

646.415 DURABLE 150 mm YELLOW LINE

STA. 1+600.000 - STA. 2+060.000 SOLID LINE 3.6 m RT
 STA. 3+160.000 - STA. 3+200.000 SOLID LINE 3.6 m RT

646.615 TEMPORARY 150 mm YELLOW LINE

STA. 1+600.000 - STA. 2+060.000 SOLID LINE 3.6 m RT
 STA. 3+160.000 - STA. 3+200.000 SOLID LINE 3.6 m RT

646.414 DURABLE 150 mm WHITE LINE


S=SOLID, D=DASHED
 STA. 1+600.000 - STA. 2+060.000 LT @ RT
 STA. 3+160.000 - STA. 3+200.000 D -
 STA. 1+600.000 - STA. 2+060.000 SOLID LINE 3.6 m LT
 STA. 3+160.000 - STA. 3+200.000 SOLID LINE 3.6 m LT

646.614 TEMPORARY 150 mm WHITE LINE

S=SOLID, D=DASHED
 STA. 1+600.000 - STA. 2+060.000 LT @ RT
 STA. 3+160.000 - STA. 3+200.000 D -
 STA. 1+600.000 - STA. 2+060.000 SOLID LINE 3.6 m LT
 STA. 3+160.000 - STA. 3+200.000 SOLID LINE 3.6 m LT

675.50 REMOVING SIGNS

AS SHOWN - 8

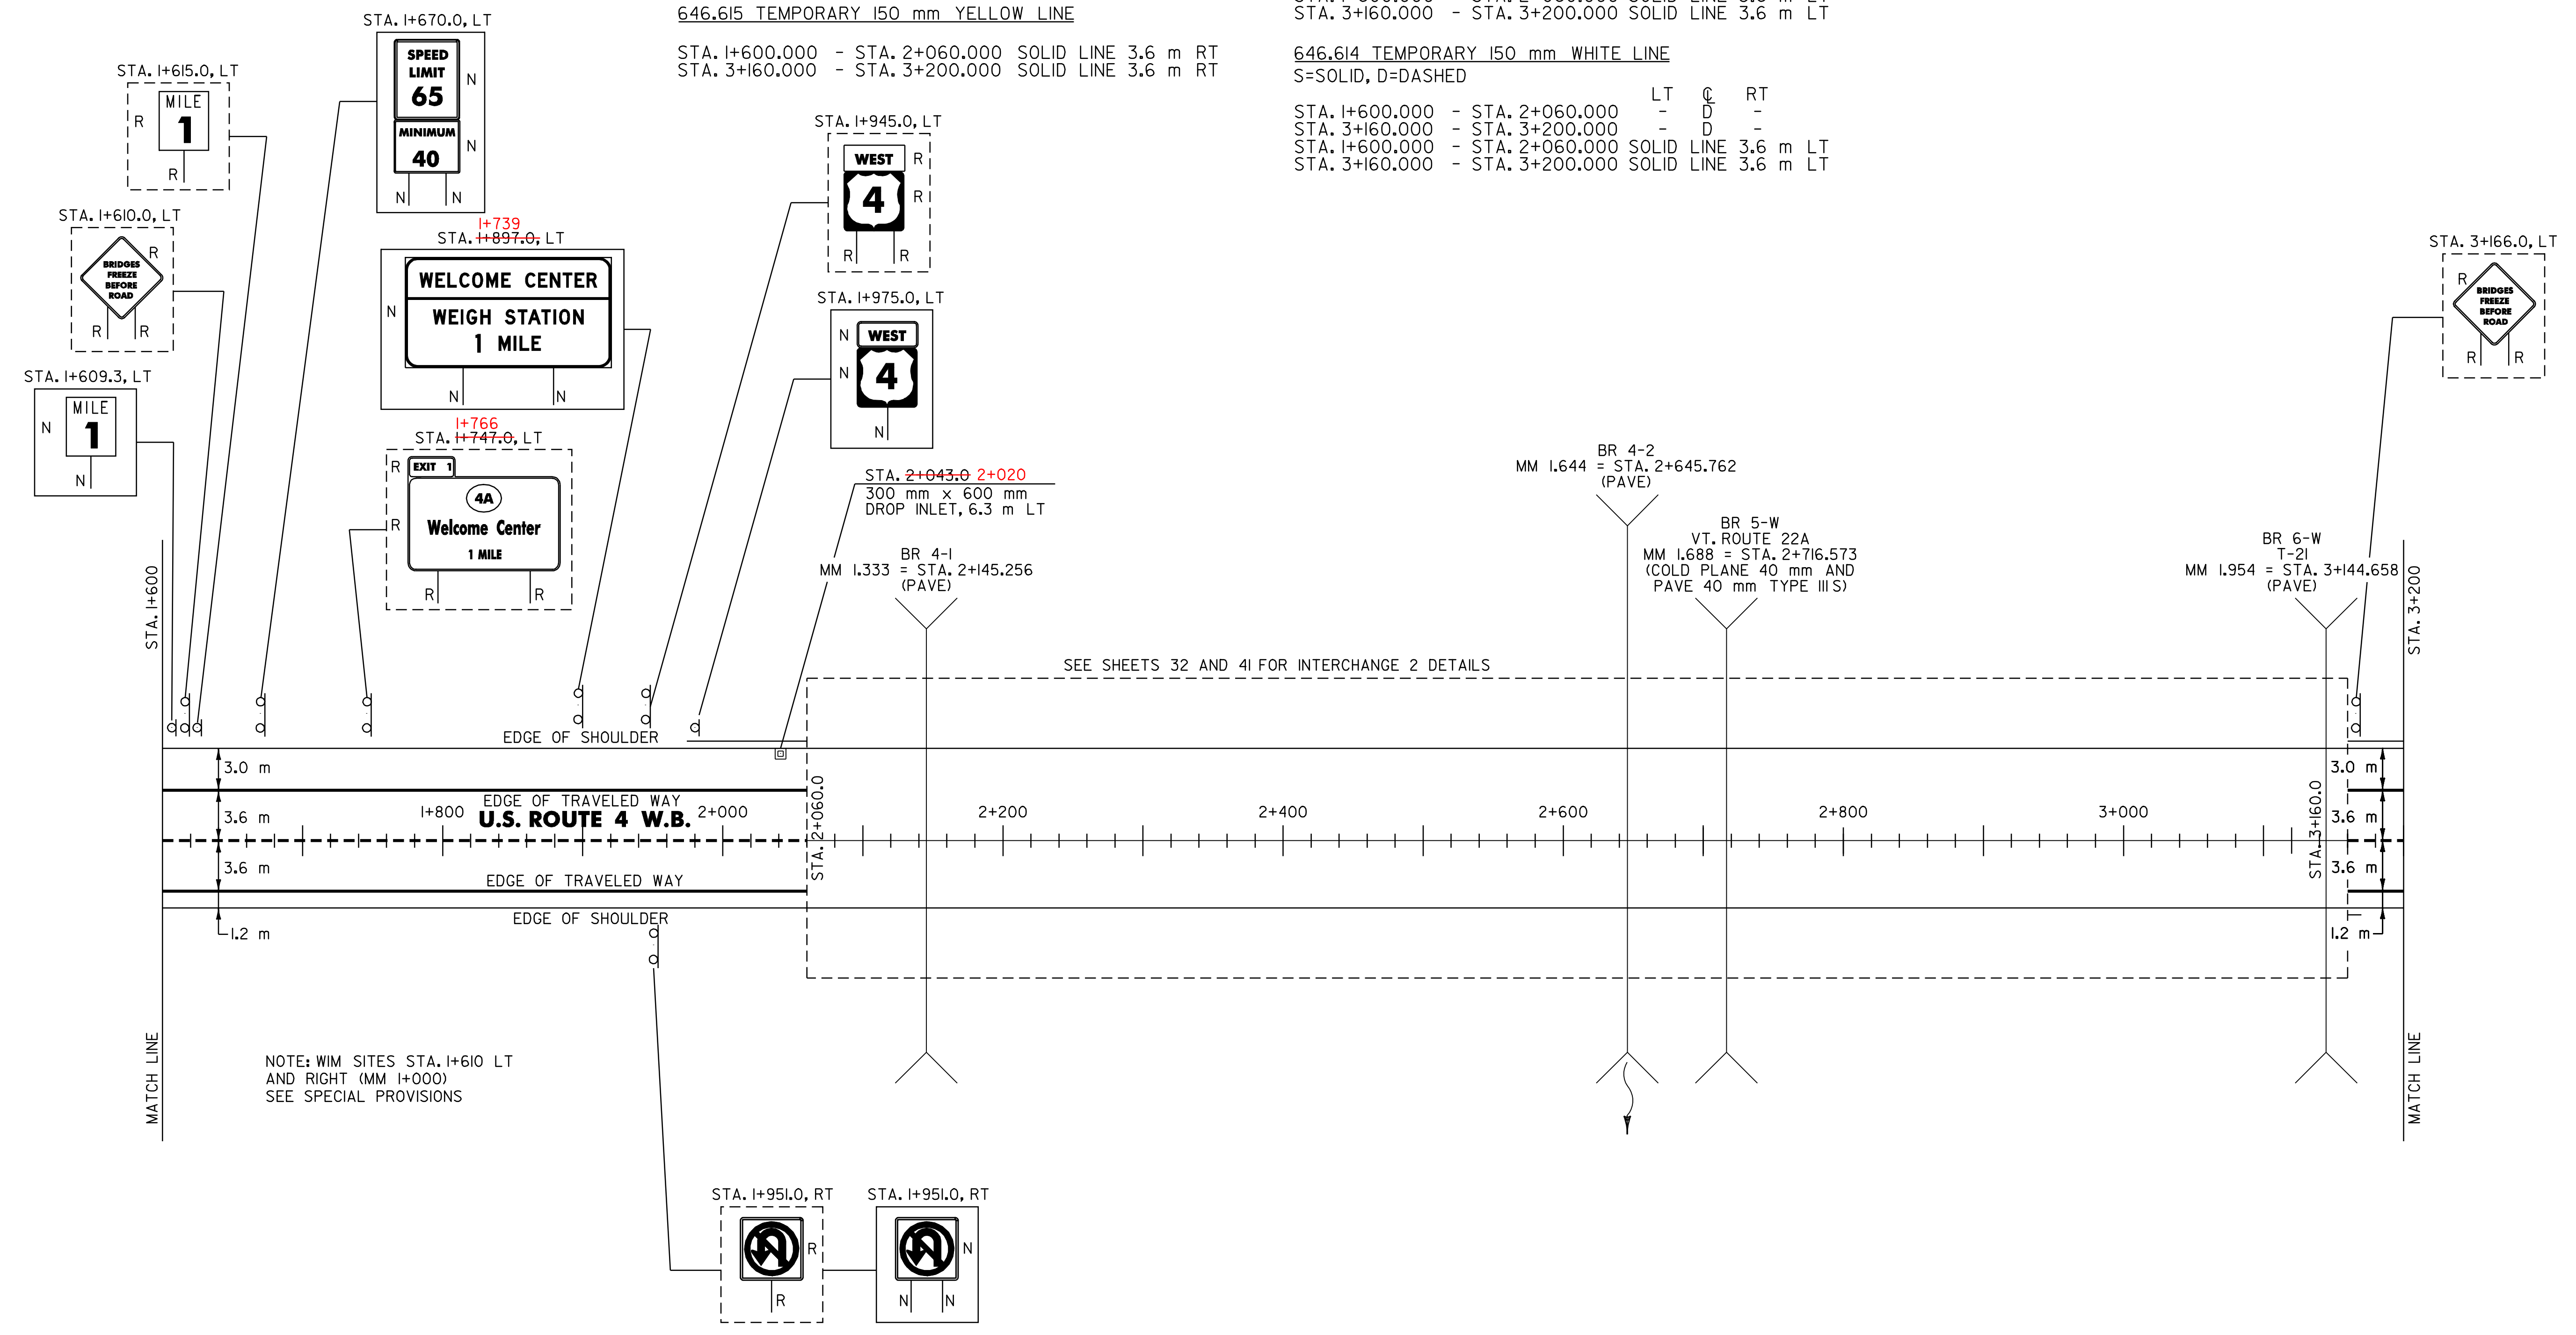

NOTE: WIM SITES STA. 1+610 LT AND RIGHT (MM 1+000) SEE SPECIAL PROVISIONS

CHANGING ELEVATION OF DI'S, CB'S OR MH'S REHABING DI'S, CB'S OR MH'S SEE NOTE 4, SHEET 3 OF 119
 STA. 2+043.0 LT

616.35 TREATED TIMBER CURB
 STA. 1+977.0 - STA. 2+060.0 LT (83.0 m)
 STA. 1+954 - STA. 2+099.5 LT

620.75 SNOW BARRIER - GALVANIZED
 STA. 2+705.4 - STA. 2+732.0 RT (26.6 m)
 STA. 2+705.4 - STA. 2+732.0 LT (26.6 m)

621.20 STEEL BEAM GUARDRAIL
 47 STA. 1+974.3 - STA. 2+060.0 LT (85.7 m)
 STA. 3+160.0 - STA. 3+200.0 LT (40.0 m)
 STA. 1+947 - STA. 2+195.0 LT

621.54 MODIFIED ECCENTRIC LOADER TERMINAL
 79 STA. 3+160.0 - STA. 3+169.9 RT STA 3+190 - STA 3+202 LT 90

621.60 ANCHOR FOR STEEL BEAM RAIL
 STA. 1+974.9 - LT

621.80 REMOVAL AND DISPOSAL OF GUARDRAIL
 2+525 STA. 1+979.0 - STA. 2+060.0 LT (81.0 m) 2+666 (151m)
 060 STA. 3+160.0 - STA. 3+166.0 RT (6.0 m) 3+189 (128m)
 STA. 3+160.0 - STA. 3+200.0 LT (40.0 m)

SIGN LEGEND
 R= REMOVE
 S= SALVAGE
 N= NEW
 RET= RETAIN
 B-B= BACK TO BACK
 EXISTING= - - - - -
 NEW= _____

PAVING PROJECT LAYOUT	SURVEYED BY <u>N/A</u> DATE <u>N/A</u>
	DRAWN BY <u>J.N.</u> DATE <u>8/98</u>
	SQUAD LEADER <u>T.P.K.</u>
	DESIGN FILE NO. <u>/pave/96bl54/pbl54.dgn</u>
	IPARM FILE <u>pbl54.i</u> DATE <u>N/A</u> PLOTTED <u>N/A</u>
PROJ. NAME <u>FAIR HAVEN - RUTLAND</u>	
PROJ. NO. <u>NH 9727(1)S</u>	
SHEET <u>13 OF 119</u> SHEETS	

DATUM	
VERTICAL	<u>N/A</u>
HORIZONTAL	<u>N/A</u>