

646.415 DURABLE 150 mm YELLOW LINE

STA. 3+200.000 - STA. 4+160.000 SOLID LINE 3.6 m RT
 STA. 4+720.000 - STA. 4+800.000 SOLID LINE 3.6 m RT

646.615 TEMPORARY 150 mm YELLOW LINE

STA. 3+200.000 - STA. 4+160.000 SOLID LINE 3.6 m RT
 STA. 4+720.000 - STA. 4+800.000 SOLID LINE 3.6 m RT

646.414 DURABLE 150 mm WHITE LINE


S=SOLID, D=DASHED LT C RT
 STA. 3+200.000 - STA. 4+160.000 - D - -
 STA. 4+720.000 - STA. 4+800.000 - D - -
 STA. 3+200.000 - STA. 4+160.000 SOLID LINE 3.6 m LT
 STA. 4+720.000 - STA. 4+800.000 SOLID LINE 3.6 m LT

646.614 TEMPORARY 150 mm WHITE LINE

S=SOLID, D=DASHED LT C RT
 STA. 3+200.000 - STA. 4+160.000 - D - -
 STA. 4+720.000 - STA. 4+800.000 - D - -
 STA. 3+200.000 - STA. 4+160.000 SOLID LINE 3.6 m LT
 STA. 4+720.000 - STA. 4+800.000 SOLID LINE 3.6 m LT

675.50 REMOVING SIGNS

AS SHOWN - 10

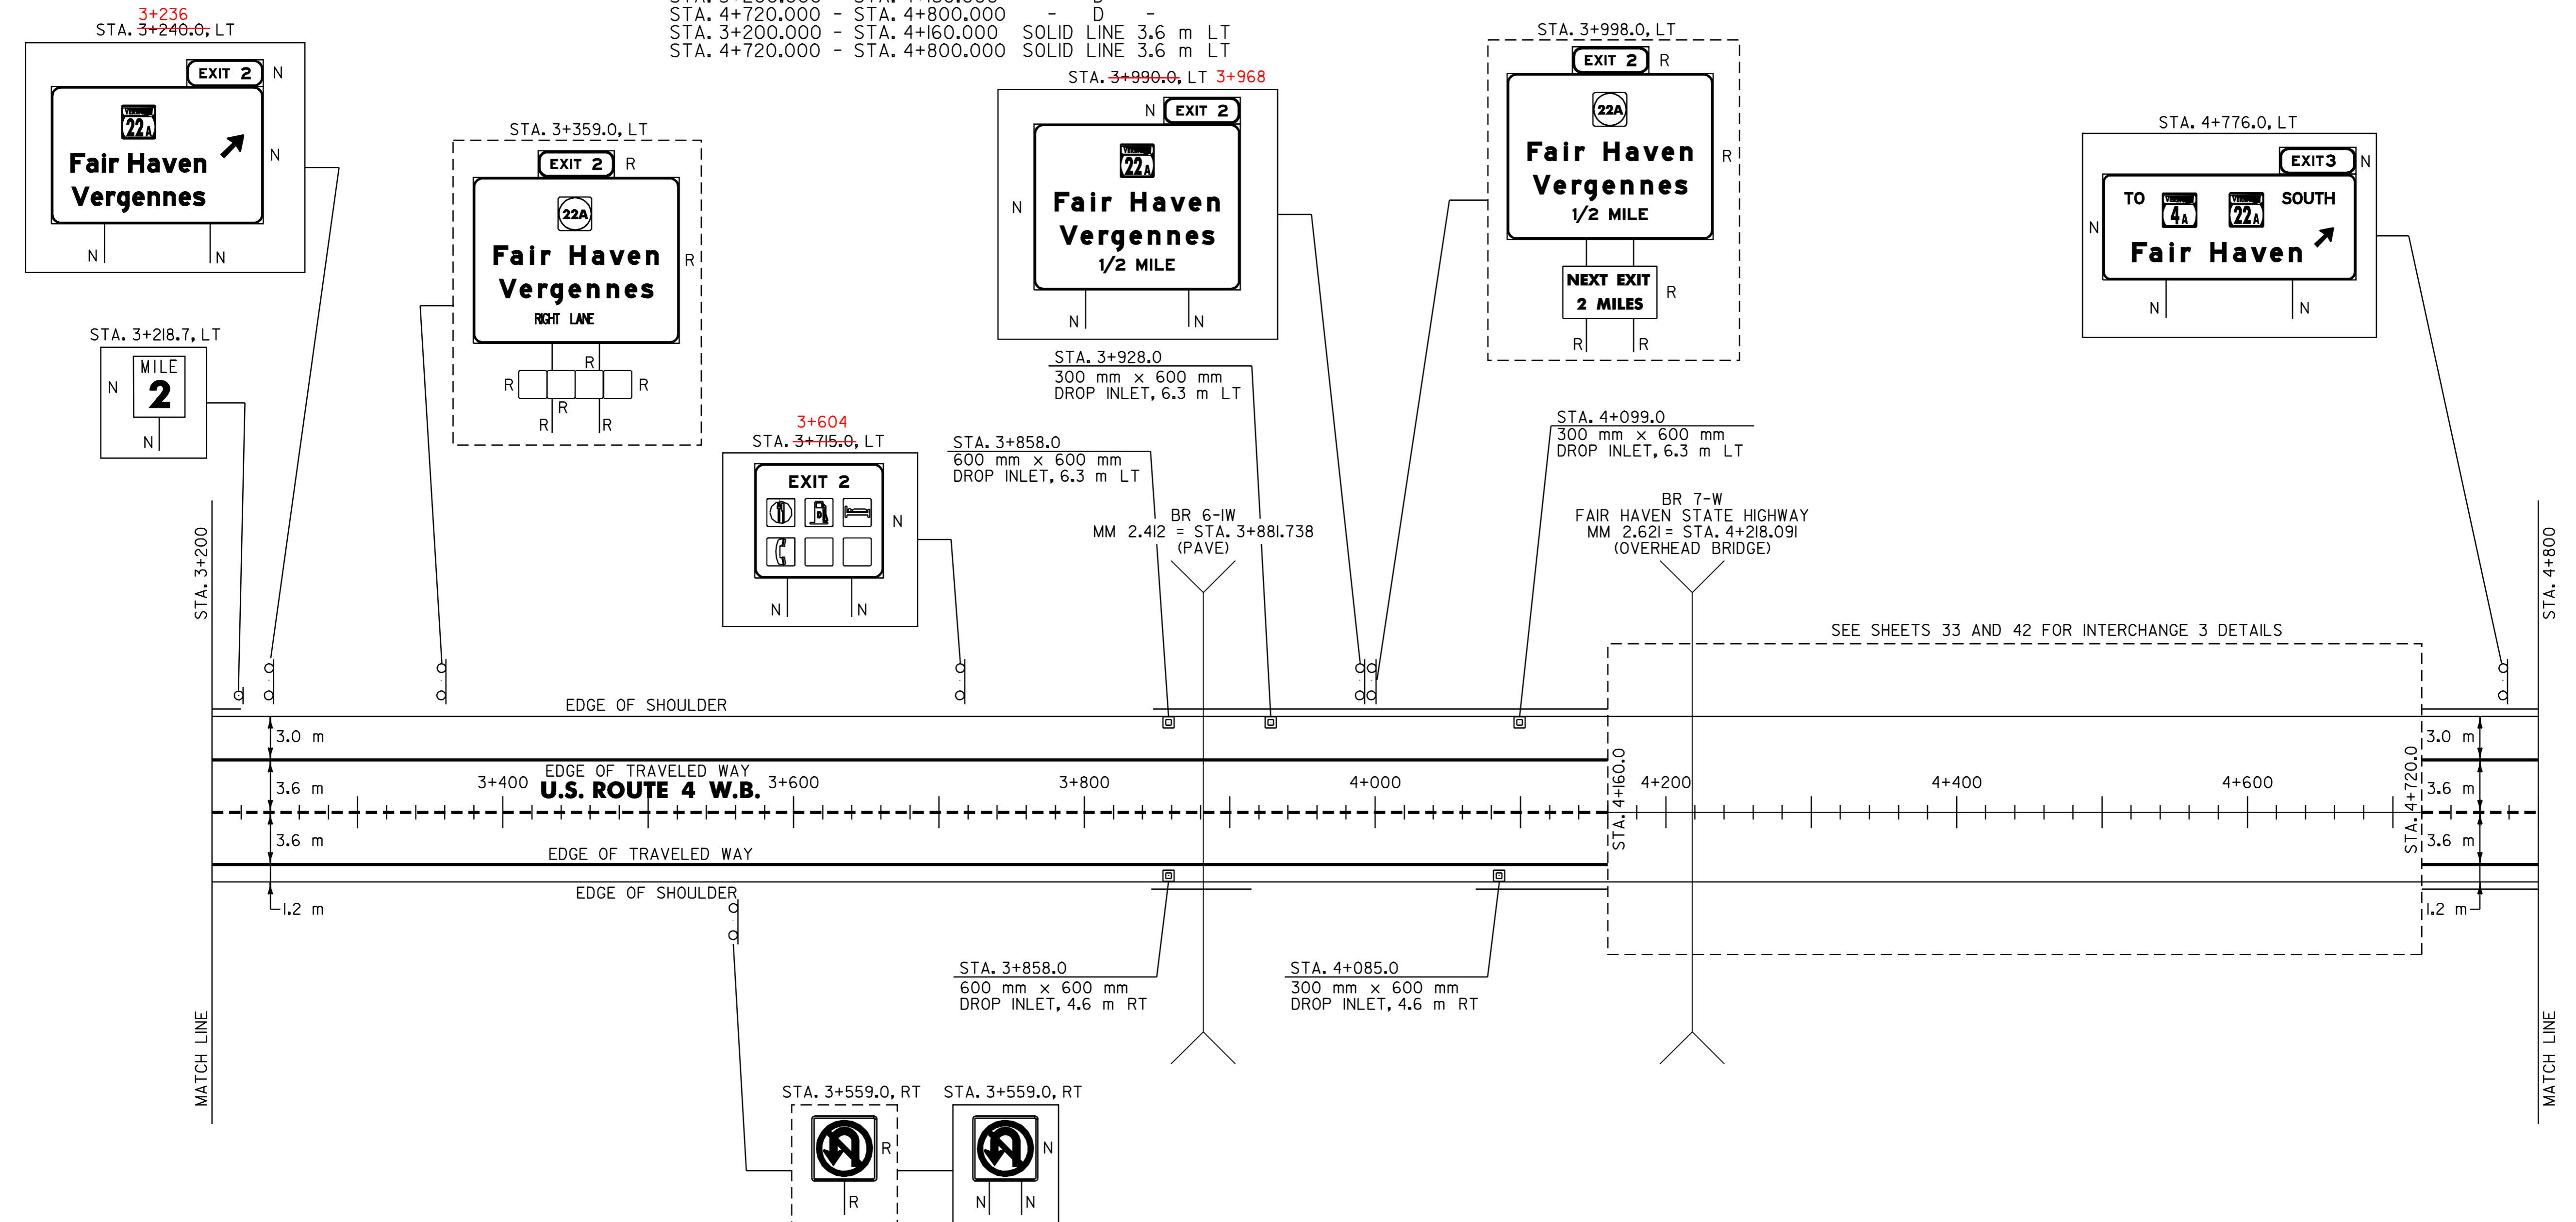

CHANGING ELEVATION OF DI'S, CB'S OR MH'S
 REHABING DI'S, CB'S OR MH'S
 SEE NOTE 4, SHEET 3 OF I19

STA. 3+858.0 RT
 STA. 3+858.0 LT
 STA. 3+928.0 LT
 STA. 4+085.0 RT
 STA. 4+099.0 LT

616.35 TREATED TIMBER CURB

830 STA. 3+857.0 - STA. 4+002.0 LT (145.0 m) 3+972
 831 STA. 3+858.0 - STA. 3+893.0 RT (35.0 m) 865
 061 STA. 4+084.0 - STA. 4+149.0 RT (65.0 m) 125
 072 STA. 4+098.0 - STA. 4+148.0 LT (50.0 m) 125

621.20 STEEL BEAM GUARDRAIL

830 STA. 3+200.0 - STA. 3+208.4 LT (8.4 m)
 831 STA. 3+845.9 - STA. 3+903.5 RT (57.6 m) 3+882.88
 832 STA. 3+847.3 - STA. 4+160.0 LT (312.7 m)
 4+042.5 STA. 4+069.3 - STA. 4+160.0 RT (90.7 m) 4+162
 STA. 4+720.0 - STA. 4+800.0 RT (80.0 m)
 STA. 4+720.0 - STA. 4+800.0 LT (80.0 m)

621.54 MODIFIED ECCENTRIC LOADER TERMINAL

200 STA. 3+208.4 - STA. 3+219.8 LT 208
 883 STA. 3+903.5 - STA. 3+914.9 RT 894

621.60 ANCHOR FOR STEEL BEAM RAIL

STA. 3+846.5 RT 3+813
 STA. 3+847.9 LT 3+809
 STA. 4+069.9 RT 4+028
 4+045 RT

621.80 REMOVAL AND DISPOSAL OF GUARDRAIL

STA. 3+200.0 - STA. 3+208.0 LT (8.0 m)
 STA. 3+849.0 - STA. 3+911.0 RT (62.0 m)
 STA. 3+849.0 - STA. 4+160.0 LT (311.0 m)
 STA. 4+073.0 - STA. 4+160.0 RT (87.0 m)
 STA. 4+720.0 - STA. 4+800.0 RT (80.0 m)
 STA. 4+720.0 - STA. 4+800.0 LT (80.0 m)

621.80 REMOVAL AND DISPOSAL OF GUARDRAIL

STA 3+830 - STA 4+173 LT (342m)
 STA 4+042 - STA 4+162 RT (119m)
 STA 4+634 - STA 4+800 LT
 STA 4+654 - STA 4+800 RT

SIGN LEGEND
 R= REMOVE
 S= SALVAGE
 N= NEW
 RET= RETAIN
 B-B= BACK TO BACK
 EXISTING= - - - - -
 NEW= _____

| | |
|------------|-----|
| DATUM | |
| VERTICAL | N/A |
| HORIZONTAL | N/A |

PAVING PROJECT LAYOUT

| | | | |
|-----------------|------------------------|--------------|------|
| SURVEYED BY | N/A | DATE | N/A |
| DRAWN BY | J.N. | DATE | 8/98 |
| SQUAD LEADER | T.P.K. | | |
| DESIGN FILE NO. | /pave/96bl54/pbl54.dgn | | |
| IPARM FILE | pbl54i03.i | DATE PLOTTED | N/A |
| PROJ. NAME | FAIR HAVEN - RUTLAND | | |
| PROJ. NO. | NH 9727(I)S | | |
| SHEET | 14 OF 119 | SHEETS | |