

646.415 DURABLE 150 mm YELLOW LINE

STA. 8+000.000 - STA. 8+340.000 SOLID LINE 3.6 m RT  
 STA. 9+360.000 - STA. 9+600.000 SOLID LINE 3.6 m RT

646.615 TEMPORARY 150 mm YELLOW LINE

STA. 8+000.000 - STA. 8+340.000 SOLID LINE 3.6 m RT  
 STA. 9+360.000 - STA. 9+600.000 SOLID LINE 3.6 m RT

646.414 DURABLE 150 mm WHITE LINE

S=SOLID, D=DASHED

STA. 8+000.000 - STA. 8+340.000 LT C RT  
 STA. 9+360.000 - STA. 9+600.000 - D -  
 STA. 8+000.000 - STA. 8+340.000 SOLID LINE 3.6 m LT  
 STA. 9+360.000 - STA. 9+600.000 SOLID LINE 3.6 m LT


646.614 TEMPORARY 150 mm WHITE LINE

S=SOLID, D=DASHED

STA. 8+000.000 - STA. 8+340.000 LT C RT  
 STA. 9+360.000 - STA. 9+600.000 - D -  
 STA. 8+000.000 - STA. 8+340.000 SOLID LINE 3.6 m LT  
 STA. 9+360.000 - STA. 9+600.000 SOLID LINE 3.6 m LT

675.50 REMOVING SIGNS

AS SHOWN - 6

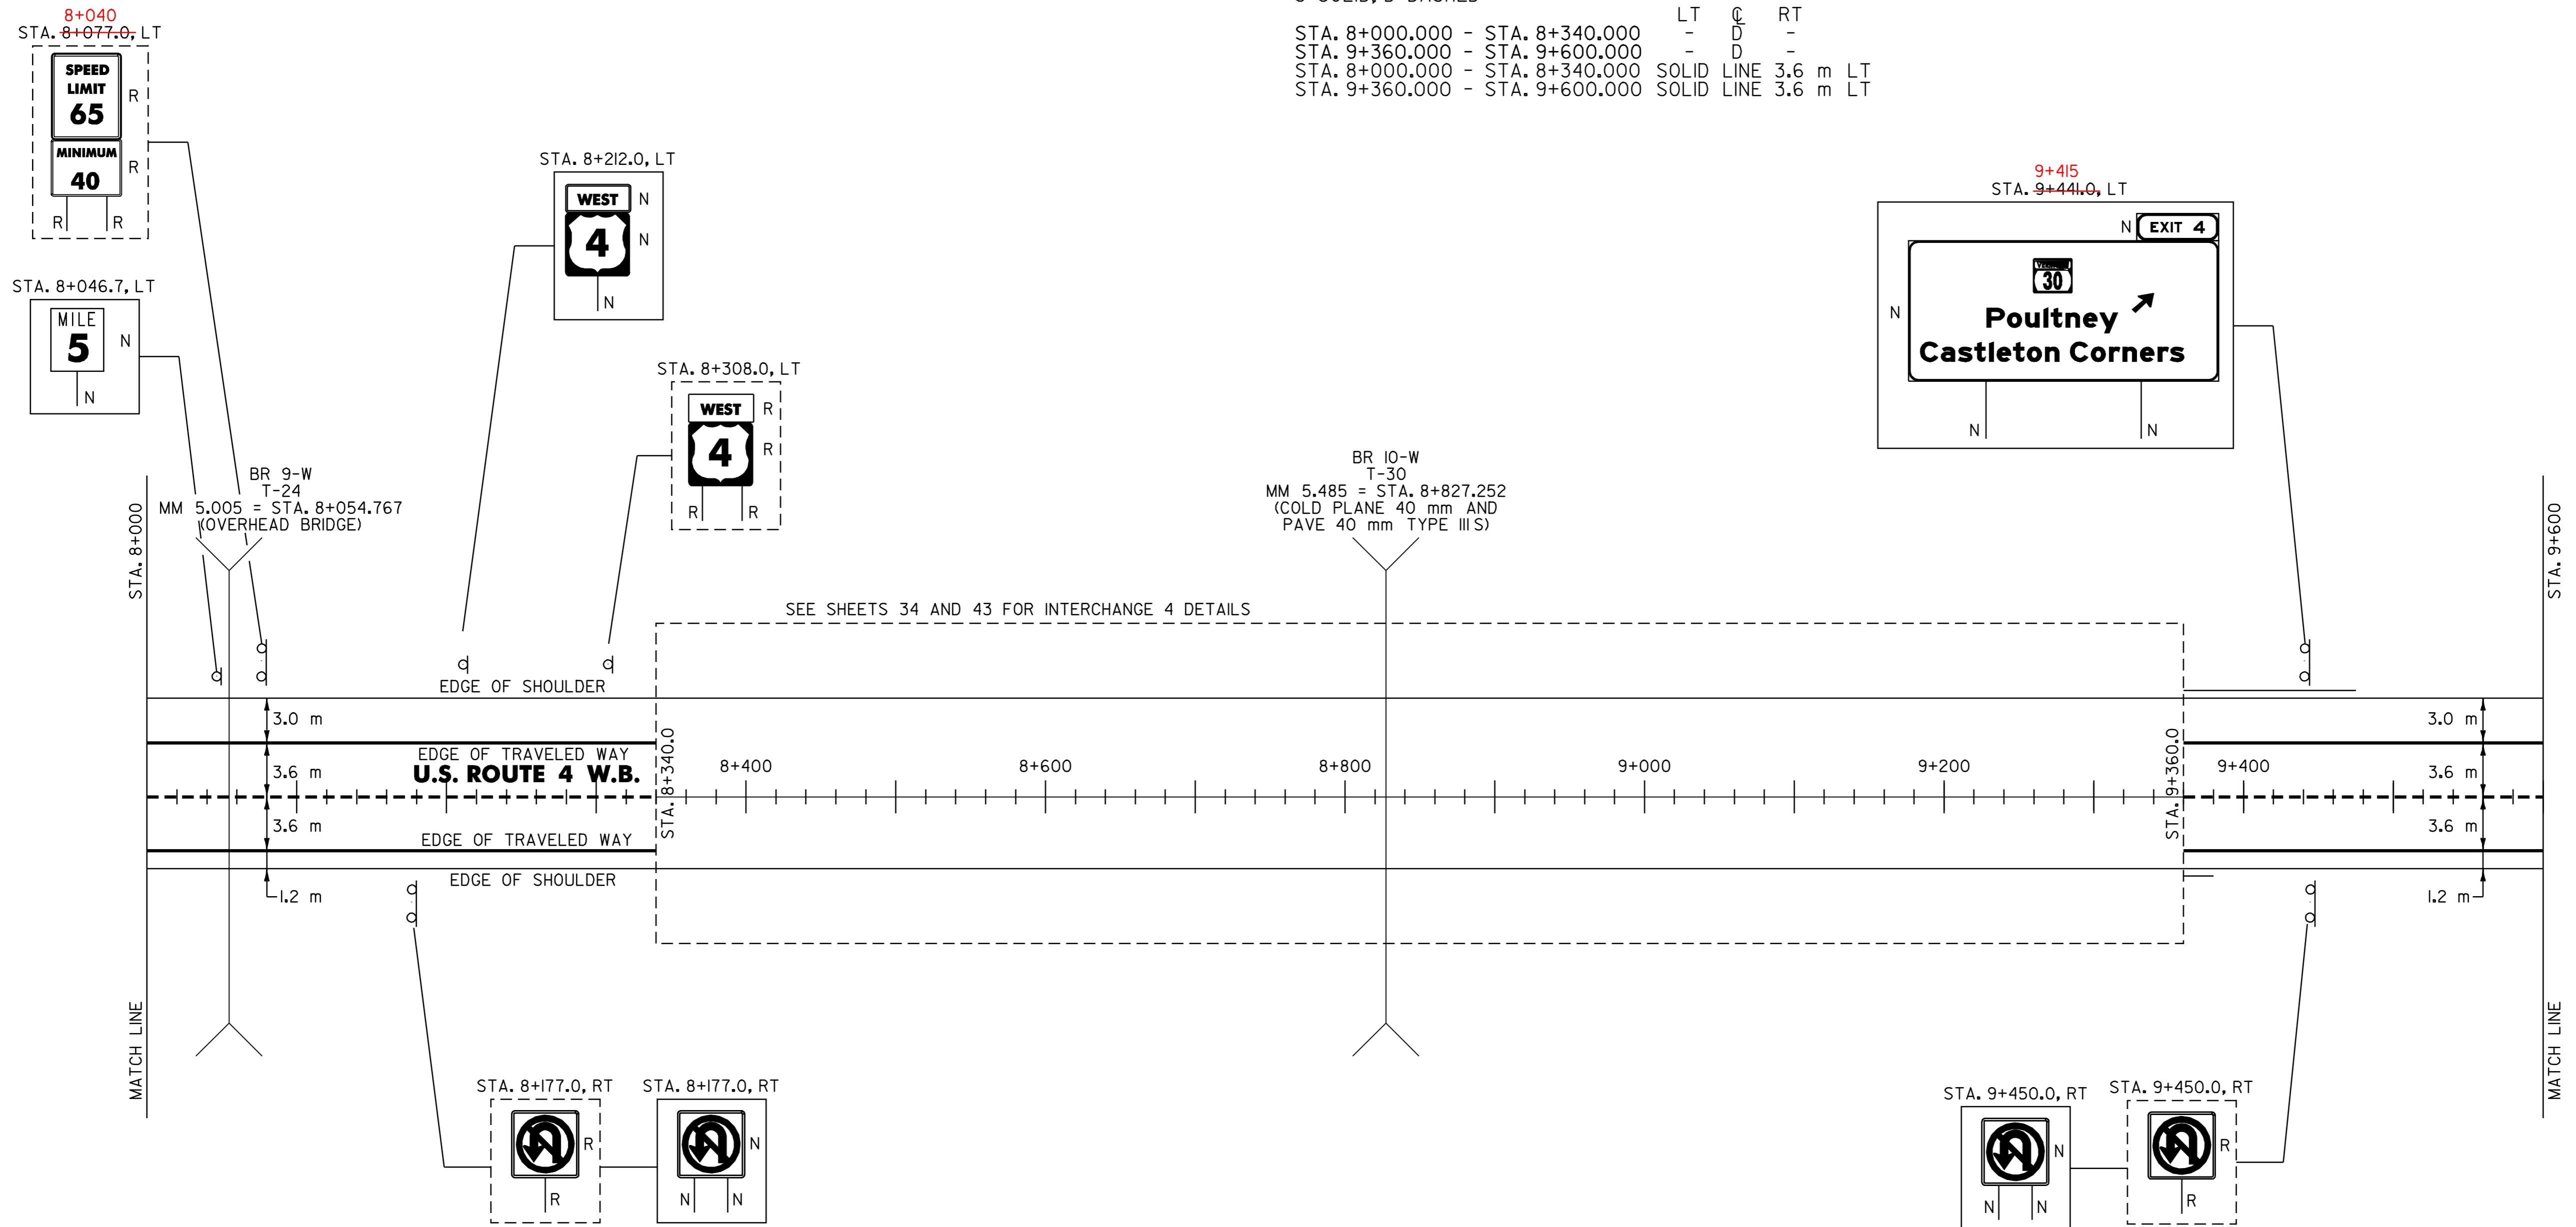

616.35 TREATED TIMBER CURB  
 STA. 9+360.0 - STA. 9+423.0 LT (63.0 m)

620.75 SNOW BARRIER - GALVANIZED  
 STA. 8+813.0 - STA. 8+841.5 RT (28.5 m)  
 STA. 8+816.0 - STA. 8+842.6 LT (26.6 m)

621.20 STEEL BEAM GUARDRAIL  
 STA. 9+360.0 - STA. 9+464.2 LT (104.2 m)

621.54 MODIFIED ECCENTRIC LOADER TERMINAL  
 STA. 9+464.2 - STA. 9+475.6 LT

621.80 REMOVAL AND DISPOSAL OF GUARDRAIL

~~STA. 9+360.0 - STA. 9+463.0 LT (103.0 m)~~  
~~STA. 8+351.0 - STA. 8+759 RT~~  
~~STA. 8+645.0 - STA. 8+768.5 LT~~

SIGN LEGEND  
 R= REMOVE  
 S= SALVAGE  
 N= NEW  
 RET= RETAIN  
 B-B= BACK TO BACK  
 EXISTING= - - - - -  
 NEW= \_\_\_\_\_

**PAVING PROJECT LAYOUT**

SURVEYED BY	N/A	DATE	N/A
DRAWN BY	J.N.	DATE	8/98
SQUAD LEADER	T.P.K.		
DESIGN FILE NO.	/pave/96bl54/pbl54.dgn		
IPARM FILE	pbl54i06.i	DATE PLOTTED	N/A
PROJ. NAME	FAIR HAVEN - RUTLAND		
PROJ. NO.	NH 9727(I)S		
SHEET	17 OF 119	SHEETS	

DATUM	
VERTICAL	N/A
HORIZONTAL	N/A