

646.415 DURABLE 150 mm YELLOW LINE

STA. 13+040.000 - STA. 14+400.000 SOLID LINE 3.6 m RT

646.615 TEMPORARY 150 mm YELLOW LINE

STA. 13+040.000 - STA. 14+400.000 SOLID LINE 3.6 m RT

646.414 DURABLE 150 mm WHITE LINE

S=SOLID, D=DASHED

STA. 13+040.000 - STA. 14+400.000 LT $\frac{C}{D}$ RT
 STA. 13+040.000 - STA. 14+400.000 SOLID LINE 3.6 m LT


646.614 TEMPORARY 150 mm WHITE LINE

S=SOLID, D=DASHED

STA. 13+040.000 - STA. 14+400.000 LT $\frac{C}{D}$ RT
 STA. 13+040.000 - STA. 14+400.000 SOLID LINE 3.6 m LT

675.50 REMOVING SIGNS

AS SHOWN - IO

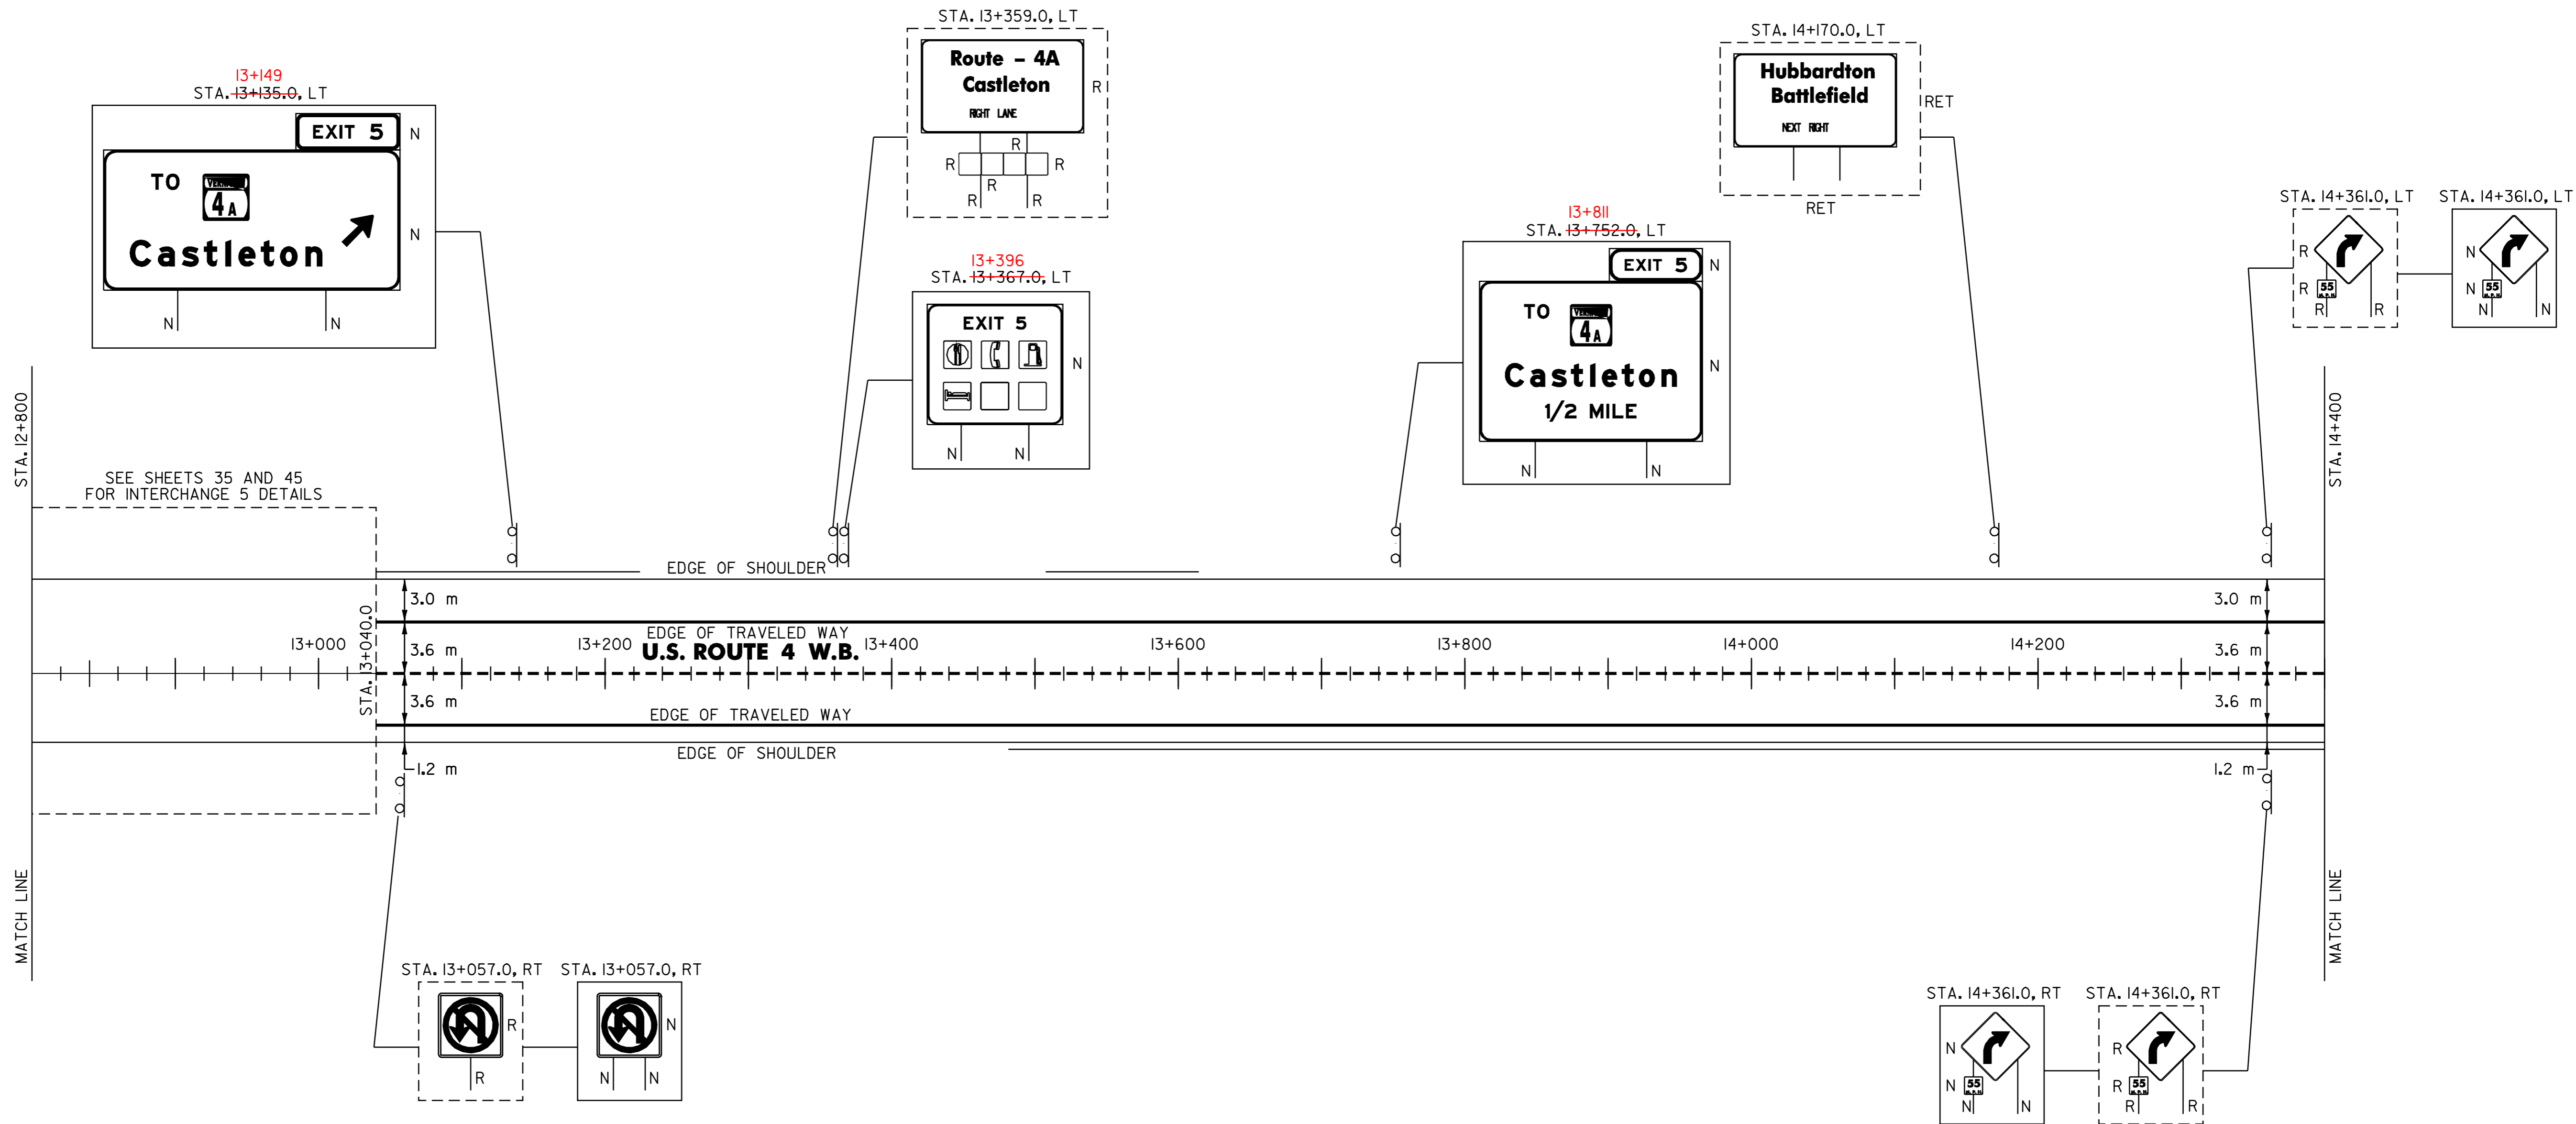

SEE SHEETS 35 AND 45 FOR INTERCHANGE 5 DETAILS

~~621.20 STEEL BEAM GUARDRAIL W/2.4 m POSTS (MOD.)~~

~~STA. 13+040.0 - STA. 13+213.0 LT (173.0 m)~~

621.20 STEEL BEAM GUARDRAIL

- 438 STA. 13+481.4 - STA. 14+400.0 RT (918.6 m) 380
- 472 STA. 13+507.4 - STA. 13+603.0 LT (95.6 m) 564.0
- STA. 13+040 - STA. 13+191 LT

621.54 MODIFIED ECCENTRIC LOADER TERMINAL

- 191 STA. 13+213.0 - STA. 13+224.4 LT 202.4
- 564 STA. 13+603.0 - STA. 13+614.4 LT 575
- STA. 14+380 - STA. 14+391 RT

621.60 ANCHOR FOR STEEL BEAM RAIL

- STA. 13+482.0 RT 13+472.6 LT
- STA. 13+508.0 LT 13+068.5 LT
- 13+439 LT

621.80 REMOVAL AND DISPOSAL OF GUARDRAIL

- 466 STA. 13+040.0 - STA. 13+172.0 LT (132.0 m) 564
- STA. 13+515.0 - STA. 13+603.0 LT (88.0 m)
- 439 STA. 13+489.0 - STA. 14+400.0 RT (911.0 m) 380
- STA. 12+800 - STA. 12+831 LT

SIGN LEGEND

- R= REMOVE
- S= SALVAGE
- N= NEW
- RET= RETAIN
- B-B= BACK TO BACK
- EXISTING= - - - - -
- NEW= _____

PAVING PROJECT LAYOUT

SURVEYED BY	N/A	DATE	N/A
DRAWN BY	J.N.	DATE	8/98
SQUAD LEADER	T.P.K.		
DESIGN FILE NO.	/pave/96b154/pbl54.dgn		
IPARM FILE	pbl54i09.i	DATE PLOTTED	N/A
PROJ. NAME	FAIR HAVEN - RUTLAND		
PROJ. NO.	NH 9727(I)S		
SHEET	20 OF 119	SHEETS	

DATUM	
VERTICAL	N/A
HORIZONTAL	N/A