


646.415 DURABLE 150 mm YELLOW LINE
 STA. 16+000.000 - STA. 17+600.000 SOLID LINE 3.6 m RT

646.414 DURABLE 150 mm WHITE LINE
 S=SOLID, D=DASHED
 STA. 16+000.000 - STA. 17+600.000 LT C RT
 STA. 16+000.000 - STA. 17+600.000 D D
 STA. 16+000.000 - STA. 17+600.000 SOLID LINE 3.6 m LT

675.50 REMOVING SIGNS
 AS SHOWN - 5

646.615 TEMPORARY 150 mm YELLOW LINE
 STA. 16+000.000 - STA. 17+600.000 SOLID LINE 3.6 m RT

646.614 TEMPORARY 150 mm WHITE LINE
 S=SOLID, D=DASHED
 STA. 16+000.000 - STA. 17+600.000 LT C RT
 STA. 16+000.000 - STA. 17+600.000 D D
 STA. 16+000.000 - STA. 17+600.000 SOLID LINE 3.6 m LT

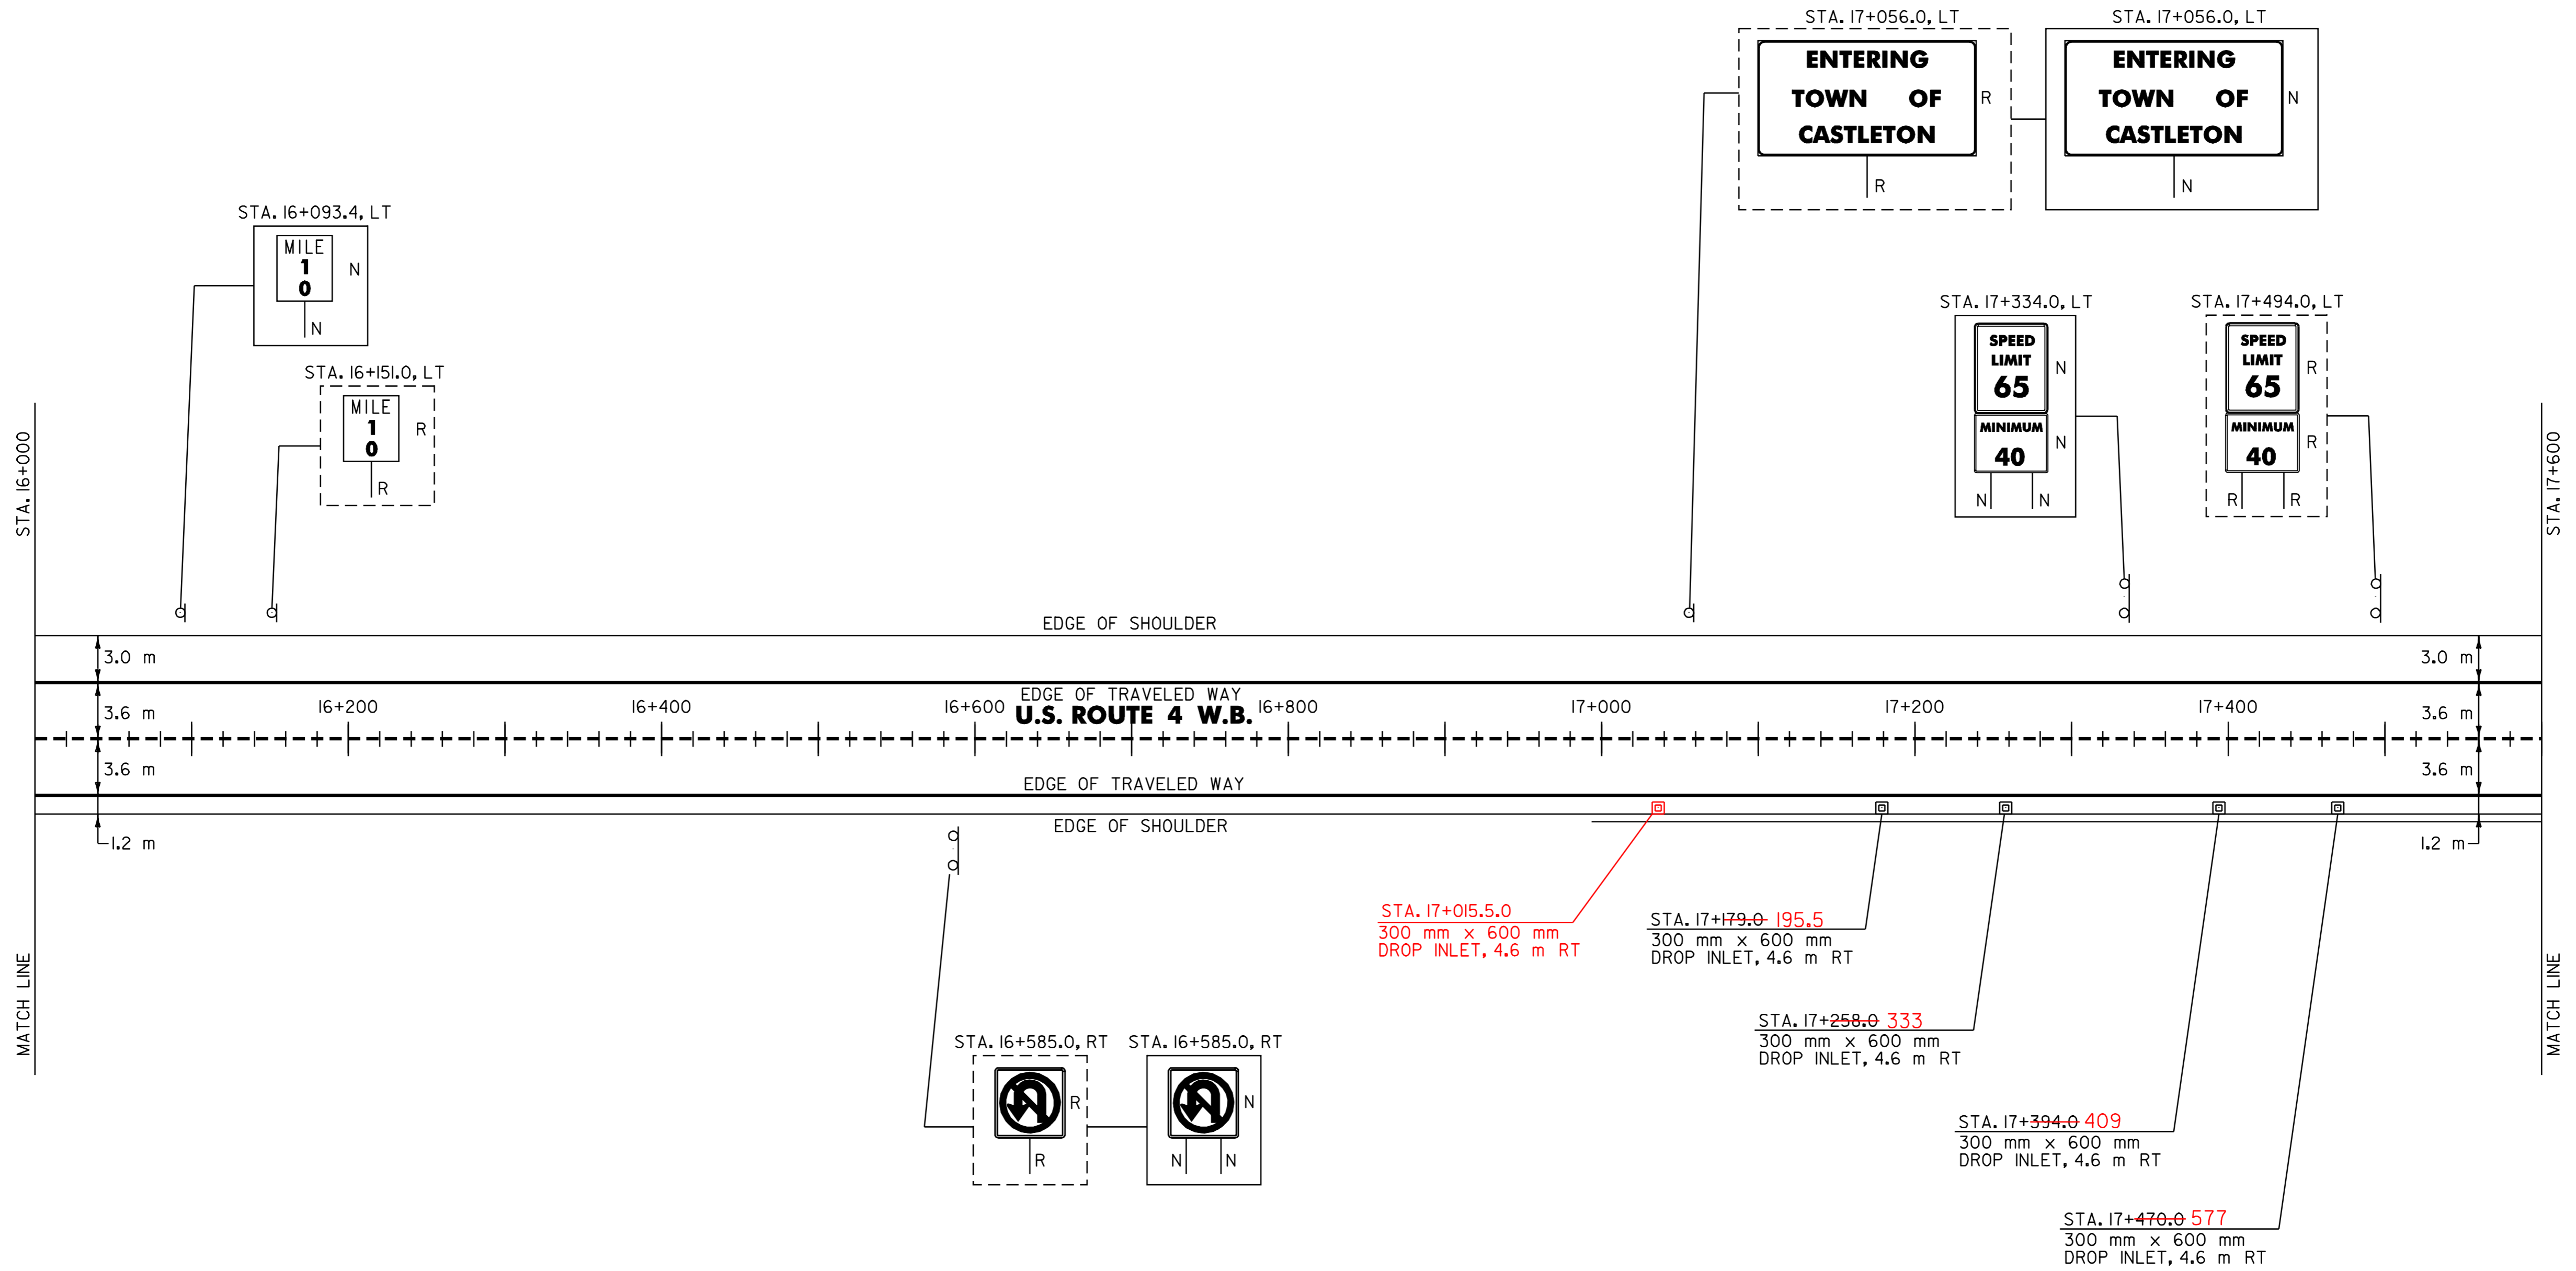

CHANGING ELEVATION OF D'S, CB'S OR MH'S
 REHABING D'S, CB'S OR MH'S
 SEE NOTE 4, SHEET 3 OF 119

STA. 17+179.0 RT
 STA. 17+258.0 RT
 STA. 17+394.0 RT
 STA. 17+470.0 RT

616.35 TREATED TIMBER CURB
 STA. 17+177.0 - STA. 17+600.0 RT (423.0 m)

621.20 STEEL BEAM GUARDRAIL W/2.4 m POST (MOD.)
 STA. 16+993.1 - STA. 17+600.0 RT (606.9 m)

621.60 ANCHOR FOR STEEL BEAM RAIL
 STA. 16+994.3 RT

621.80 REMOVAL AND DISPOSAL OF GUARDRAIL
 922 STA. 16+990.0 - STA. 17+600.0 RT (610.0 m)

SIGN LEGEND
 R= REMOVE
 S= SALVAGE
 N= NEW
 RET= RETAIN
 B-B= BACK TO BACK
 EXISTING= - - - - -
 NEW= _____

**PAVING
 PROJECT
 LAYOUT**

SURVEYED BY N/A DATE N/A
 DRAWN BY J.N. DATE 8/98
 SQUAD LEADER T.P.K.
 DESIGN FILE NO. /pave/96b154/pb154.dgn
 IPARM FILE pb154ill.i DATE PLOTTED N/A
 PROJ. NAME FAIR HAVEN - RUTLAND
 PROJ. NO. NH 9727(1)S
 SHEET 22 OF 119 SHEETS

DATUM
 VERTICAL N/A
 HORIZONTAL N/A