

646.415 DURABLE 150 mm YELLOW LINE

STA. 17+600.000 - STA. 17+780.000 SOLID LINE 3.6 m RT
 STA. 18+360.000 - STA. 19+200.000 SOLID LINE 3.6 m RT

646.615 TEMPORARY 150 mm YELLOW LINE

STA. 17+600.000 - STA. 17+780.000 SOLID LINE 3.6 m RT
 STA. 18+360.000 - STA. 19+200.000 SOLID LINE 3.6 m RT

646.414 DURABLE 150 mm WHITE LINE

S=SOLID, D=DASHED

STA. 17+600.000 - STA. 17+780.000 - D - -
 STA. 18+360.000 - STA. 19+200.000 - D - -
 STA. 17+600.000 - STA. 17+780.000 SOLID LINE 3.6 m LT
 STA. 18+360.000 - STA. 19+200.000 SOLID LINE 3.6 m LT


646.614 TEMPORARY 150 mm WHITE LINE

S=SOLID, D=DASHED

STA. 17+600.000 - STA. 17+780.000 - D - -
 STA. 18+360.000 - STA. 19+200.000 - D - -
 STA. 17+600.000 - STA. 17+780.000 SOLID LINE 3.6 m LT
 STA. 18+360.000 - STA. 19+200.000 SOLID LINE 3.6 m LT

675.50 REMOVING SIGNS

AS SHOWN - 2

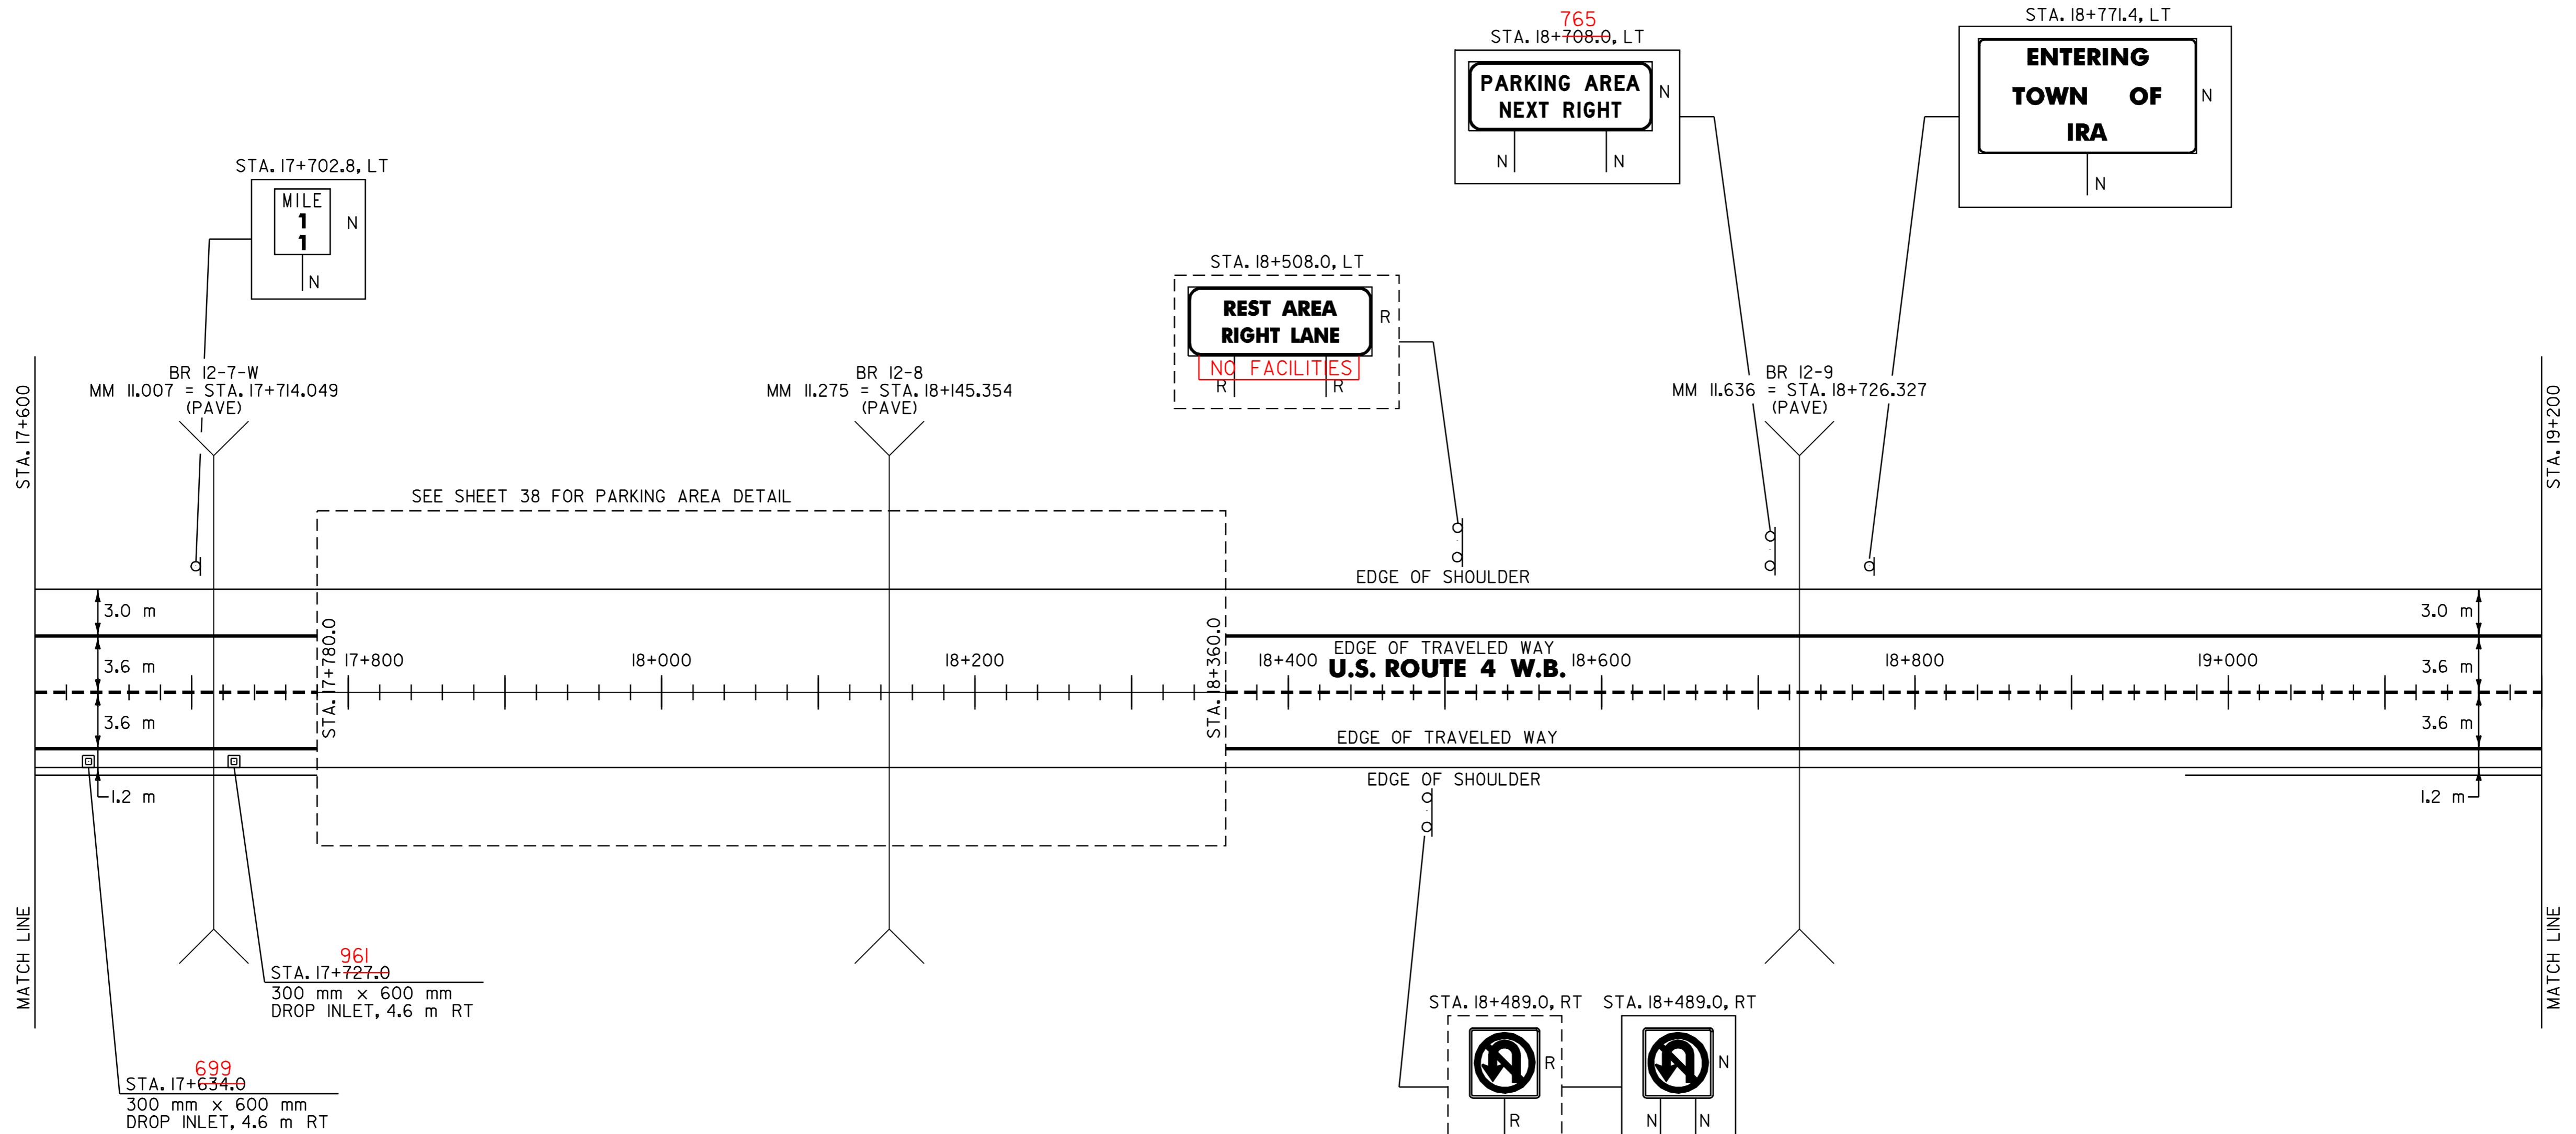

CHANGING ELEVATION OF DI'S, CB'S OR MH'S
 REHABING DI'S, CB'S OR MH'S
 SEE NOTE 4, SHEET 3 OF 119

STA. 17+634.0 RT
 STA. 17+727.0 RT

616.35 TREATED TIMBER CURB
 STA. 17+600.0 - STA. 17+780.0 RT (180.0 m)

~~621.20 STEEL BEAM GUARDRAIL W/2.4 m POSTS (MOD.)~~
~~STA. 17+600.0 - STA. 17+780.0 RT (180.0 m)~~

621.20 STEEL BEAM GUARDRAIL

921 STA. 18+972.0 - STA. 19+200.0 RT (228.0 m)
 STA. 17+890.0 - STA. 18+043.0 LT
 STA. 17+600 - STA. 17+780 RT STA. 18+921.5 - STA. 19+200

621.60 ANCHOR FOR STEEL BEAM RAIL

STA. 18+973.2 RT 917
 17+890.6 LT

621.80 REMOVAL AND DISPOSAL OF GUARDRAIL

922 STA. 17+600.0 - STA. 17+780.0 RT (180.0 m) 18+062
 STA. 18+977.0 - STA. 19+200.0 RT (223.0 m)
 STA. 17+890 - STA. 18+043 LT

SIGN LEGEND

R= REMOVE
 S= SALVAGE
 N= NEW
 RET= RETAIN
 B-B= BACK TO BACK
 EXISTING= - - - - -
 NEW= _____

PAVING PROJECT LAYOUT

SURVEYED BY N/A DATE N/A
 DRAWN BY J.N. DATE 8/98
 SQUAD LEADER T.P.K.
 DESIGN FILE NO. /pave/96b154/pbl54.dgn
 IPARM FILE pbl54112.i DATE PLOTTED N/A
 PROJ. NAME FAIR HAVEN - RUTLAND
 PROJ. NO. NH 9727(1)S
 SHEET 23 OF 119 SHEETS

DATUM	
VERTICAL	N/A
HORIZONTAL	N/A