


646.415 DURABLE 150 mm YELLOW LINE
 STA. 19+200.000 - STA. 20+800.000 SOLID LINE 3.6 m RT

646.615 TEMPORARY 150 mm YELLOW LINE
 STA. 19+200.000 - STA. 20+800.000 SOLID LINE 3.6 m RT

646.414 DURABLE 150 mm WHITE LINE
 S=SOLID, D=DASHED
 STA. 19+200.000 - STA. 20+800.000 LT $\begin{matrix} C \\ D \end{matrix}$ RT
 STA. 19+200.000 - STA. 20+800.000 SOLID LINE 3.6 m LT

646.614 TEMPORARY 150 mm WHITE LINE
 S=SOLID, D=DASHED
 STA. 19+200.000 - STA. 20+800.000 LT $\begin{matrix} C \\ D \end{matrix}$ RT
 STA. 19+200.000 - STA. 20+800.000 SOLID LINE 3.6 m LT

675.50 REMOVING SIGNS
 AS SHOWN - 2

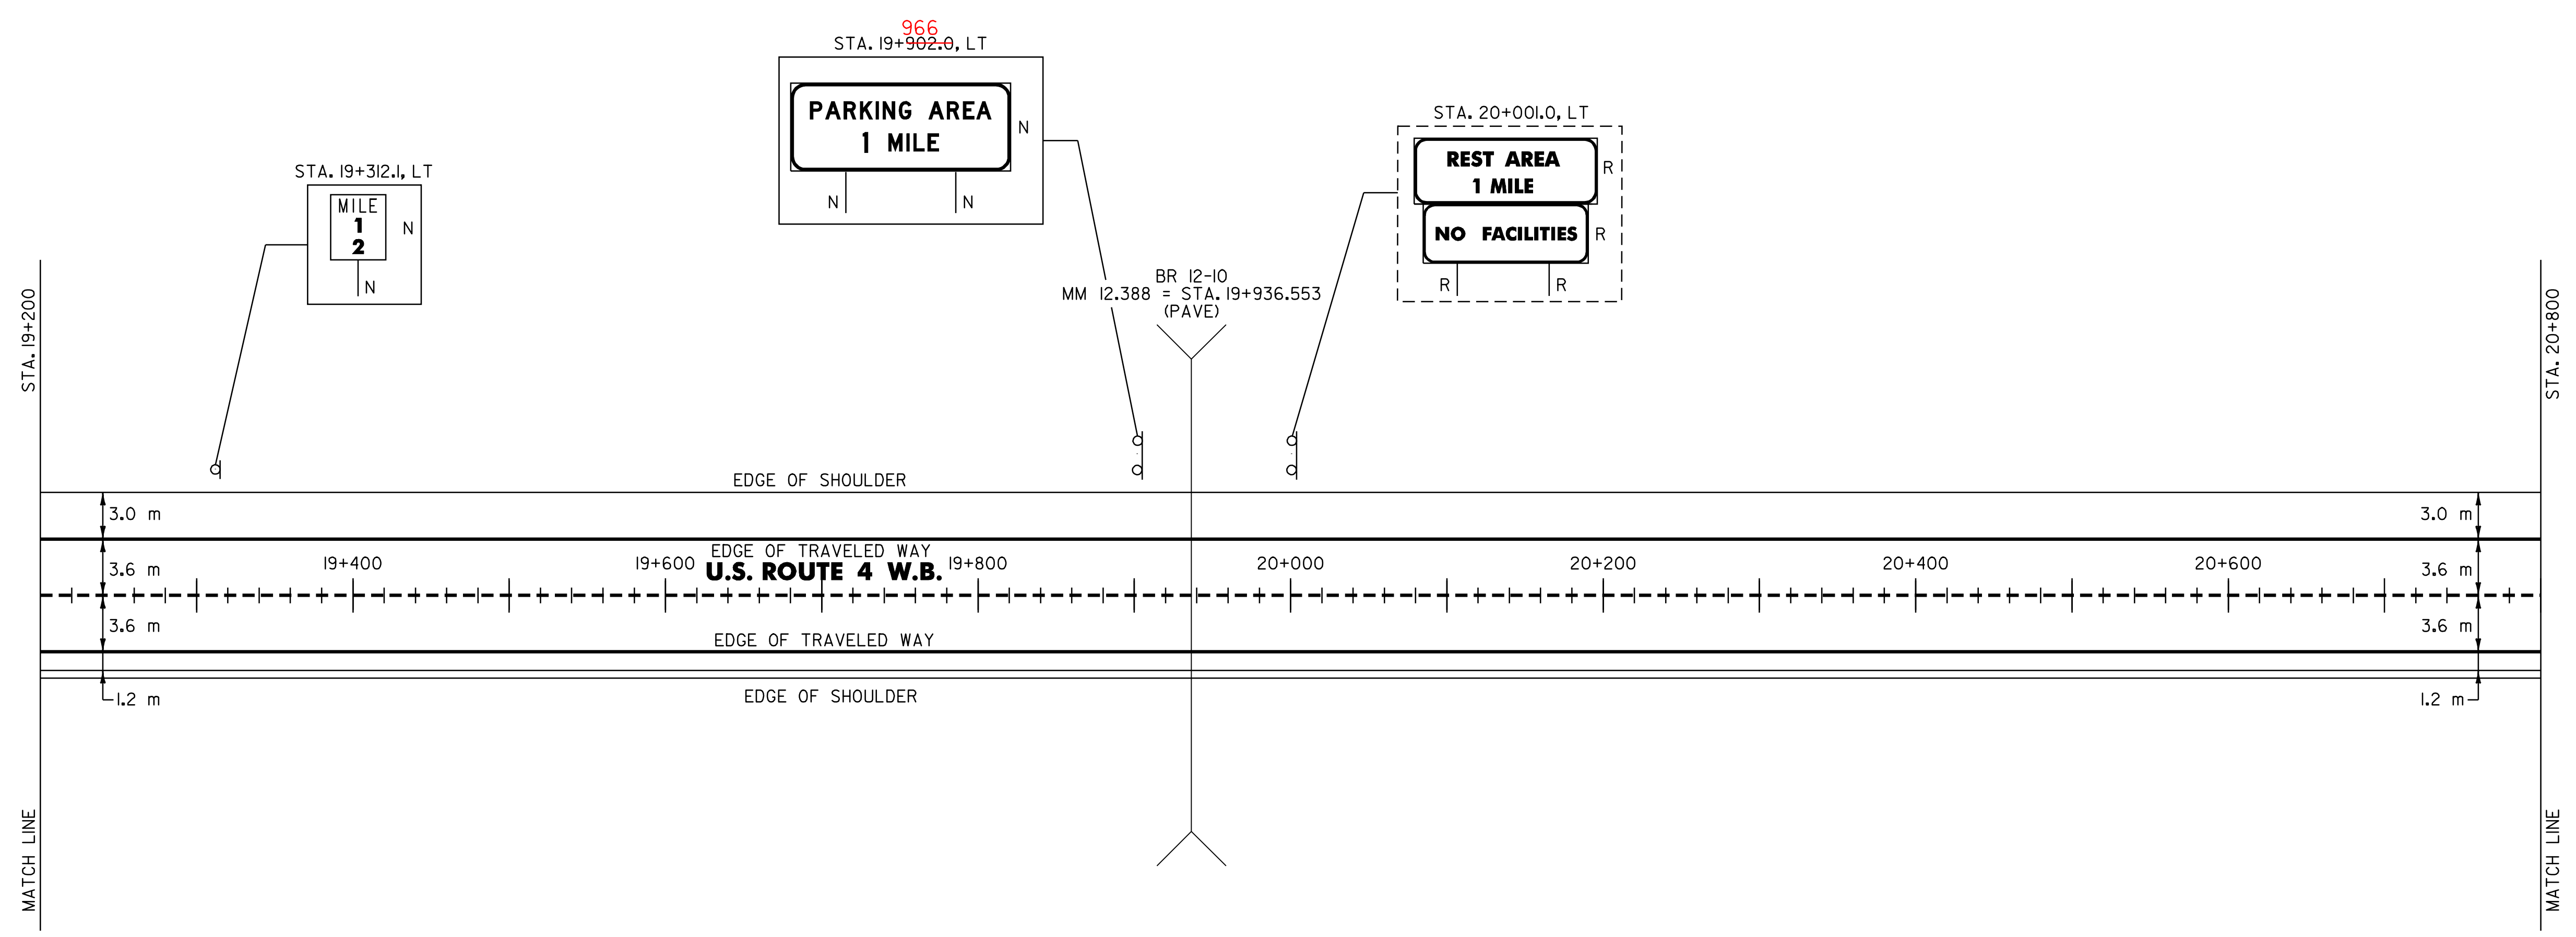

621.20 STEEL BEAM GUARDRAIL
 STA. 19+200.0 - STA. 20+789.0 RT (1589.0 m)

621.54 MODIFIED ECCENTRIC LOADER TERMINAL
 STA. 20+789.0 - STA. 20+800.0 RT

621.80 REMOVAL AND DISPOSAL OF GUARDRAIL
 STA. 19+200.0 - STA. 20+789.0 RT (1589.0 m) 770.0

DATUM	
VERTICAL	N/A
HORIZONTAL	N/A

SIGN LEGEND

R= REMOVE
 S= SALVAGE
 N= NEW
 RET= RETAIN
 B-B= BACK TO BACK
 EXISTING= - - - - -
 NEW= _____

PAVING PROJECT LAYOUT	SURVEYED BY <u>N/A</u> DATE <u>N/A</u>
	DRAWN BY <u>J.N.</u> DATE <u>8/98</u>
	SQUAD LEADER <u>T.P.K.</u>
	DESIGN FILE NO. <u>/pave/96bl54/pbl54.dgn</u>
	IPARM FILE <u>pbl54ll3.i</u> DATE PLOTTED <u>N/A</u>
PROJ. NAME <u>FAIR HAVEN - RUTLAND</u>	
PROJ. NO. <u>NH 9727(I)S</u>	
SHEET <u>24 OF 119</u> SHEETS	