

646.415 DURABLE 150 mm YELLOW LINE
STA. 24+380.000 - STA. 25+600.000 SOLID LINE 3.6 m RT


646.414 DURABLE 150 mm WHITE LINE
S=SOLID, D=DASHED
LT C RT
STA. 24+380.000 - STA. 25+600.000
STA. 24+380.000 - STA. 25+600.000 SOLID LINE 3.6 m LT

675.50 REMOVING SIGNS
AS SHOWN - 10

646.615 TEMPORARY 150 mm YELLOW LINE

STA. 24+380.000 - STA. 25+600.000 SOLID LINE 3.6 m RT

646.614 TEMPORARY 150 mm WHITE LINE
S=SOLID, D=DASHED
LT C RT
STA. 24+380.000 - STA. 25+600.000
STA. 24+380.000 - STA. 25+600.000 SOLID LINE 3.6 m LT

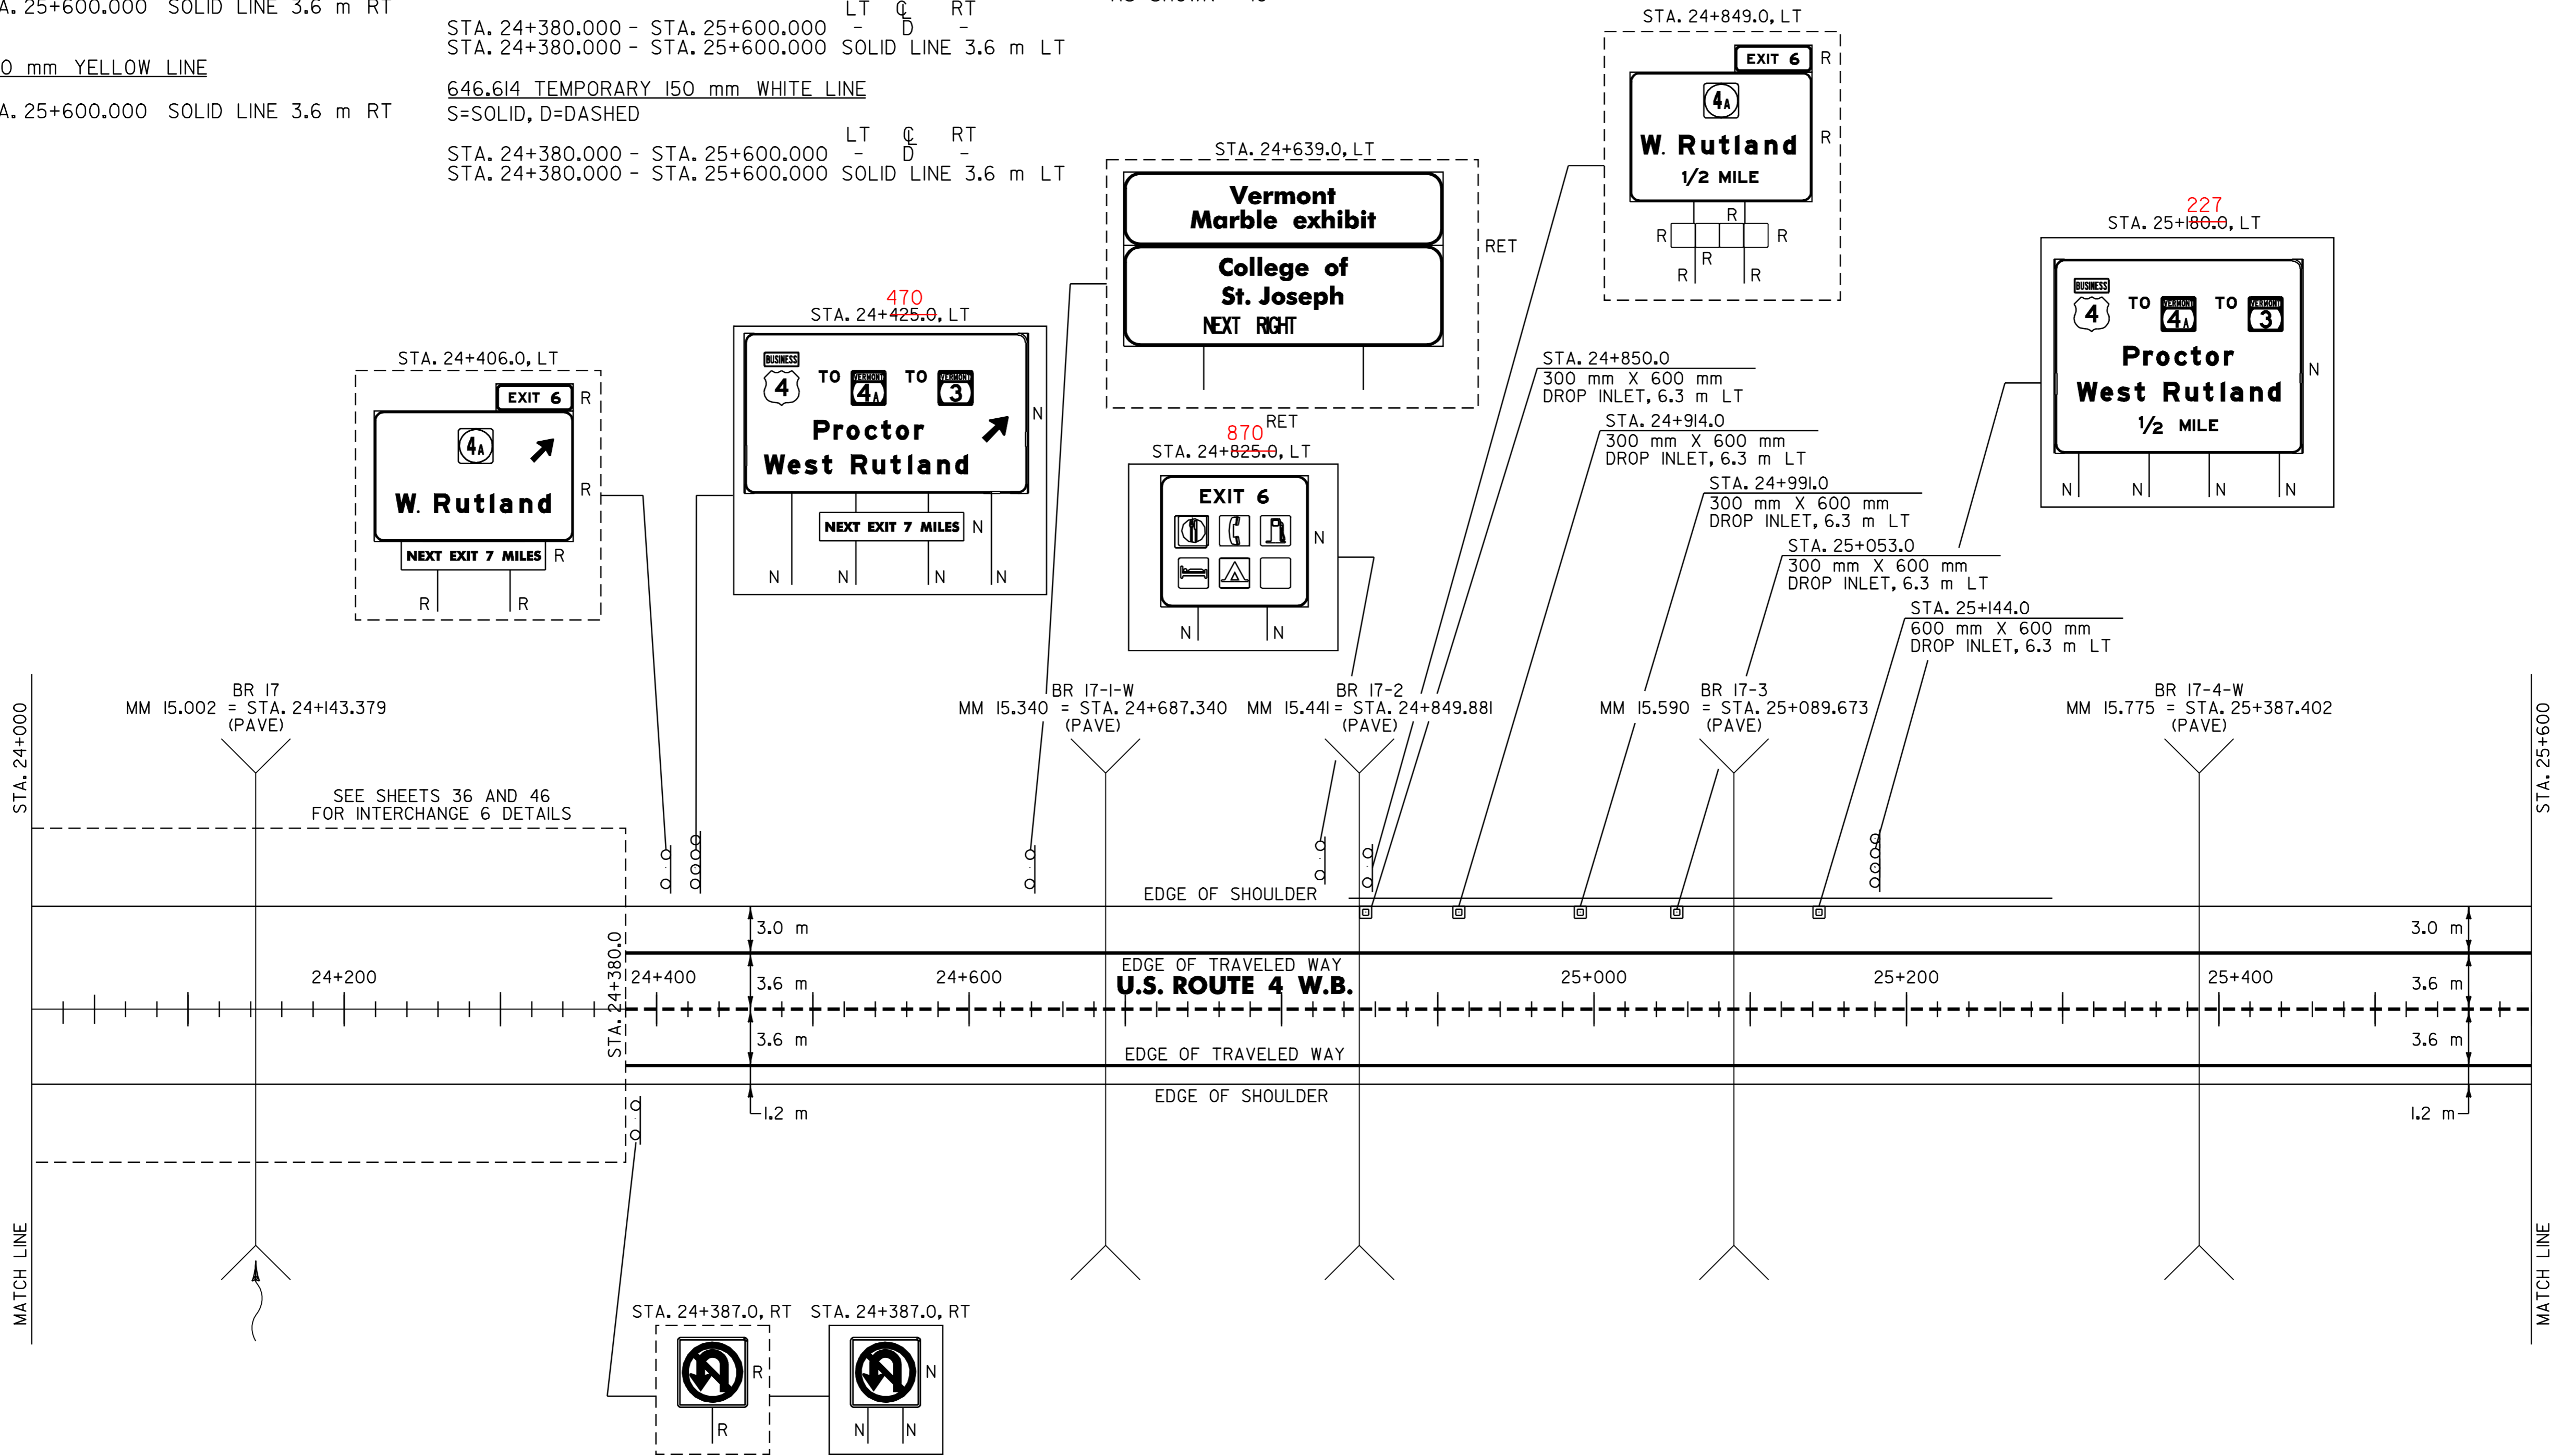

621.54 MODIFIED ECCENTRIC LOADER TERMINAL
STA. 25+282.0 - STA. 25+293.4 LT

620.75 SNOW BARRIER - GALVANIZED
24+132 - 24+154.2 LT BR#17 W

CHANGING ELEVATION OF DI'S, CB'S OR MH'S
REHABING DI'S, CB'S OR MH'S
SEE NOTE 4, SHEET 3 OF 119

621.75 REMOVING AND RESET GUARDRAIL
STA. 24+843.0 - STA. 25+217.4 LT (38.0 m)

STA. 24+850.0 LT
STA. 24+914.0 LT
STA. 24+991.0 LT
STA. 25+053.0 LT
STA. 25+144.0 LT

621.76 REPLACE GUARDRAIL POST ASSEMBLY w/1.8 m WOOD POST
STA. 24+843.0 - STA. 25+217.4 LT (15 EA)

621.20 STEEL BEAM GUARDRAIL
STA. 25+217.4 - STA. 25+282.0 LT (64.6 m)

621.77 REPLACE GUARDRAIL BEAM UNIT
STA. 24+843.0 - STA. 25+217.4 LT (5 EA)
STA. 24+972 - 25+269.5 LT 10 EA

621.80 REMOVAL AND DISPOSAL OF GUARDRAIL
263 STA. 25+217.4 - STA. 25+225.0 LT (7.6 m) 274
STA. 24+152 - STA. 24+164 LT

SIGN LEGEND
R= REMOVE
S= SALVAGE
N= NEW
RET= RETAIN
B-B= BACK TO BACK
EXISTING= - - - - -
NEW= _____

PAVING PROJECT LAYOUT

SURVEYED BY	N/A	DATE	N/A
DRAWN BY	J.N.	DATE	8/98
SQUAD LEADER	T.P.K.		
DESIGN FILE NO.	/pave/96b154/pbl54.dgn		
IPARM FILE	pbl54i16.i	DATE PLOTTED	N/A
PROJ. NAME	FAIR HAVEN - RUTLAND		
PROJ. NO.	NH 9727(I)S		
SHEET	27 OF 119	SHEETS	

DATUM	
VERTICAL	N/A
HORIZONTAL	N/A