


646.415 DURABLE 150 mm YELLOW LINE
 STA. 25+600.000 - STA. 27+200.000 SOLID LINE 3.6 m RT

646.414 DURABLE 150 mm WHITE LINE
 S=SOLID, D=DASHED
 STA. 25+600.000 - STA. 27+200.000 LT C RT
 STA. 25+600.000 - STA. 27+200.000 SOLID LINE 3.6 m LT

675.50 REMOVING SIGNS
 AS SHOWN - 3

646.615 TEMPORARY 150 mm YELLOW LINE
 STA. 25+600.000 - STA. 27+200.000 SOLID LINE 3.6 m RT

646.614 TEMPORARY 150 mm WHITE LINE
 S=SOLID, D=DASHED
 STA. 25+600.000 - STA. 27+200.000 LT C RT
 STA. 25+600.000 - STA. 27+200.000 SOLID LINE 3.6 m LT

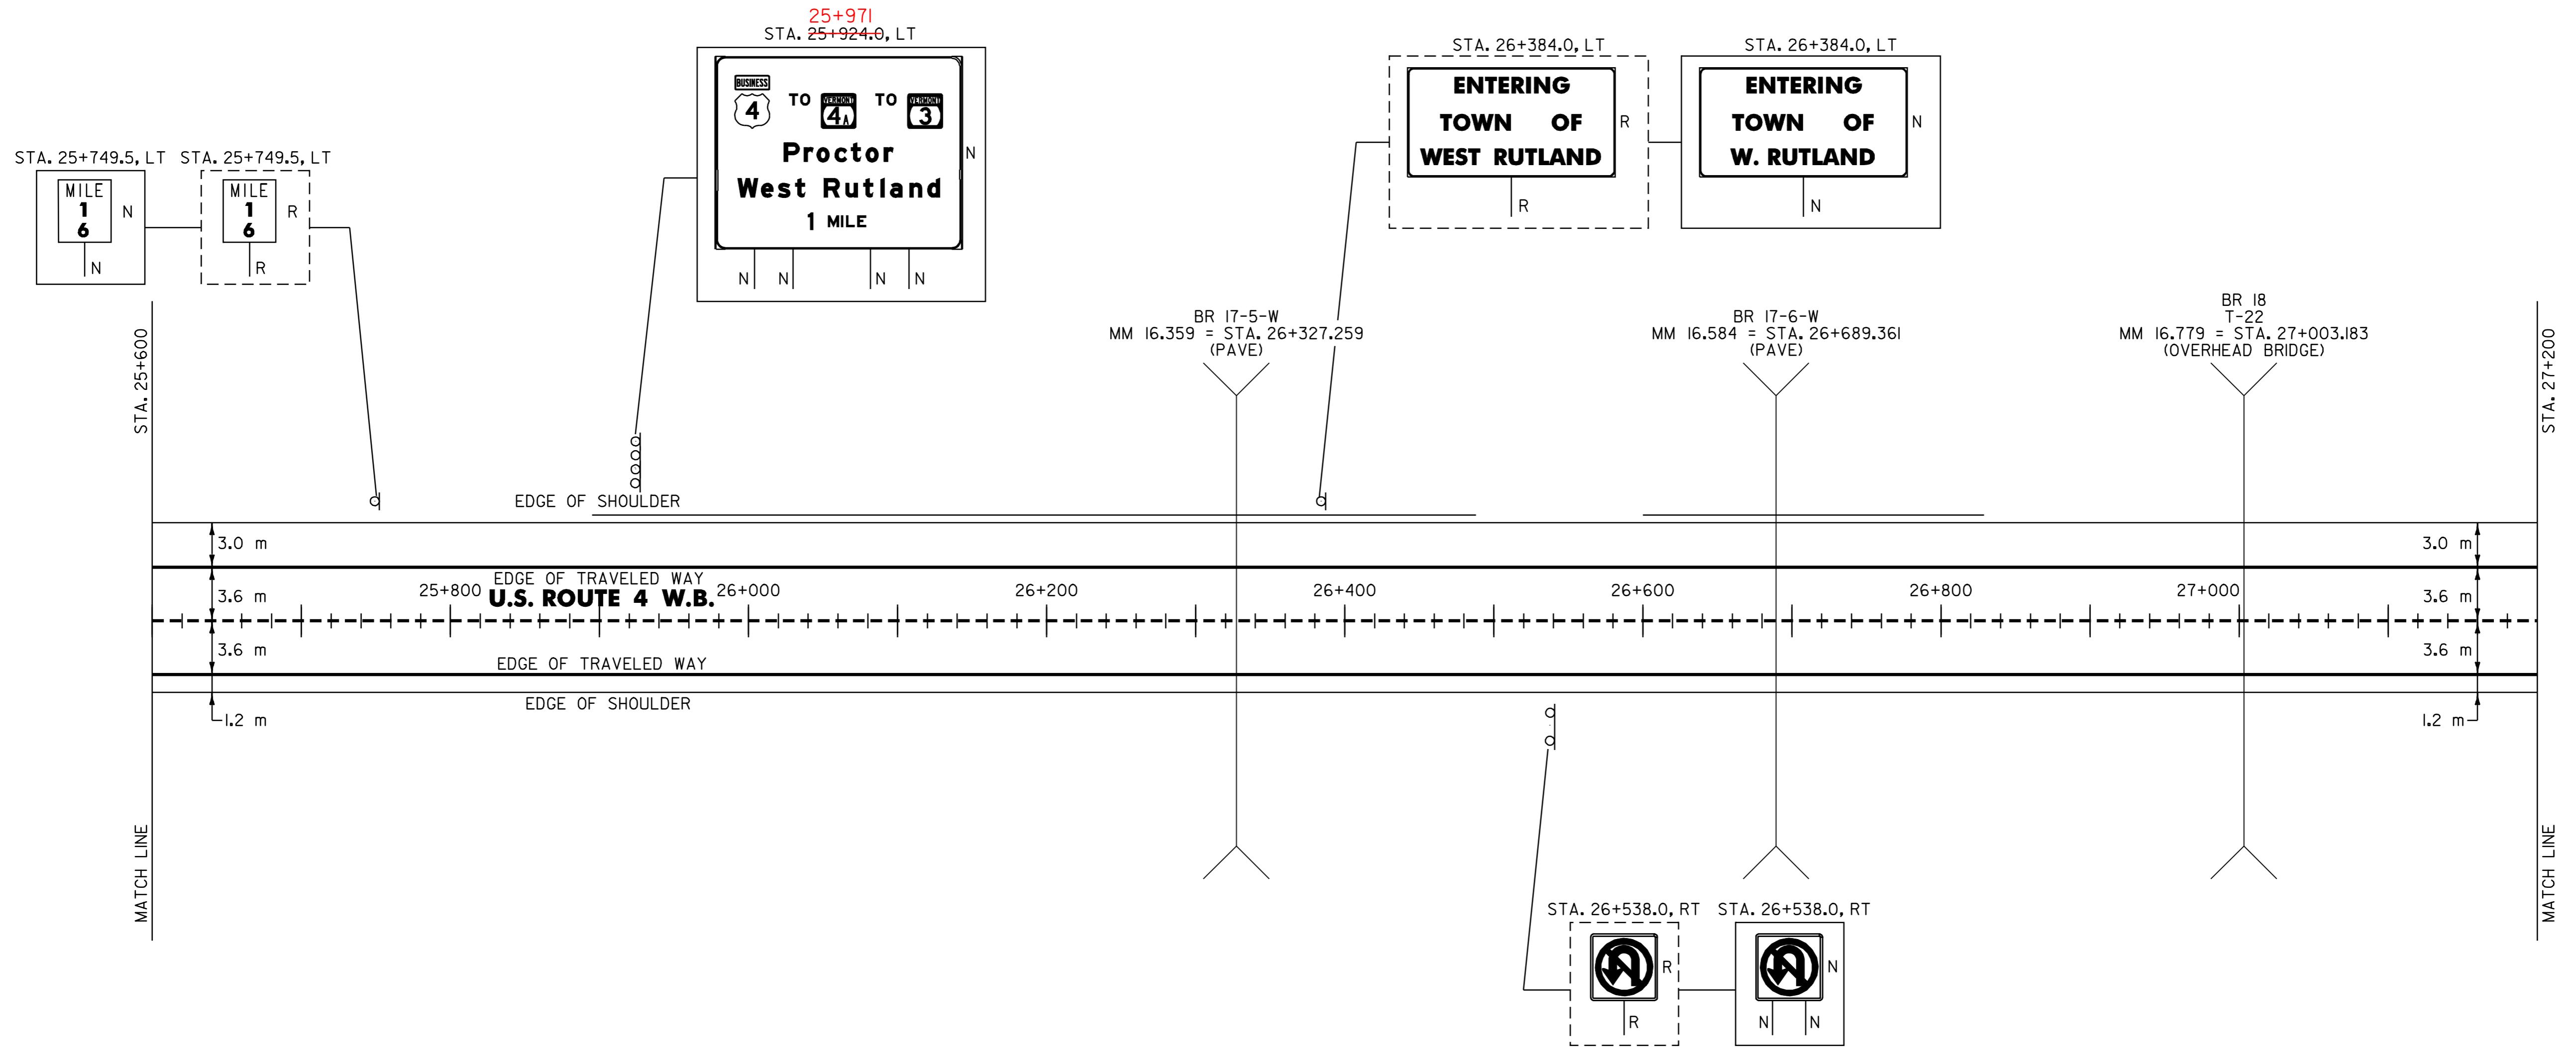

621.77 REPLACE GUARDRAIL BEAM UNIT
 26+043 - 26+188.6 LT (6 EA)

SIGN LEGEND
 R= REMOVE
 S= SALVAGE
 N= NEW
 RET= RETAIN
 B-B= BACK TO BACK
 EXISTING= - - - - -
 NEW= _____

PAVING PROJECT LAYOUT

SURVEYED BY N/A DATE N/A
 DRAWN BY J.N. DATE 8/98
 SQUAD LEADER T.P.K.
 DESIGN FILE NO. /pave/96bl54/pbl54.dgn
 IPARM FILE pbl54ll7.i DATE PLOTTED N/A
 PROJ. NAME FAIR HAVEN - RUTLAND
 PROJ. NO. NH 9727(I)S
 SHEET 28 OF 119 SHEETS

DATUM	
VERTICAL	<u>N/A</u>
HORIZONTAL	<u>N/A</u>