

646.415 DURABLE 150 mm YELLOW LINE

STA. 27+200.000 - STA. 28+800.000 SOLID LINE 3.6 m RT

646.615 TEMPORARY 150 mm YELLOW LINE

STA. 27+200.000 - STA. 28+800.000 SOLID LINE 3.6 m RT

646.414 DURABLE 150 mm WHITE LINE

S=SOLID, D=DASHED

STA. 27+200.000 - STA. 28+800.000 LT C RT  
 STA. 27+200.000 - STA. 28+800.000 SOLID LINE 3.6 m LT


646.614 TEMPORARY 150 mm WHITE LINE

S=SOLID, D=DASHED

STA. 27+200.000 - STA. 28+800.000 LT C RT  
 STA. 27+200.000 - STA. 28+800.000 SOLID LINE 3.6 m LT

675.50 REMOVING SIGNS

AS SHOWN - 5

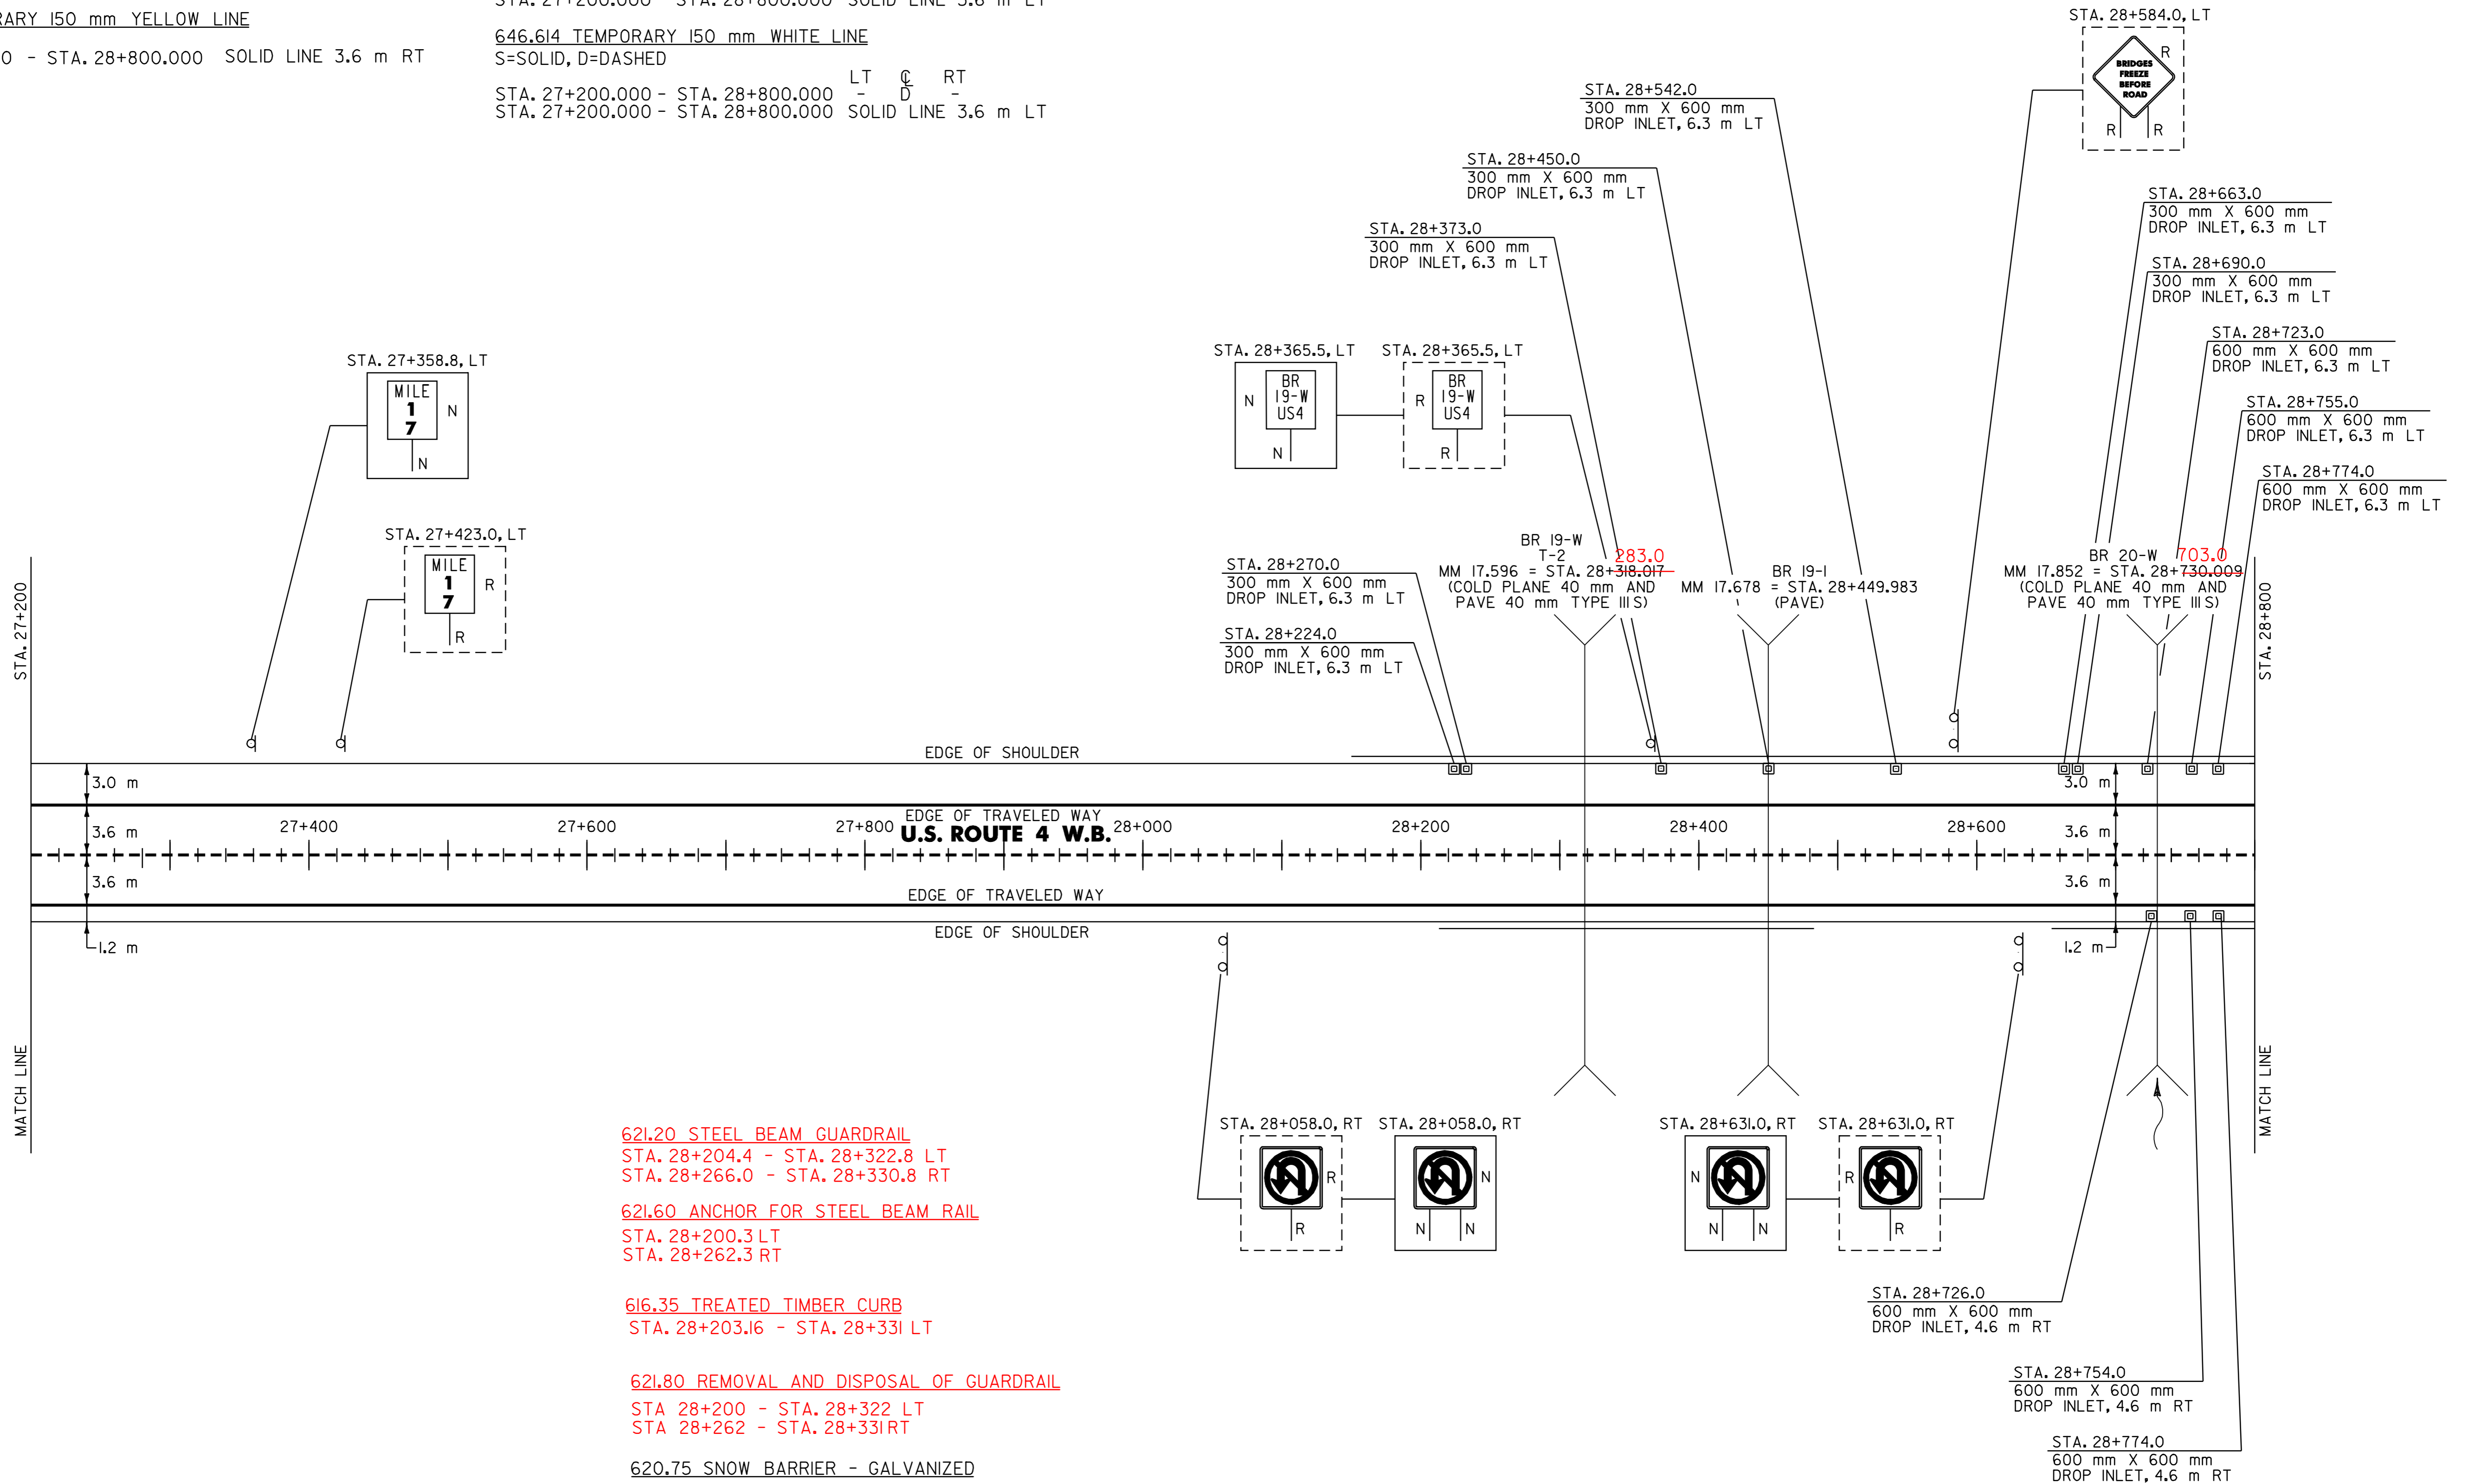

**621.20 STEEL BEAM GUARDRAIL**  
 STA. 28+204.4 - STA. 28+322.8 LT  
 STA. 28+266.0 - STA. 28+330.8 RT

**621.60 ANCHOR FOR STEEL BEAM RAIL**  
 STA. 28+200.3 LT  
 STA. 28+262.3 RT

**616.35 TREATED TIMBER CURB**  
 STA. 28+203.16 - STA. 28+331 LT

**621.80 REMOVAL AND DISPOSAL OF GUARDRAIL**  
 STA 28+200 - STA. 28+322 LT  
 STA 28+262 - STA. 28+331 RT

**620.75 SNOW BARRIER - GALVANIZED**  
 STA. 28+318.0 - STA. 28+337.0 LT (19.0 m)  
 STA. 28+323.0 - STA. 28+342.0 RT (19.0 m)

**621.75 REMOVING AND RESET GUARDRAIL**  
 STA. 28+150.0 - STA. 28+800.0 LT (68.4 m)

**621.76 REPLACE GUARDRAIL POST ASSEMBLY w/1.8 m WOOD POST**  
 STA. 28+150.0 - STA. 28+800.0 LT (30 EA)

**621.77 REPLACE GUARDRAIL BEAM UNIT**  
 STA. 28+150.0 - STA. 28+800.0 LT (40 EA)  
 400 3

CHANGING ELEVATION OF DI'S, CB'S OR MH'S  
 REHABING DI'S, CB'S OR MH'S  
 SEE NOTE 4, SHEET 3 OF 119

- STA. 28+224.0 LT
- STA. 28+270.0 LT
- STA. 28+373.0 LT
- STA. 28+450.0 LT
- STA. 28+542.0 LT
- STA. 28+663.0 LT
- STA. 28+690.0 LT
- STA. 28+723.0 LT
- STA. 28+726.0 RT
- STA. 28+754.0 RT
- STA. 28+755.0 LT
- STA. 28+774.0 LT & RT

**SIGN LEGEND**

- R= REMOVE
- S= SALVAGE
- N= NEW
- RET= RETAIN
- B-B= BACK TO BACK
- EXISTING= - - - - -
- NEW= \_\_\_\_\_

**PAVING PROJECT LAYOUT**

SURVEYED BY	N/A	DATE	N/A
DRAWN BY	J.N.	DATE	8/98
SQUAD LEADER	T.P.K.		
DESIGN FILE NO.	/pave/96b154/pbl54.i		
IPARM FILE	pbl54i18.i	DATE PLOTTED	N/A
PROJ. NAME	FAIR HAVEN - RUTLAND		
PROJ. NO.	NH 9727(1)S		
SHEET	29 OF 119	SHEETS	

DATUM	
VERTICAL	N/A
HORIZONTAL	N/A