

646.415 DURABLE 150 mm YELLOW LINE

STA. 28+800.000 - STA. 29+567.096 SOLID LINE 3.6 m RT
 STA. 29+576.296 - STA. 30+060.000 SOLID LINE 3.6 m RT

646.615 TEMPORARY 150 mm YELLOW LINE

STA. 28+800.000 - STA. 29+567.096 SOLID LINE 3.6 m RT
 STA. 29+576.296 - STA. 30+060.000 SOLID LINE 3.6 m RT

646.414 DURABLE 150 mm WHITE LINE

S=SOLID, D=DASHED
 STA. 28+800.000 - STA. 29+567.096 LT C RT
 STA. 29+576.296 - STA. 30+060.000 - D -
 STA. 28+800.000 - STA. 29+567.096 SOLID LINE 3.6 m LT
 STA. 29+576.296 - STA. 30+060.000 SOLID LINE 3.6 m LT

646.614 TEMPORARY 150 mm WHITE LINE

S=SOLID, D=DASHED
 STA. 28+800.000 - STA. 29+567.096 - D -
 STA. 29+576.296 - STA. 30+060.000 - D -
 STA. 28+800.000 - STA. 29+567.096 SOLID LINE 3.6 m LT
 STA. 29+576.296 - STA. 30+060.000 SOLID LINE 3.6 m LT

646.50 DURABLE LETTER OR SYMBOL

STA. 29+907.950 RT, "A,H,E,A,D" (5 EA)
 STA. 29+907.950 LT, "A,H,E,A,D" (5 EA)
 STA. 29+920.050 RT, "S,I,G,N,A,L" (6 EA)
 STA. 29+920.050 LT, "S,I,G,N,A,L" (6 EA)

646.70 TEMPORARY LETTER OR SYMBOL


STA. 29+907.950 RT, "A,H,E,A,D" (5 EA)
 STA. 29+907.950 LT, "A,H,E,A,D" (5 EA)
 STA. 29+920.050 RT, "S,I,G,N,A,L" (6 EA)
 STA. 29+920.050 LT, "S,I,G,N,A,L" (6 EA)

646.52 DURABLE RAILROAD CROSSING SYMBOL

STA. 29+845.000 RT
 STA. 29+845.000 LT

675.50 REMOVING SIGNS

AS SHOWN - 13

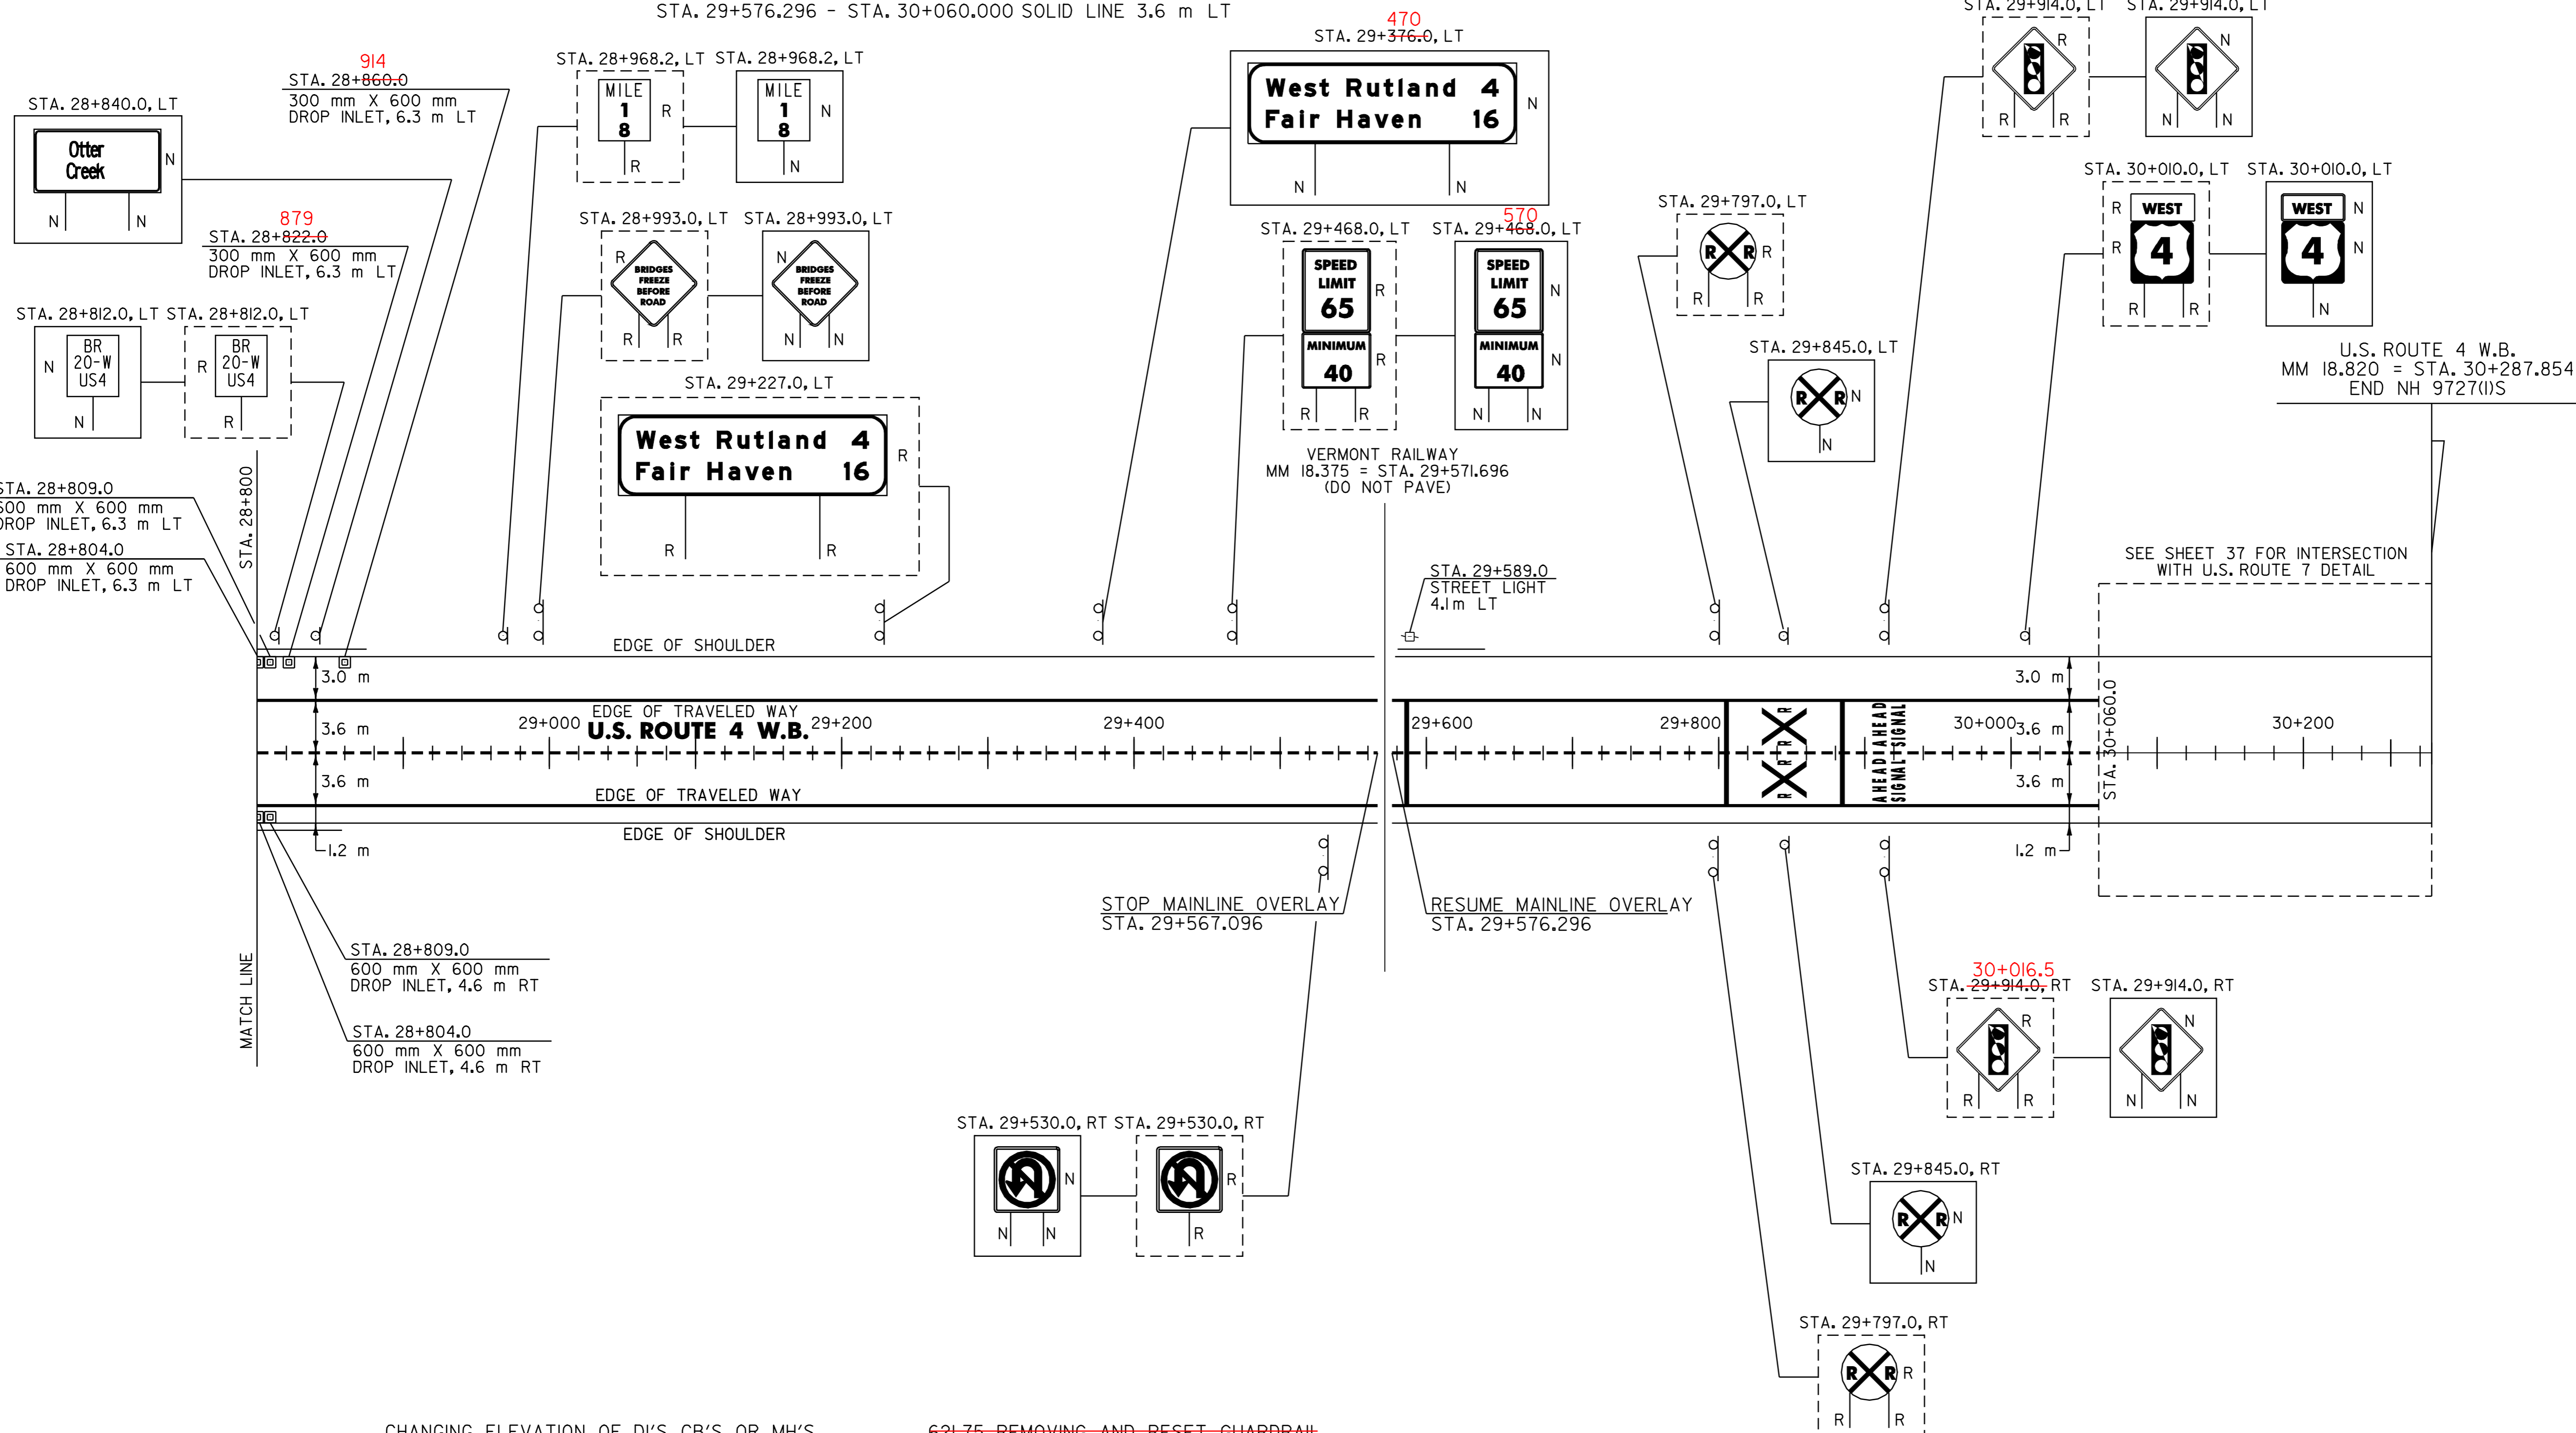

CHANGING ELEVATION OF DI'S, CB'S OR MH'S
 REHABING DI'S, CB'S OR MH'S
 SEE NOTE 4, SHEET 3 OF I19

STA. 28+804.0 LT & RT
 STA. 28+809.0 LT & RT
 STA. 28+822.0 LT
 STA. 28+860.0 RT

621.20 STEEL BEAM GUARDRAIL
 STA. 29+581.4 - STA. 29+596.6 LT (15.2 m)
 STA. 29+617.4 - STA. 29+628.8 LT (11.4 m)

621.54 MODIFIED ECCENTRIC LOADER TERMINAL
 STA. 29+628.8 - STA. 29+640.2 LT

~~621.75 REMOVING AND RESET GUARDRAIL~~
~~STA. 28+800.0 - STA. 28+875.0 LT (7.6 m)~~

~~621.76 REPLACE GUARDRAIL POST ASSEMBLY w/1.8 m WOOD POST~~
~~STA. 28+800.0 - STA. 28+875.0 LT (6 EA)~~

~~621.77 REPLACE GUARDRAIL BEAM UNIT~~
~~STA. 28+800.0 - STA. 28+875.0 LT (2 EA)~~

621.80 REMOVAL AND DISPOSAL OF GUARDRAIL
 672 STA. 29+581.4 - STA. 29+596.6 LT (15.2 m) 725
~~STA. 29+617.4 - STA. 29+625.0 LT (7.6 m)~~

SIGN LEGEND
 R= REMOVE
 S= SALVAGE
 N= NEW
 RET= RETAIN
 B=B= BACK TO BACK
 EXISTING= - - - - -
 NEW= _____

PAVING PROJECT LAYOUT	SURVEYED BY <u>N/A</u> DATE <u>N/A</u>
	DRAWN BY <u>J.N.</u> DATE <u>8/98</u>
	SQUAD LEADER <u>T.P.K.</u>
	DESIGN FILE NO. <u>/pave/96bl54/pbl54.dgn</u>
	IPARM FILE <u>pbl54.i9.i</u> DATE PLOTTED <u>N/A</u>
PROJ. NAME <u>FAIR HAVEN - RUTLAND</u>	
PROJ. NO. <u>NH 9727(I)S</u>	
SHEET <u>30 OF I19</u> SHEETS	

DATUM	
VERTICAL	N/A
HORIZONTAL	N/A