

675.50 REMOVING SIGNS

AS SHOWN - 33

621.75 REMOVING AND RESET GUARDRAIL


STA. 0+016.1 - STA. 0+135.0 RT (15.2 m)
 STA. 0+016.1 - STA. 0+181.0 LT (19.0 m)

621.76 REPLACE GUARDRAIL POST ASSEMBLY

STA. 0+016.1 - STA. 0+135.0 RT (12 EA) 0+070 RT (2 EA)
 STA. 0+016.1 - STA. 0+181.0 LT (4 EA)

621.77 REPLACE GUARDRAIL BEAM UNIT

STA. 0+016.1 - STA. 0+135.0 RT (3 EA) 0+070 RT
 STA. 0+016.1 - STA. 0+181.0 LT (1 EA)

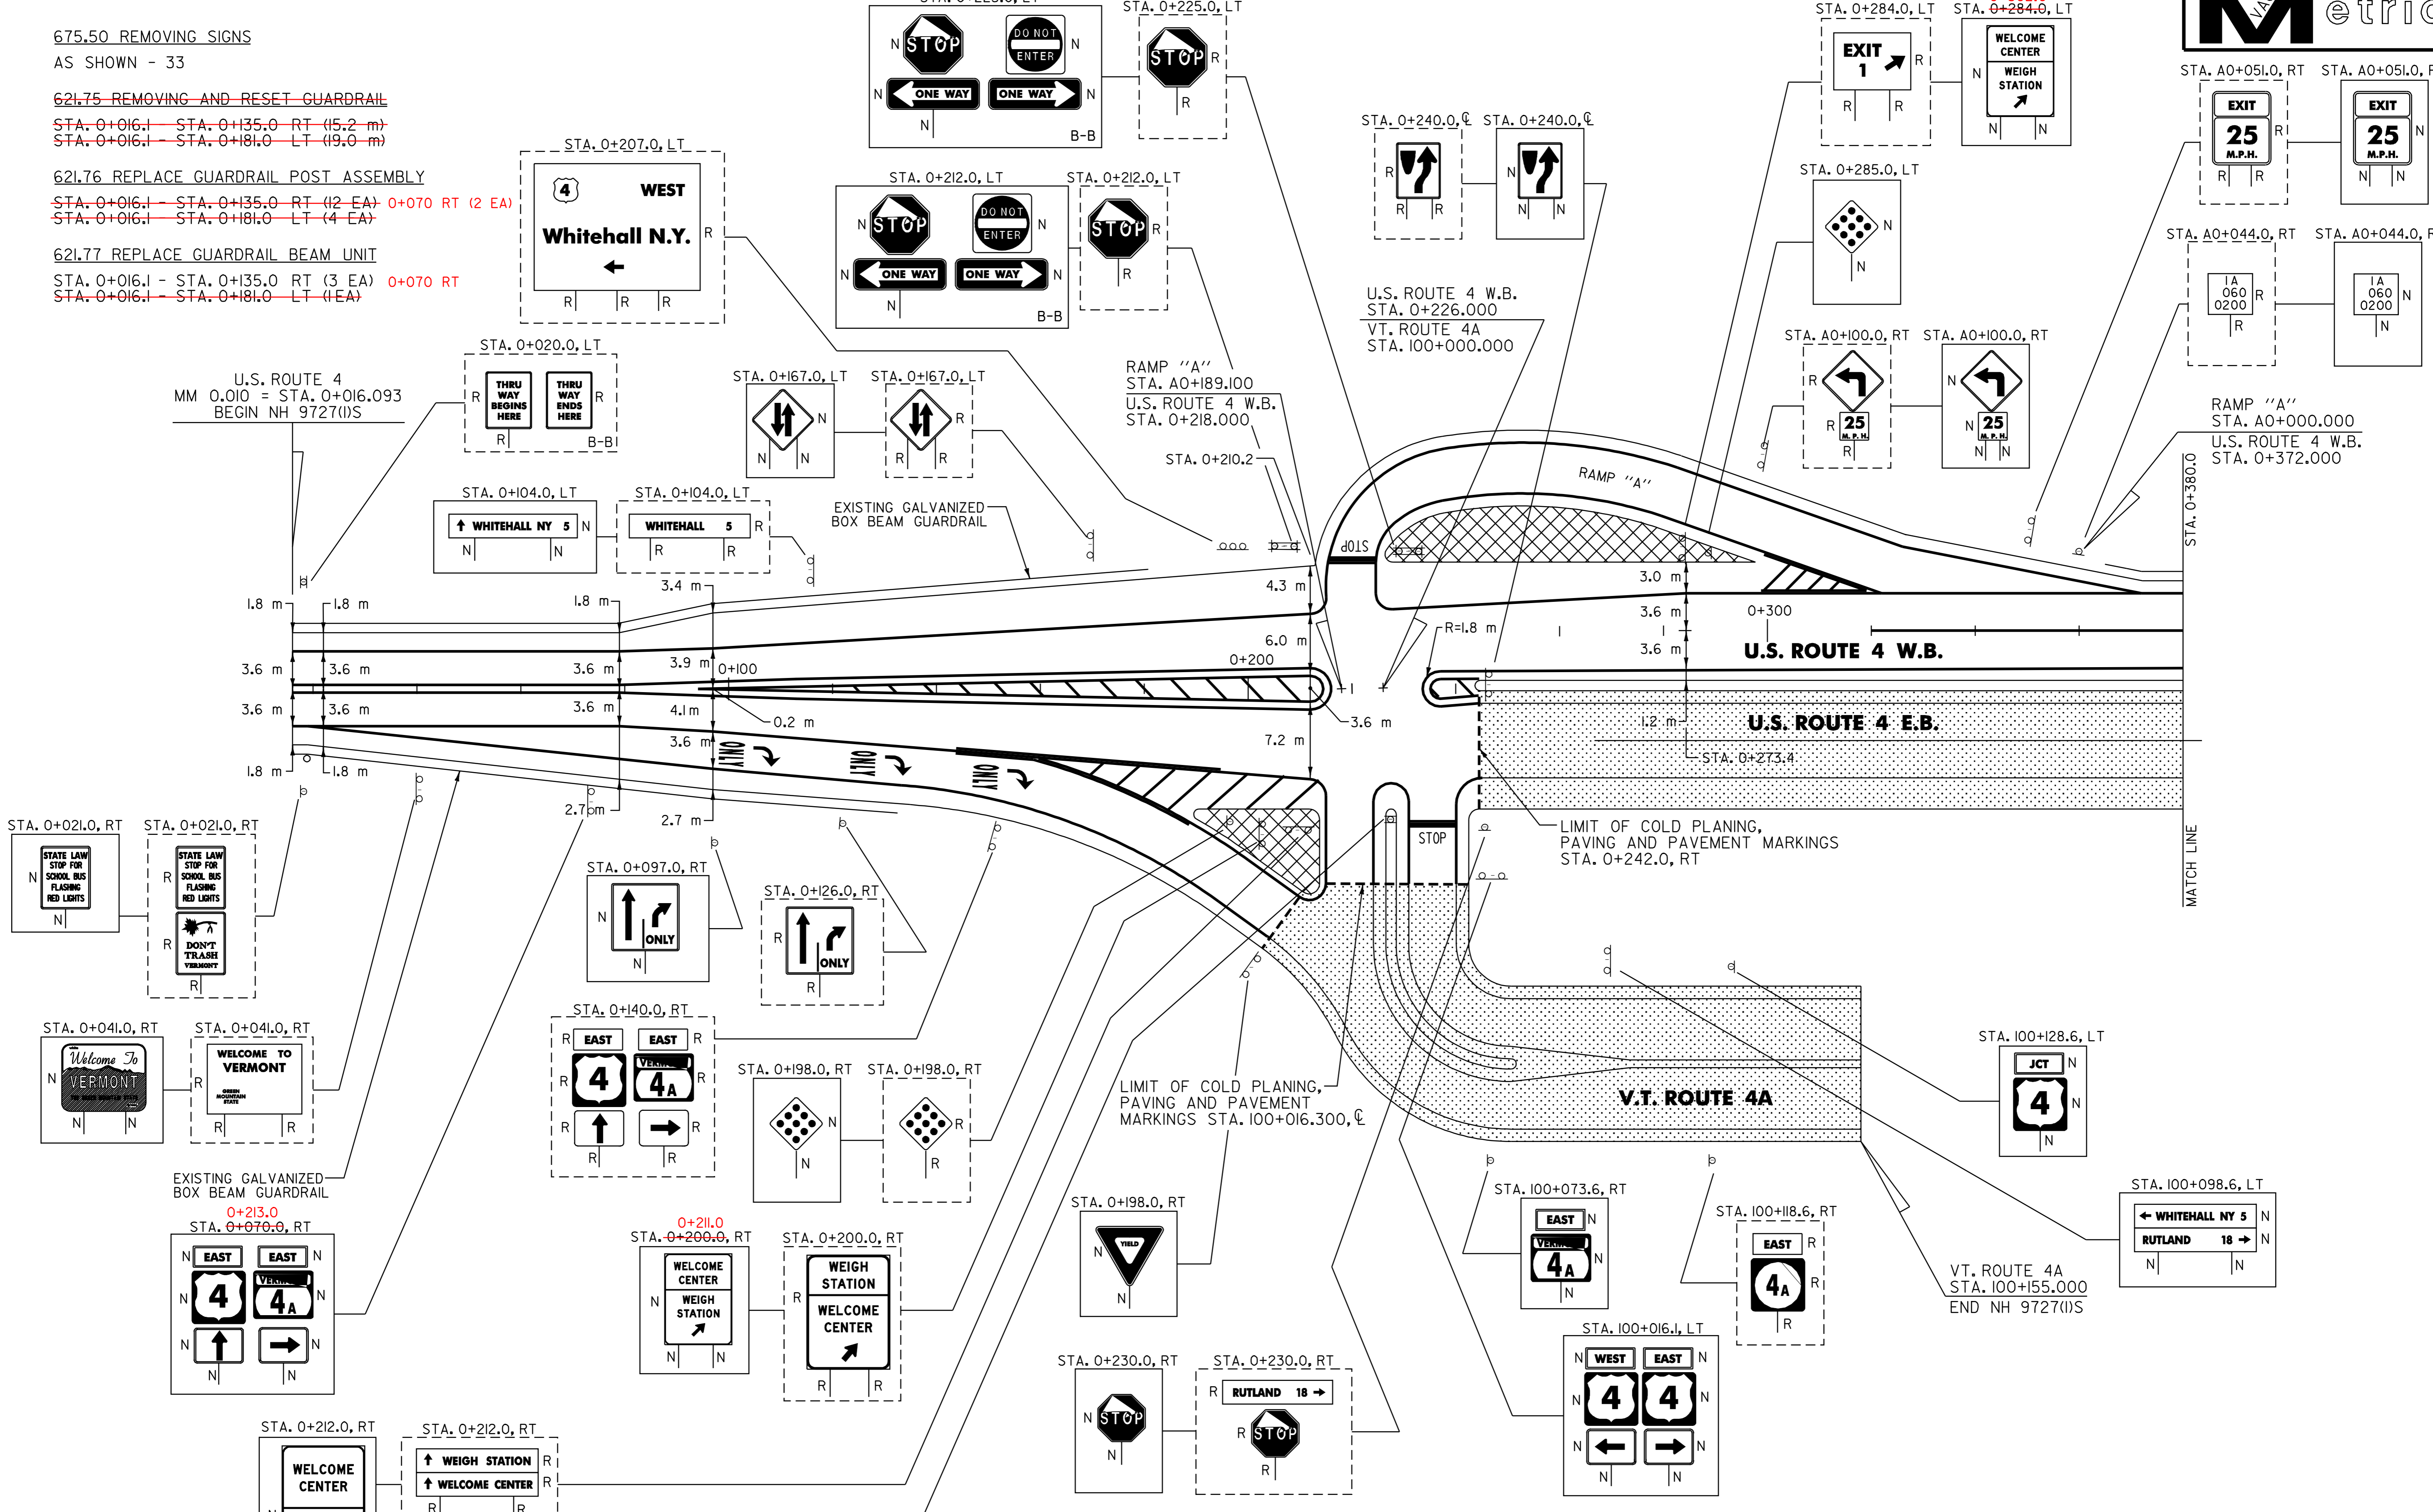

DATUM
 VERTICAL N/A
 HORIZONTAL N/A

- SIGN LEGEND**
- R= REMOVE
 - S= SALVAGE
 - N= NEW
 - RET= RETAIN
 - B-B= BACK TO BACK
 - EXISTING=
 - NEW=

INTERCHANGE NO. 1 SIGN & GUARDRAIL DETAIL SHEET

SURVEYED BY N/A DATE N/A
 DRAWN BY T.J.B. DATE 8/98
 SQUAD LEADER T.P.K.
 DESIGN FILE N0/pave/96b154/pb154.dgn
 IPARM FILE pb154d03.i DATE N/A PLOTTED N/A
 PROJ. NAME FAIR HAVEN - RUTLAND
 PROJ. NO. NH 9727(I)S
 SHEET 31 OF 119 SHEETS