

646.415 DURABLE 150 mm YELLOW LINE
STA. 17+780.000 - STA. 18+360.000 RT, SOLID LINE 3.6 m
STA. 18+084.000 - STA. 18+140.000 LT, SOLID LINE (PARKING AREA)
STA. 18+200.000 - STA. 18+213.000 LT, SOLID LINE (PARKING AREA)

646.615 TEMPORARY 150 mm YELLOW LINE
STA. 17+780.000 - STA. 18+360.000 RT, SOLID LINE 3.6 m
STA. 18+084.000 - STA. 18+140.000 LT, SOLID LINE (PARKING AREA)
STA. 18+200.000 - STA. 18+213.000 LT, SOLID LINE (PARKING AREA)

676.10 DELINEATOR WITH STEEL POSTS
STA. 17+780.000 - STA. 18+360.000, LT - 15 EA

676.12 REMOVAL OF EXISTING DELINEATORS
STA. 17+780.000 - STA. 18+360.000, LT - 15 EA (EST.)


646.42 DURABLE 200 mm WHITE LINE
STA. 18+045.000 - STA. 18+084.000 LT 78.0 m (GORE STRIPING)
STA. 18+213.000 - STA. 18+254.000 LT 150.0 m (GORE STRIPING AND HATCHING)

646.62 TEMPORARY 200 mm WHITE LINE
STA. 18+045.000 - STA. 18+084.000 LT 78.0 m (GORE STRIPING)
STA. 18+213.000 - STA. 18+254.000 LT 150.0 m (GORE STRIPING AND HATCHING)

646.414 DURABLE 150 mm WHITE LINE
S=SOLID, D=DASHED
LT C RT
D - -
STA. 17+780.000 - STA. 18+360.000 - - -
STA. 17+780.000 - STA. 18+360.000 LT, SOLID LINE
STA. 17+914.500 - STA. 18+045.000 LT, DASHED LINE (LANE LINE)
STA. 18+045.000 - STA. 18+140.000 LT, SOLID LINE (PARKING AREA)
STA. 18+200.000 - STA. 18+254.000 LT, SOLID LINE (PARKING AREA)
STA. 18+254.000 - STA. 18+320.500 LT, DASHED LINE (LANE LINE)

646.614 TEMPORARY 150 mm WHITE LINE
S=SOLID, D=DASHED
LT C RT
D - -
STA. 17+780.000 - STA. 18+360.000 - - -
STA. 17+780.000 - STA. 18+360.000 LT, SOLID LINE
STA. 17+914.500 - STA. 18+045.000 LT, DASHED LINE (LANE LINE)
STA. 18+045.000 - STA. 18+140.000 LT, SOLID LINE (PARKING AREA)
STA. 18+200.000 - STA. 18+254.000 LT, SOLID LINE (PARKING AREA)
STA. 18+254.000 - STA. 18+320.500 LT, DASHED LINE (LANE LINE)

646.614 TEMPORARY 150 mm WHITE LINE
S=SOLID, D=DASHED
LT C RT
D - -
STA. 17+780.000 - STA. 18+360.000 - - -
STA. 17+780.000 - STA. 18+360.000 LT, SOLID LINE
STA. 17+914.500 - STA. 18+045.000 LT, DASHED LINE (LANE LINE)
STA. 18+045.000 - STA. 18+140.000 LT, SOLID LINE (PARKING AREA)
STA. 18+200.000 - STA. 18+254.000 LT, SOLID LINE (PARKING AREA)
STA. 18+254.000 - STA. 18+320.500 LT, DASHED LINE (LANE LINE)

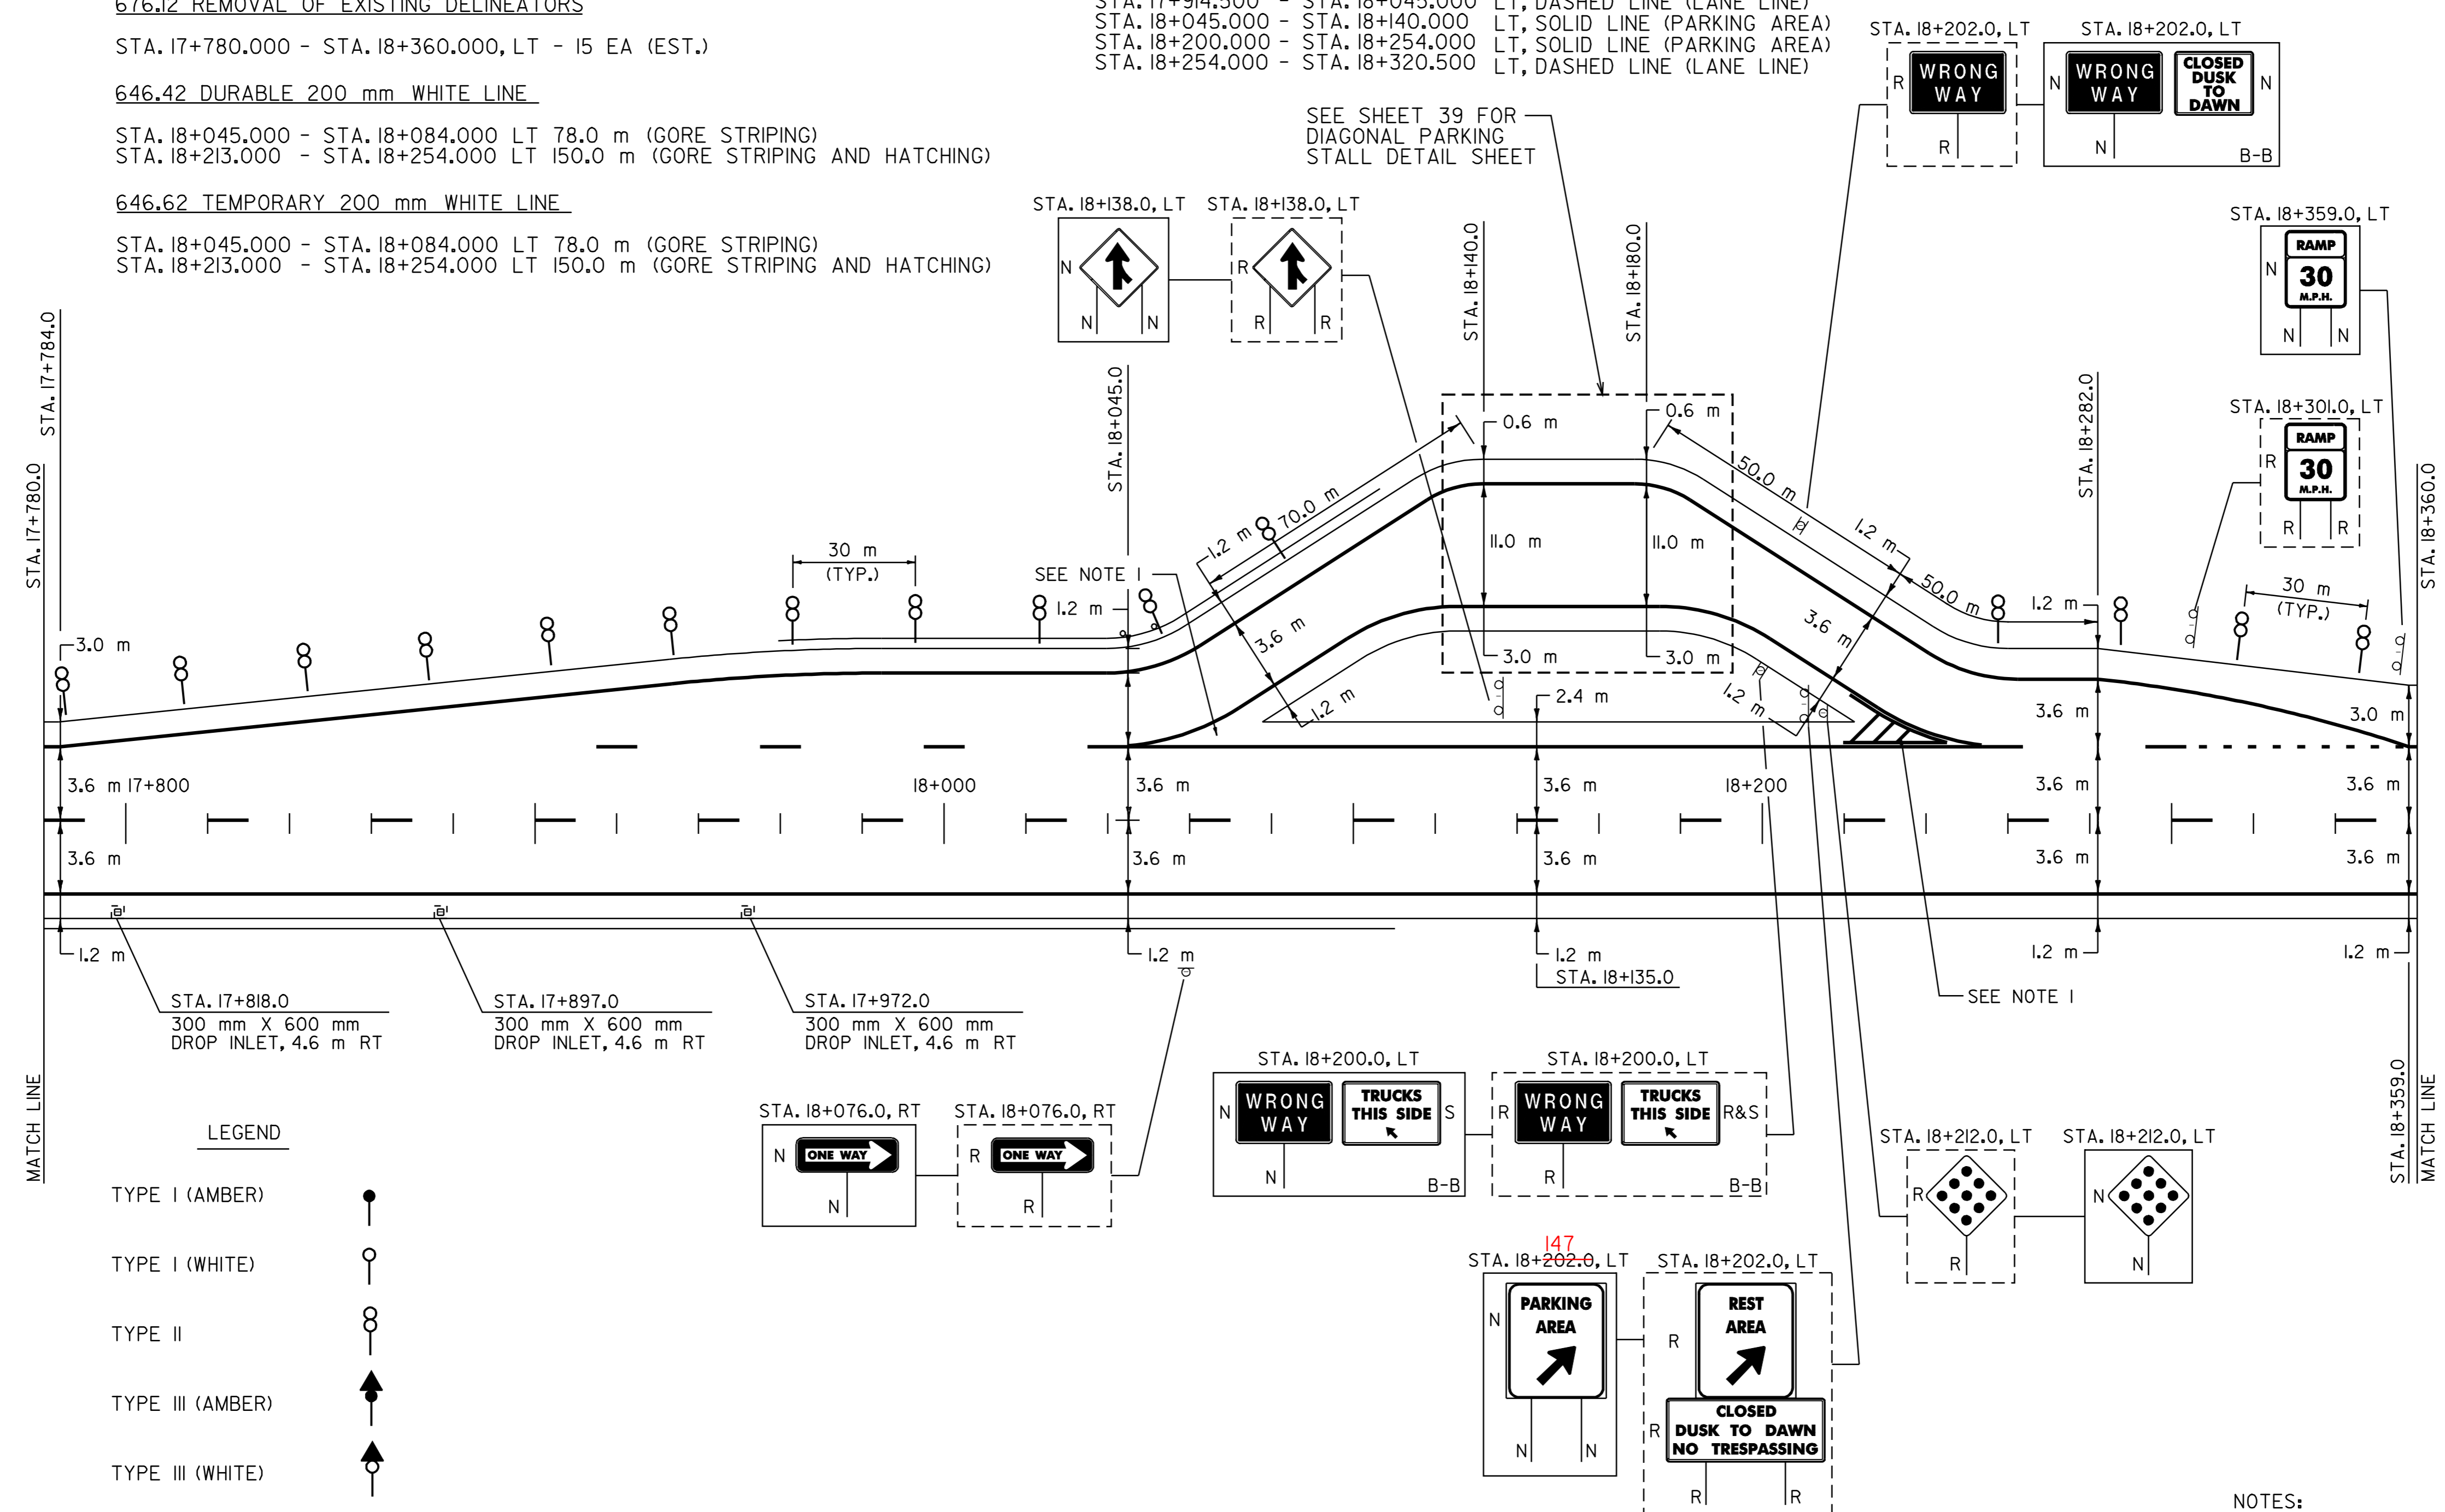

- LEGEND**
- TYPE I (AMBER)
 - TYPE I (WHITE)
 - TYPE II
 - TYPE III (AMBER)
 - TYPE III (WHITE)

616.35 TREATED TIMBER CURB
STA. 17+780.0 - STA. 17+972.0 RT (192.0 m) 915

621.20 STEEL BEAM GUARDRAIL
890 STA. 17+944.8 - STA. 18+124.0 LT (179.2 m) 043
STA. 17+780.0 - STA. 18+061.0 RT

621.20 STEEL BEAM GUARDRAIL W/2.4 m POSTS (MOD.)
STA. 17+780.0 - STA. 18+118.5 RT (338.5 m)

621.54 MODIFIED ECCENTRIC LOADER TERMINAL
062 STA. 18+118.5 - STA. 18+129.9 RT 073
043.6 STA. 18+124.0 - STA. 18+135.4 LT 055

621.60 ANCHOR FOR STEEL BEAM RAIL
STA. 17+945.4 LT 890

621.80 REMOVAL AND DISPOSAL OF GUARDRAIL
STA. 17+780.0 - STA. 18+126.0 RT (346.0 m) 062
890.0 STA. 17+952.0 - STA. 18+124.0 LT (172.0 m) 043.0

CHANGING ELEVATION OF DI'S, CB'S OR MH'S
REHABING DI'S, CB'S OR MH'S
SEE NOTE 4, SHEET 3 OF 119

STA. 17+818.0 RT
STA. 17+897.0 RT
STA. 17+972.0 RT

- SIGN LEGEND**
- R= REMOVE
 - S= SALVAGE
 - N= NEW
 - RET= RETAIN
 - B-B= BACK TO BACK
 - EXISTING=
 - NEW=

**PARKING AREA
DETAIL SHEET**

- NOTES:**
- REFER TO STANDARD SHEETS E-191M, E-192M AND E-193M FOR GORE MARKING DETAILS.
 - REFER TO STANDARD SHEETS E-197M TO E-199M FOR DELINEATOR DETAILS.

DATUM	
VERTICAL	N/A
HORIZONTAL	N/A

SURVEYED BY	N/A	DATE	N/A
DRAWN BY	T.J.B.	DATE	8/98
SQUAD LEADER	T.P.K.		
DESIGN FILE NO.	/pave/96b154/pb154.dgn		
IPARM FILE	pb154dl0.i	DATE PLOTTED	N/A
PROJ. NAME	FAIR HAVEN - RUTLAND		
PROJ. NO.	NH 9727(1)S		
SHEET	38 OF 119	SHEETS	