




STA. 1+897.0, LT (WB)
 LEFT POST = 5.8 m
 MIDDLE POST = 5.7 m
 RIGHT POST = 5.7 m
 W150 X 13.5

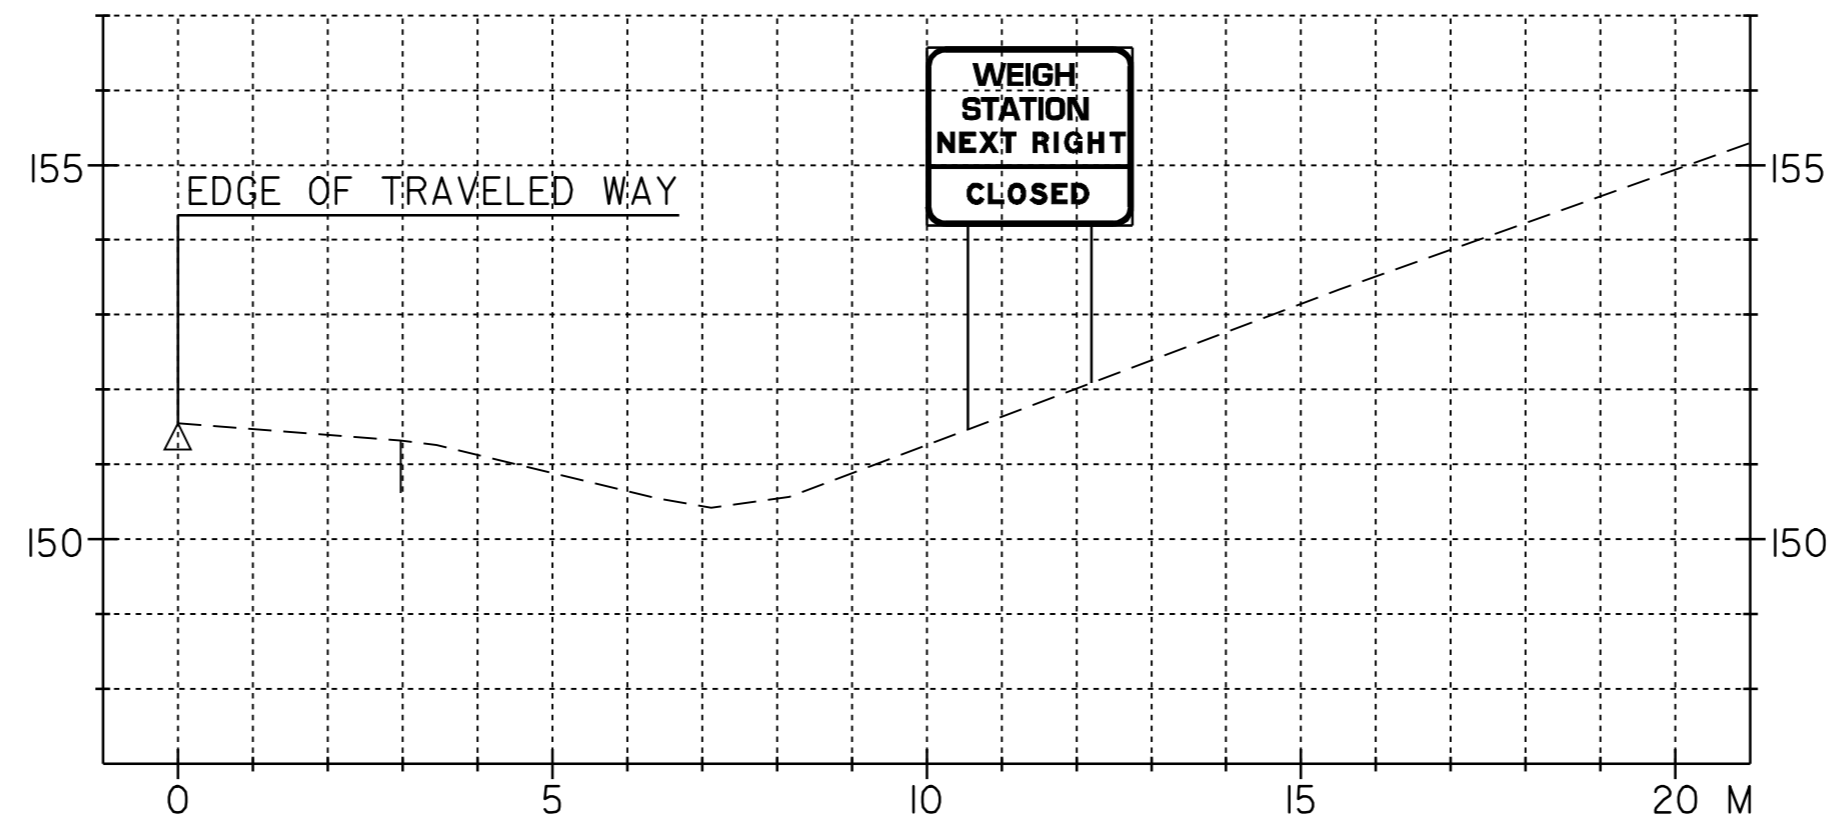


STA. 1+571.0, LT (WB)
 LEFT POST = 5.1 m
 RIGHT POST = 4.5 m
 W150 X 13.5

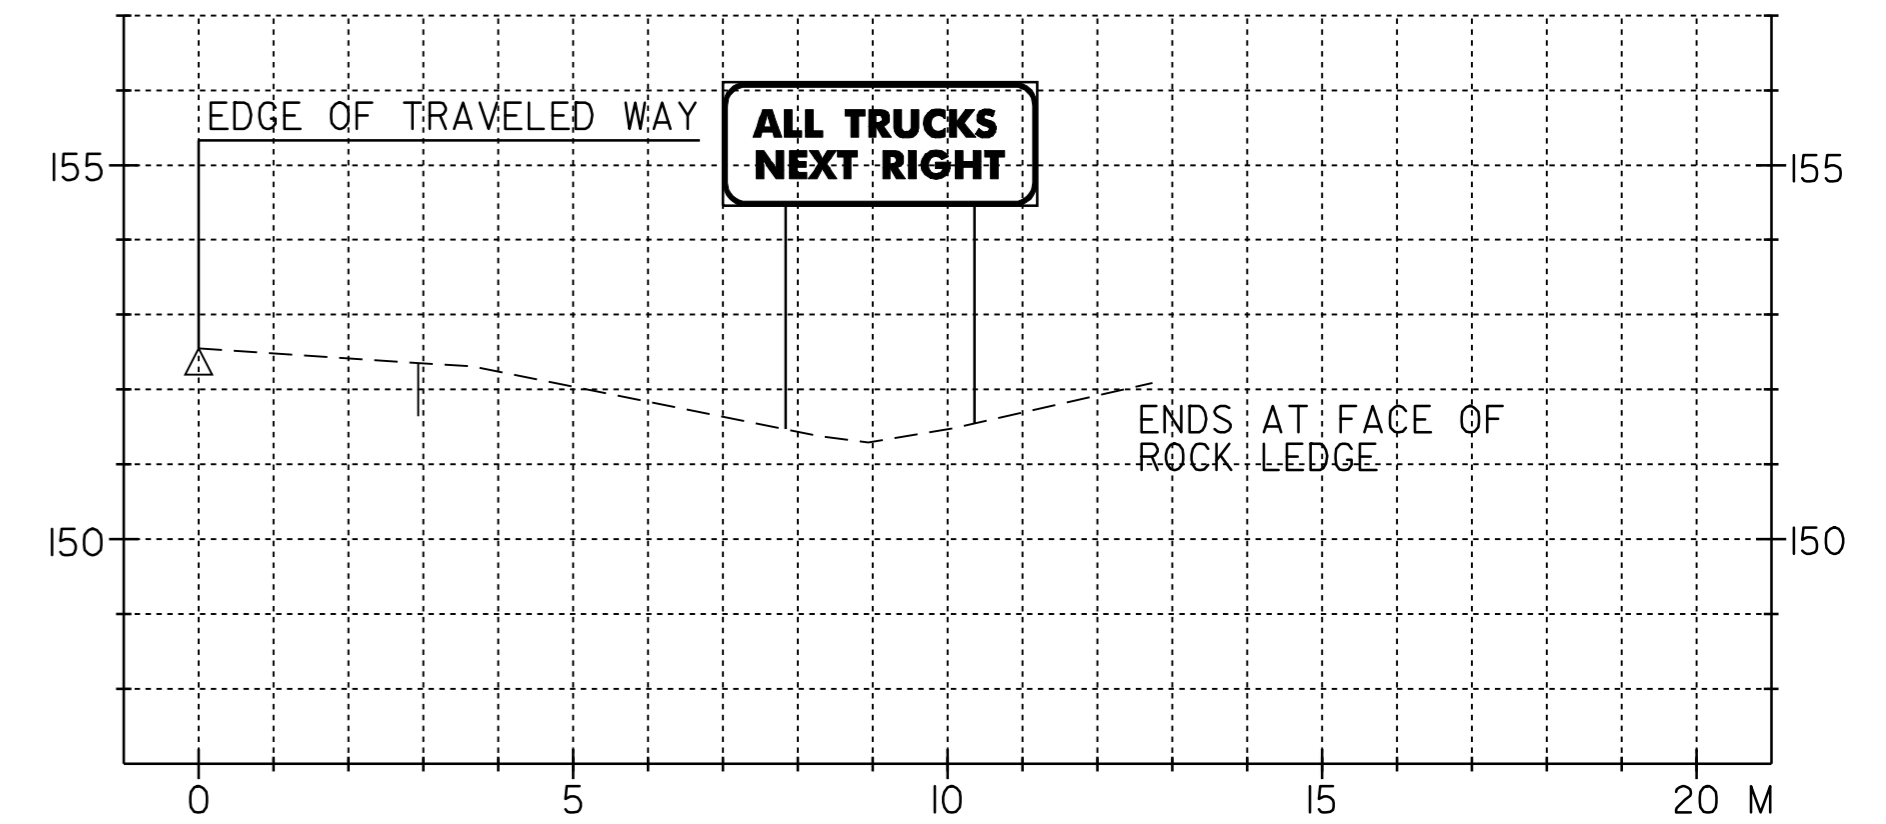


STA. 0+737.0, LT (WB)
 LEFT POST = 4.6 m
 RIGHT POST = 4.6 m
 100 mm DIAMETER TUBULAR STEEL

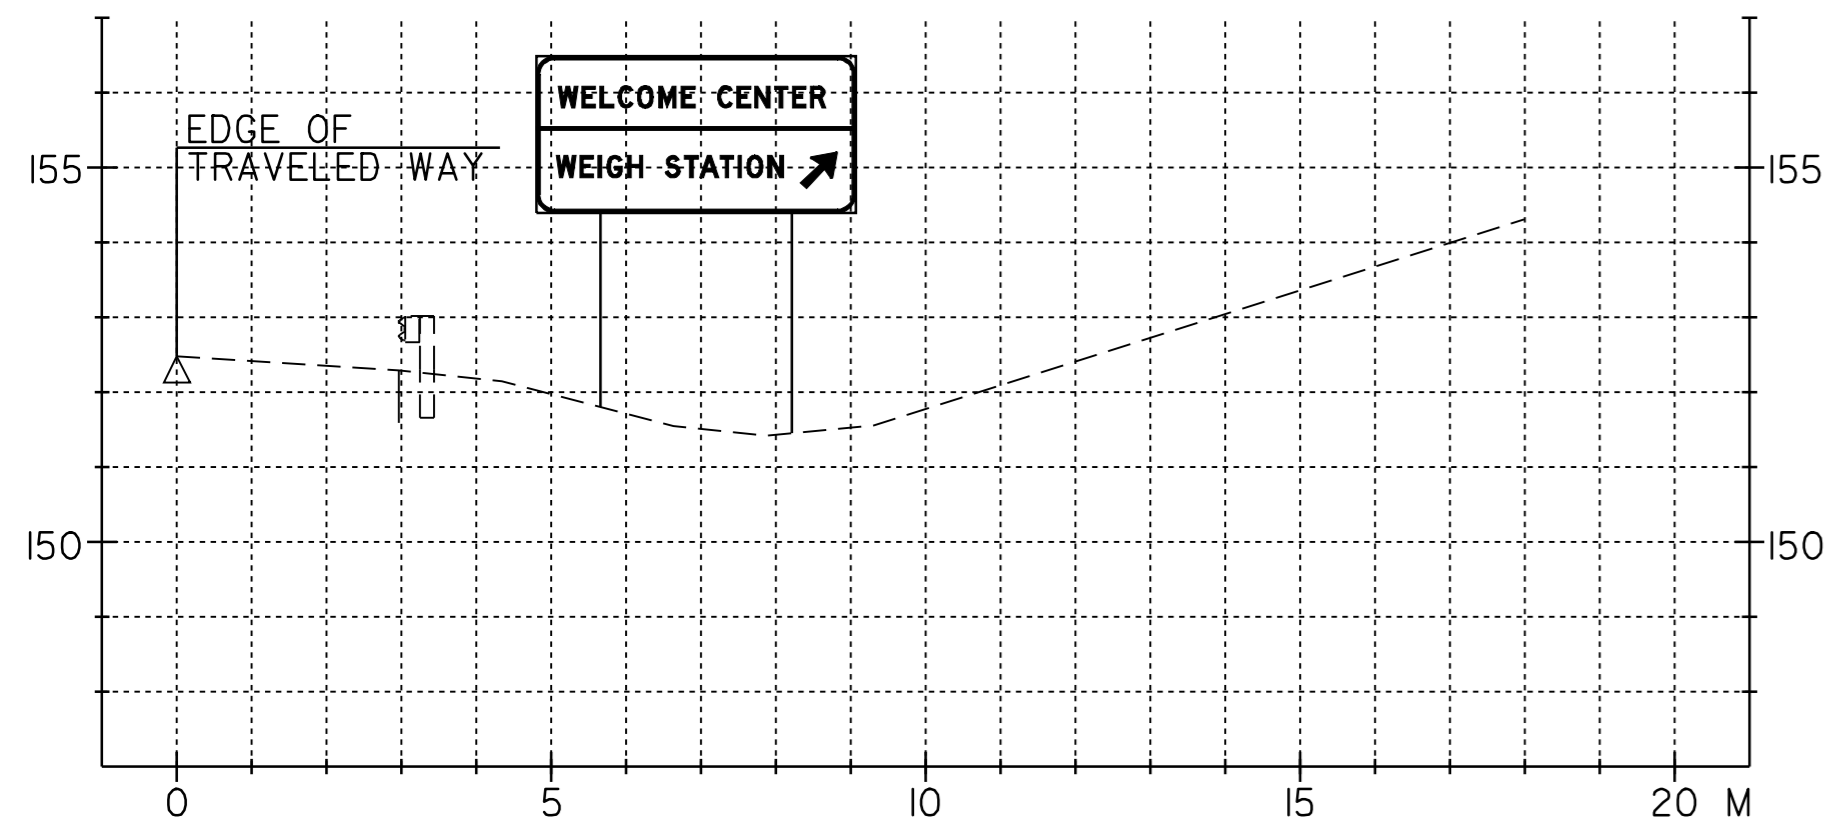

STA. 0+463.0, LT (WB)
 LEFT POST = 4.7 m
 RIGHT POST = 5.0 m
 W150 X 13.5

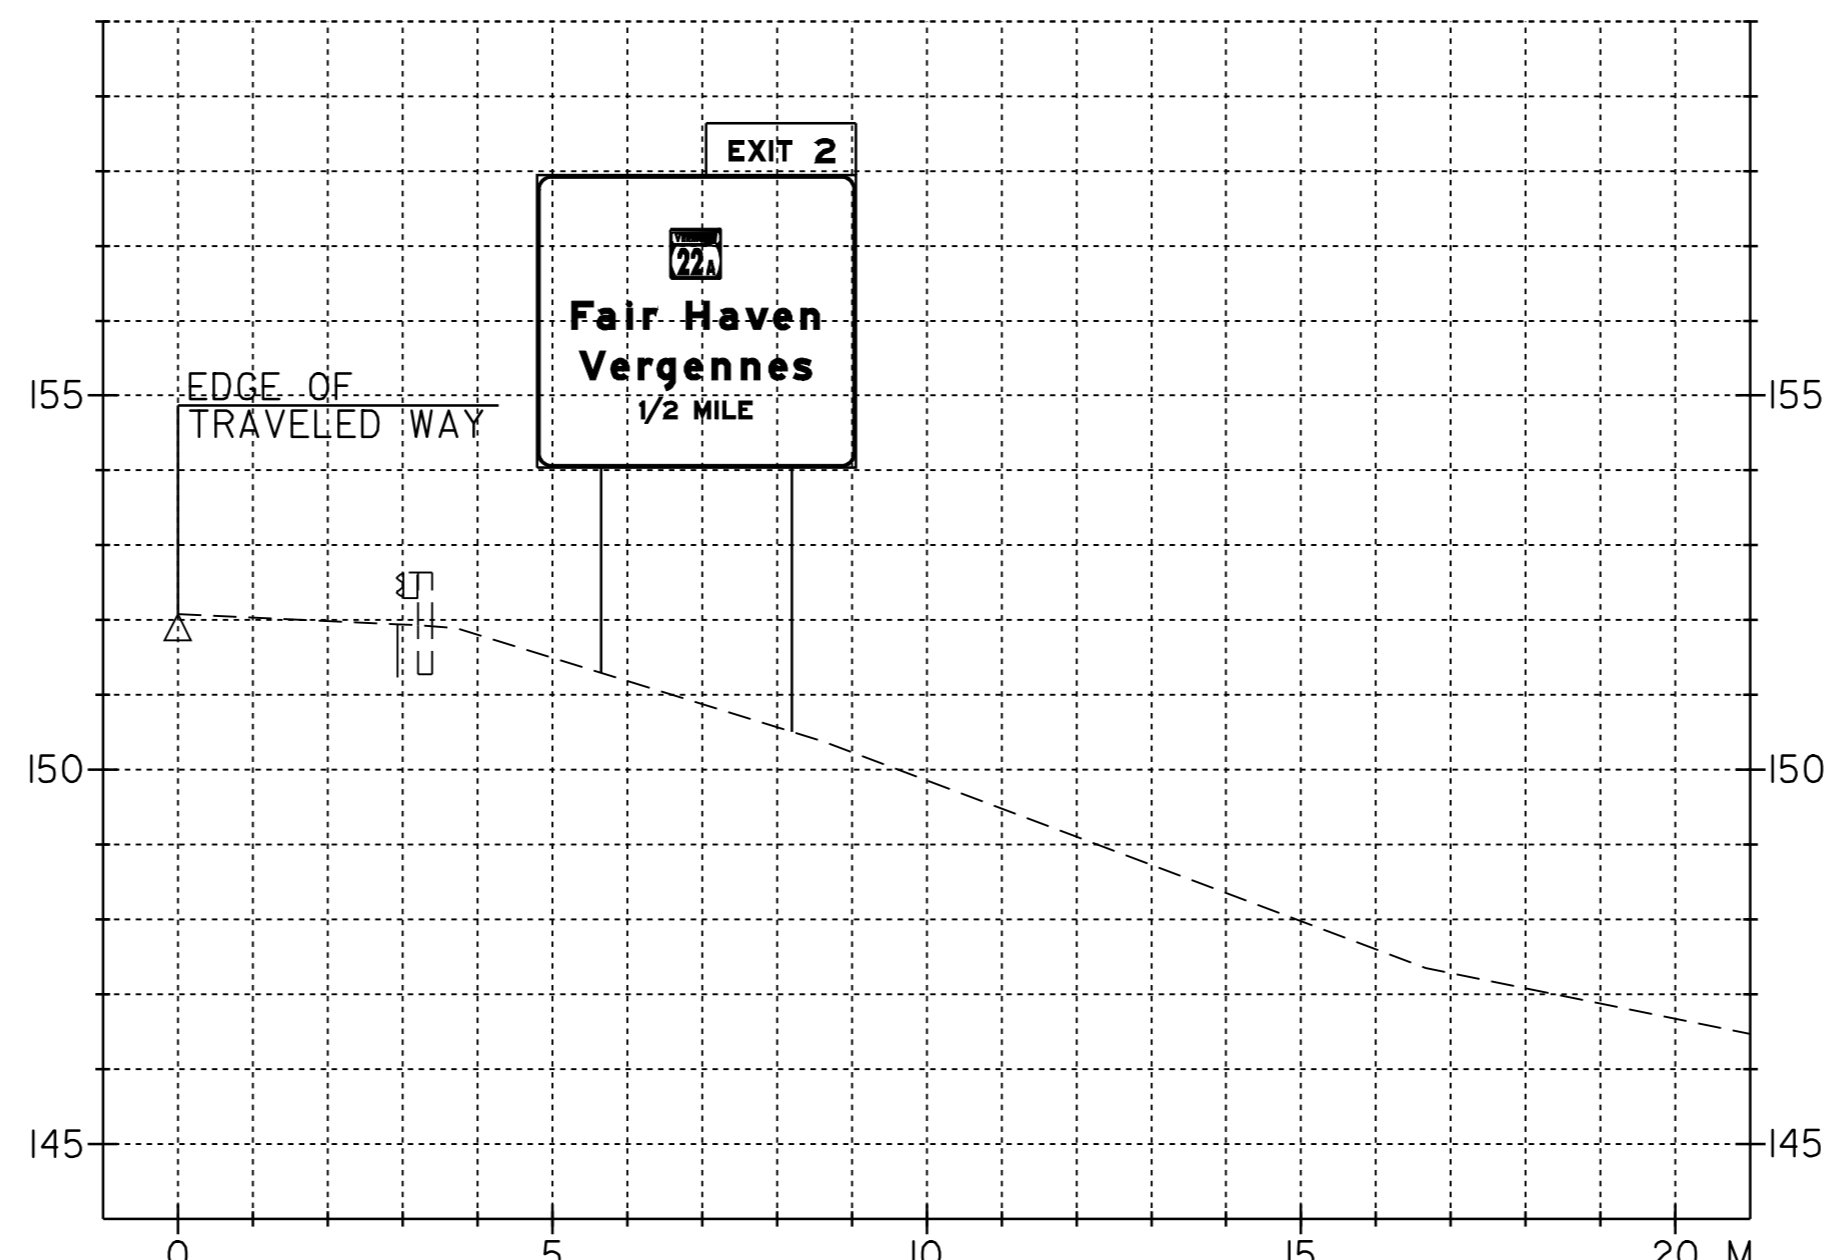


STA. 3+990.0, LT (WB)
 LEFT POST = 6.7 m
 RIGHT POST = 7.4 m
 W250 X 32.7

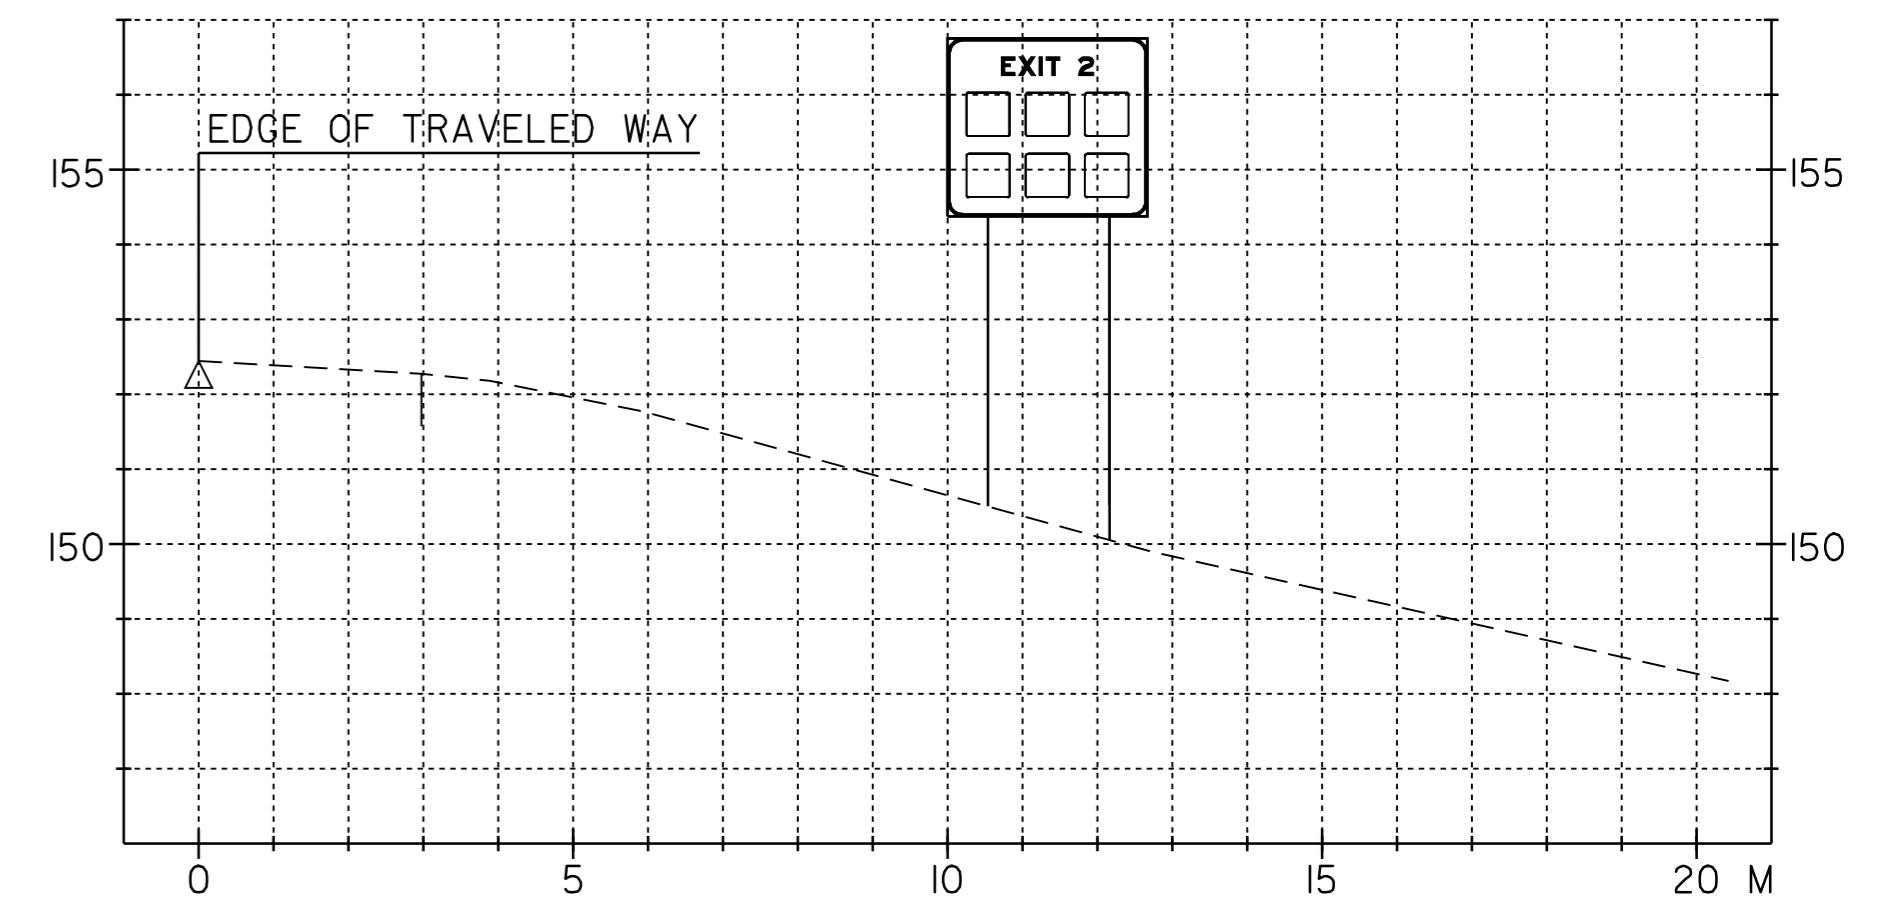

STA. 3+715.0, LT (WB)
 LEFT POST = 6.3 m
 RIGHT POST = 6.7 m
 W150 X 18.0

DATUM	
VERTICAL	N/A
HORIZONTAL	N/A

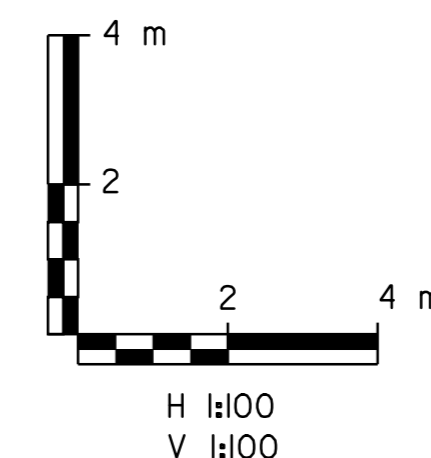

U.S. ROUTE 4 WESTBOUND CROSS SECTIONS	SURVEYED BY	N/A	DATE	N/A
	DRAWN BY	C.A.K.	DATE	8/98
	SQUAD LEADER	T.P.K.		
	DESIGN FILE NO.	/pave/96bl54/pbl54.dgn		
	IPARM FILE	pbl54d42.i	DATE PLOTTED	N/A
PROJ. NAME	FAIR HAVEN - RUTLAND			
PROJ. NO.	NH 9729(I)S			
SHEET	70 OF 119	SHEETS		