




STA. 18+708.0, LT (WB)
 LEFT POST = 4.9 m
 RIGHT POST = 3.8 m
 75 mm DIAMETER TUBULAR STEEL

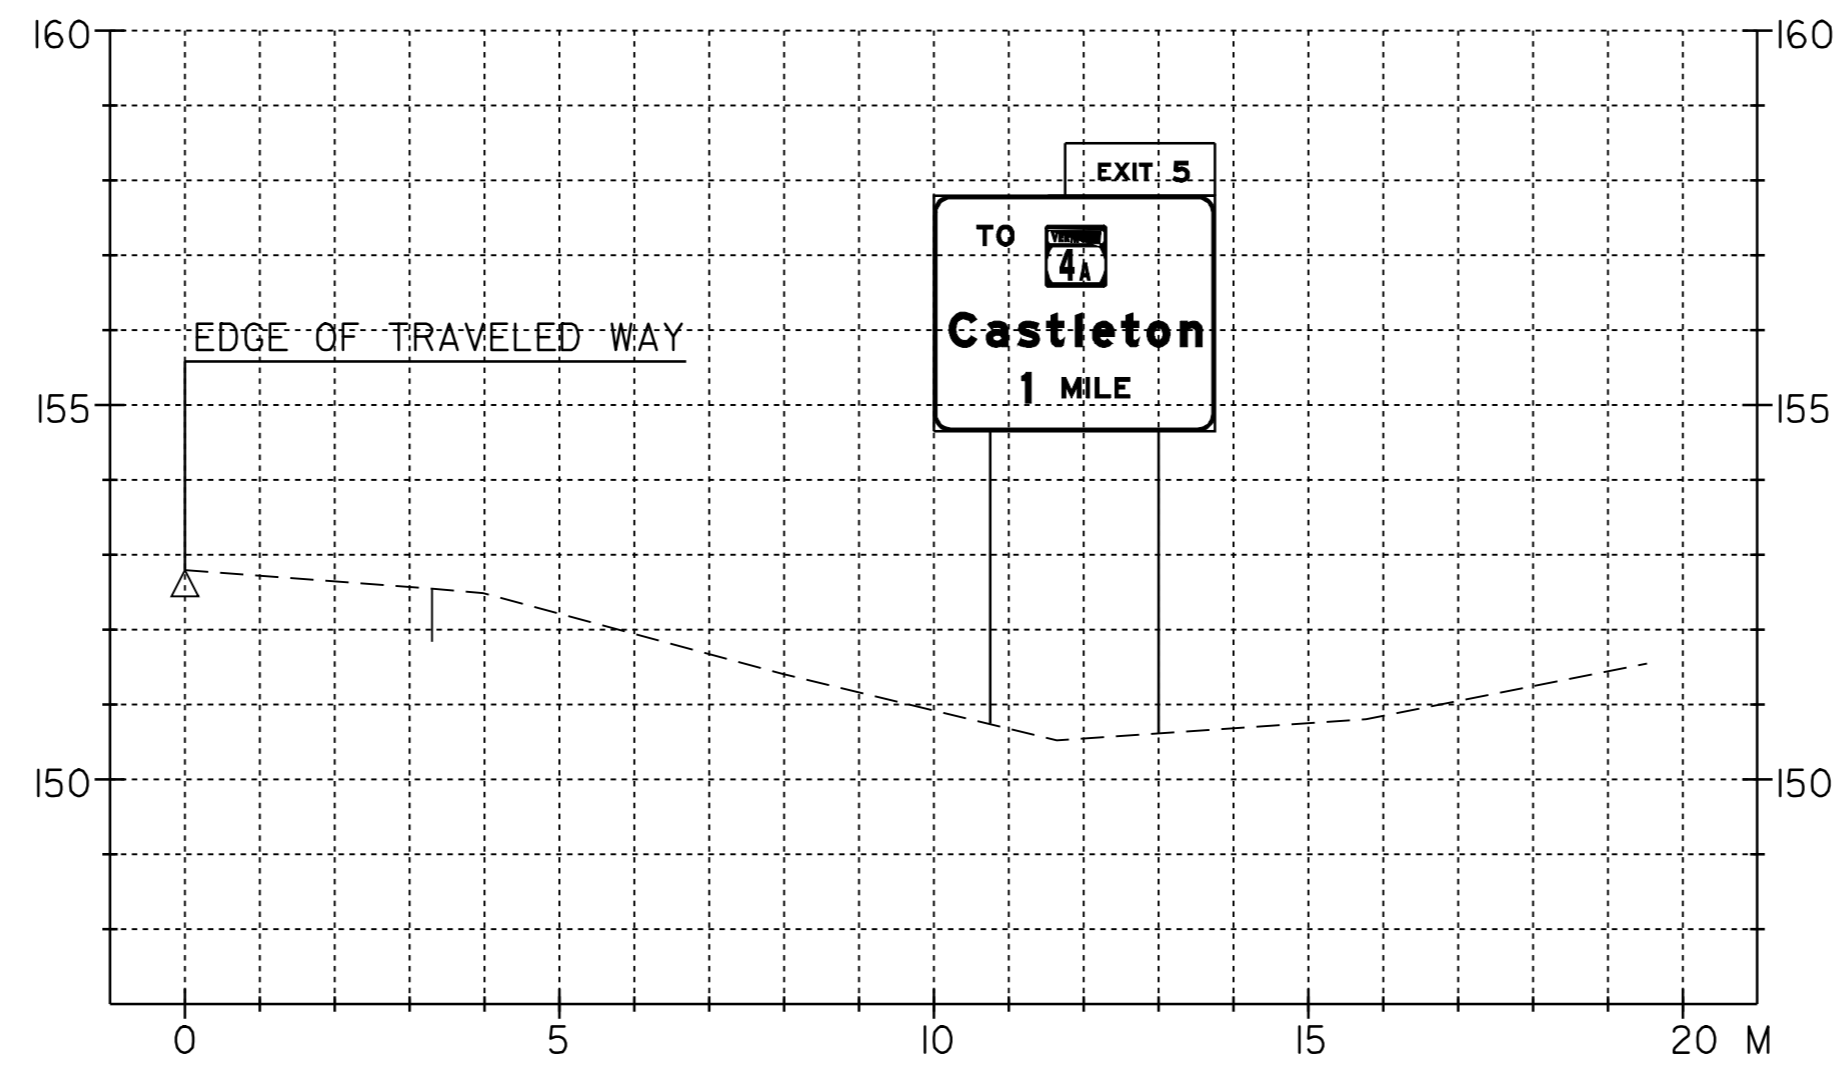


STA. 14+552.0, LT (WB)
 LEFT POST = 7.1 m
 RIGHT POST = 7.2 m
 W200 X 31.3

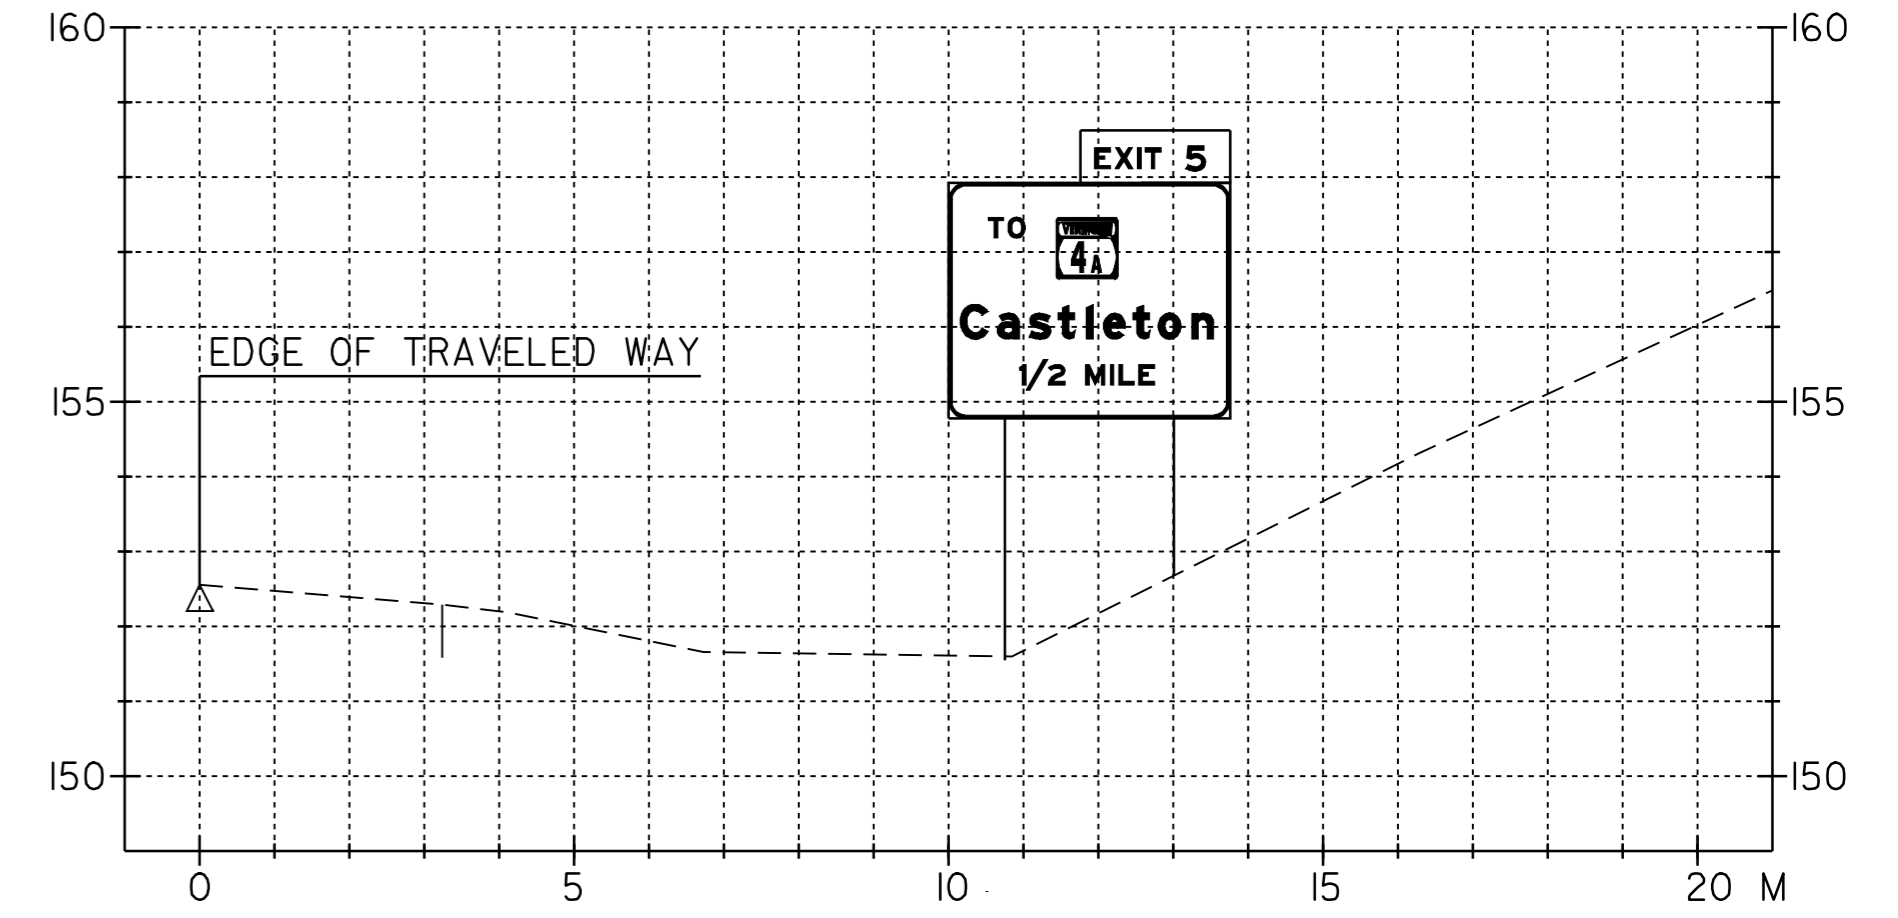


STA. 13+752.0, LT (WB)
 LEFT POST = 6.4 m
 RIGHT POST = 5.3 m
 W200 X 26.6

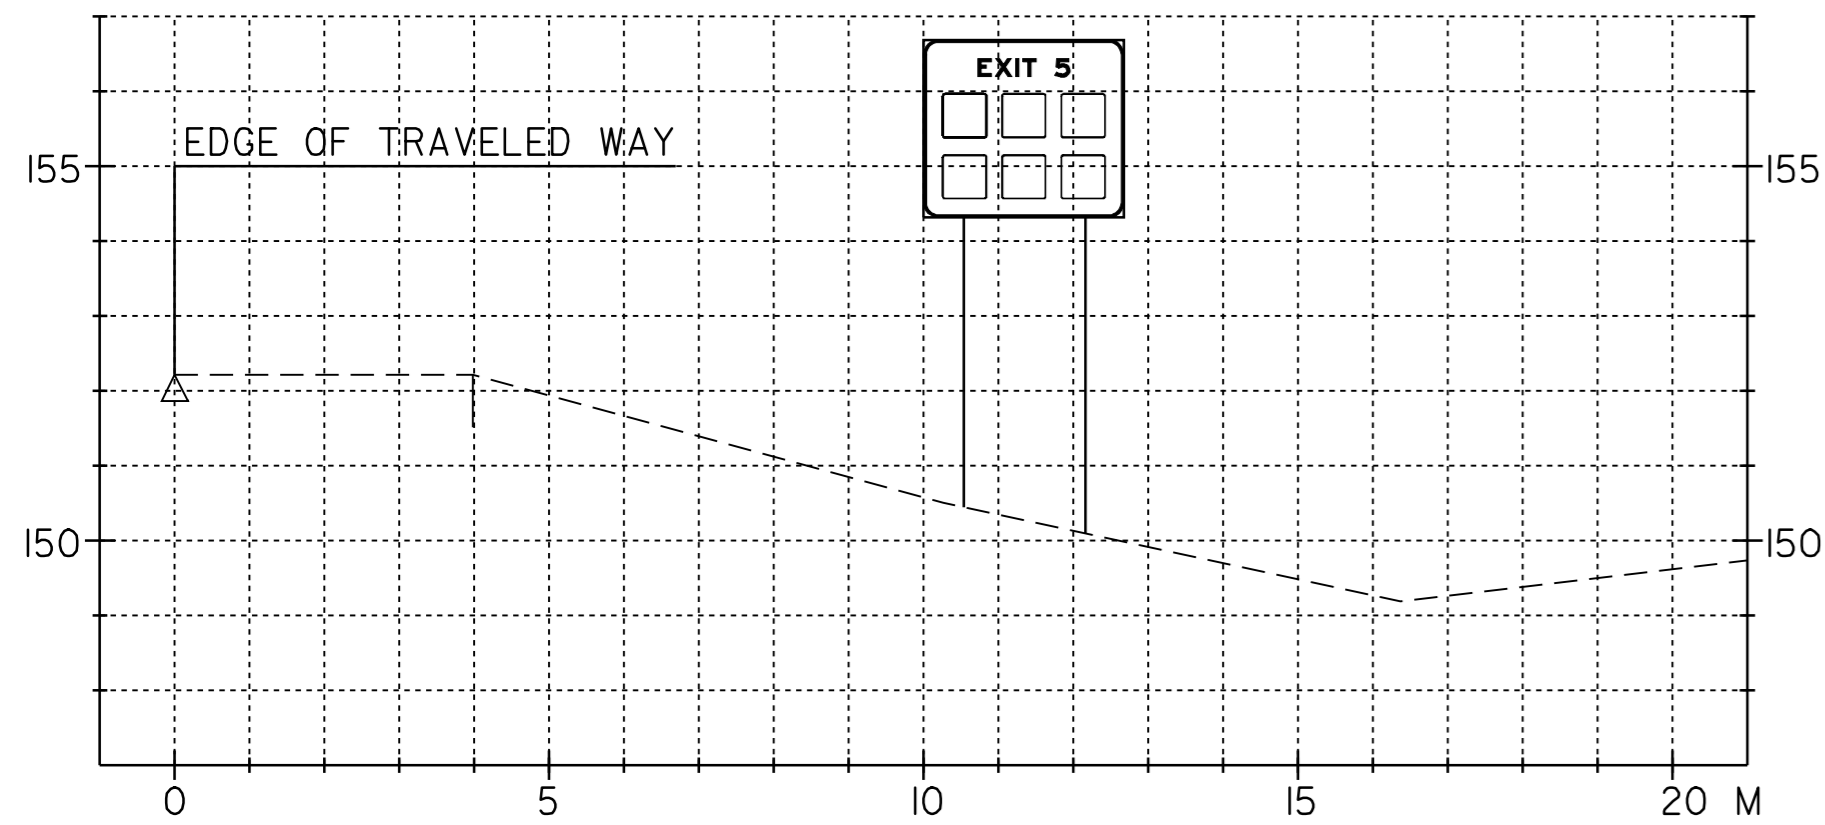

STA. 13+367.0, LT (WB)
 LEFT POST = 6.2 m
 RIGHT POST = 6.6 m
 W150 X 13.5

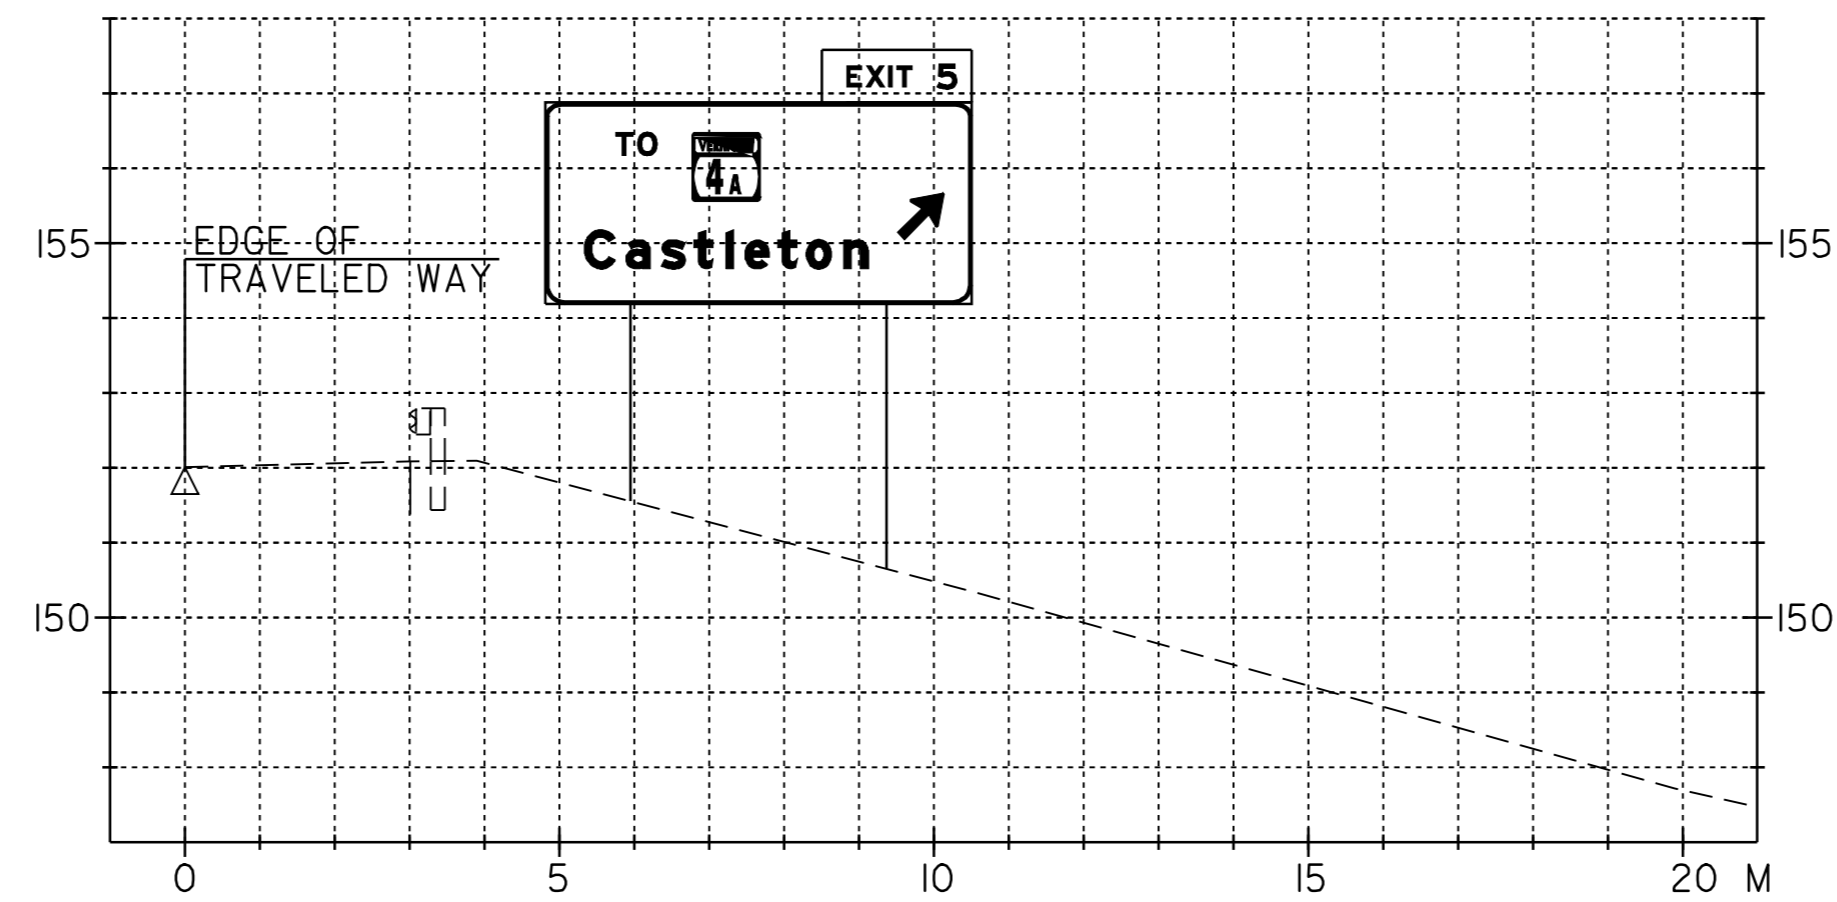


STA. 13+135.0, LT (WB)
 LEFT POST = 5.3 m
 RIGHT POST = 6.2 m
 W200 X 26.6

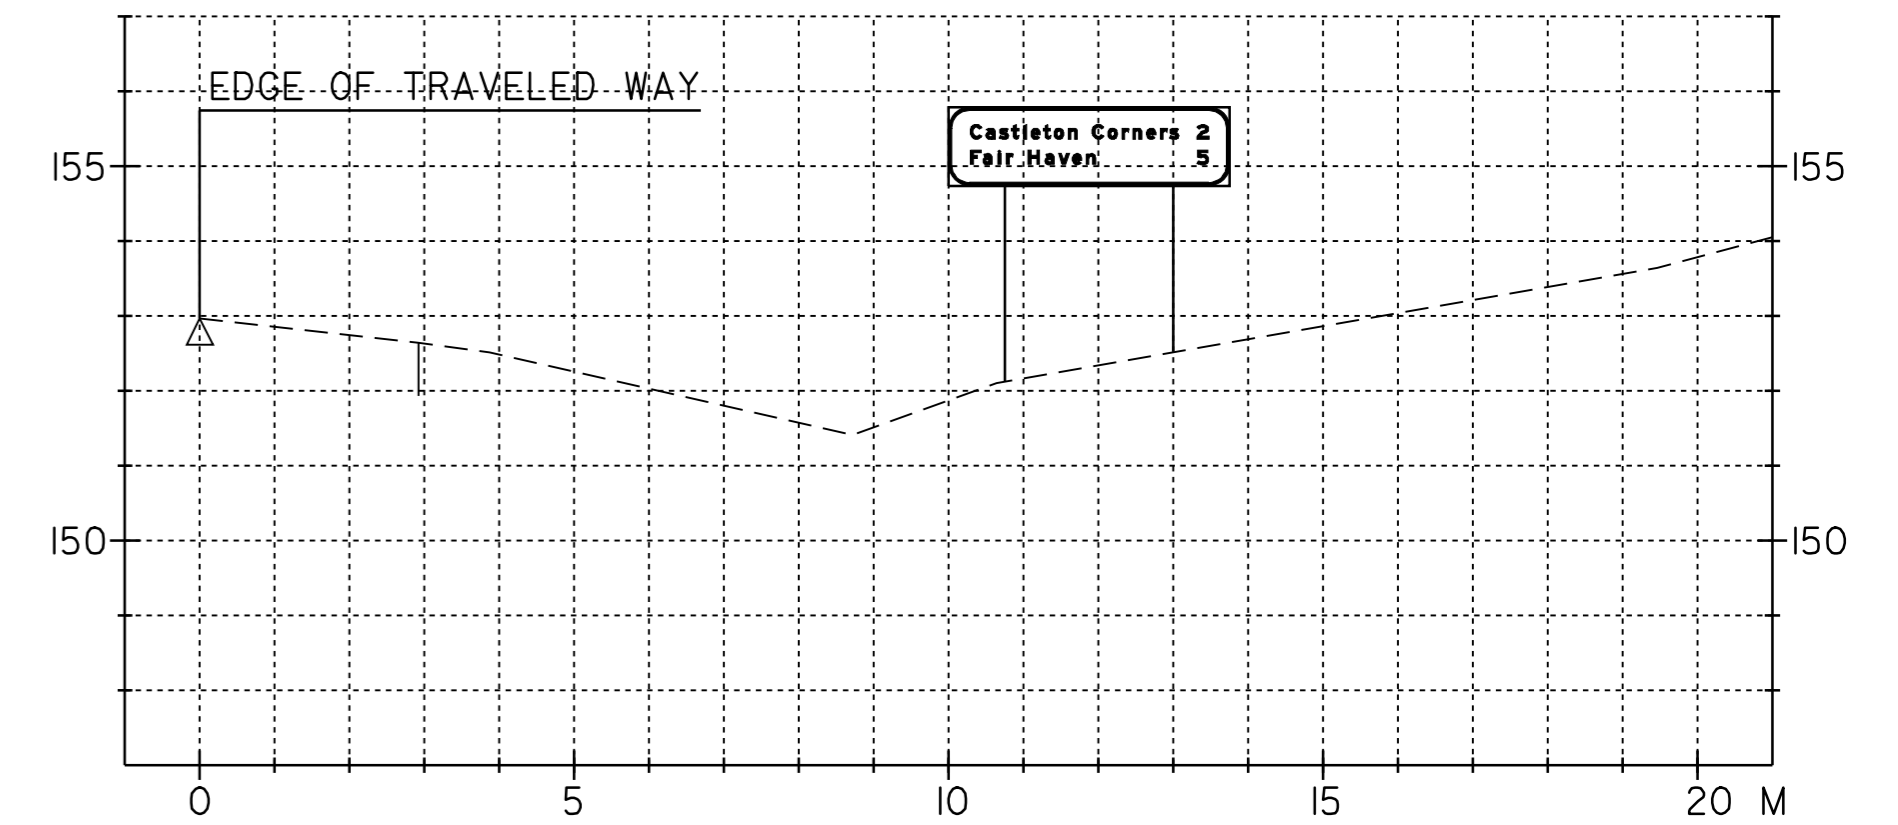

STA. 11+839.0, LT (WB)
 LEFT POST = 3.7 m
 RIGHT POST = 3.3 m
 75 mm DIAMETER TUBULAR STEEL

DATUM	
VERTICAL	N/A
HORIZONTAL	N/A

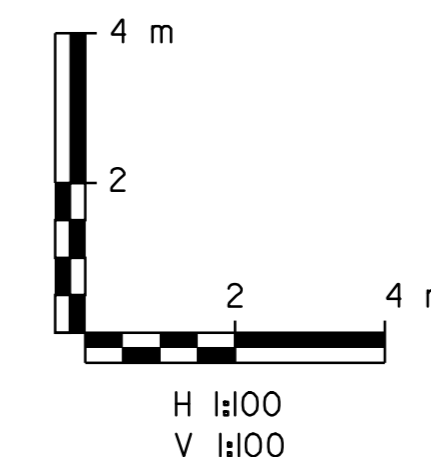

U.S. ROUTE 4 WESTBOUND CROSS SECTIONS	SURVEYED BY	N/A	DATE	N/A
	DRAWN BY	C.A.K.	DATE	8/98
	SQUAD LEADER	T.P.K.		
	DESIGN FILE NO.	/pave/96bl54/154.dgn		
	IPARM FILE	pbl54d45.i	DATE PLOTTED	N/A
PROJ. NAME	FAIR HAVEN - RUTLAND			
PROJ. NO.	NH 9729(1)S			
SHEET	73 OF 119	SHEETS		