




STA. 25+924.0, LT (WB)
 LEFT POST = 7.8 m
 MIDDLE POST = 8.3 m
 MIDDLE POST = 8.8 m
 RIGHT POST = 9.3 m
 W310 X 44.5

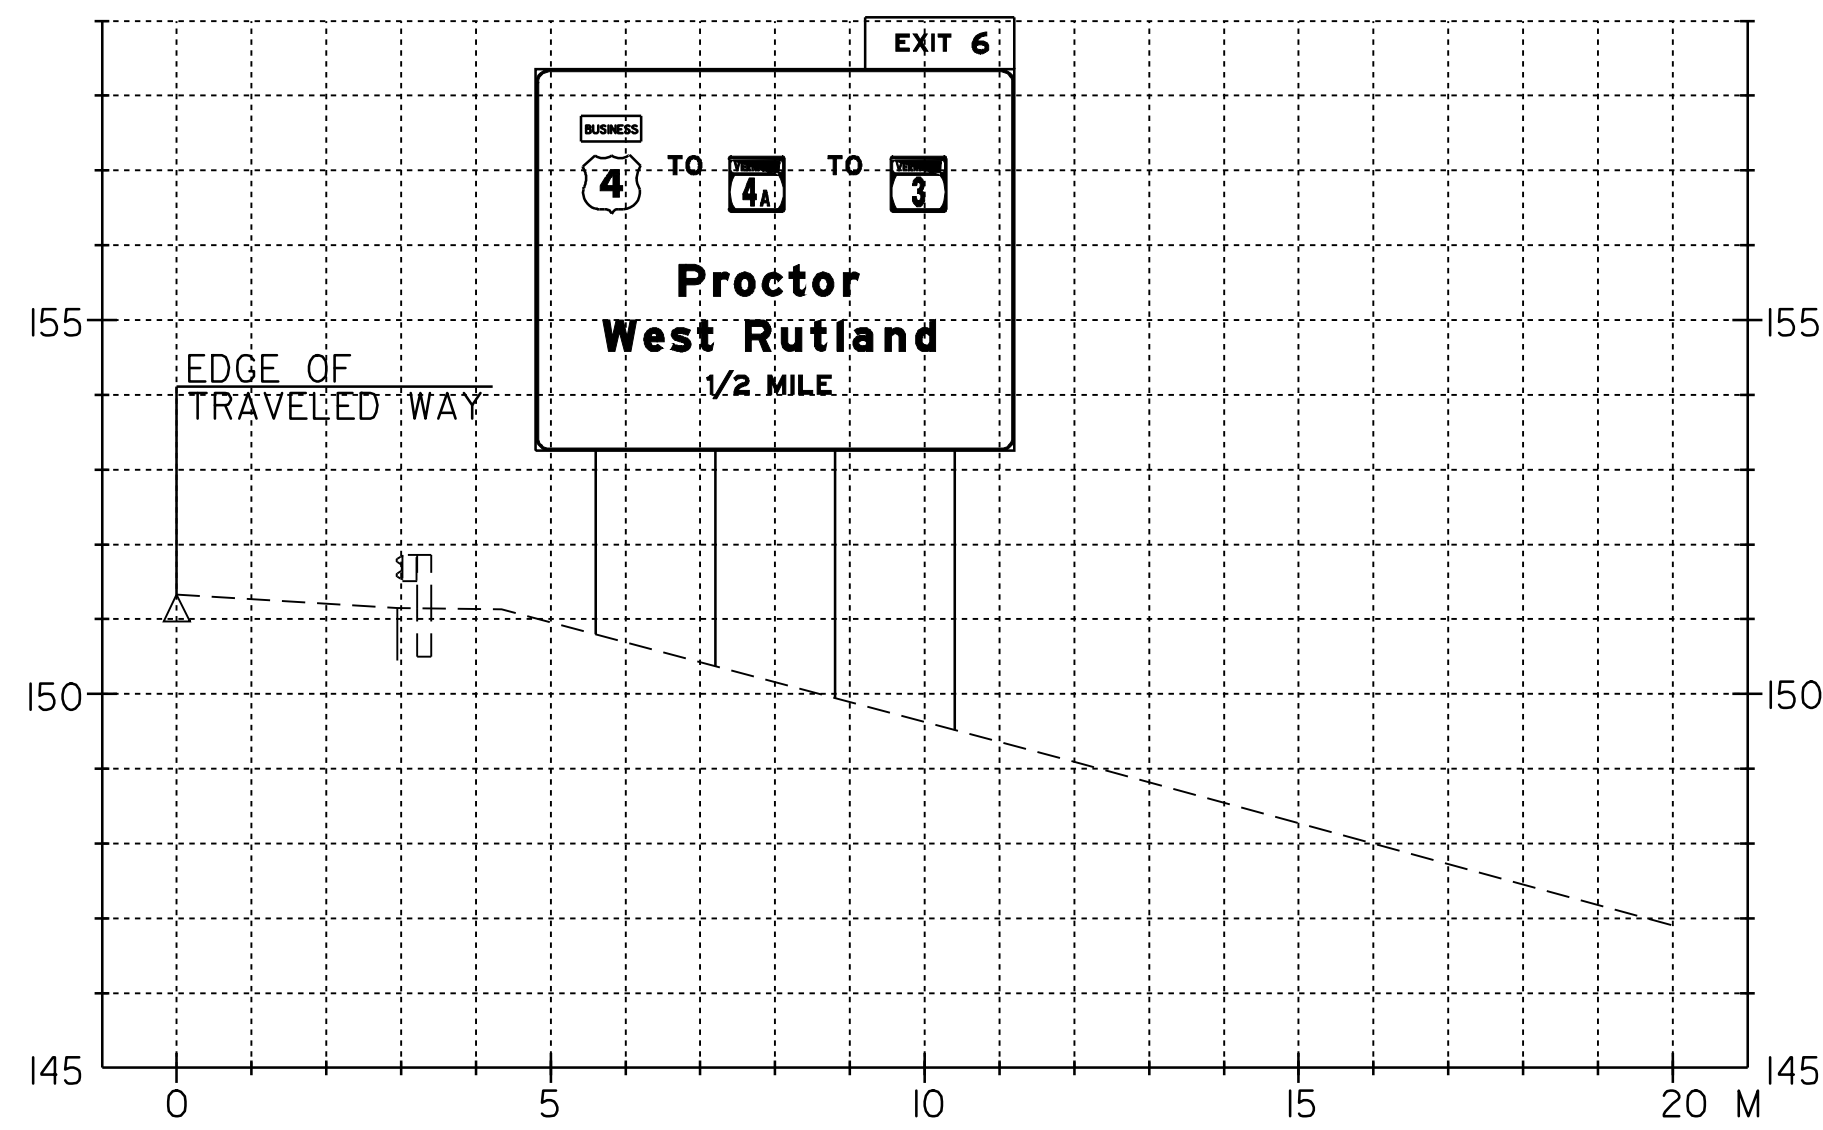


STA. 25+180.0, LT (WB)
 LEFT POST = 7.6 m
 MIDDLE POST = 8.0 m
 MIDDLE POST = 8.4 m
 RIGHT POST = 8.8 m
 W310 X 44.5

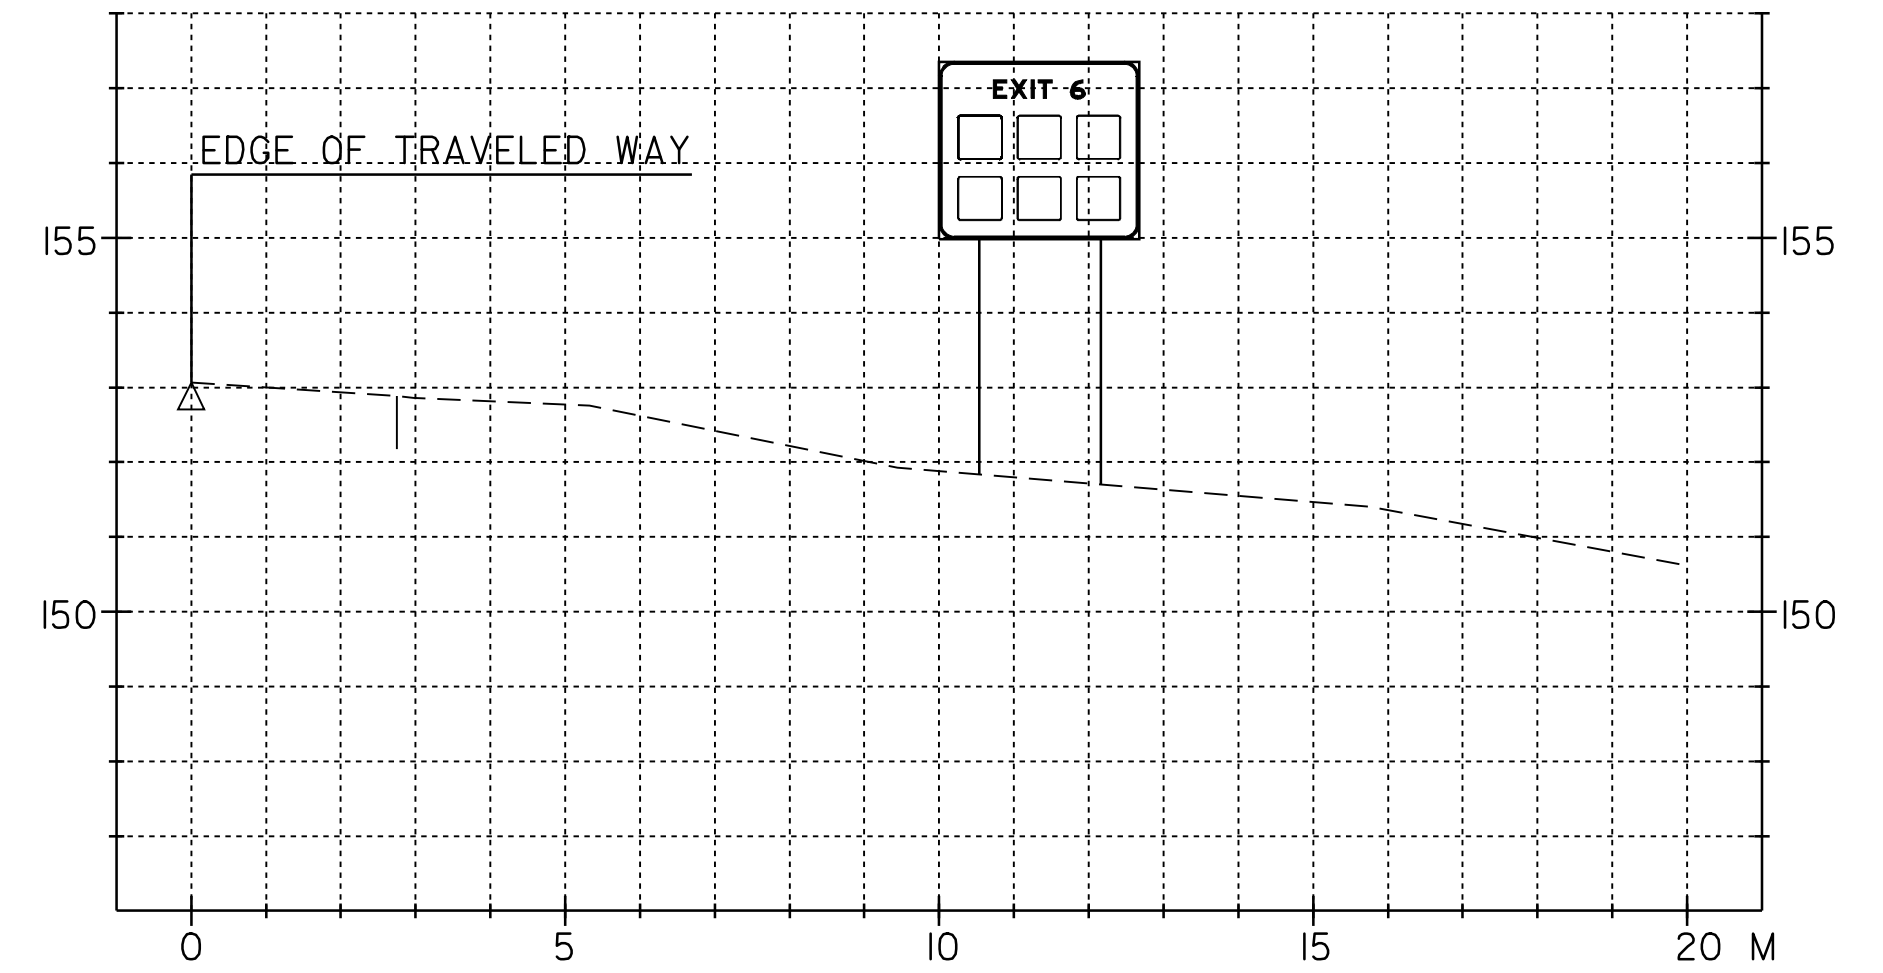


STA. 24+825.0, LT (WB)
 LEFT POST = 5.2 m
 RIGHT POST = 5.7 m
 W150 X 13.5

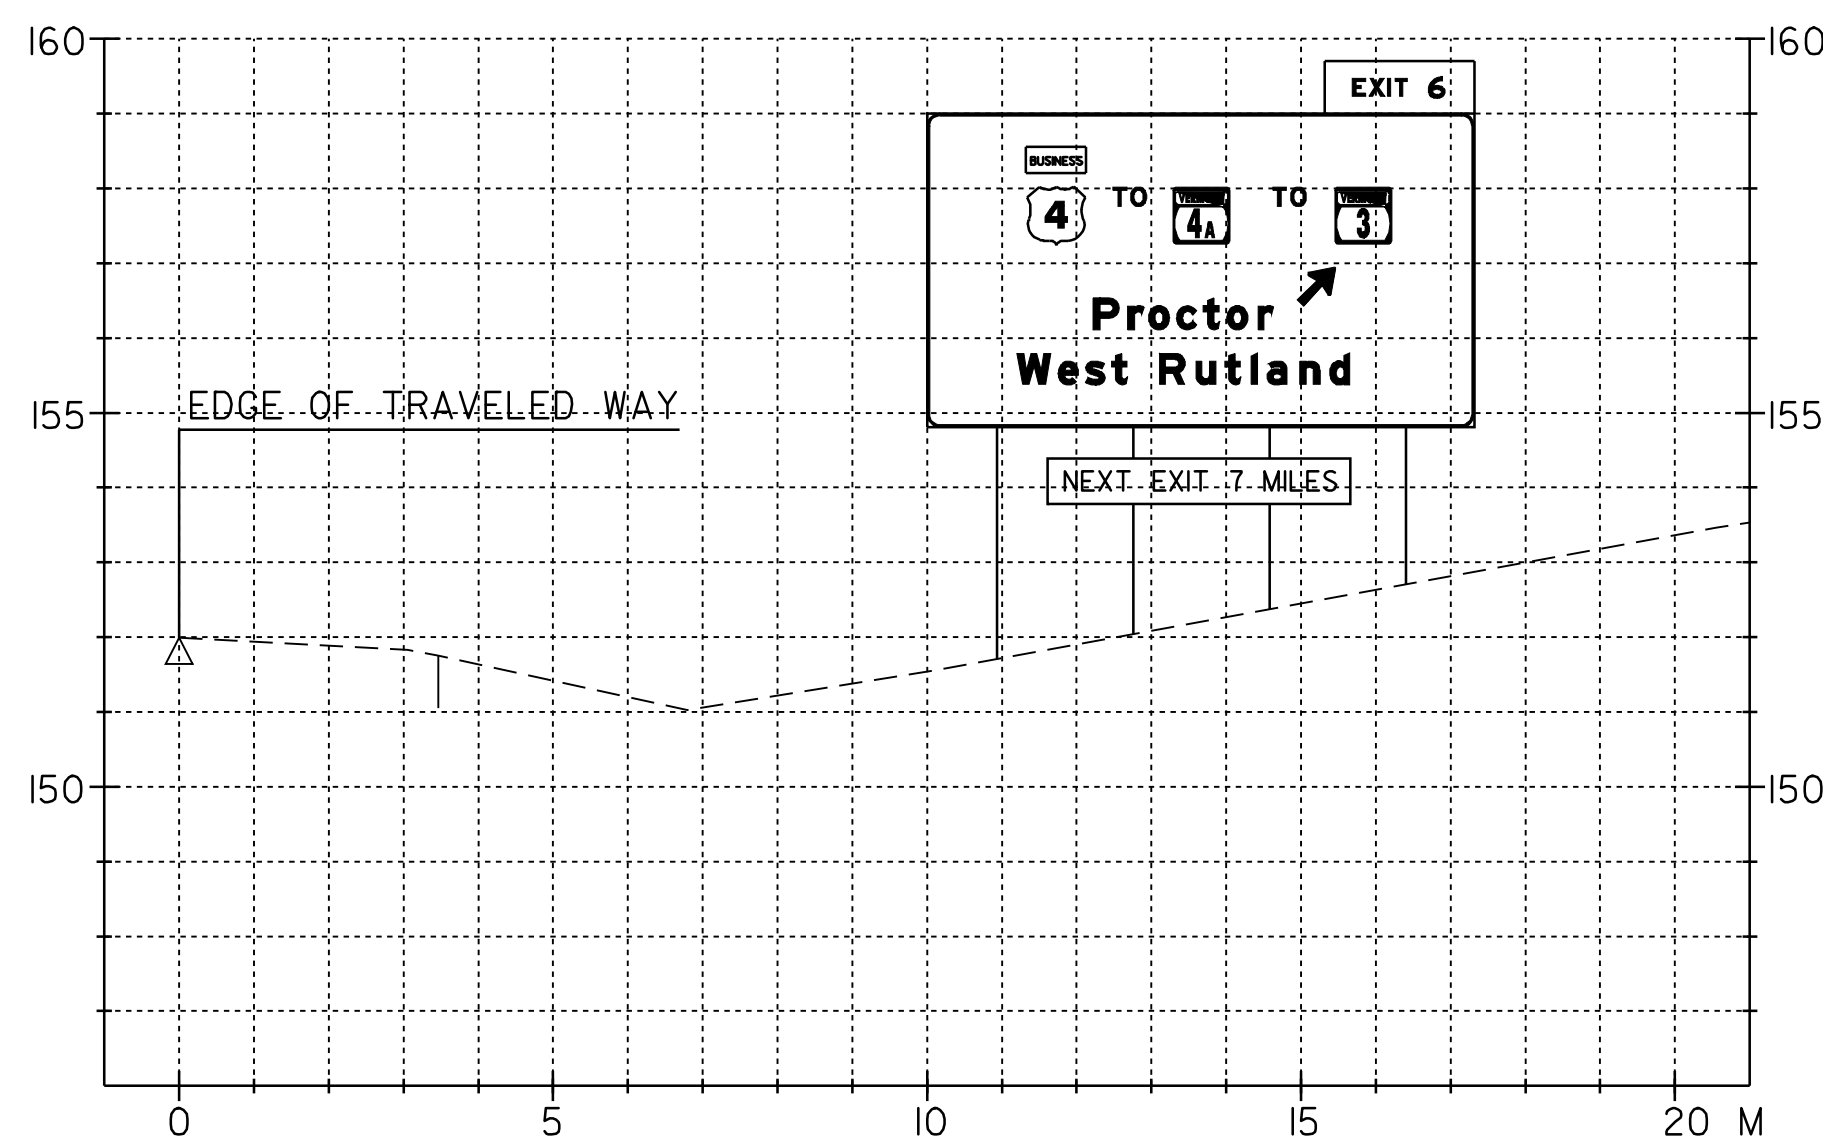

STA. 24+425.0, LT (WB)
 LEFT POST = 7.3 m
 MIDDLE POST = 7.0 m
 MIDDLE POST = 6.6 m
 RIGHT POST = 6.3 m
 W250 X 32.7

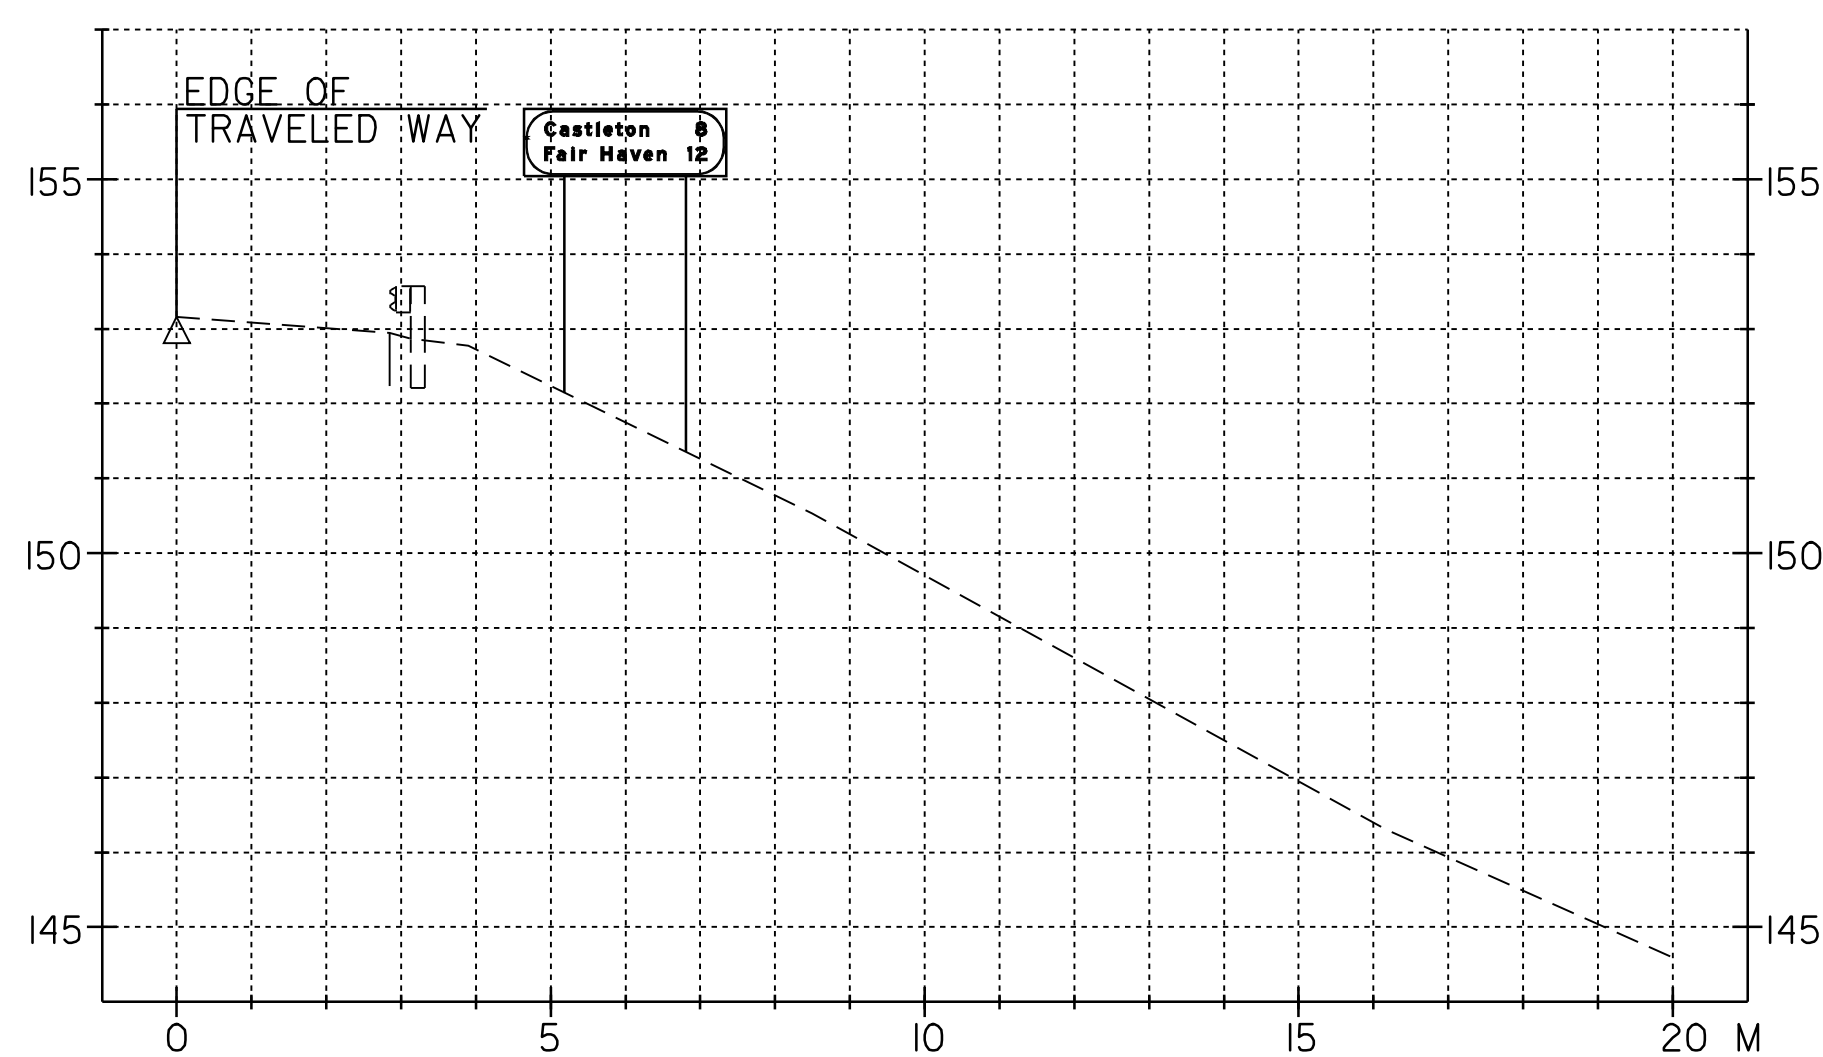


STA. 22+720 M.O., LT (WB)
 LEFT POST = 3.8 m
 RIGHT POST = 4.6 m
 100 mm DIAMETER TUBULAR ALUMINUM

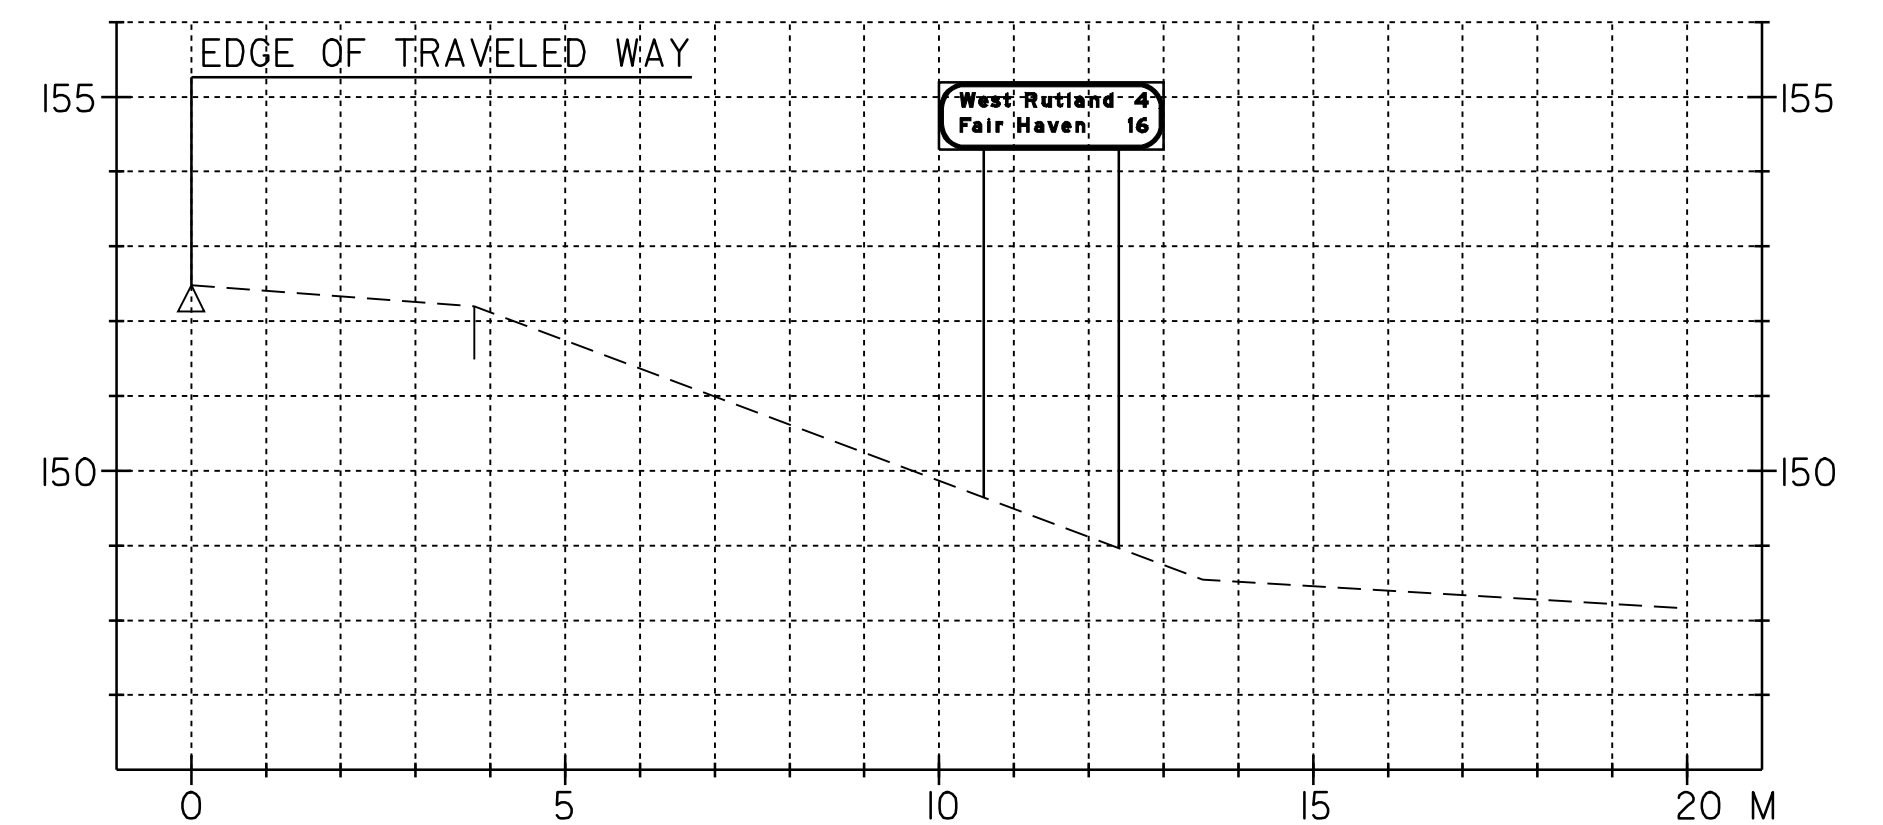

STA. 29+376.0, LT (WB)
 LEFT POST = 5.6 m
 RIGHT POST = 6.2 m
 75 mm DIAMETER TUBULAR STEEL

DATUM	
VERTICAL	N/A
HORIZONTAL	N/A

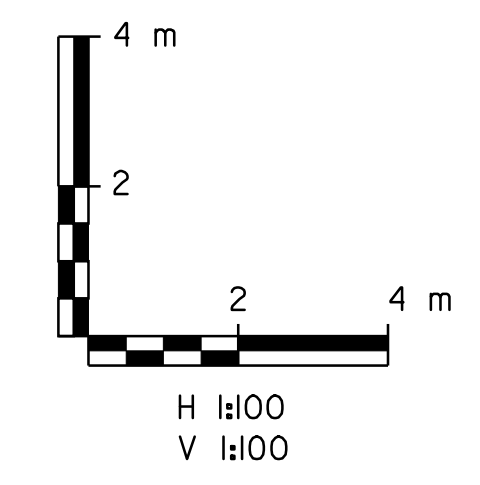

U.S. ROUTE 4 WESTBOUND CROSS SECTIONS	SURVEYED BY	N/A	DATE	N/A
	DRAWN BY	C.A.K.	DATE	8/98
	SQUAD LEADER	T.P.K.		
	DESIGN FILE NO.	/pave/96b154/pb154.dgn		
	IPARM FILE	pb154d46.1	DATE PLOTTED	N/A
PROJ. NAME	FAIR HAVEN - RUTLAND			
PROJ. NO.	NH 9729(I)S			
SHEET	74 OF 119	SHEETS		