
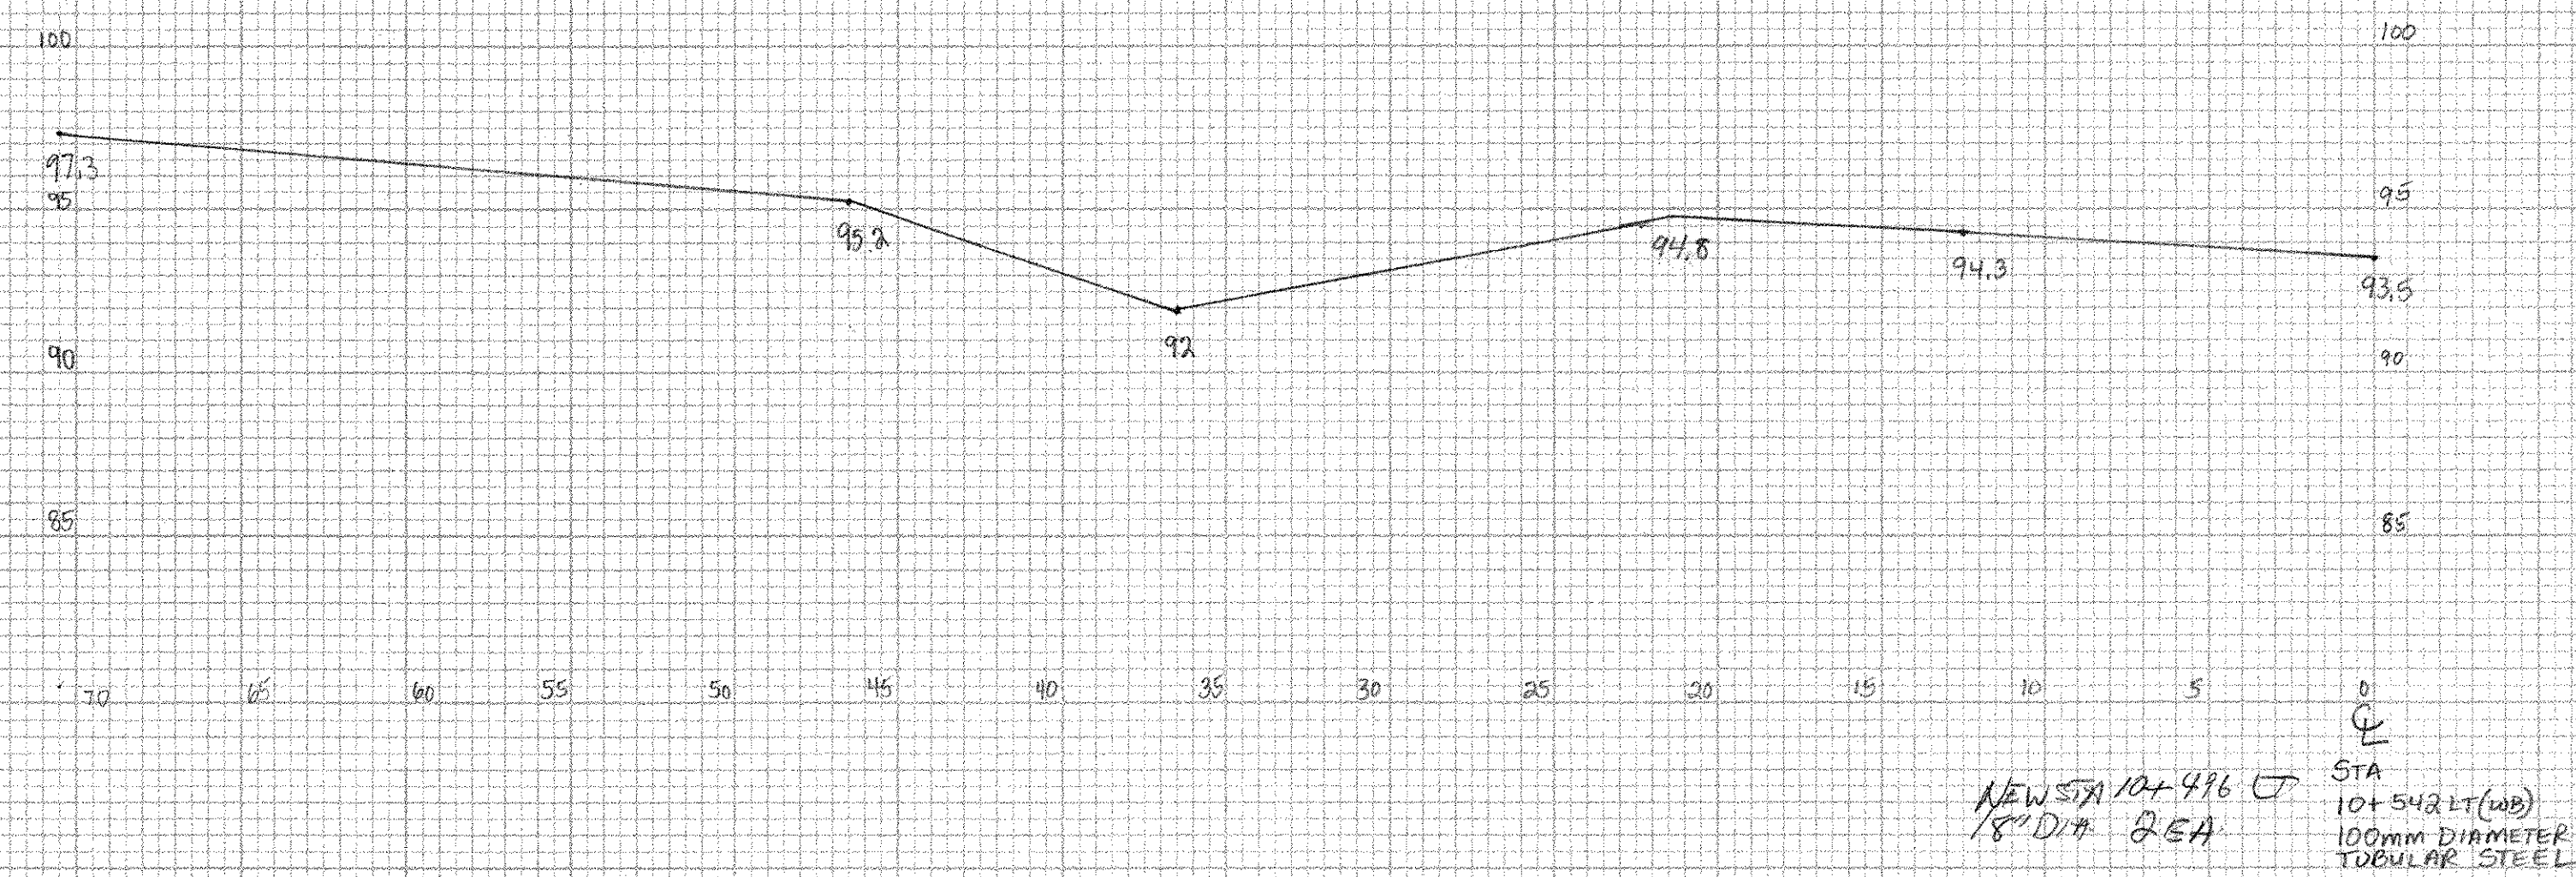



DATE: \_\_\_\_\_  
 BY: \_\_\_\_\_  
 ORIGINAL SURVEY DRAWING PLOTTED  
 SURVEY IN CHARGE: \_\_\_\_\_  
 NOTE BOOK: \_\_\_\_\_  
 TEMPLATE: \_\_\_\_\_  
 AREA: \_\_\_\_\_  
 NO. \_\_\_\_\_  
 AREAS CHECKED: \_\_\_\_\_

DATE: \_\_\_\_\_  
 BY: \_\_\_\_\_  
 ORIGINAL SURVEY DRAWING PLOTTED  
 SURVEY IN CHARGE: \_\_\_\_\_  
 NOTE BOOK: \_\_\_\_\_  
 TEMPLATE: \_\_\_\_\_  
 AREA: \_\_\_\_\_  
 NO. \_\_\_\_\_  
 AREAS CHECKED: \_\_\_\_\_

22' (6600mm)  
 VERMONT  
 30  
 Poultney  
 Castleton Corners  
 1/2 MILE  
 12'-5" (3750mm)

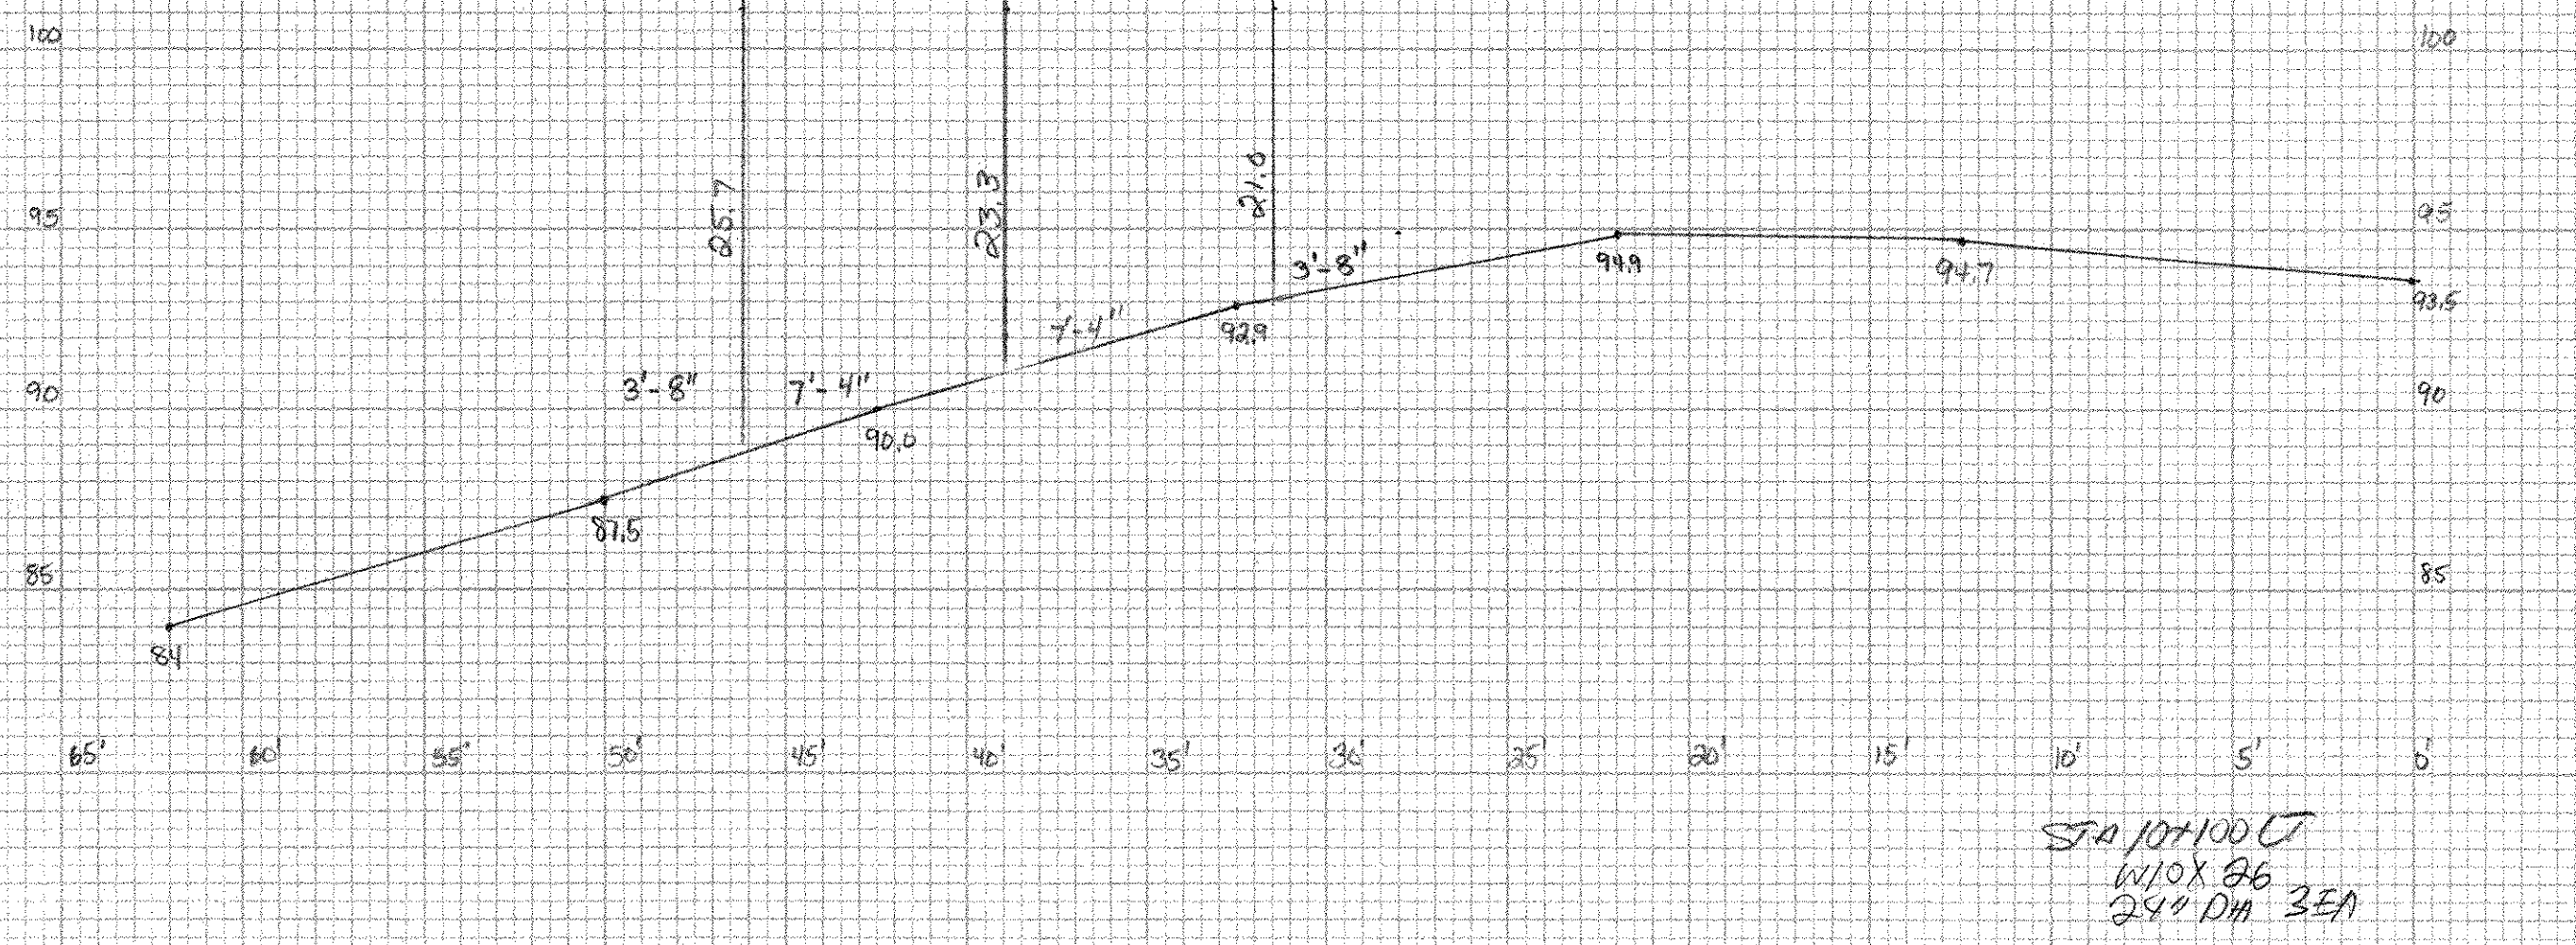

22' (6600mm)  
 VERMONT  
 30  
 Poultney  
 Castleton Corners  
 1 MILE  
 12'-6" (3750mm)

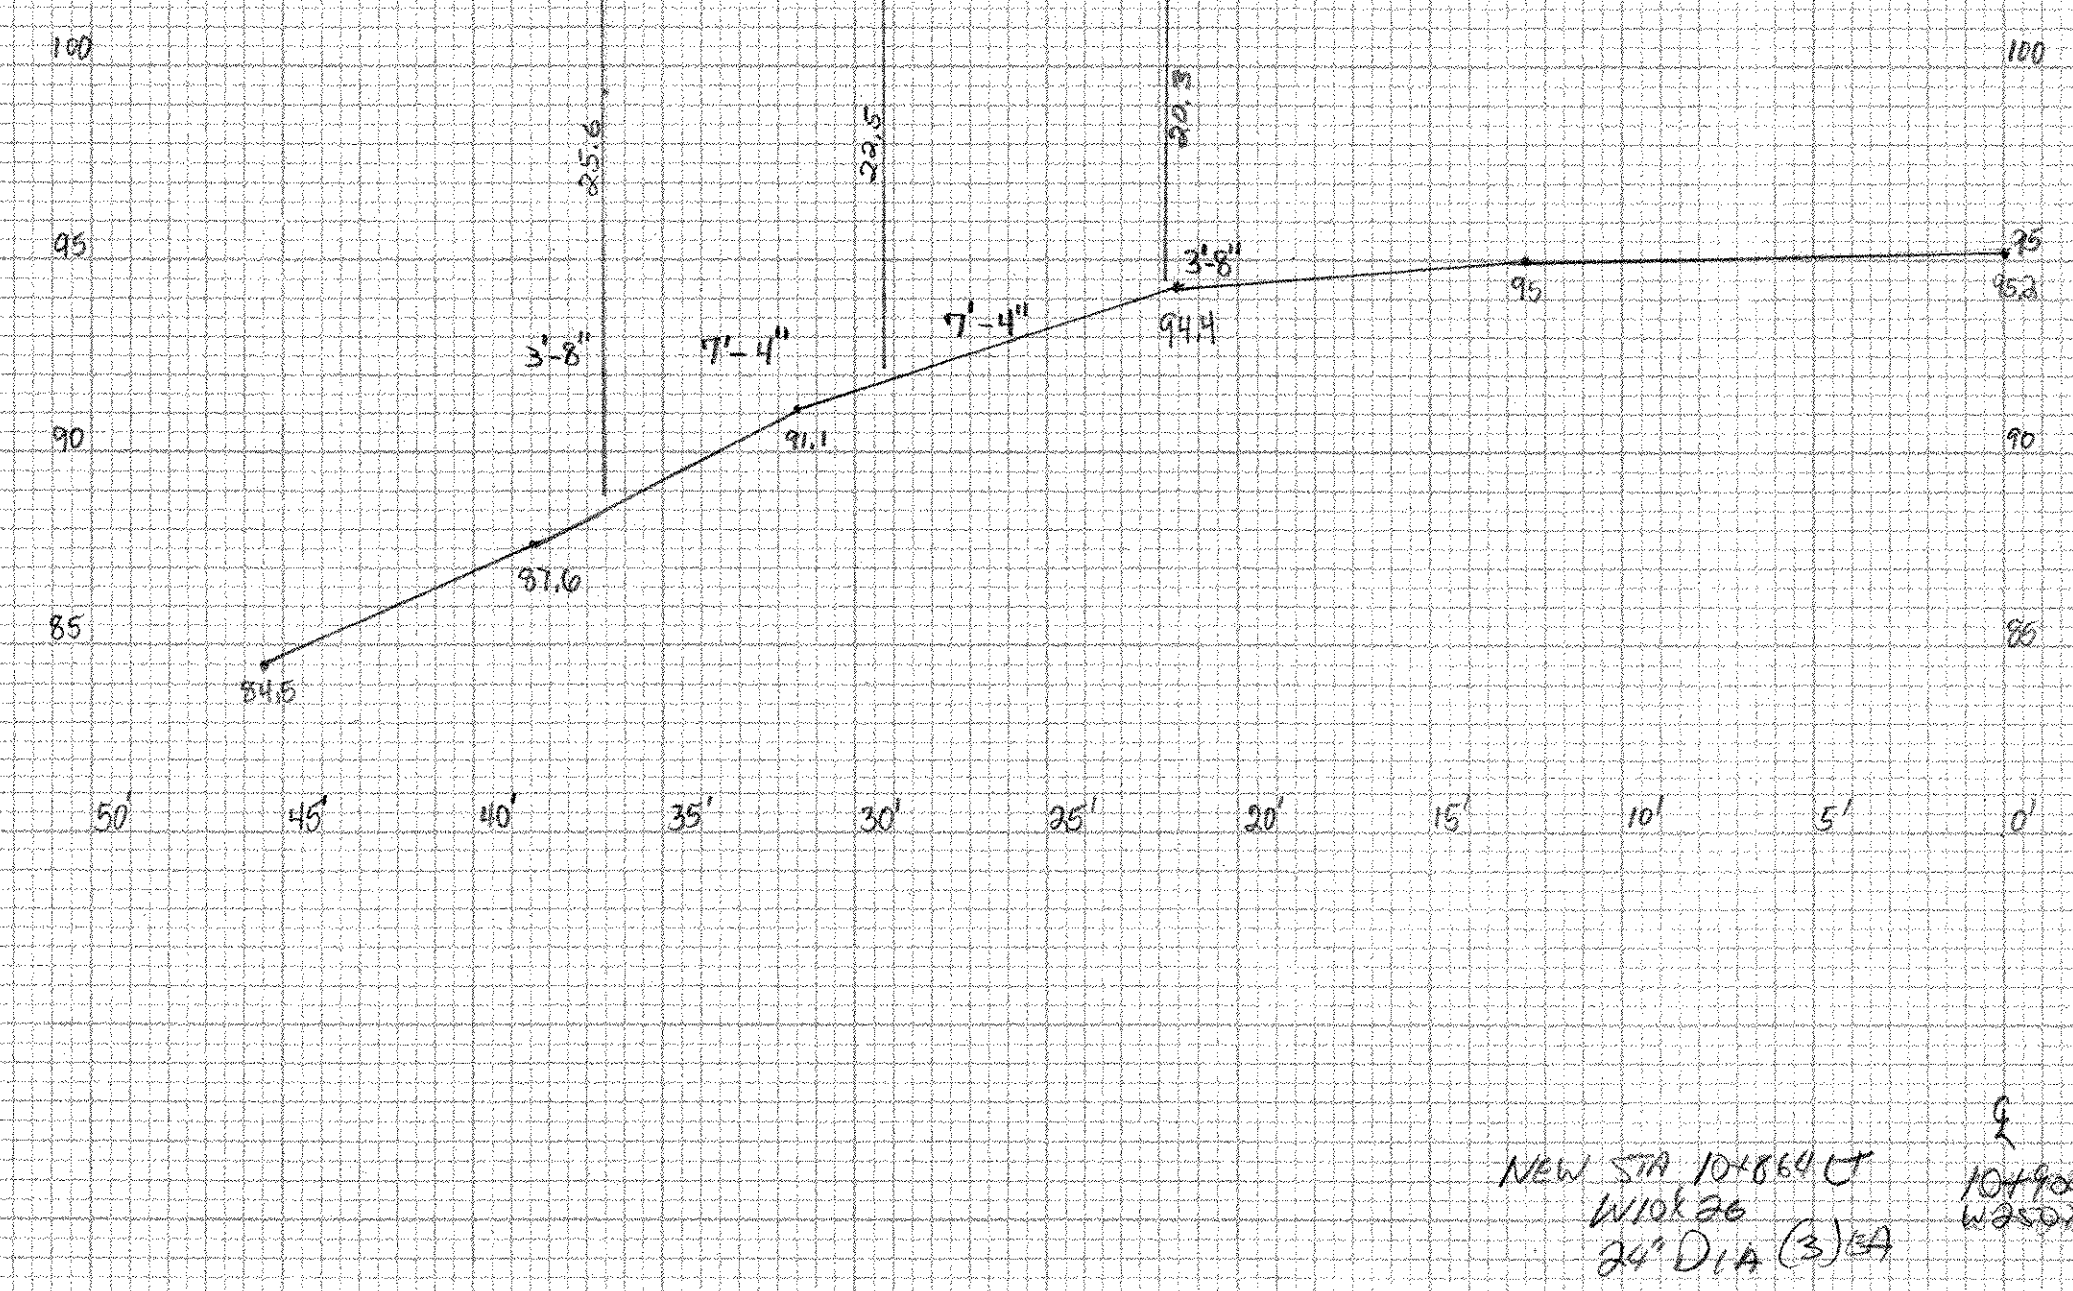

12'-6" (3750mm)  
 VERMONT  
 30  
 Castleton Corners 2  
 Fair Haven  
 11

