



NO.	DATE
1	1/2/81
2	1/2/81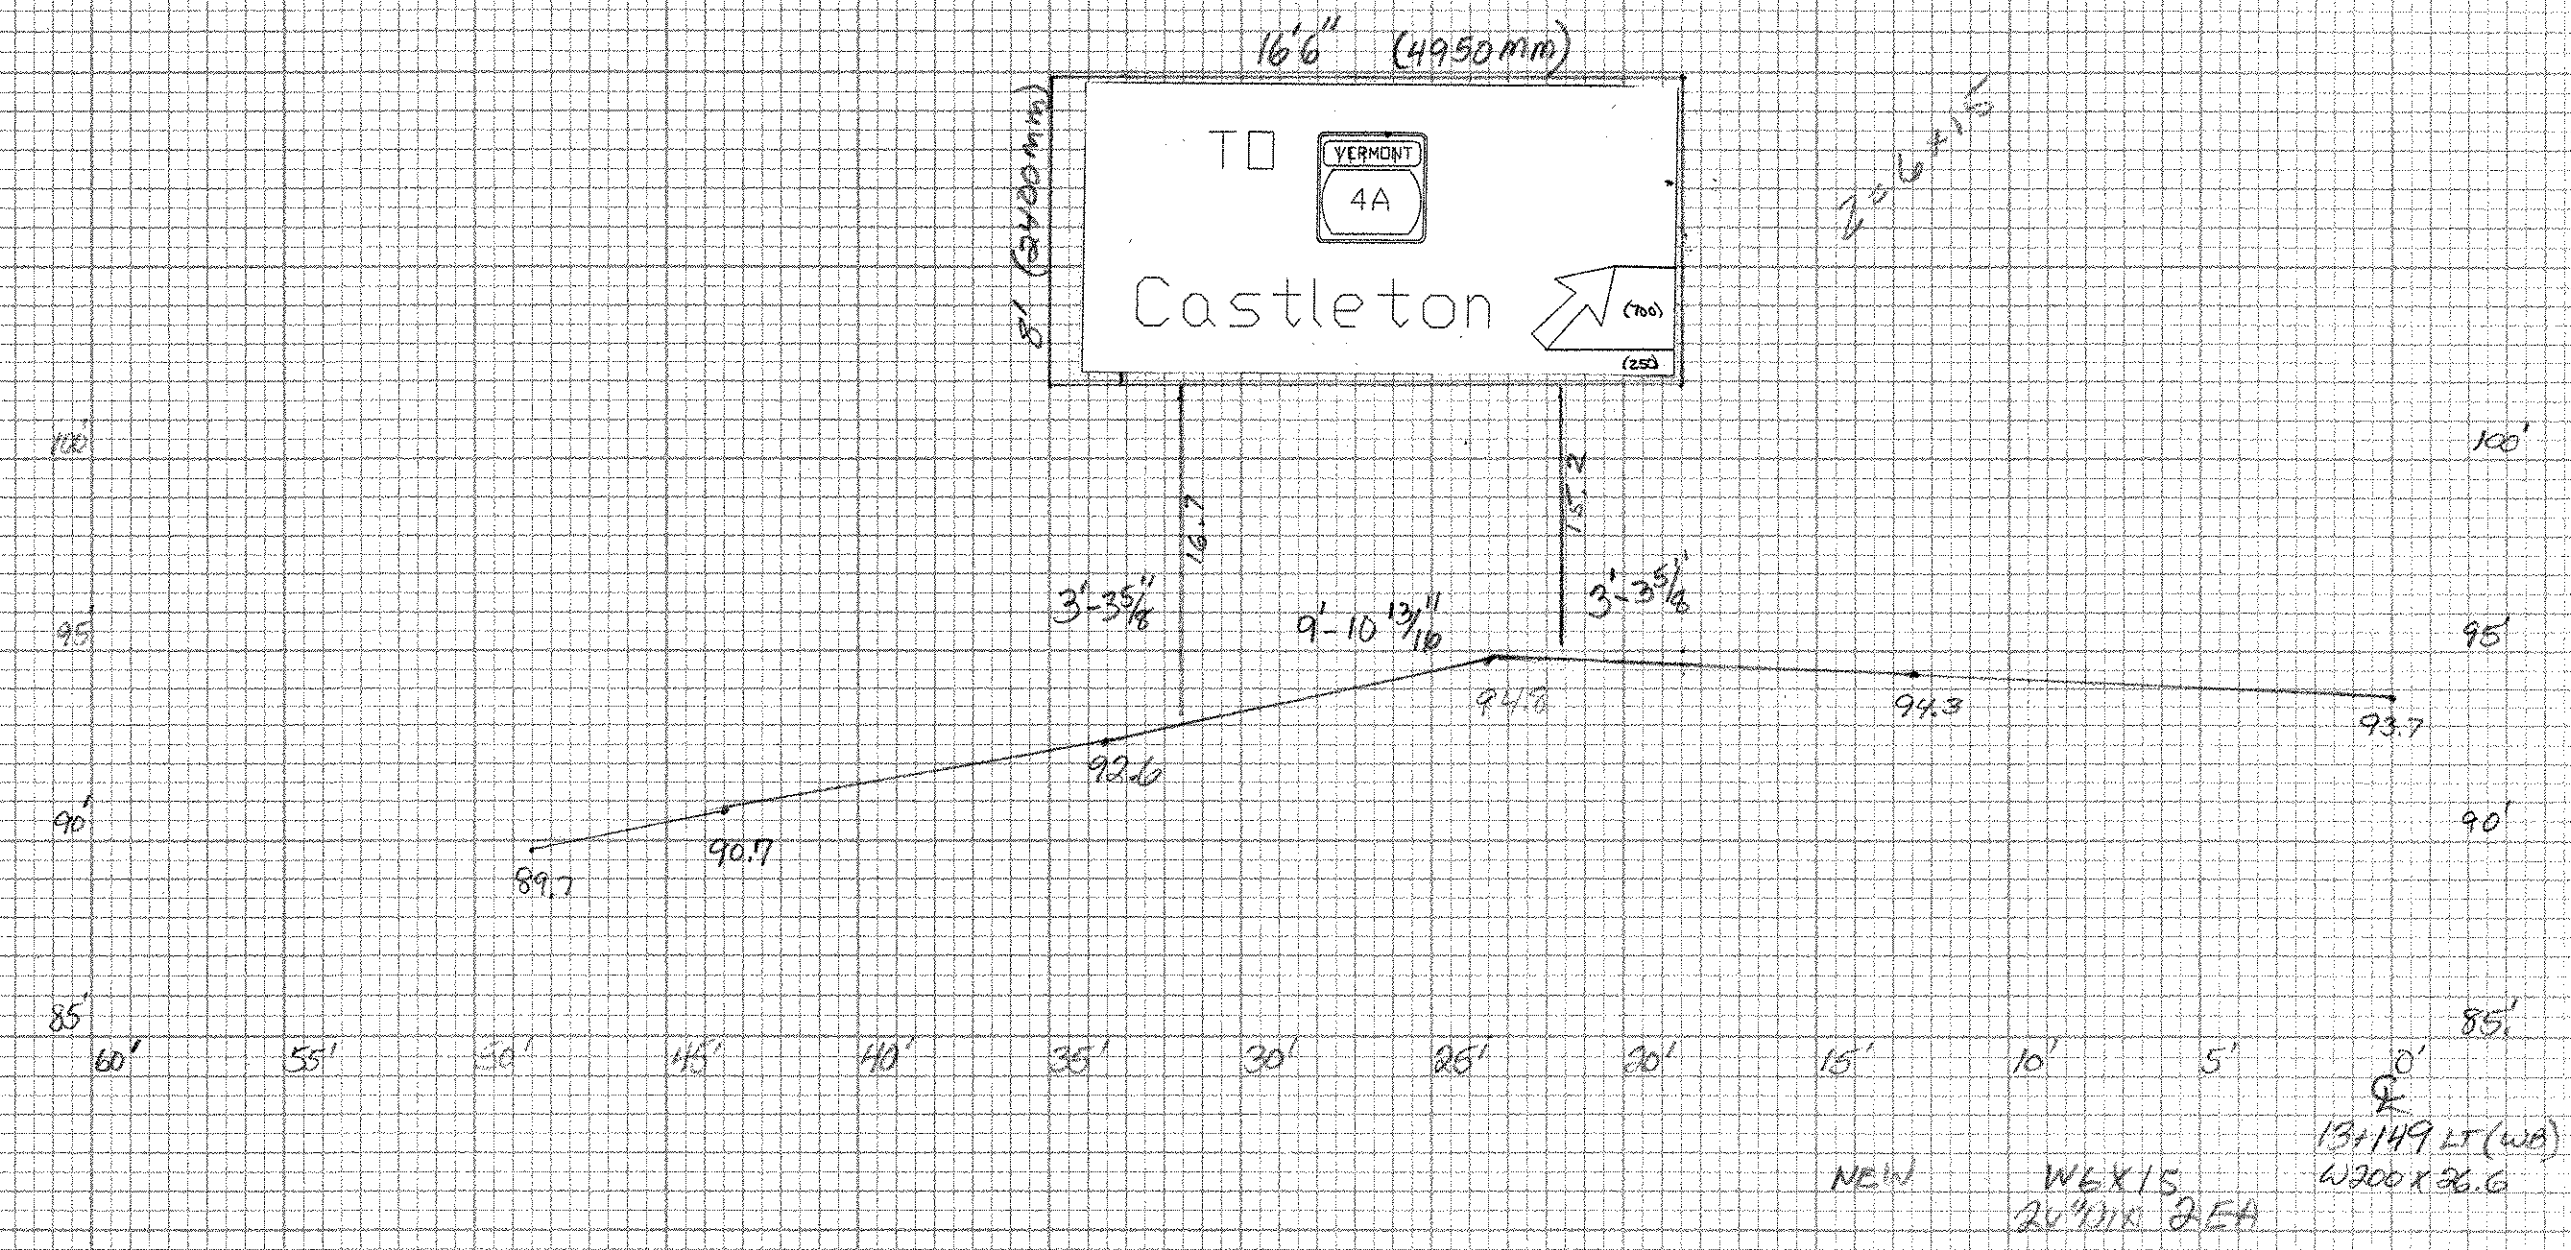
NO.	DATE
1	1/2/81
2	1/2/81
3	1/2/81
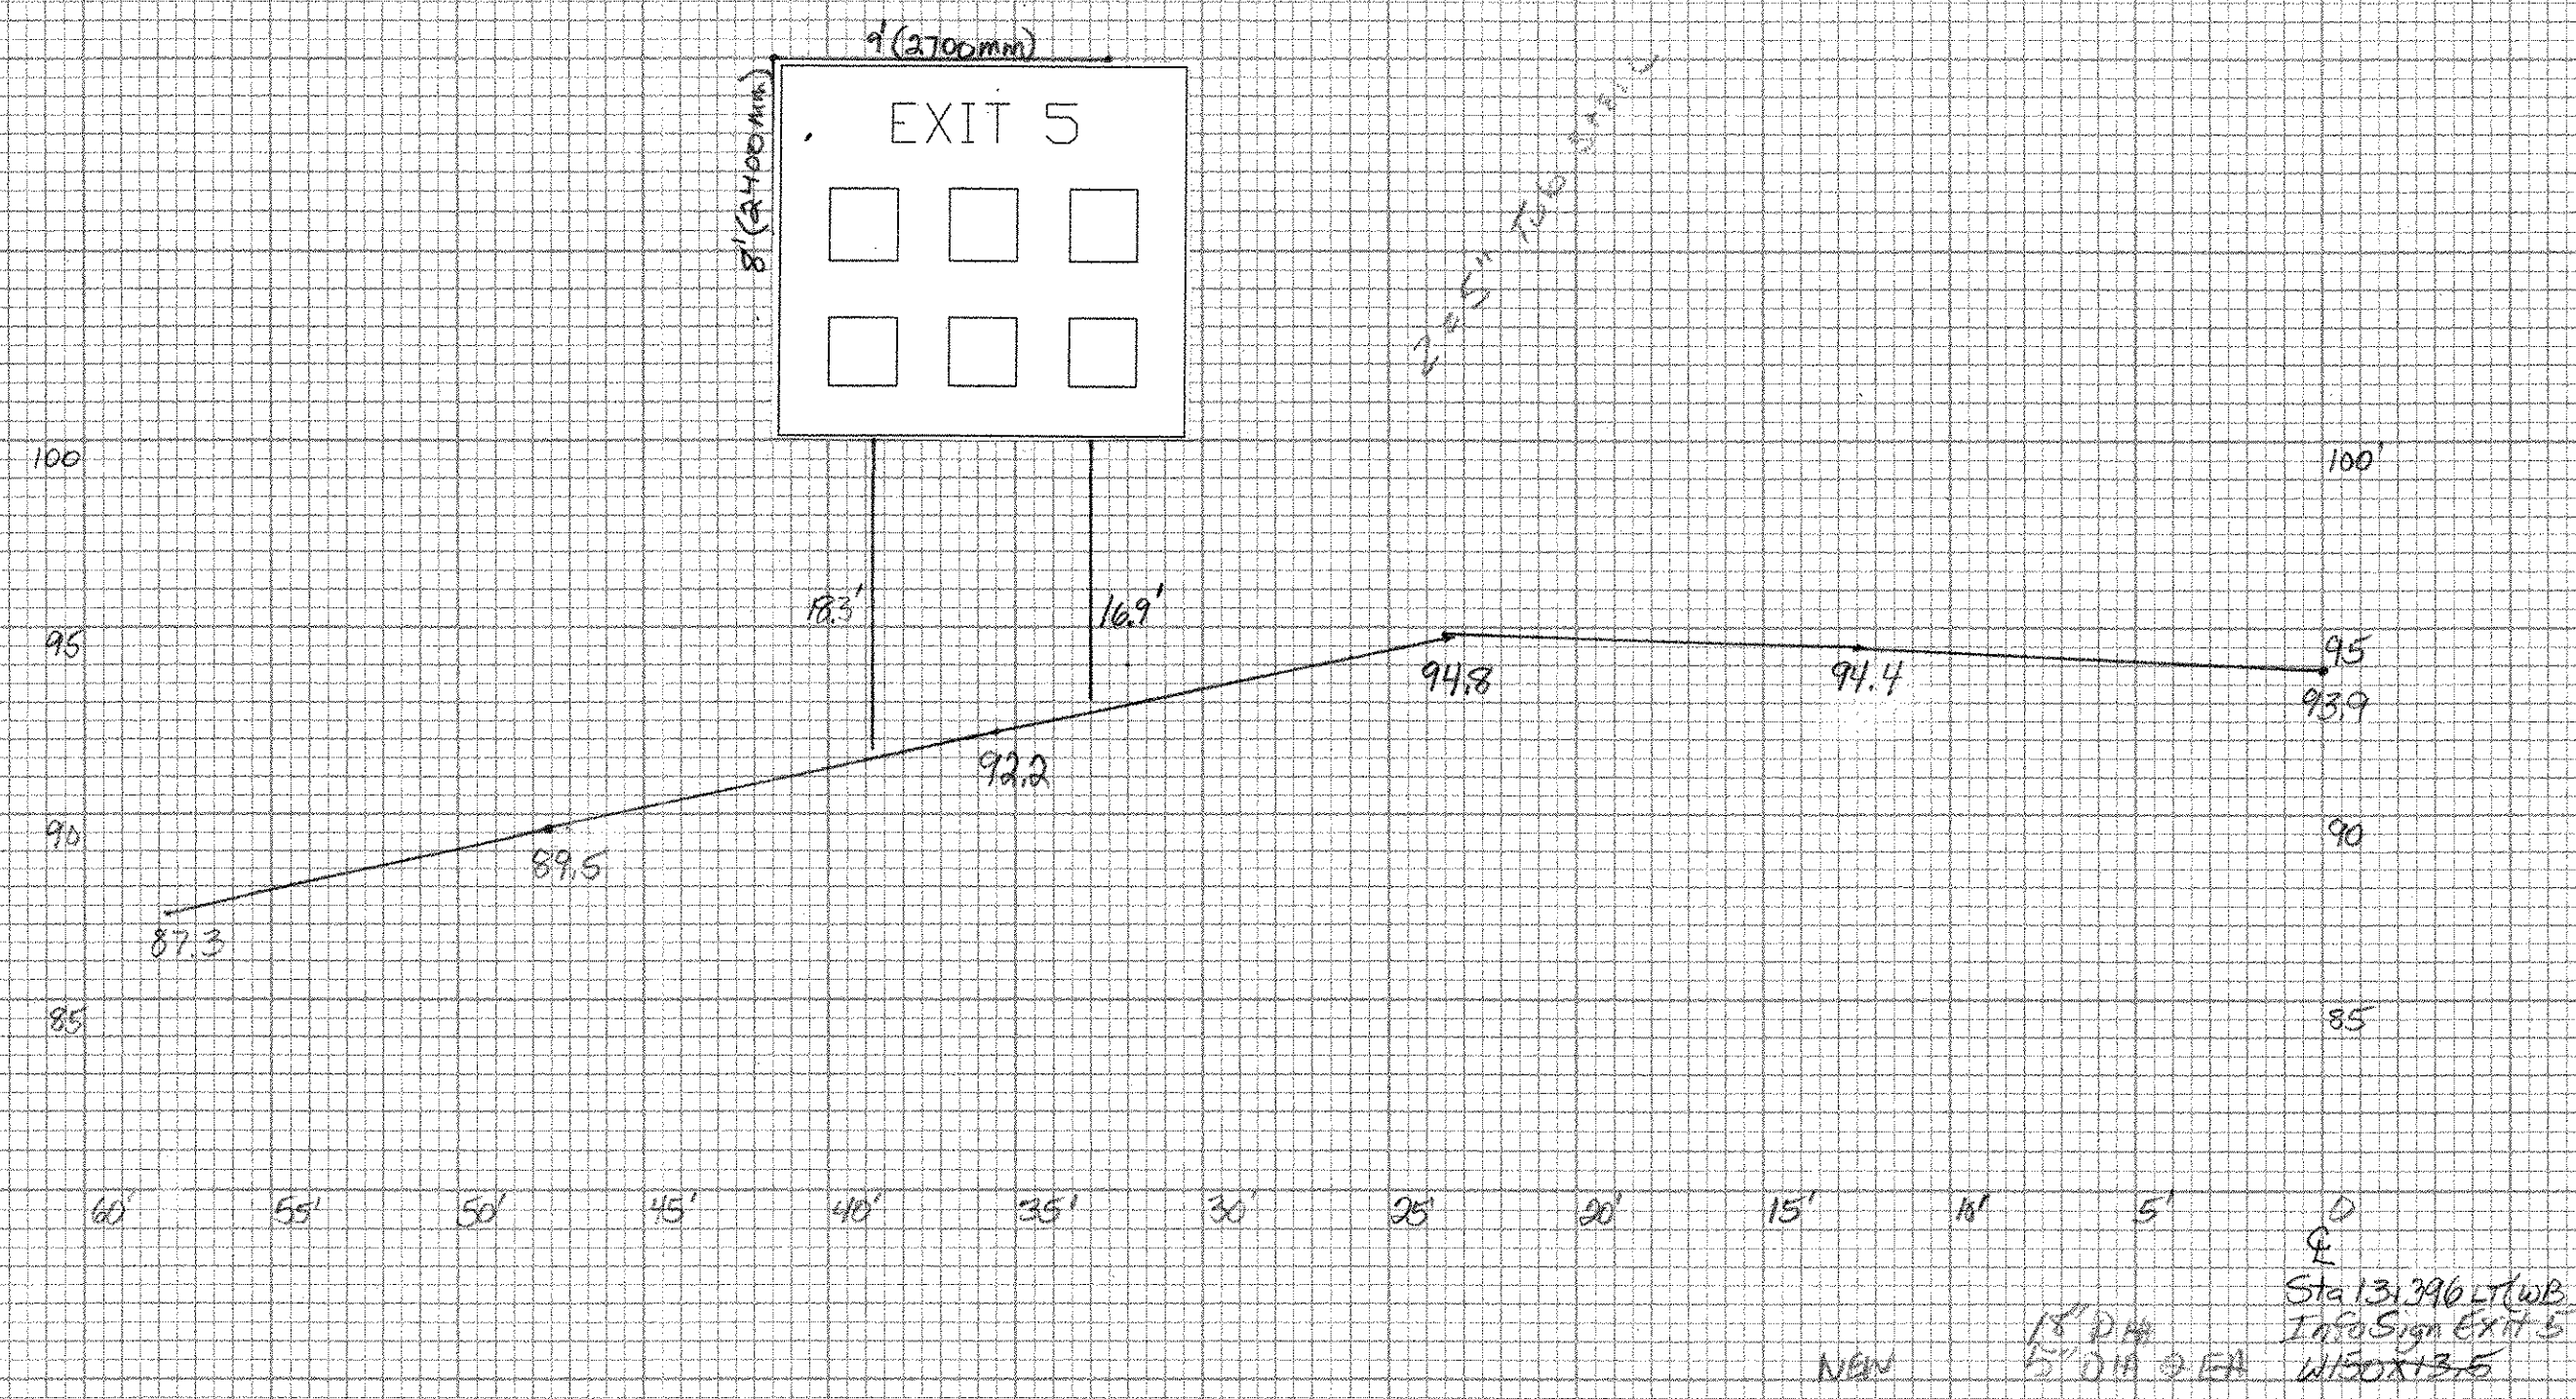