
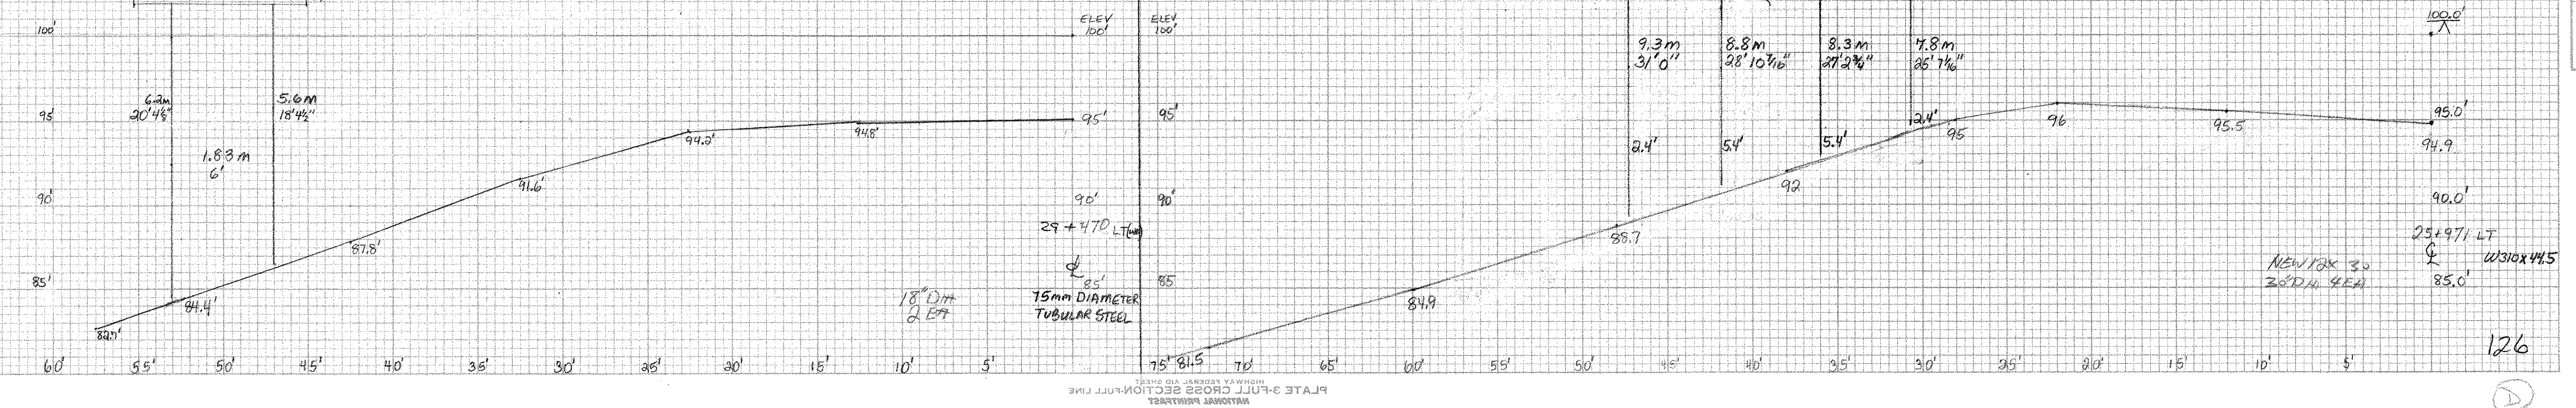
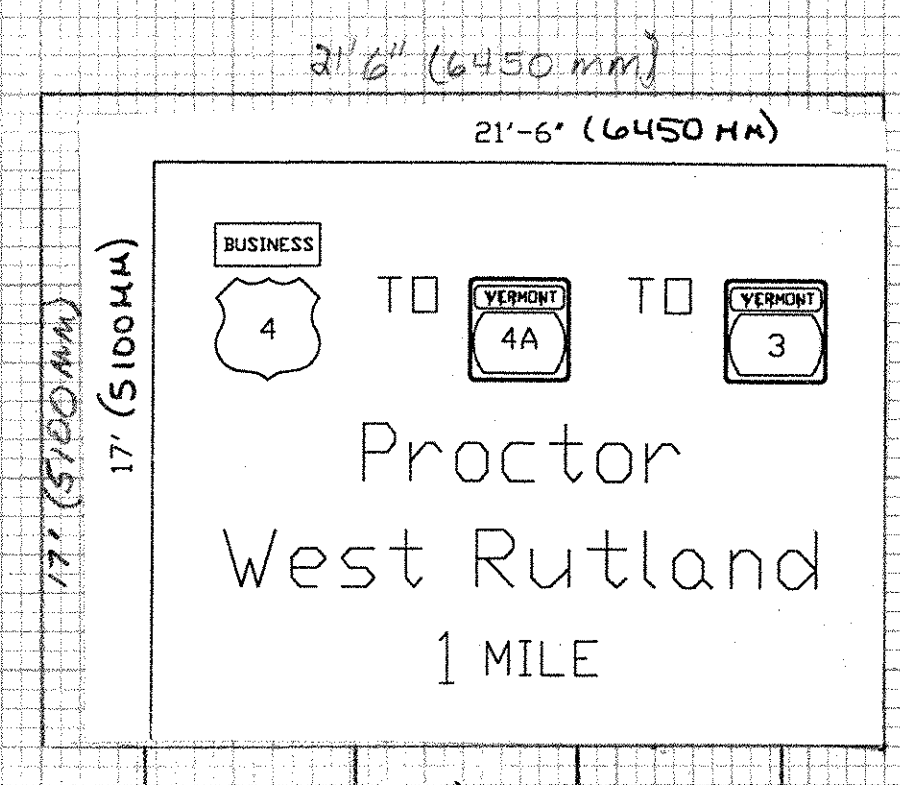


West Rutland 4  
Fair Haven 16

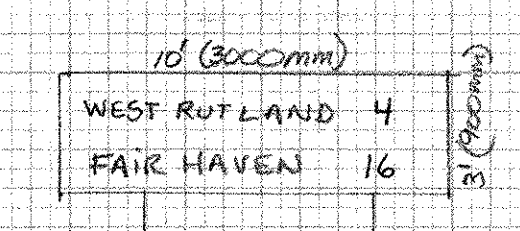

NO. 1000  
NO. 1001  
NO. 1002  
NO. 1003  
NO. 1004  
NO. 1005  
NO. 1006  
NO. 1007  
NO. 1008  
NO. 1009  
NO. 1010

NO. 1011  
NO. 1012  
NO. 1013  
NO. 1014  
NO. 1015  
NO. 1016  
NO. 1017  
NO. 1018  
NO. 1019  
NO. 1020