
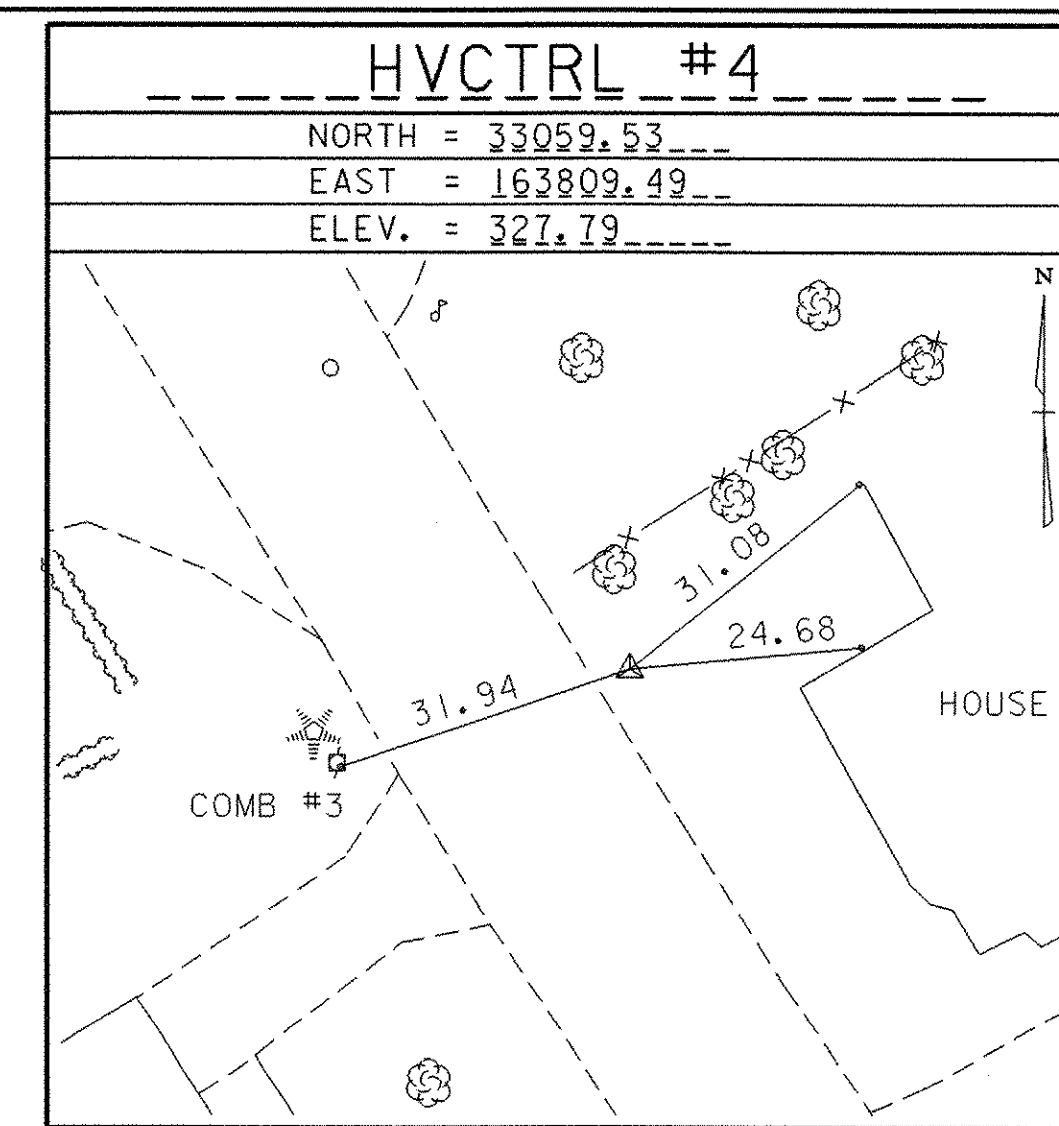
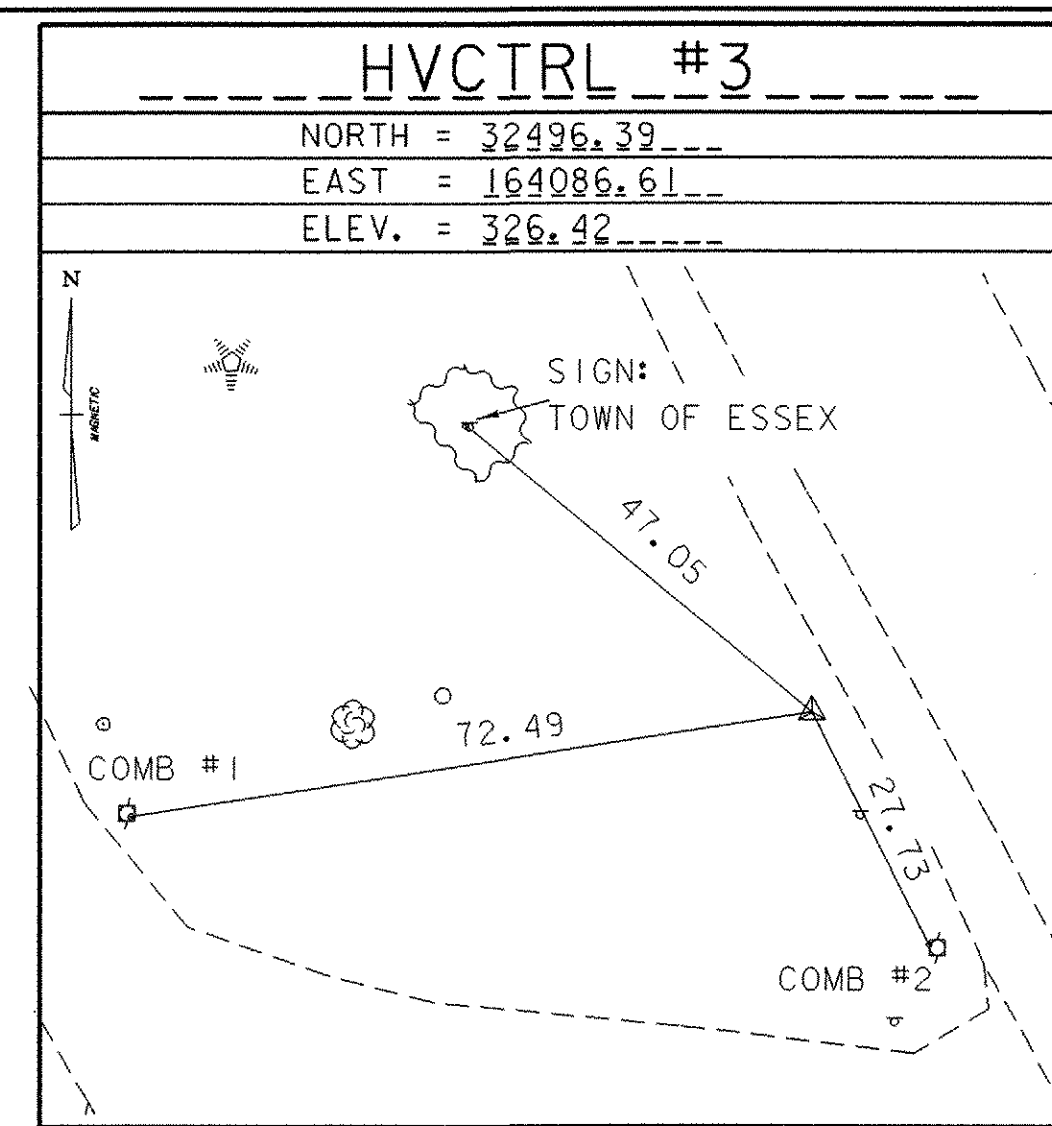
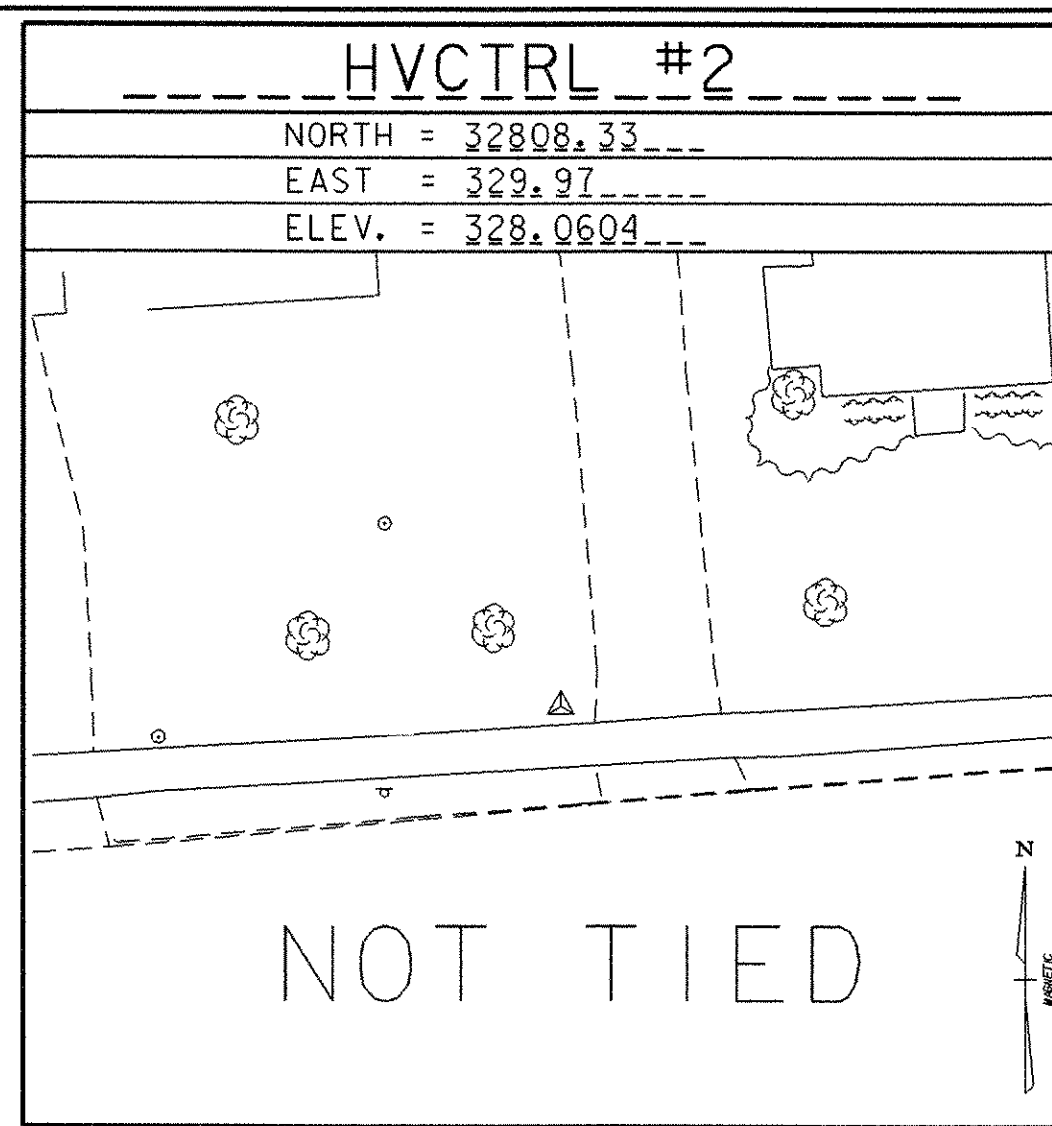







NO GPS CONTROL
CONTROL ASSUMED

TRAVERSE TIES





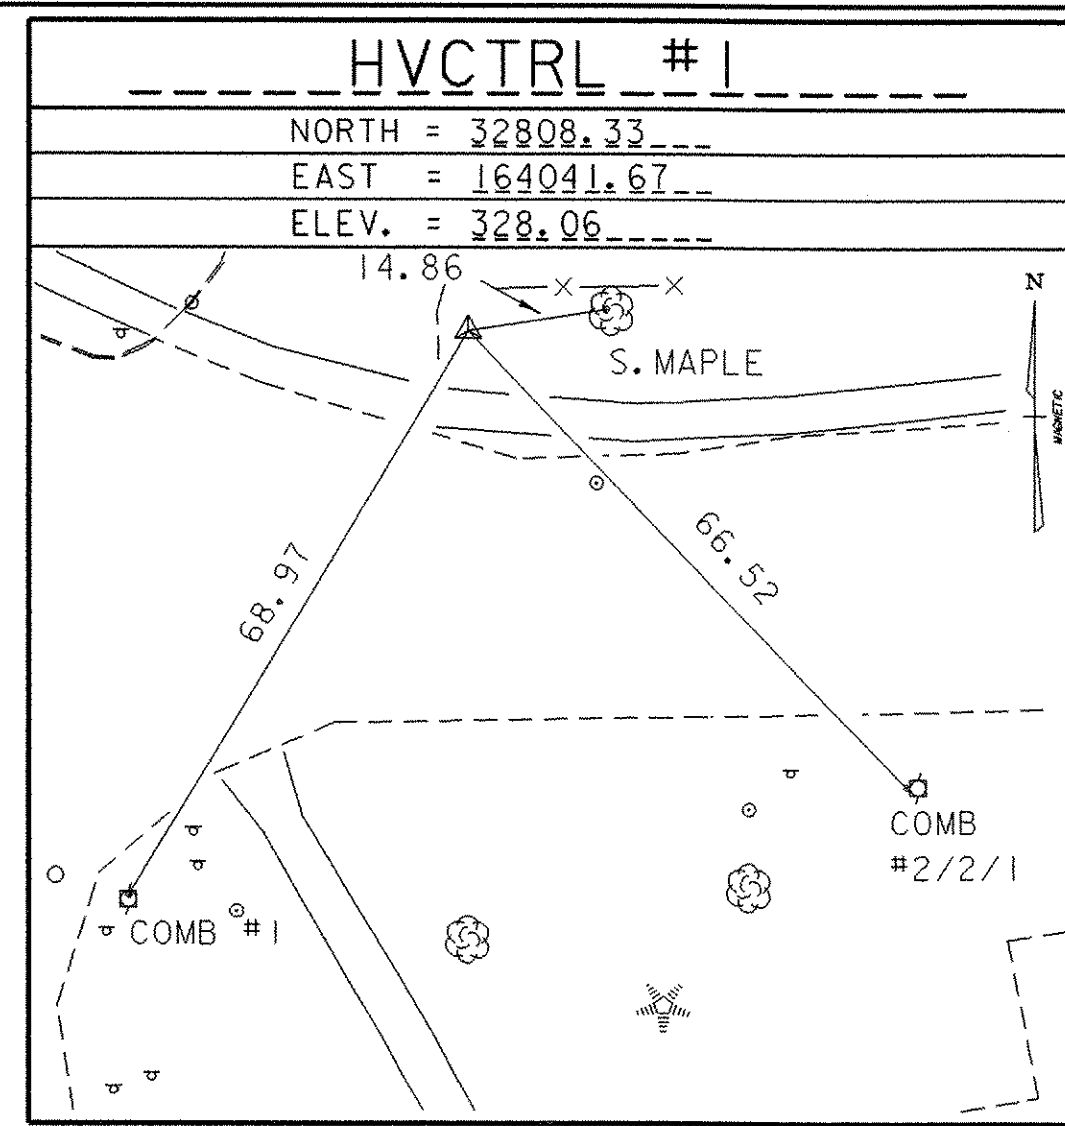


* MAIN TRAVERSE COMPLETED: DEC. 18, 2000 BY L.ORVIS PC & J.HULETT

ALIGNMENT TIES

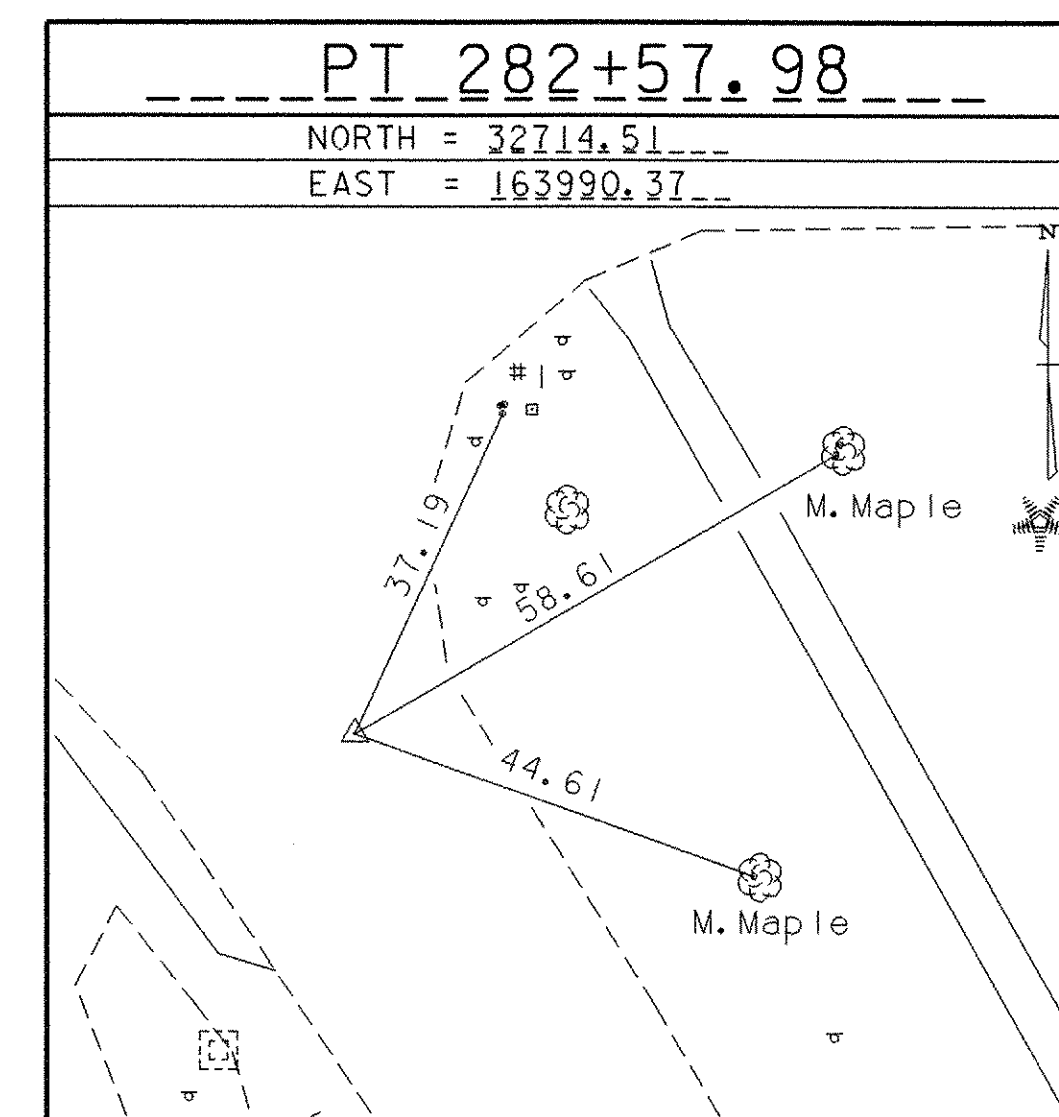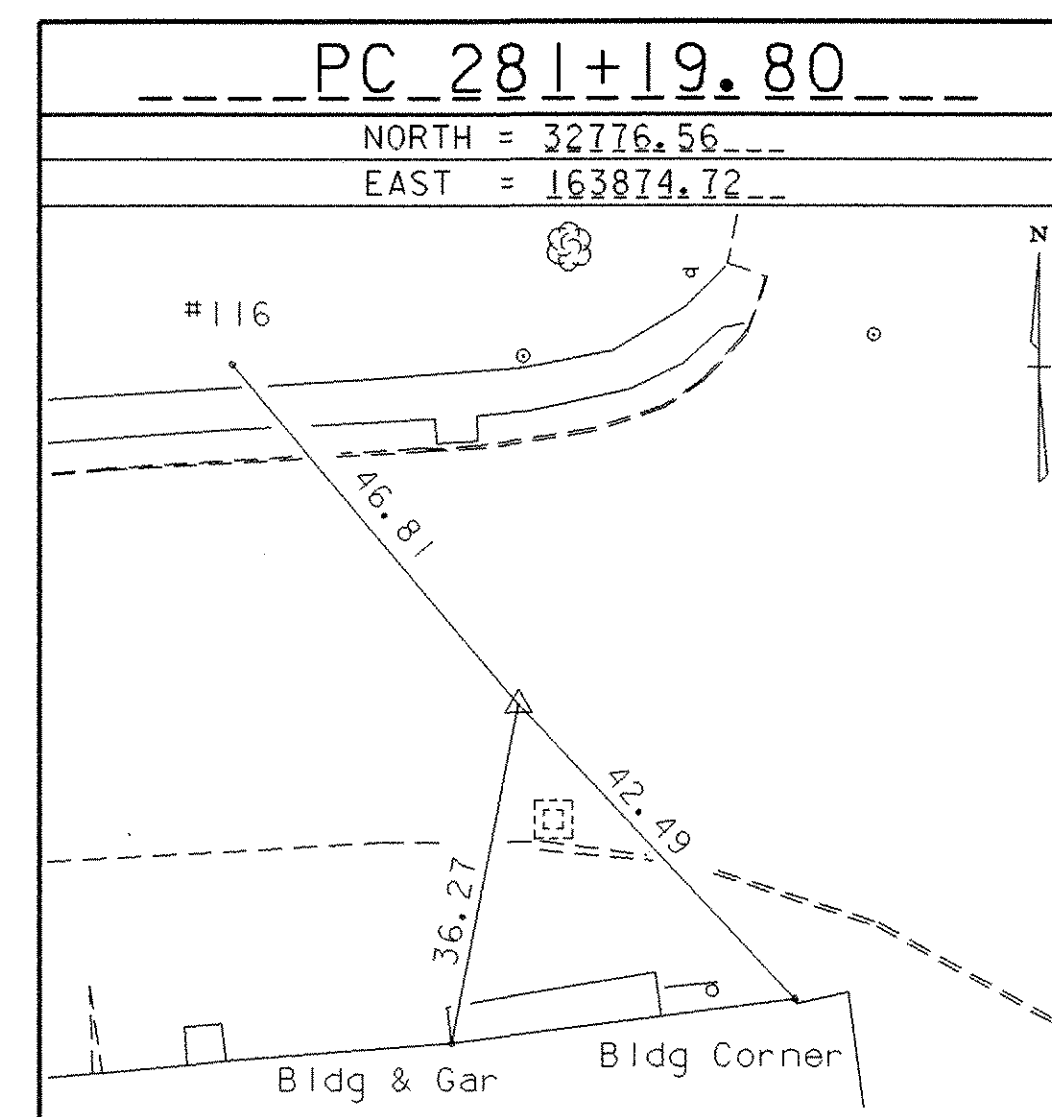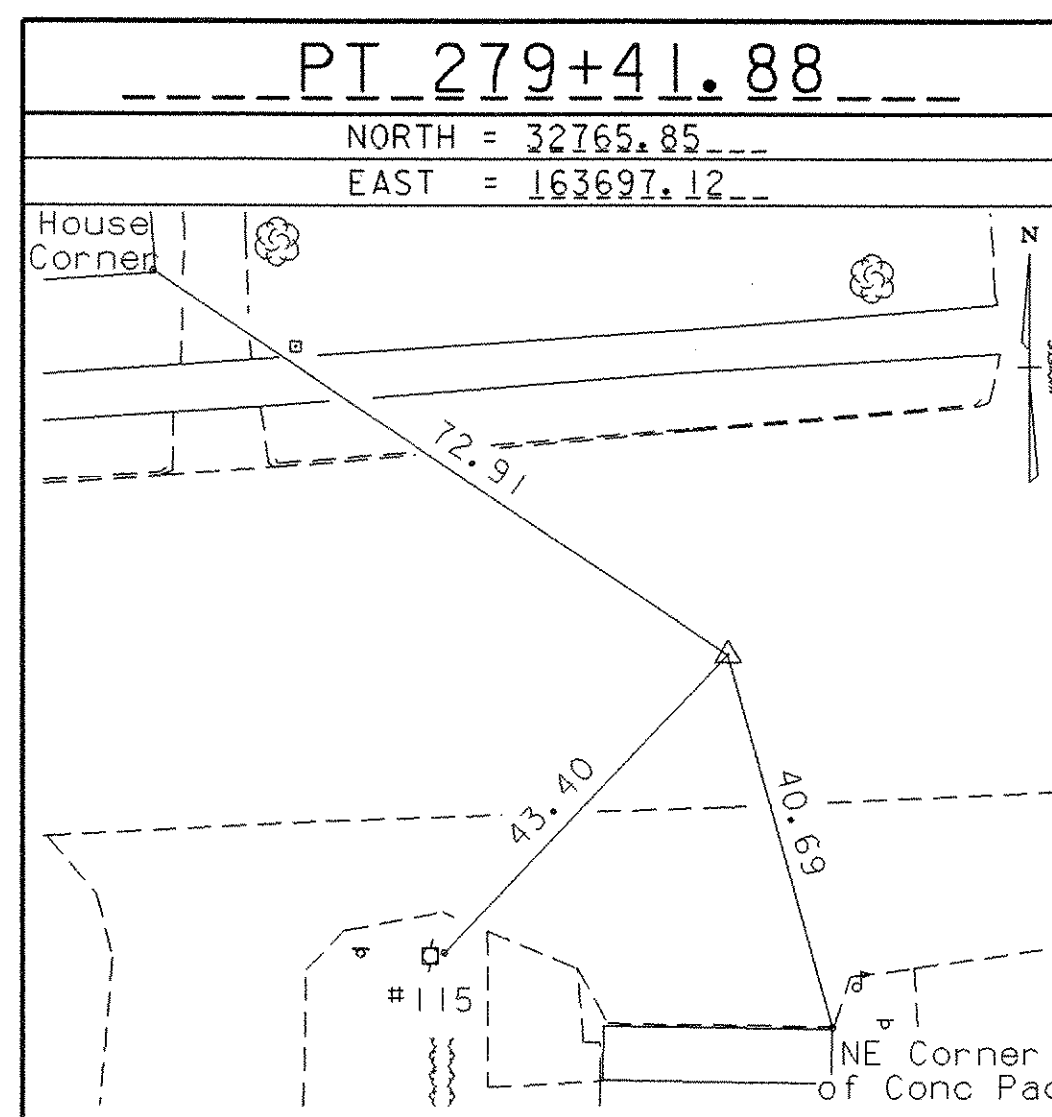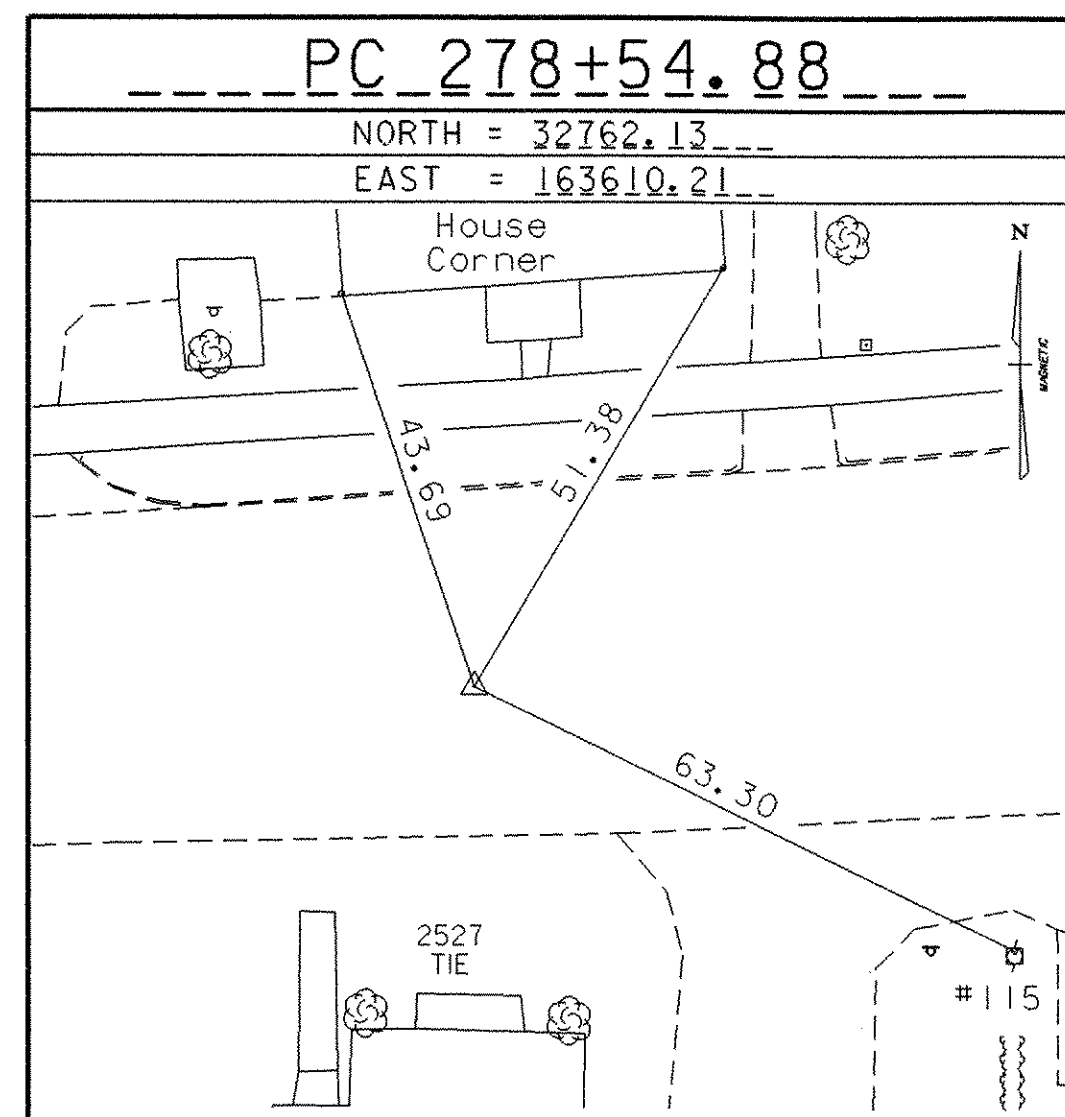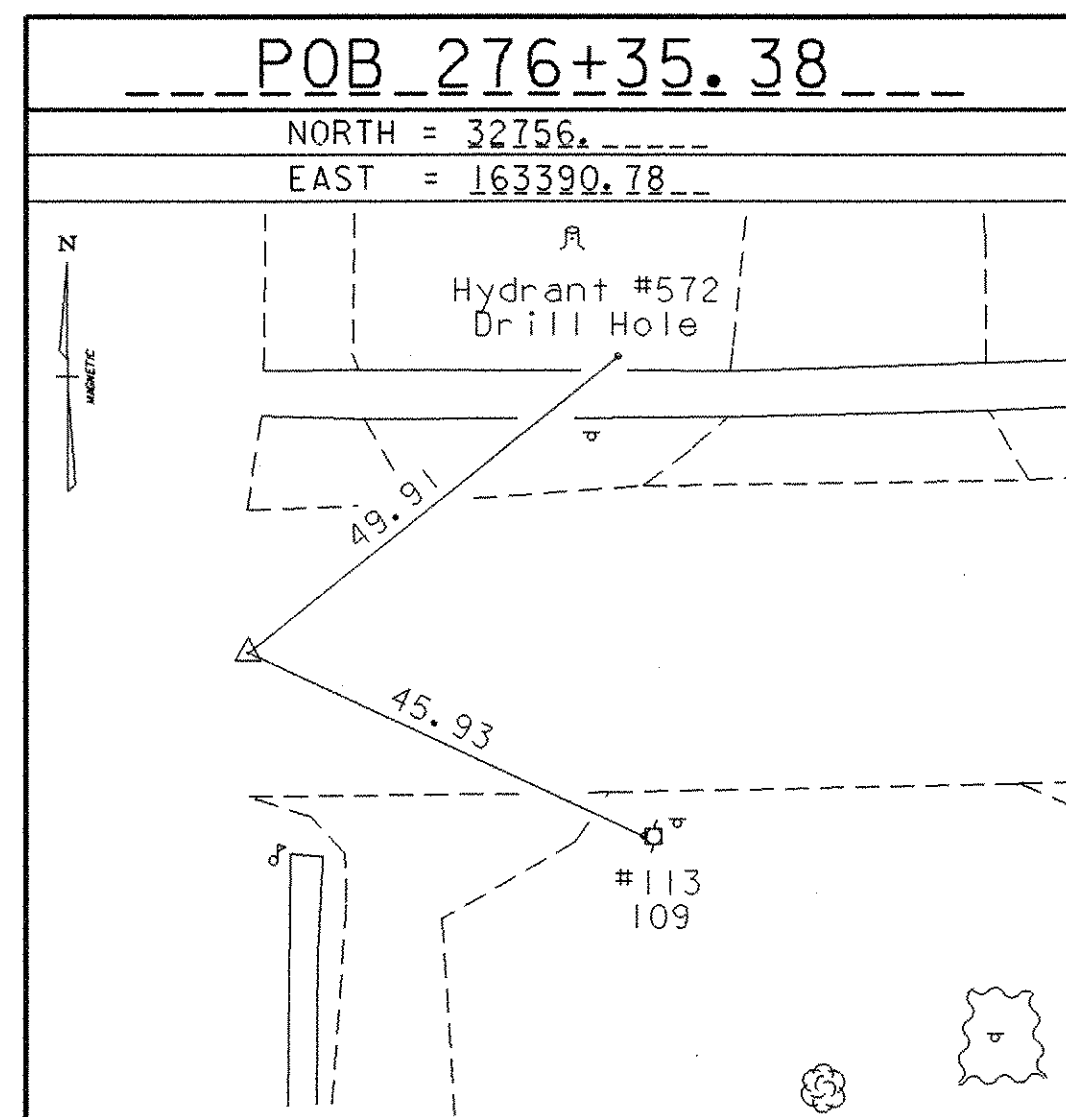

ALIGNMENT TIES

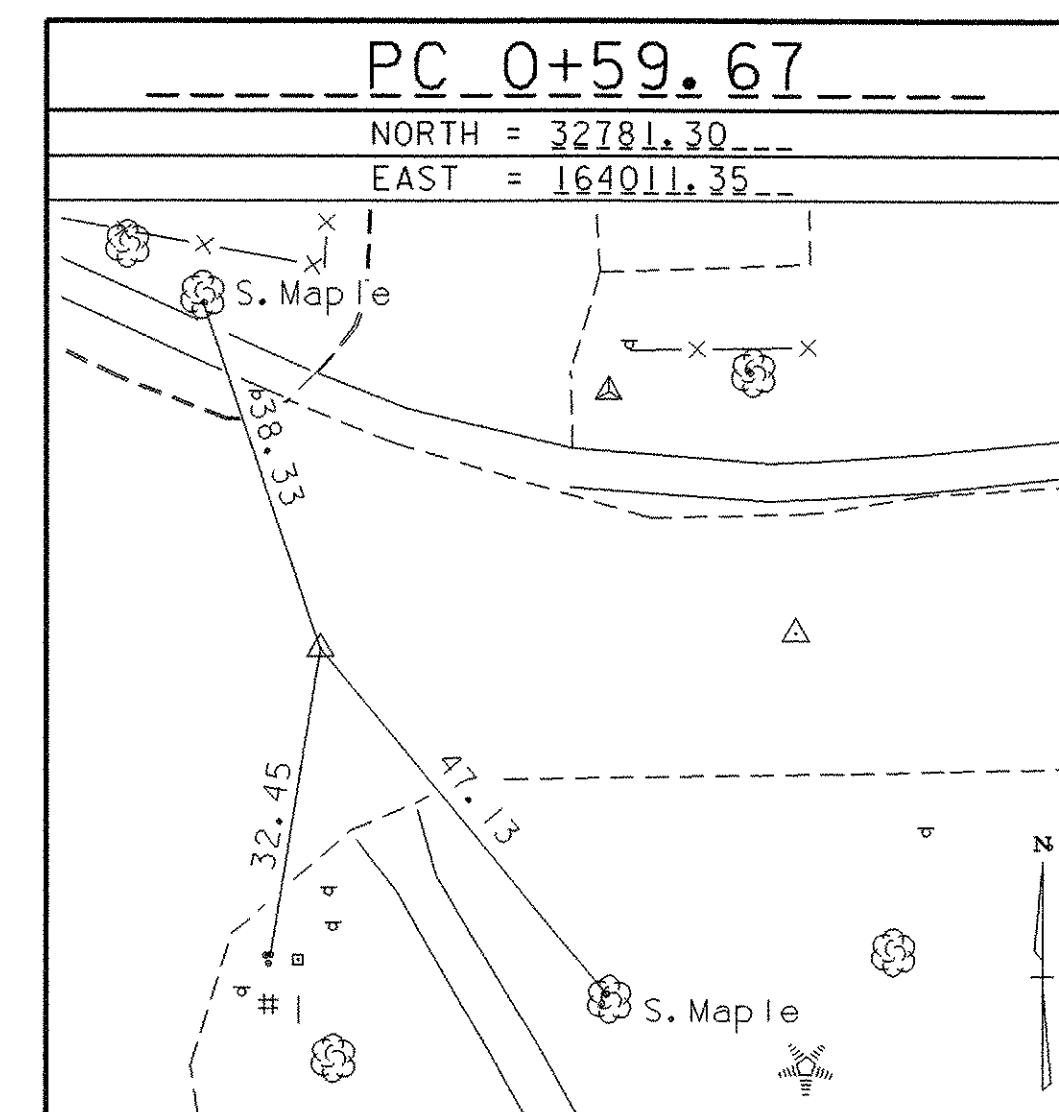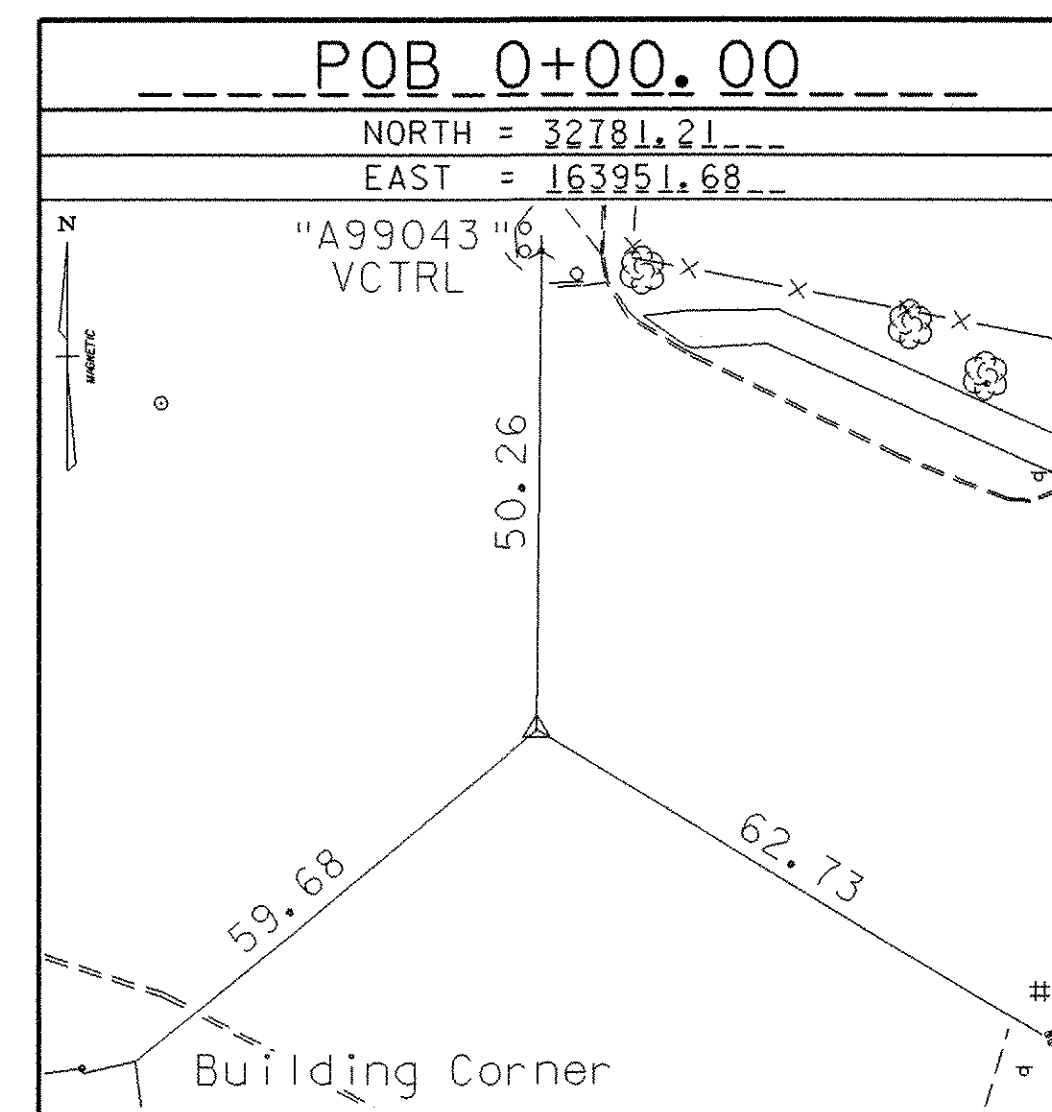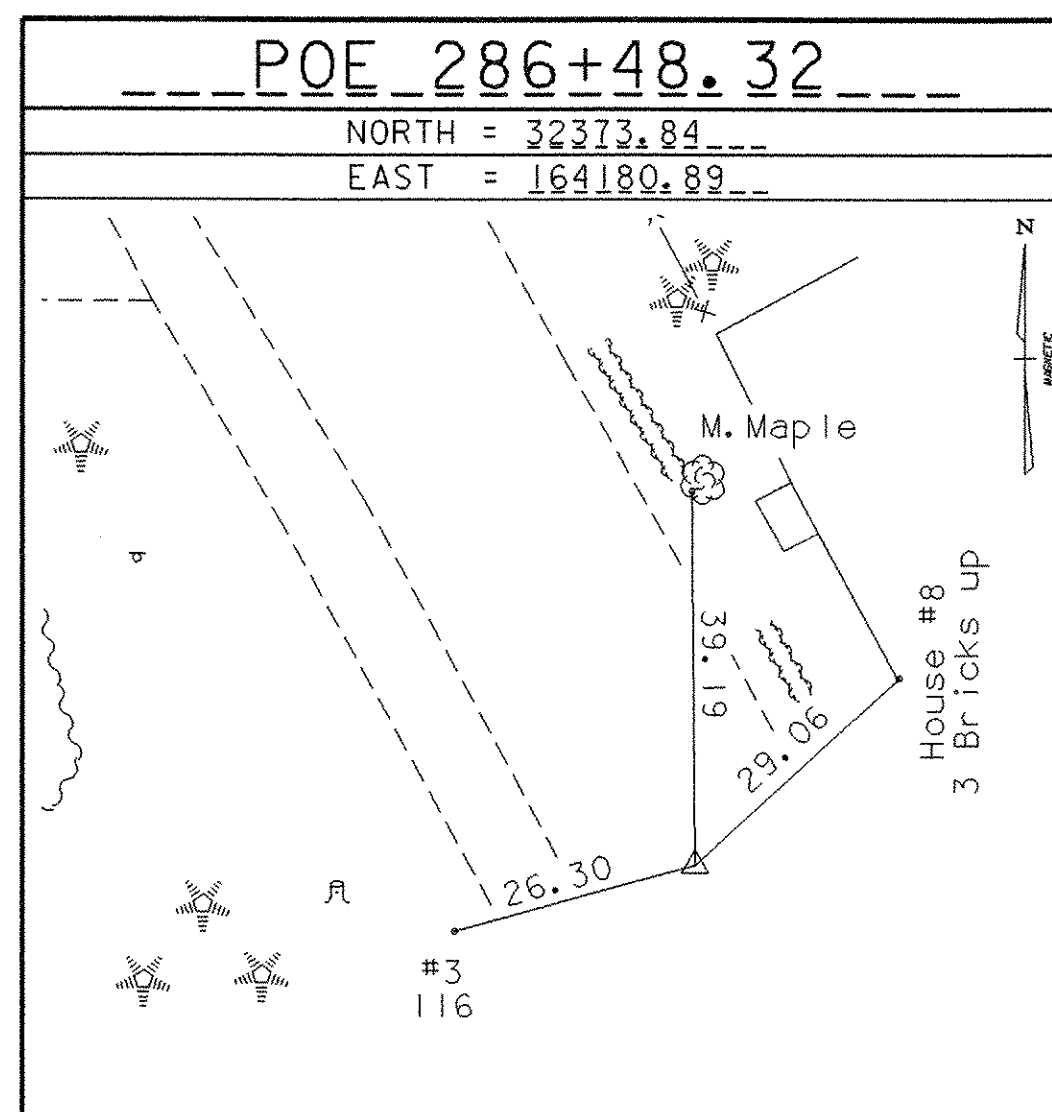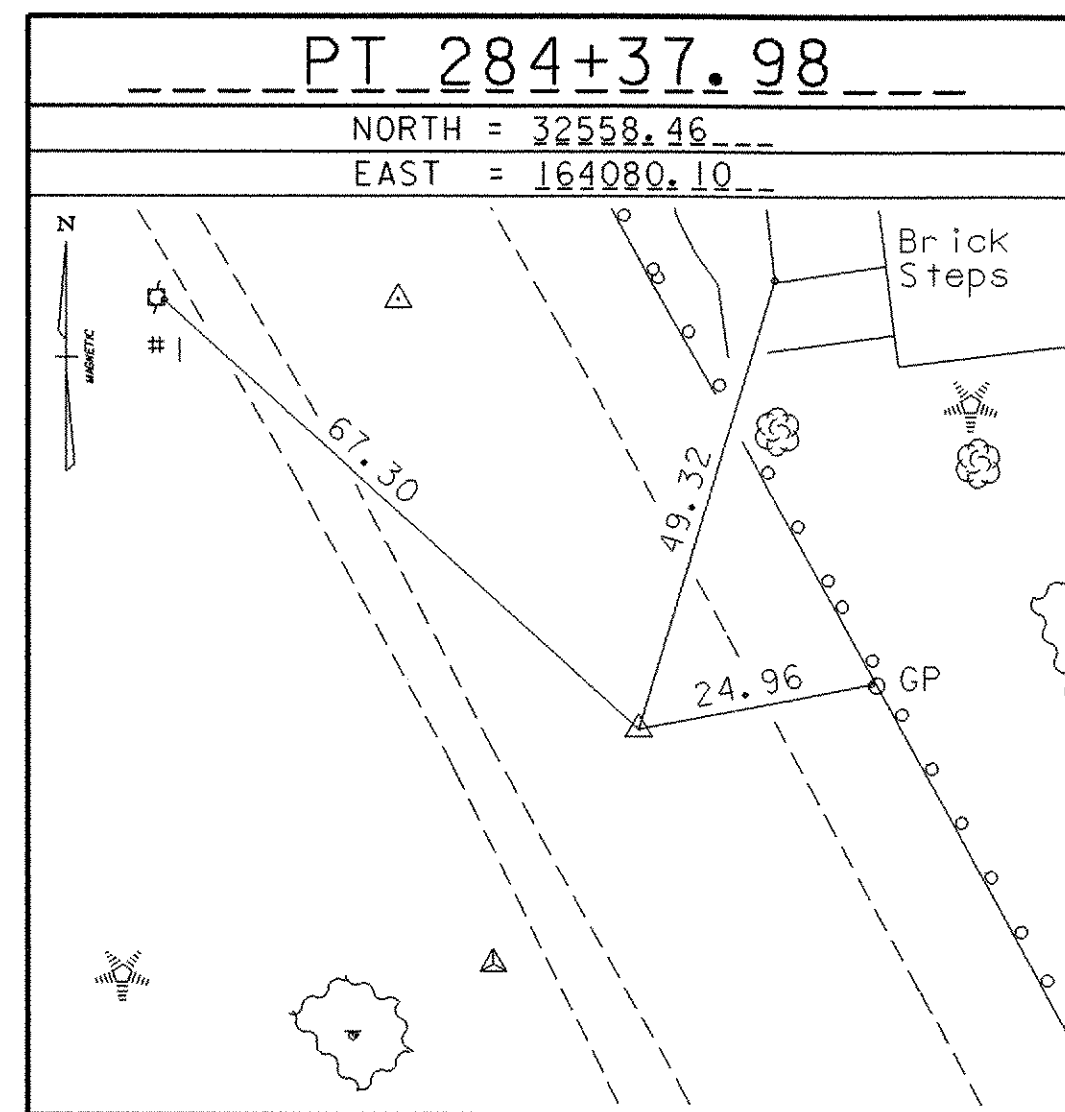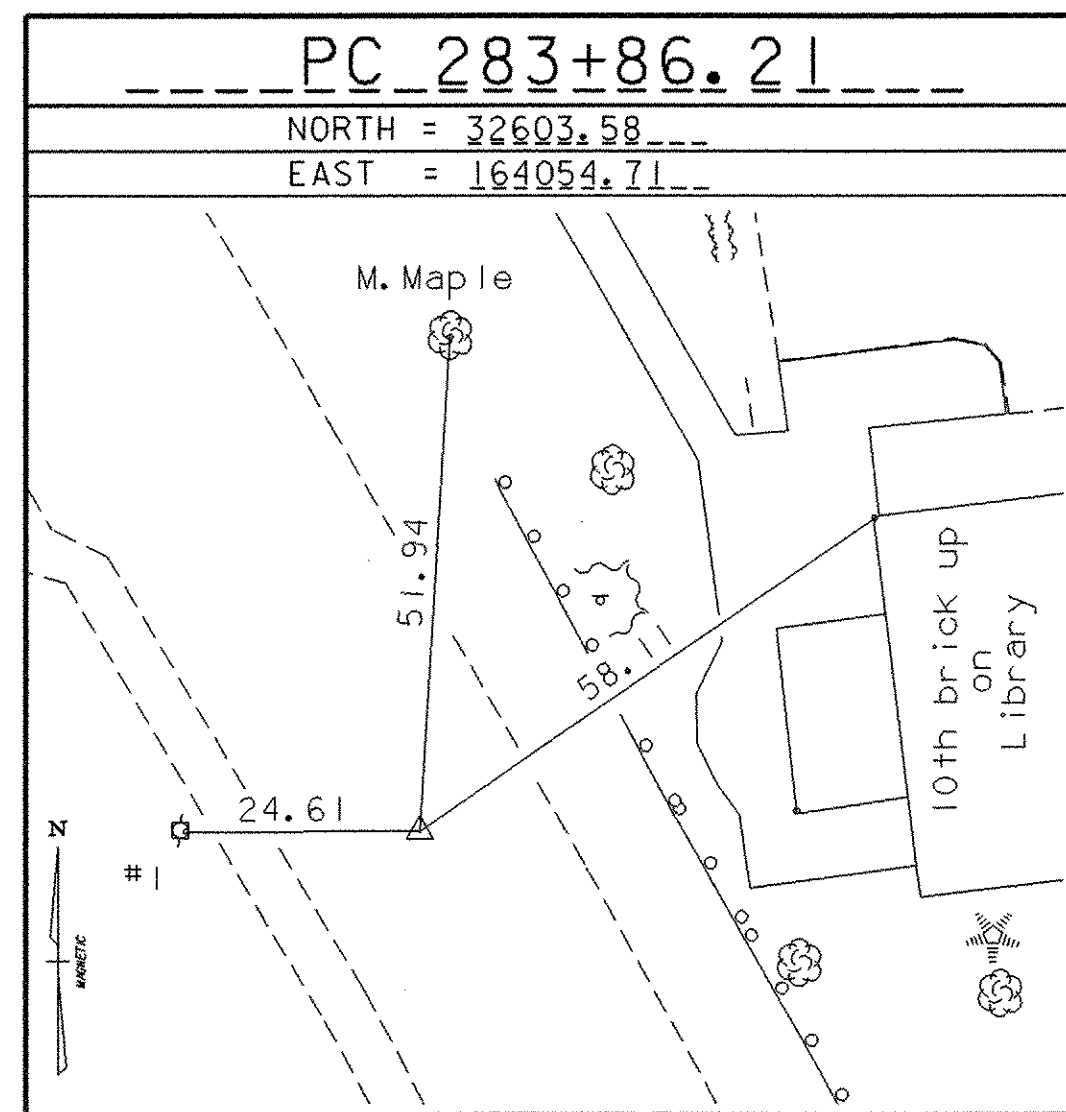

DATUM

VERTICAL ASSUMED

HORIZONTAL ASSUMED

ADJUSTMENT NONE

PROJECT NAME: ESSEX

PROJECT NUMBER: SIPG_SGNL (17)

FILE NAME: 96b182\survey\296b18211.dwg PLOT DATE: 16-NOV-2006

PROJECT LEADER: B. NYQUIST DRAWN BY: B. Bullock

DESIGNED BY: R. BULLOCK CHECKED BY: R. BULLOCK

tb182+11 SHEET 6 OF 29