

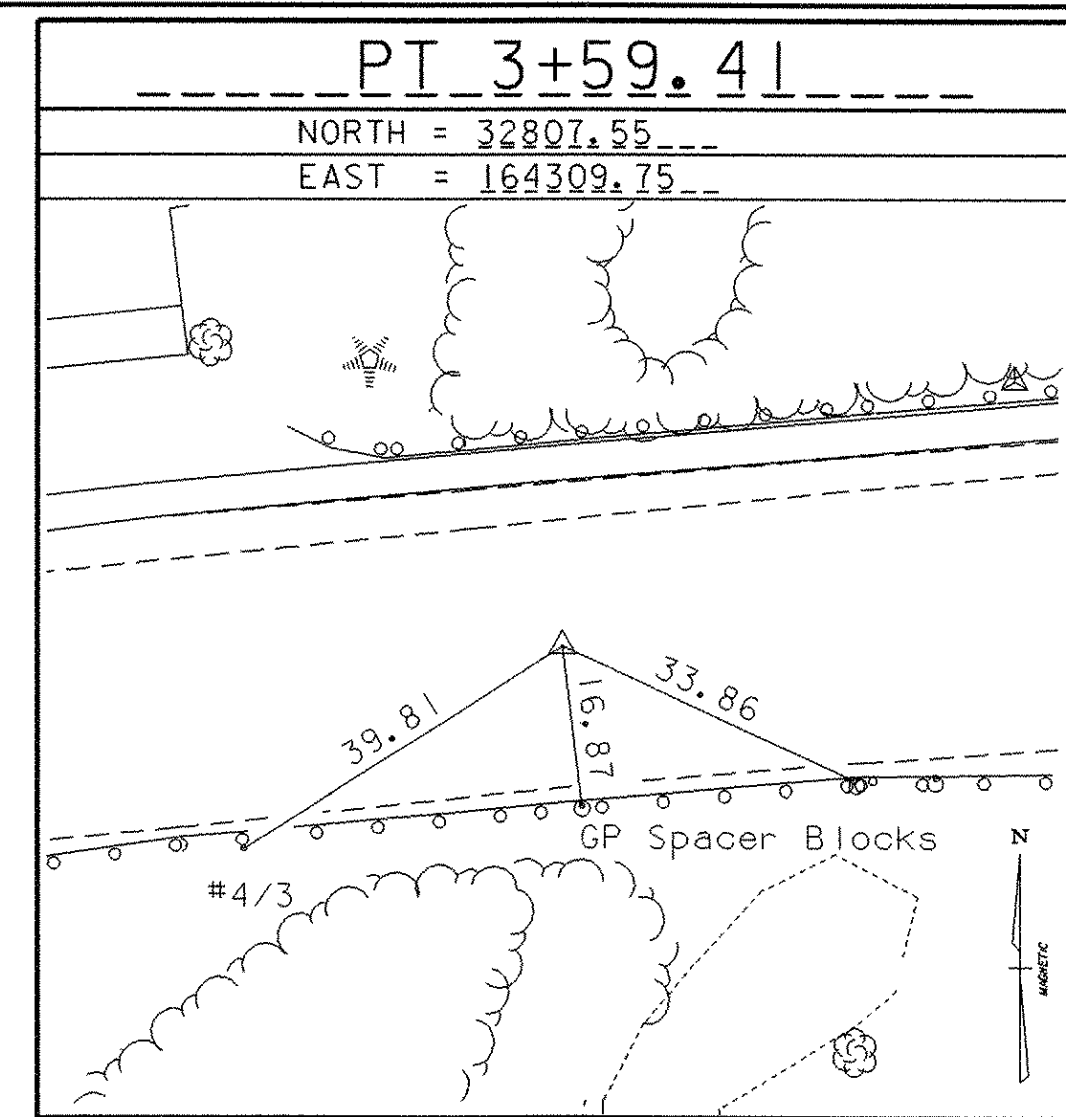
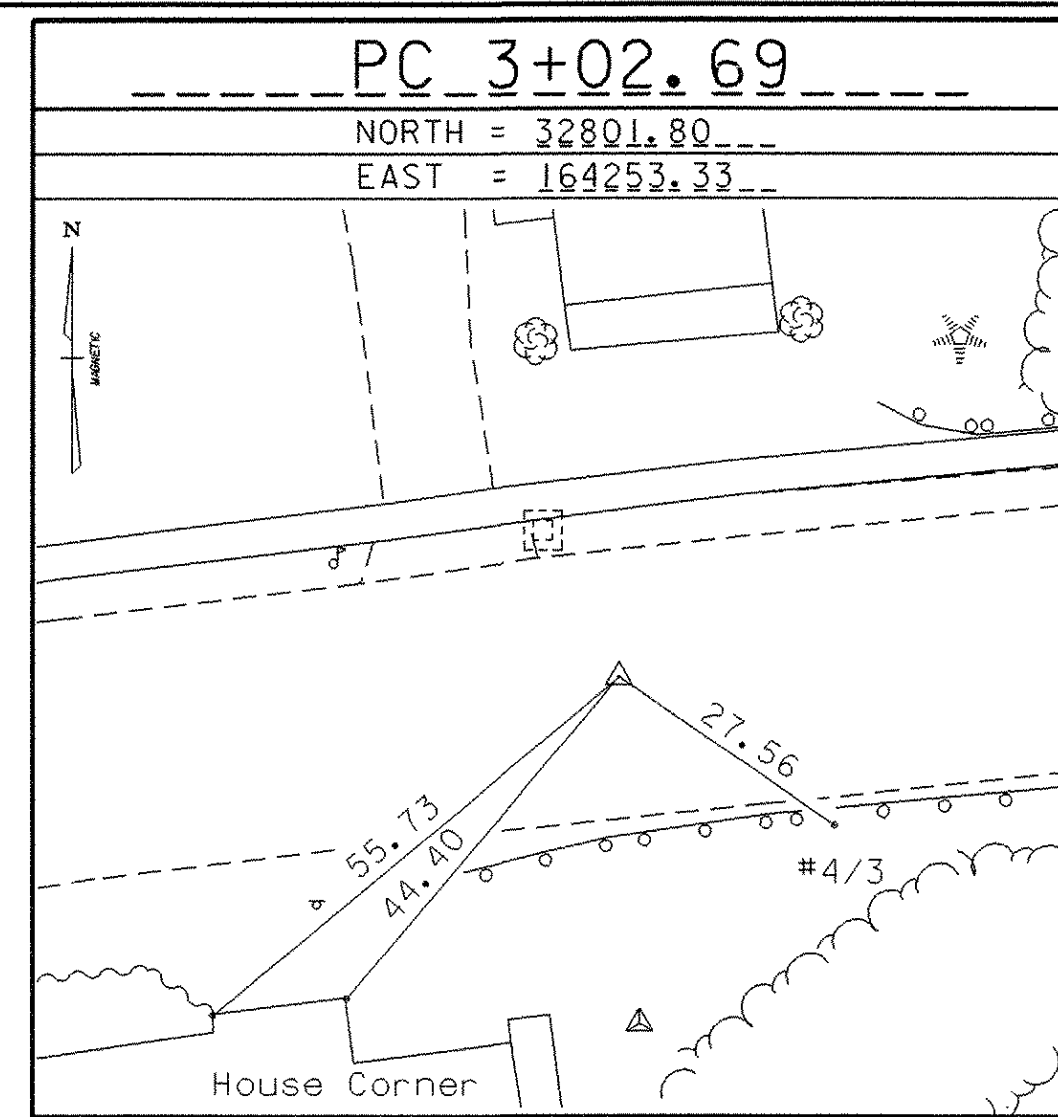
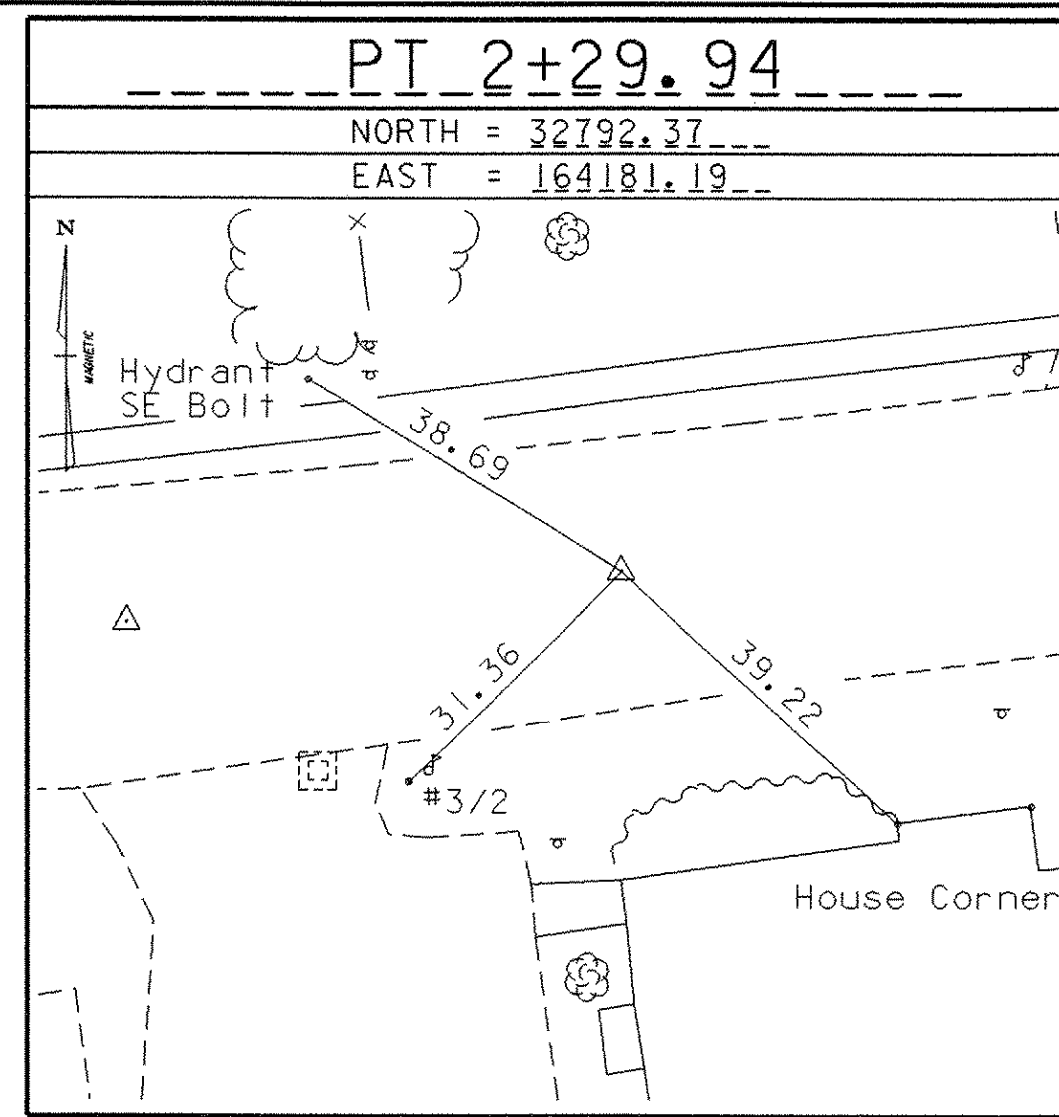
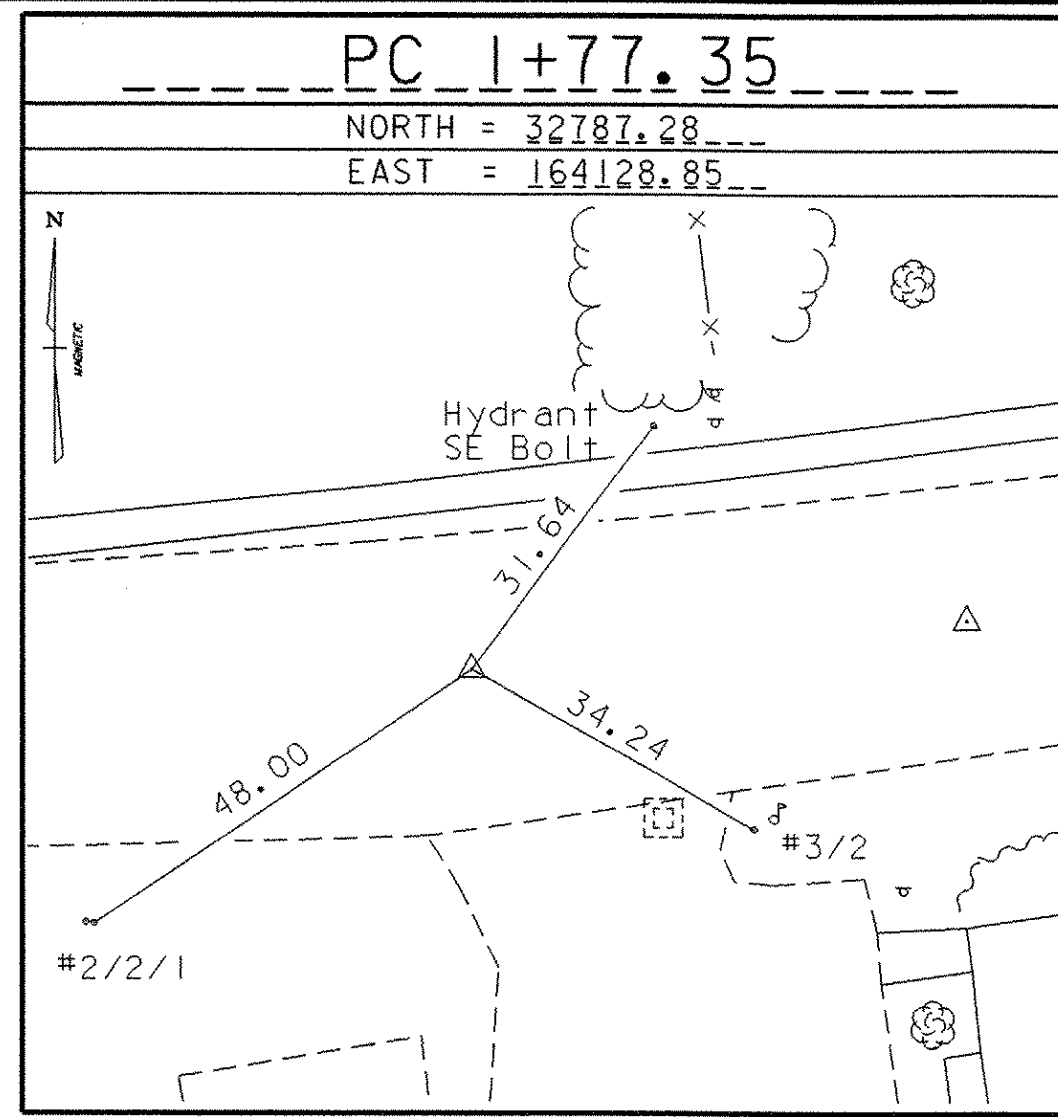
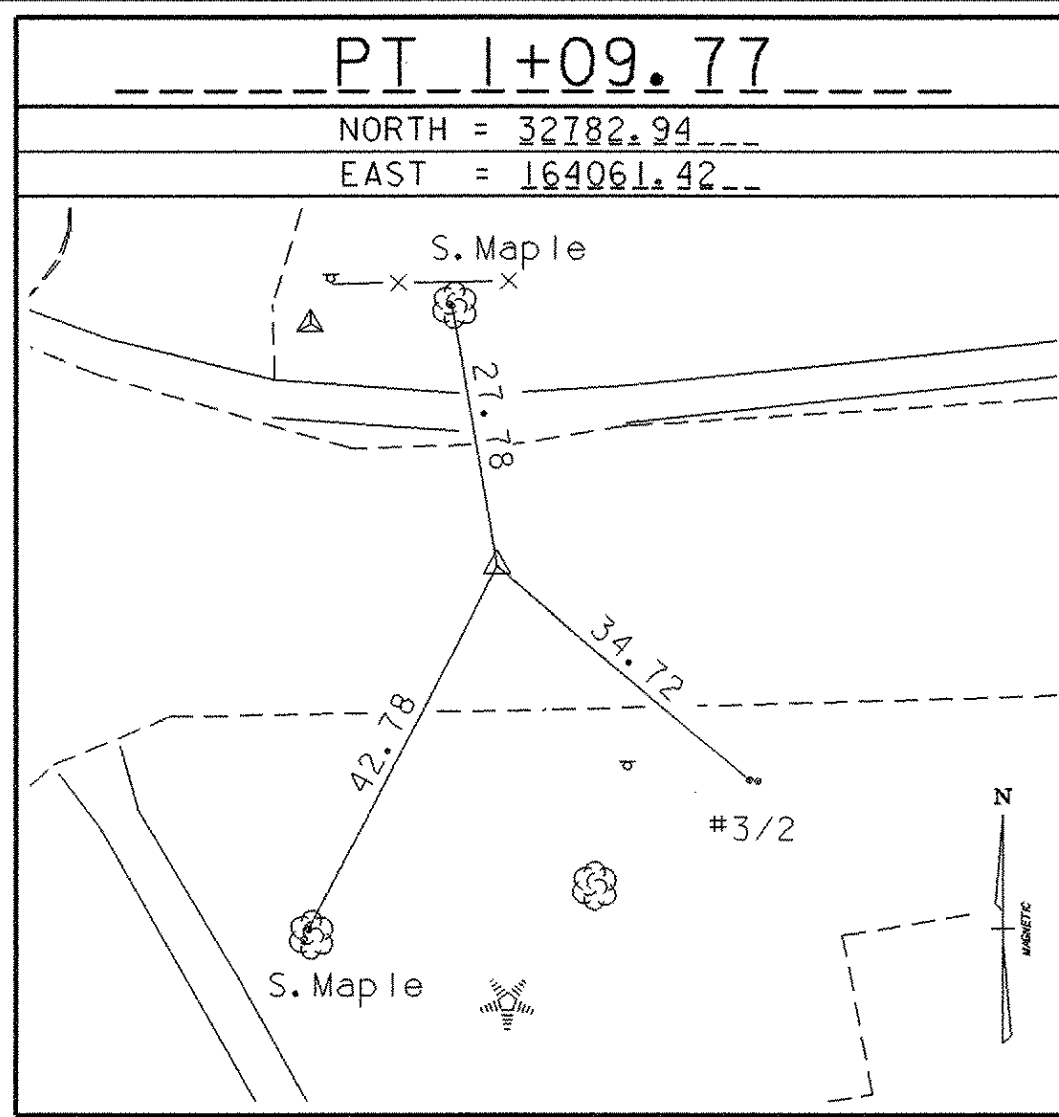
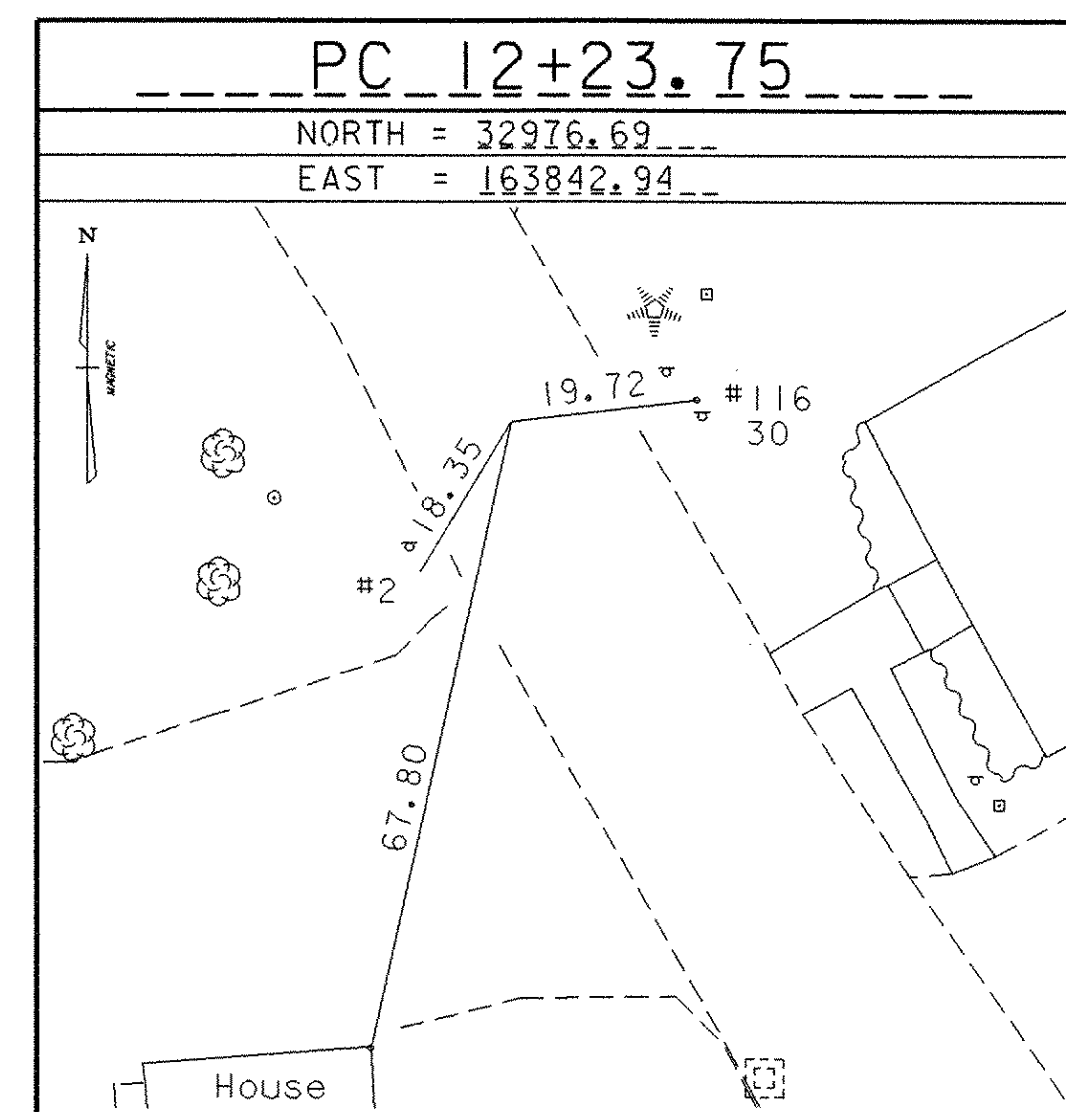
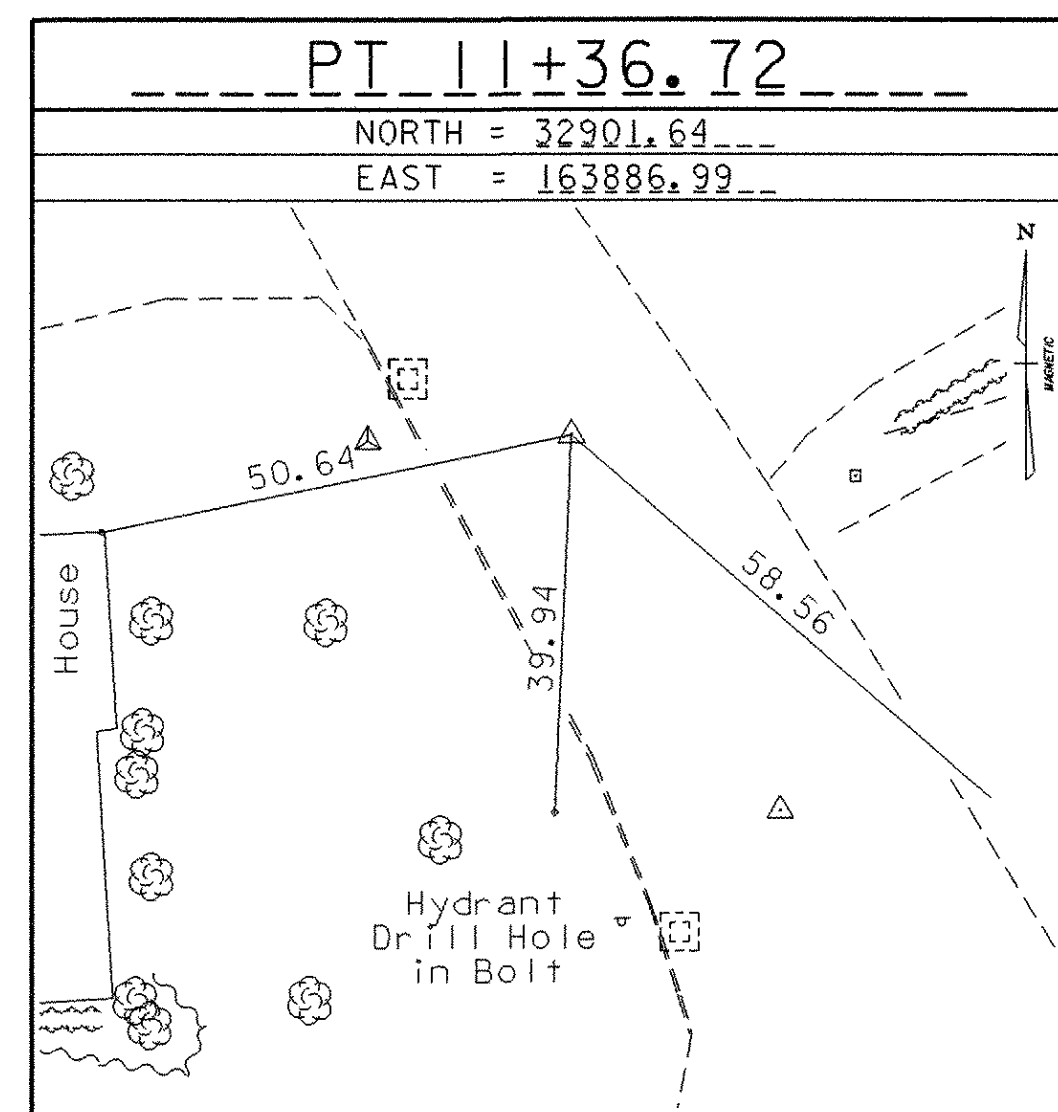
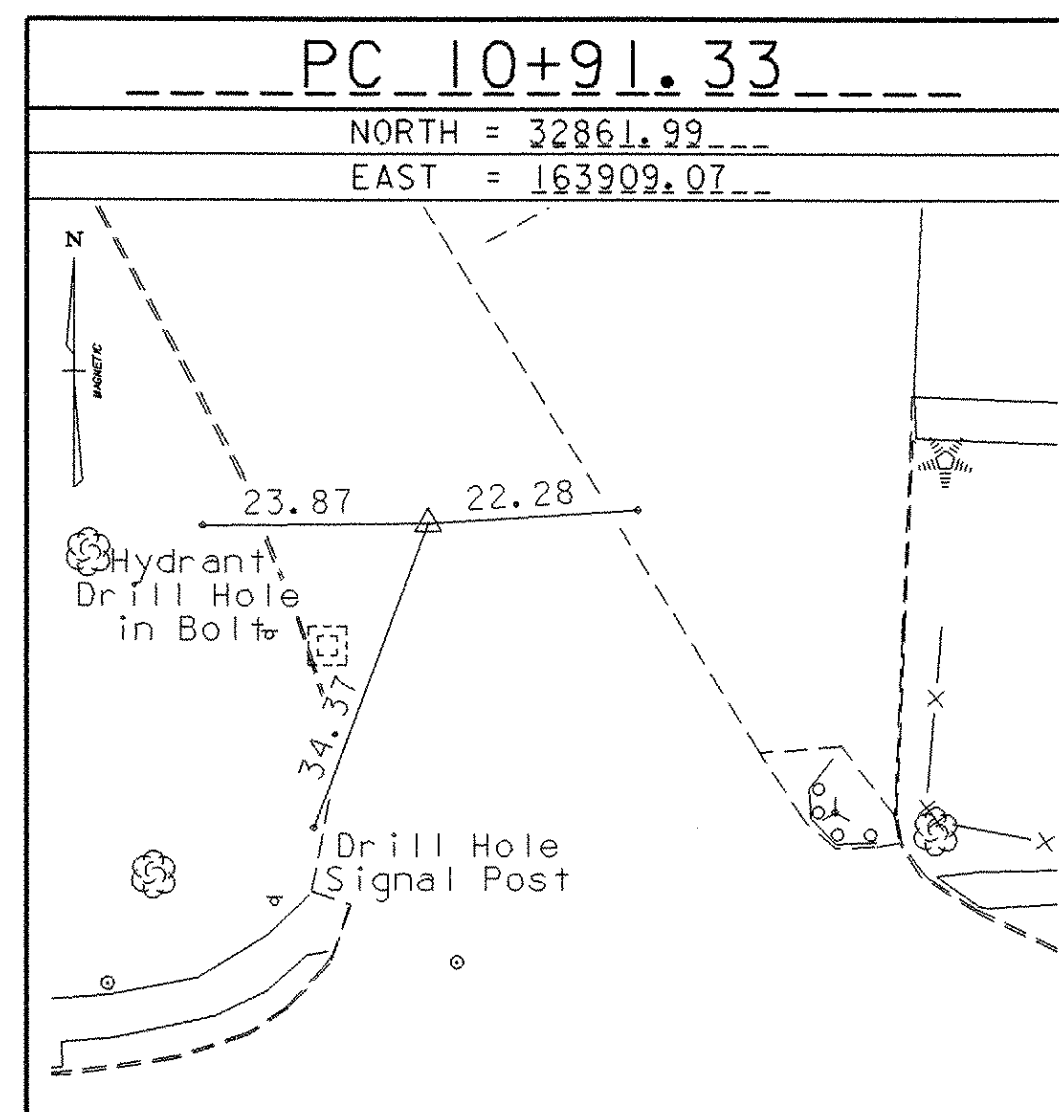







ALIGNMENT TIES

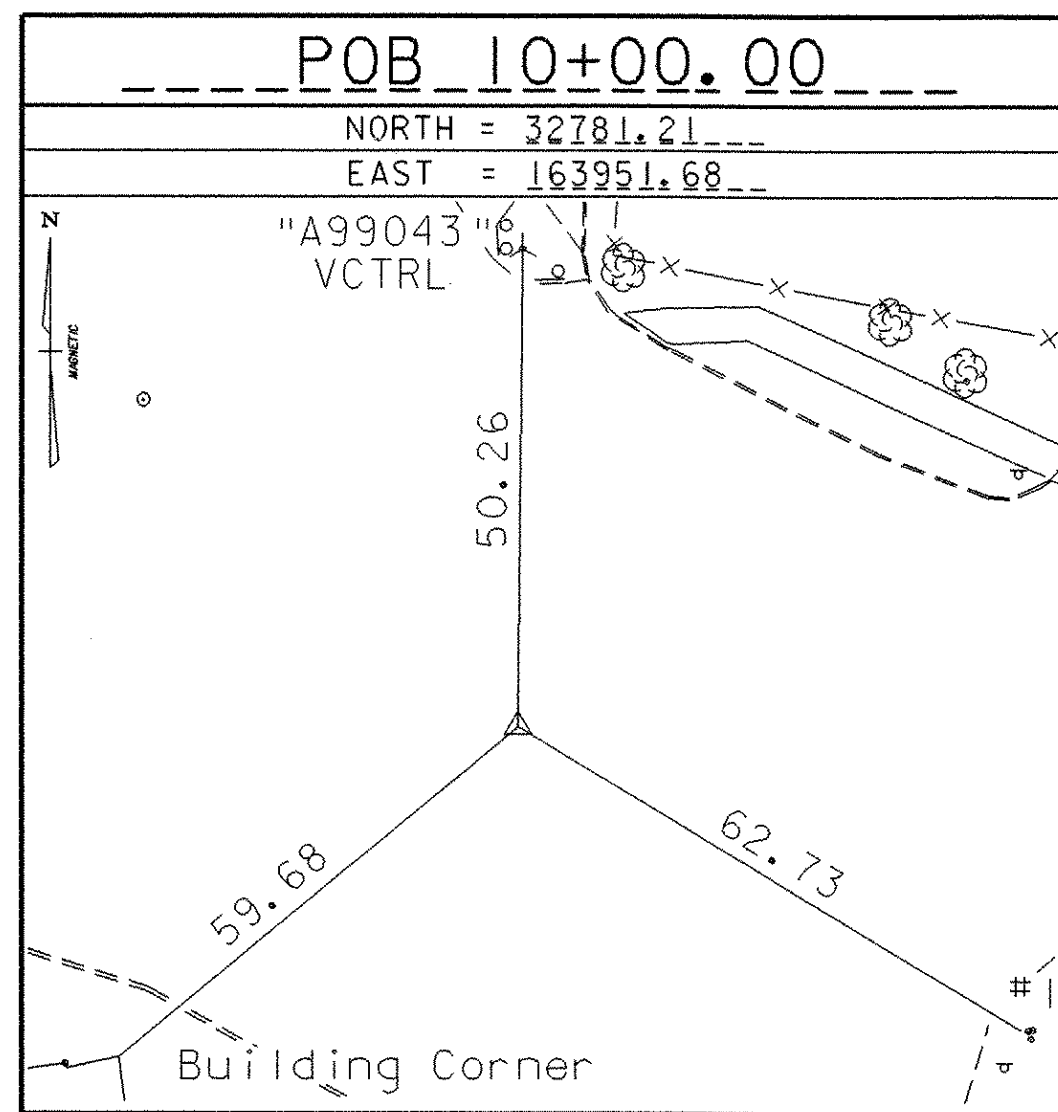

ALIGNMENT TIES

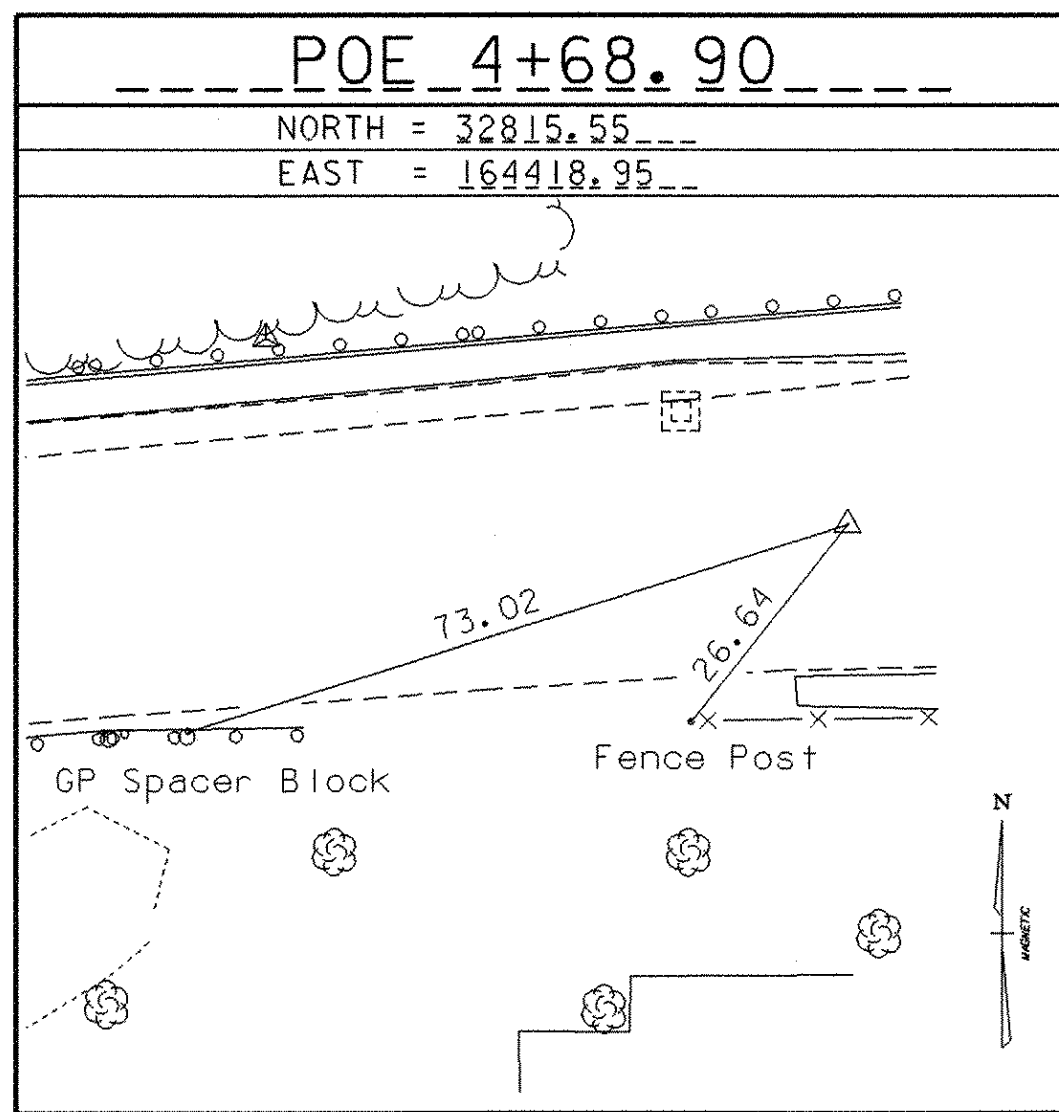

ALIGNMENT TIES

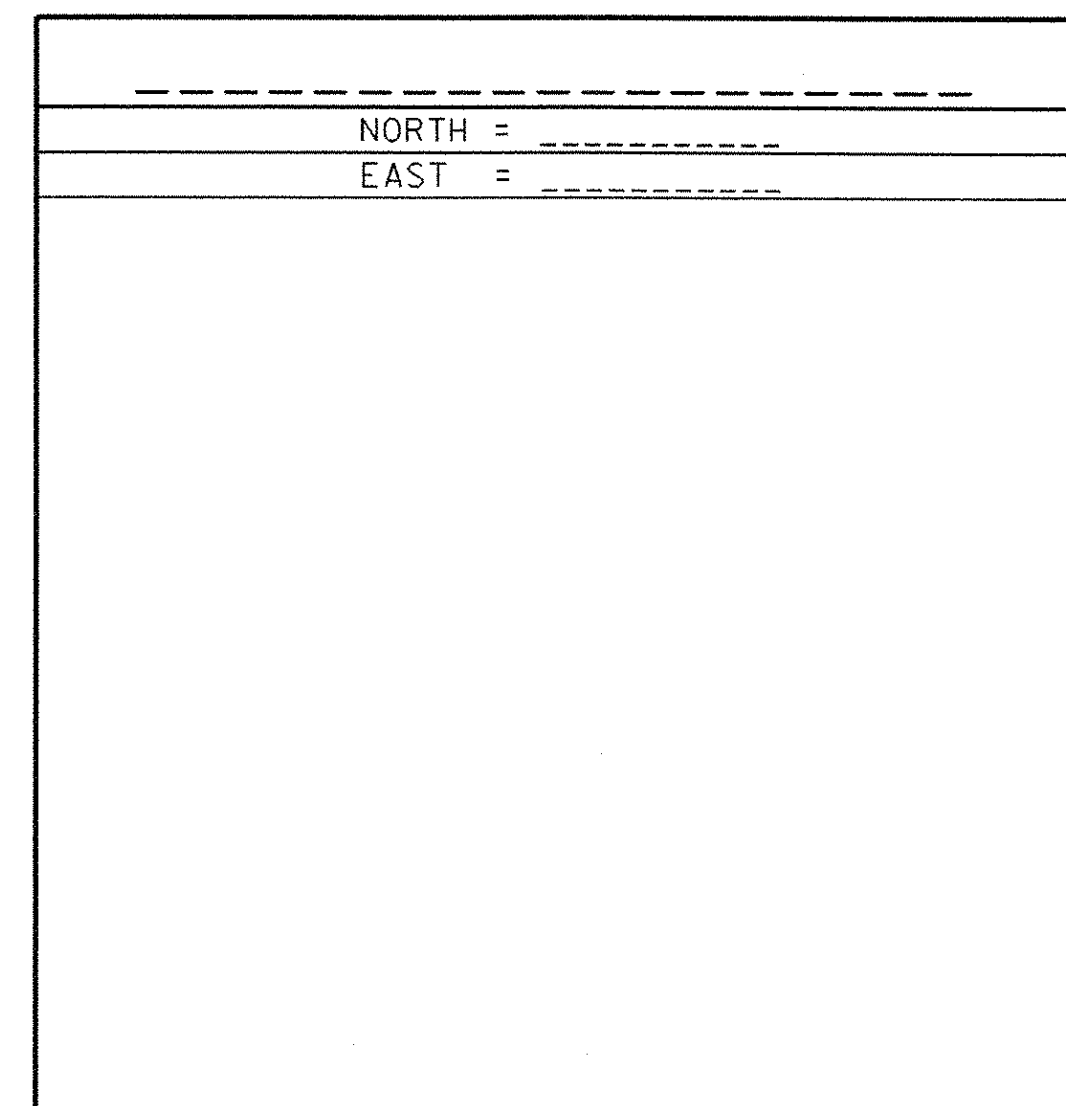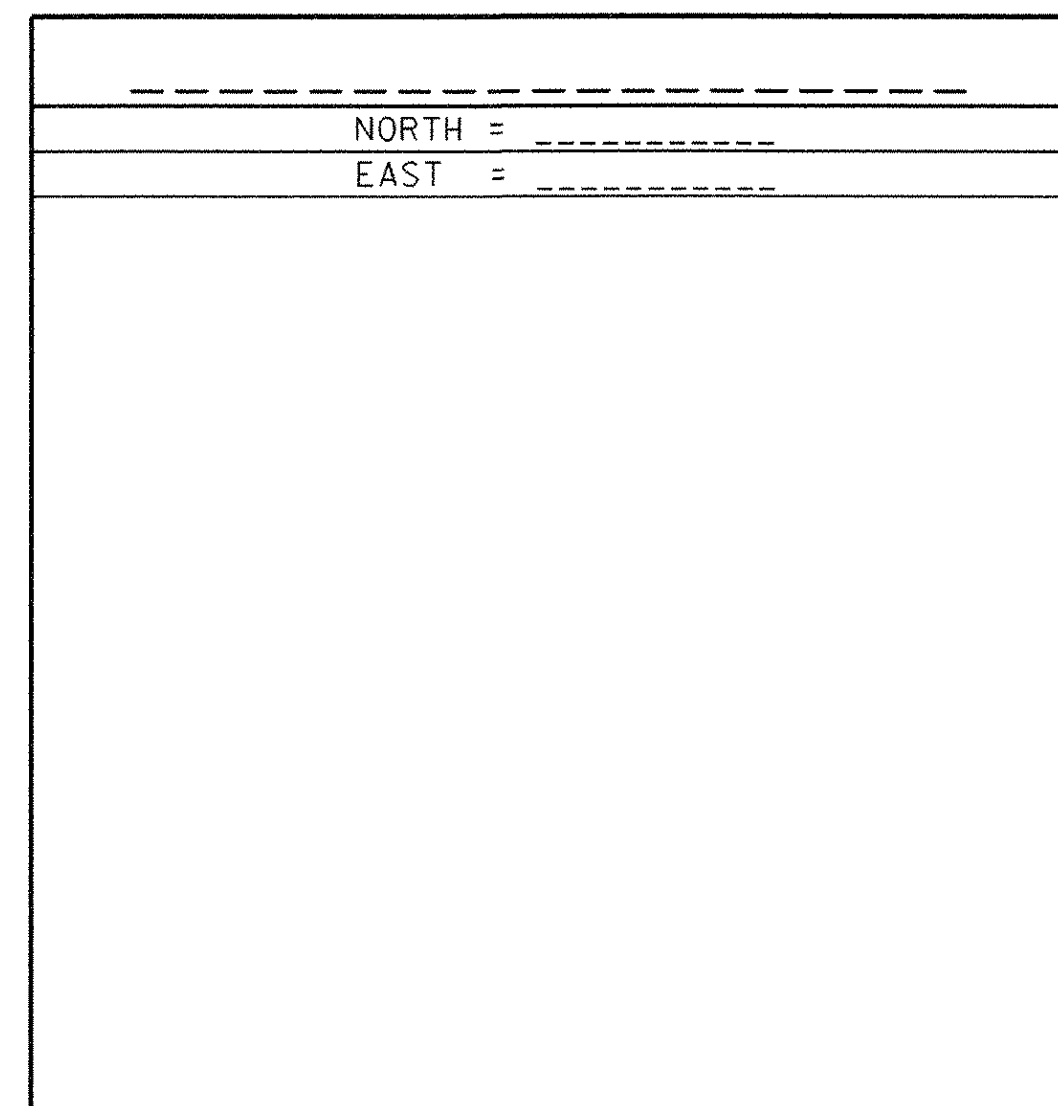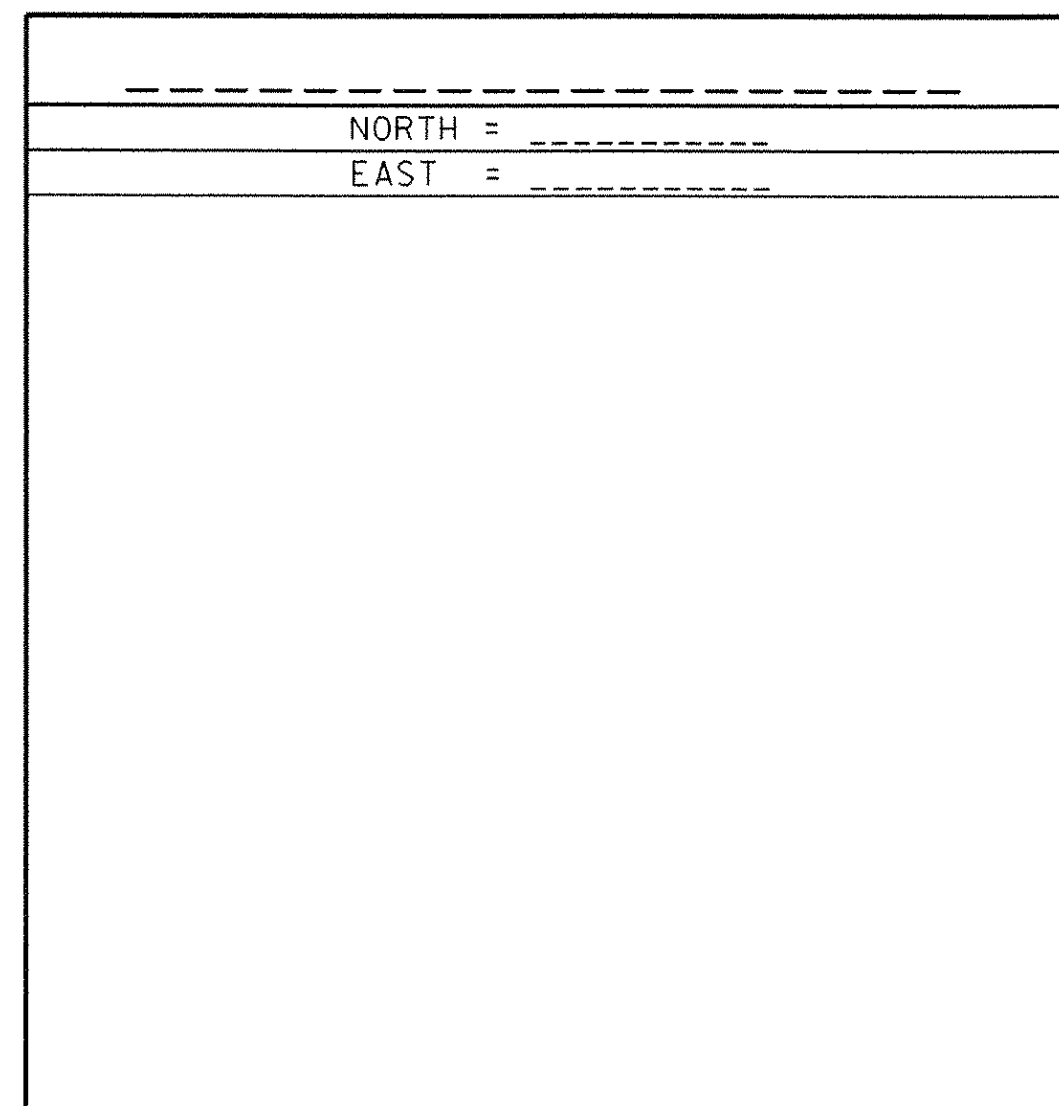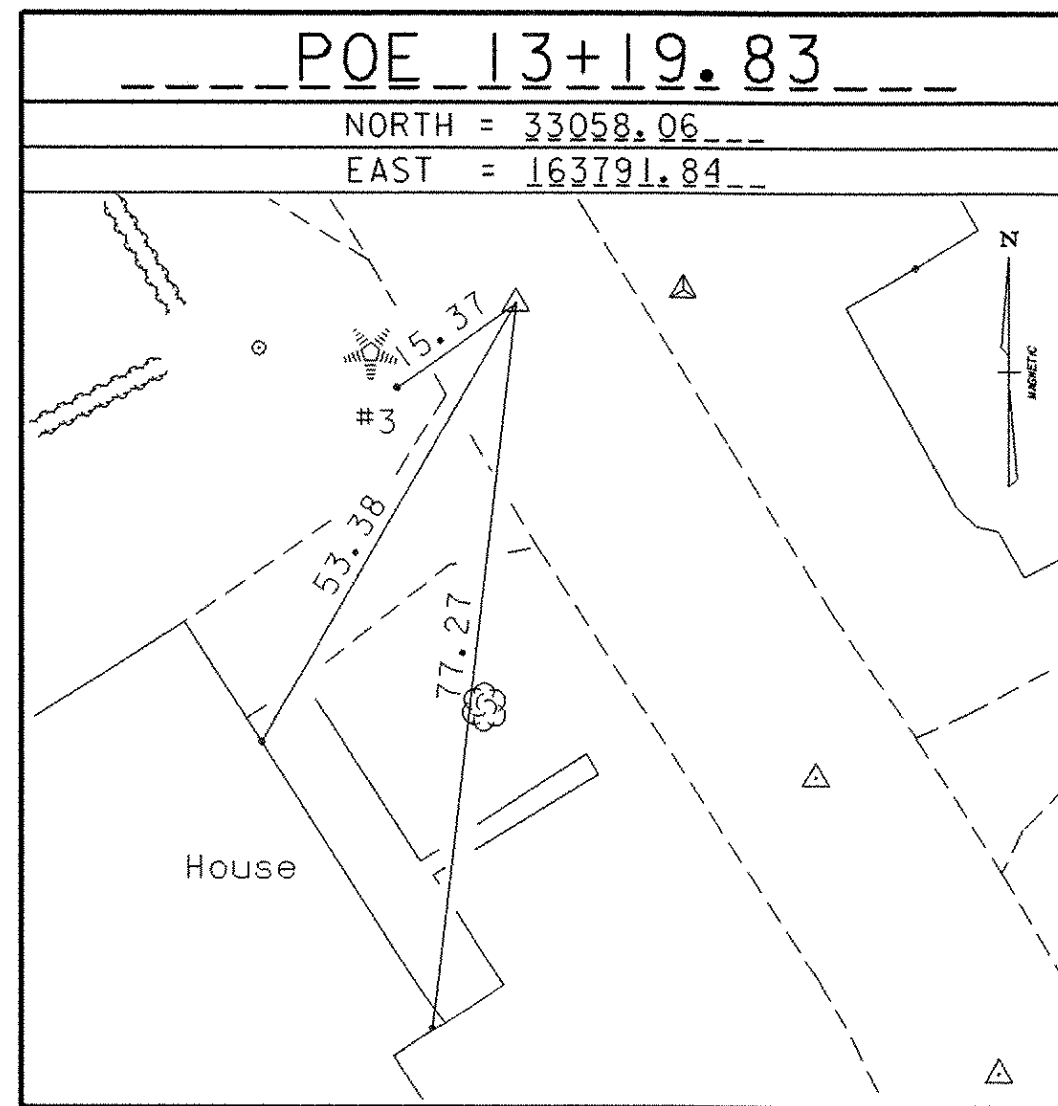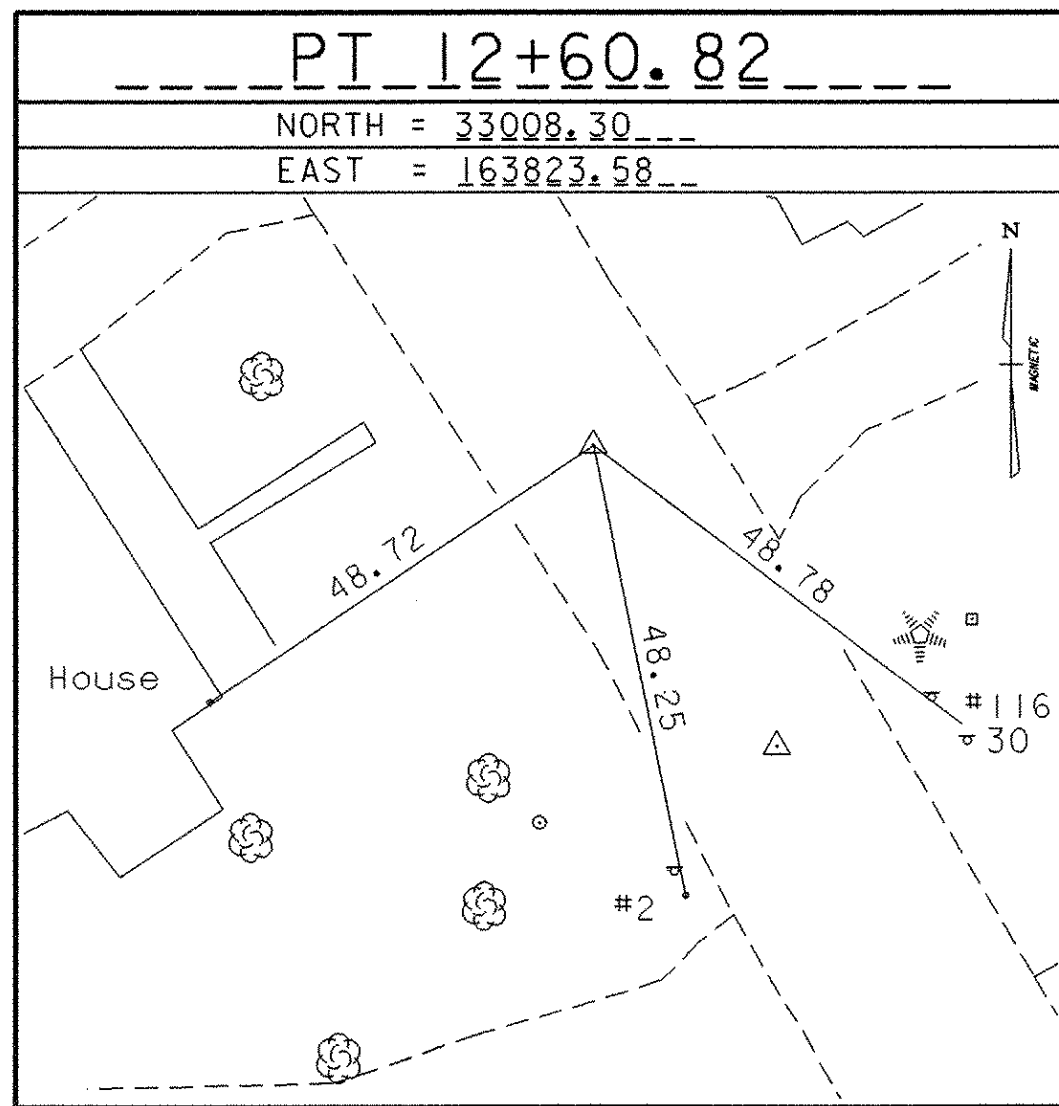

DATUM	
VERTICAL	ASSUMED
HORIZONTAL	ASSUMED
ADJUSTMENT	NONE

NO GPS CONTROL POINT: CONTROL WAS ASSUMED

PROJECT NAME:	ESSEX
PROJECT NUMBER:	SIPC_SGNL (17)
FILE NAME:	96b182\src\yay\z\96b1821.dgn
PROJECT LEADER:	B. NYQUIST
DESIGNED BY:	R. BULLOCK
	+b182112.1
PLOT DATE:	16-NOV-2006
DRAWN BY:	R. Bullock
CHECKED BY:	R. BULLOCK
SHEET	7 OF 29