

RIGHT - OF - WAY DETAIL SHEET


TABLE OF PROPERTY ACQUISITION

PARCEL NO.	PROPERTY OWNER	SHEET NO.	BEGINNING STATION	ENDING STATION	TAKE AREA±	REMAINDER AREA±	RIGHT			RECORDING DATA				REMARKS	
							TYPE	(T)/(P)	AREA ±	TITLE	DATE	TOWN / CITY	BOOK		PAGE
1A	COTA, HENRY C. & SHIRLEY W.	5	VT15 281+19.80 LT. VT15 281+07 LT. VT15 281+26 LT. TH710 10+73 LT.	VT15 281+49.64 LT. VT15 281+24 LT.	450 SF		SLOPE LANDSCAPE SLOPE	(T) (T) (T)	48 SF 39 SF			ESSEX			TRIM 10" MAPLE AS NEEDED
1B		5	VT15 278+97.32 LT.	VT15 281+87.84 LT.	0.23A		ALL R.T. & I.								VT. RTE. 15 & TH710 HWY. EASE.; 9890 SF±
2A	RUSSELL, JOHN A. & LYNN A.	5	TH710 10+75.00 RT. TH710 10+60 RT. VT128 0+91 LT. VT128 0+65 LT. VT128 0+77 LT. TH710 10+71 RT. VT 128 0+91 LT.	VT128 1+00.00 LT. TH710 10+71 RT. VT128 1+50 LT.	1280 SF		INSTALL SLOPE INSTALL DRIVE SLOPE INSTALL	(T) (T) (T) (T) (T) (T)	107 SF 193 SF 690 SF			ESSEX			CONCRETE CURB CONCRETE CURB 24' WIDE MM 0001 CONCRETE CURB
2B		5	TH710 10+75.00 RT.	VT128 2+05.95 RT.	0.15A		ALL R.T. & I.								VT. RTE. 128 & TH710 HWY. EASE.; 6430 SF±
3A	KATHERINE S. REYNOLDS, TRUSTEE OF THE KATHERINE S. REYNOLDS FAMILY TRUST AND THE RAYMOND H. REYNOLDS FAMILY TRUST	5	VT15 281+19.80 RT. VT15 281+23 RT.	VT15 281+61.65 RT. VT15 281+62 RT.	110 SF		SLOPE	(T)	90 SF			ESSEX			PAVED
3B		5	VT15 279+13.02 LT.	VT15 281+58.87 RT.	0.17A		ALL R.T. & I.								VT. RTE. 15 HWY. EASE.; 7500 SF±
4A	TOWN OF ESSEX	5	VT15 281+58.87 RT. VT15 281+61.65 RT. VT15 282+54 RT. VT15 283+16 RT.	VT15 283+86.21 RT. VT15 283.23 6 RT. VT15 283+51 RT.	950 SF		SLOPE INSTALL & MAINTAIN DRIVE	(T) (P) (T)	0.10A	QCD	04/10/06	ESSEX	683	461-462	SLOPE AND PAVE; 4,260 SF± PIPES AND DRAIN INLET 26" WIDE MM 0534
4B		5	VT15 281+49.80 LT.	VT15 283+86.21 LT.	0.36A		ALL R.T. & I.								VT. RTE. 15 & 128 HWY. EASE.; 15,680 SF±
4C		5	TH710 10+75.00 LT.	TH710 10+28.26 RT.	1650 SF		ALL R.T. & I.								TH710 HWY. EASE.
5	GREEN MOUNTAIN POWER CORPORATION														UTILITY
6	VERMONT GAS SYSTEMS, INC.														UTILITY
7	ADELPHIA CABLE COMMUNICATIONS														UTILITY
8	VERIZON NEW ENGLAND, INC.														UTILITY
	MAINTENANCE AGREEMENT ZONE	5	TH 710 10+18 CL	TH710 10+75 CL											LENGTH =57'

TABLE OF REVISIONS

REVISION NO.	SHEET NO.	DESCRIPTION	DATE
1	4	PARCEL NO. 2 RUSSELL. ADD ENDING STATION OF TH 710 10+71 RT.; 107 S.F.± FOR INSTALL (T). PER C.O. 9452 MADE BY: JB APPROVED BY: RD	05/15/06

PLAN LEGEND

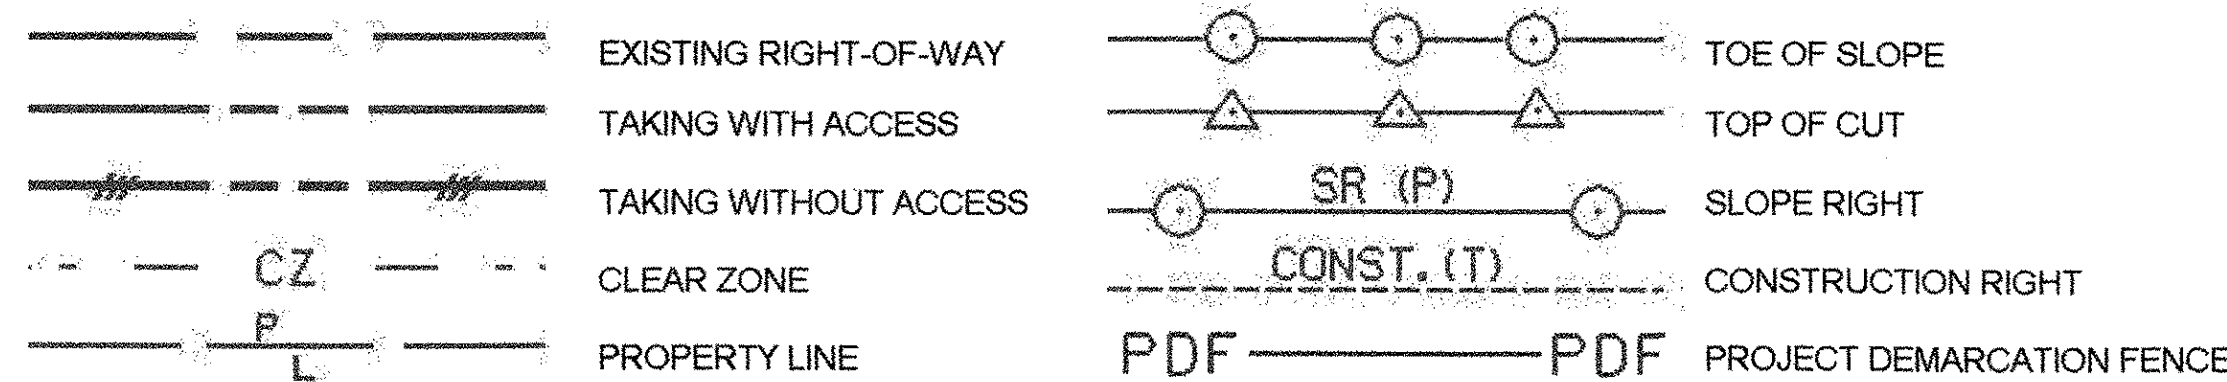

- (P) -PERMANENT
- (T) -TEMPORARY
- DR. -DRAINAGE RIGHT
- DIT. -DITCHING RIGHT
- CH. -CHANNEL RIGHT
- DRIVE -DRIVE RIGHT
- CUL. -CULVERT RIGHT
- C&T -CLEARING & TRIMMING RIGHT
- SR -SLOPE RIGHT
- UE -UTILITY EASEMENT

APPROVED: ROGER P. DUMAS DATE: 03-18-05
CHIEF, PLANS & TITLES

PLOT DATE 05/22/06

PROJECT NAME: **ESSEX**
 PROJECT NUMBER: **STPG SGNL(17)**
 FILE NAME: **96b182dot.xls** PLOT DATE:
 PROJECT LEADER: **B. NYQUIST** DRAWN BY: **G. FUNK**
 DESIGNED BY: **B. MCAVOY** CHECKED BY: **E. PIERCE**
 R.O.W. SHEET 4 OF 5 SHEETS SHEET **8** OF **29**