


LUMINAIRE ORIENTATION FROM MAI

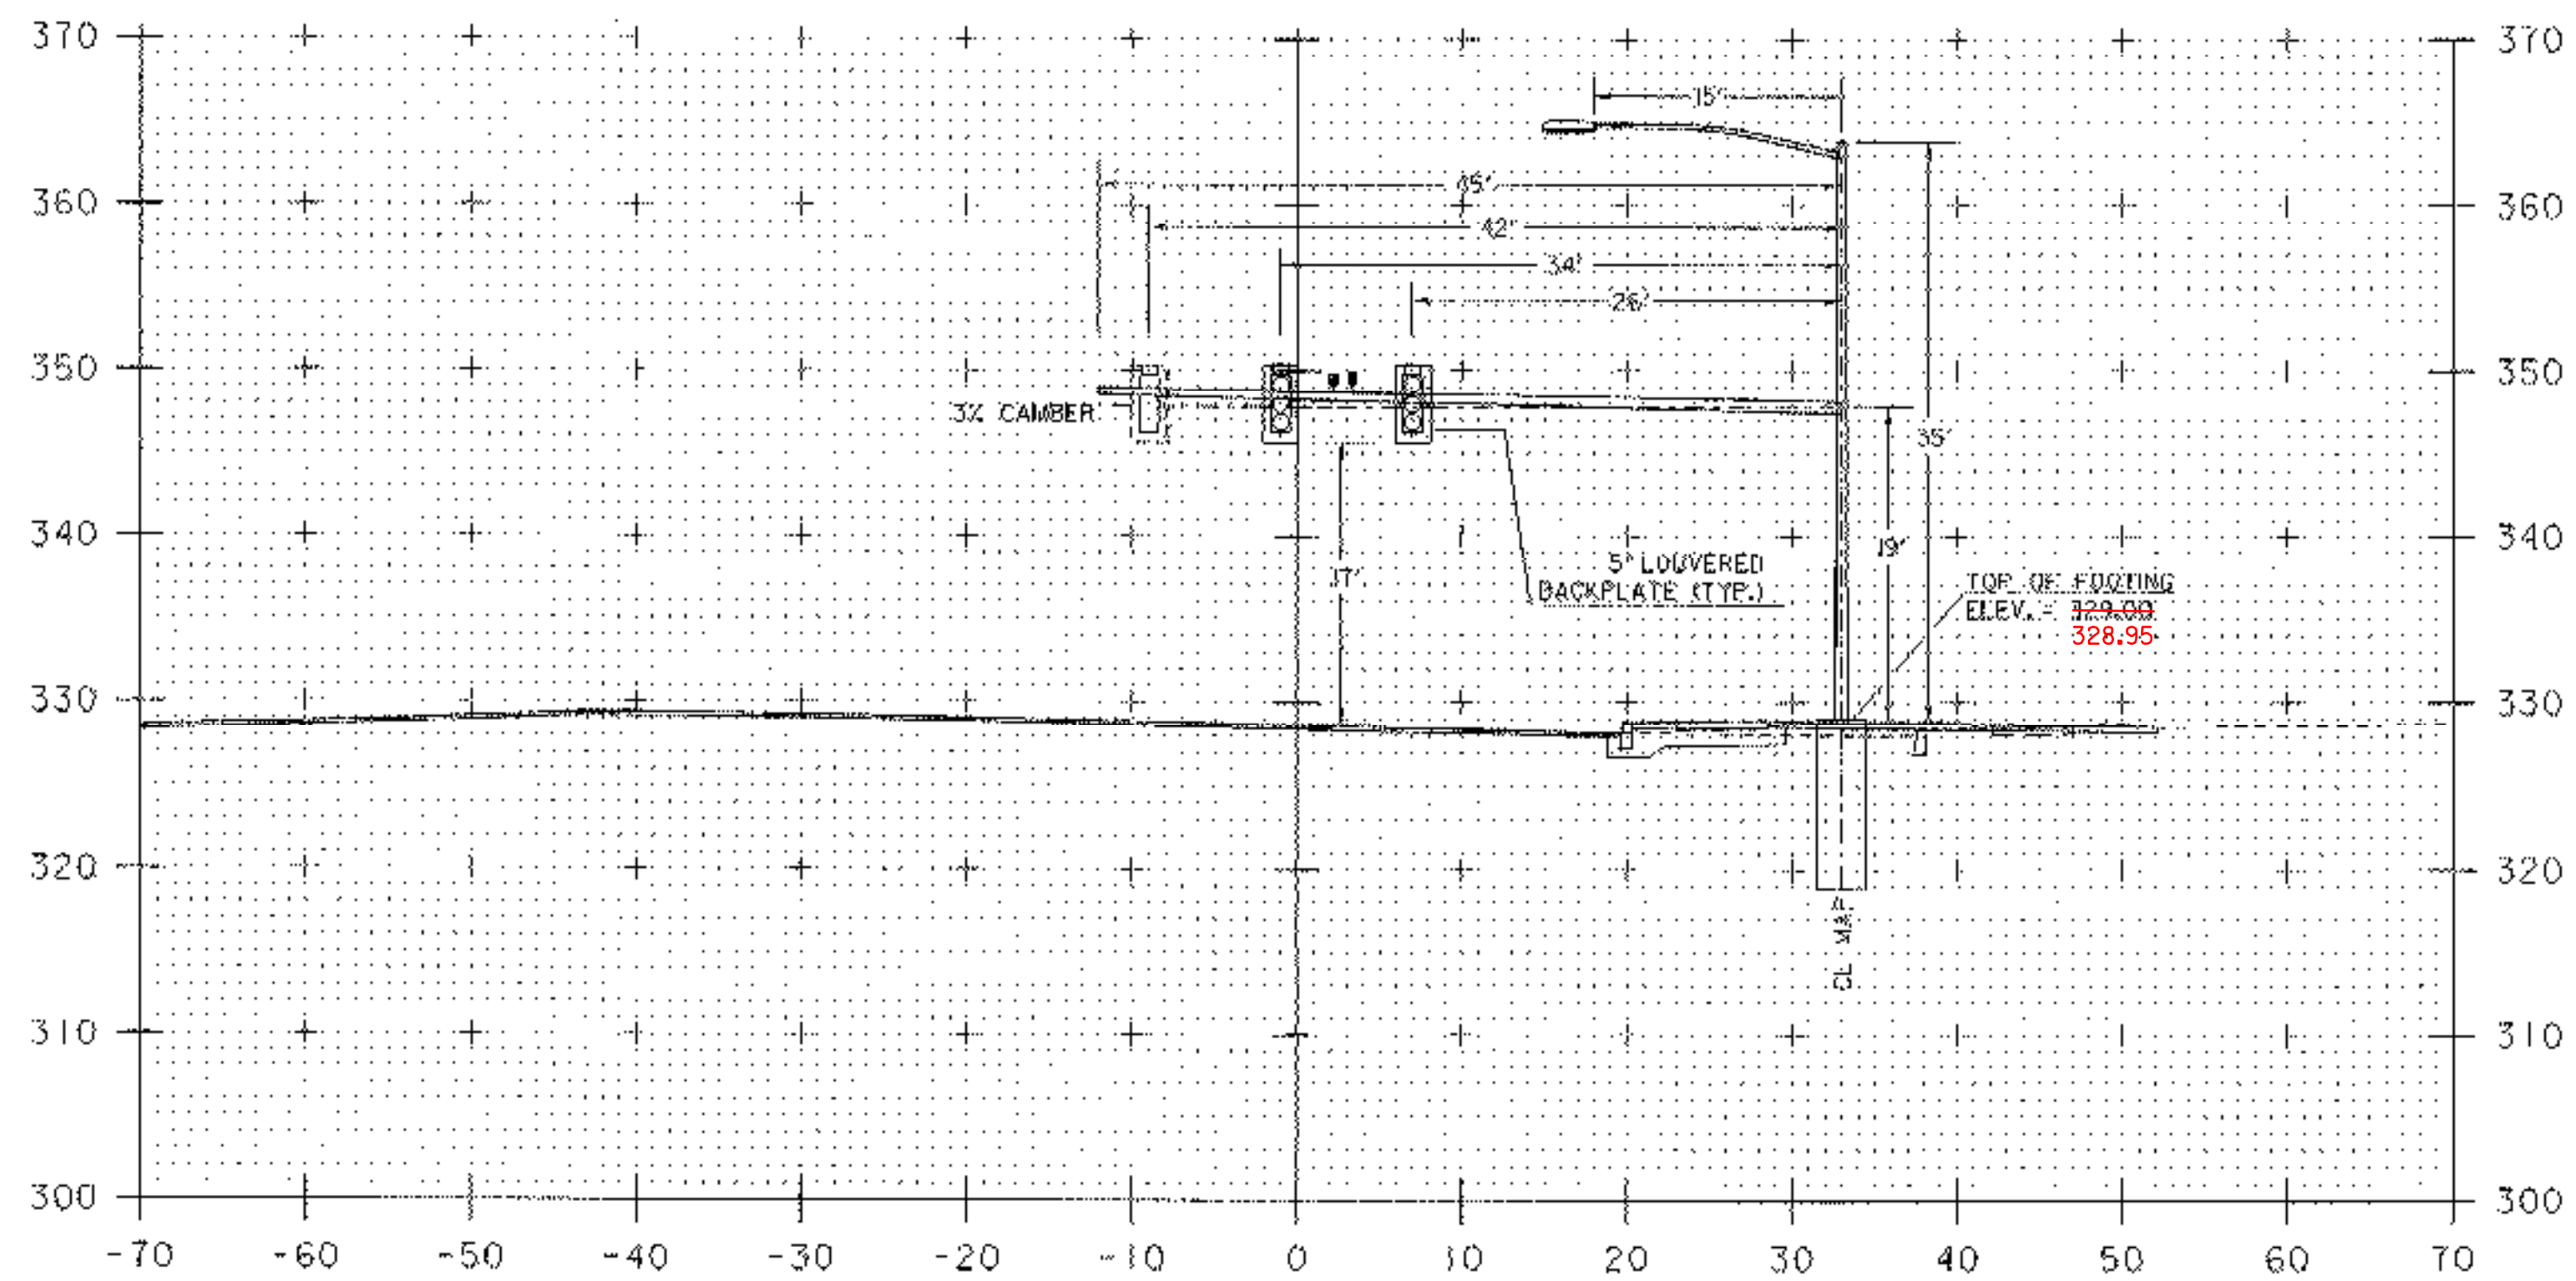

10+21

VT 15
LOOKING NORTH

PROJECT NAME:	ESSEX		
PROJECT NUMBER:	STPG SGNL (17)		
FILE NAME:	96b82/1b82wrk.dgn/1b82mol1	PLOT DATE:	16-NOV-2006
PROJECT LEADER:	B. NYQUIST	DRAWN BY:	B. MCAVOY
DESIGNED BY:	B. MCAVOY	CHECKED BY:	B. NYQUIST
		SHEET	22 OF 29