


LUMINAIRE ORIENTATION  
FROM MA2

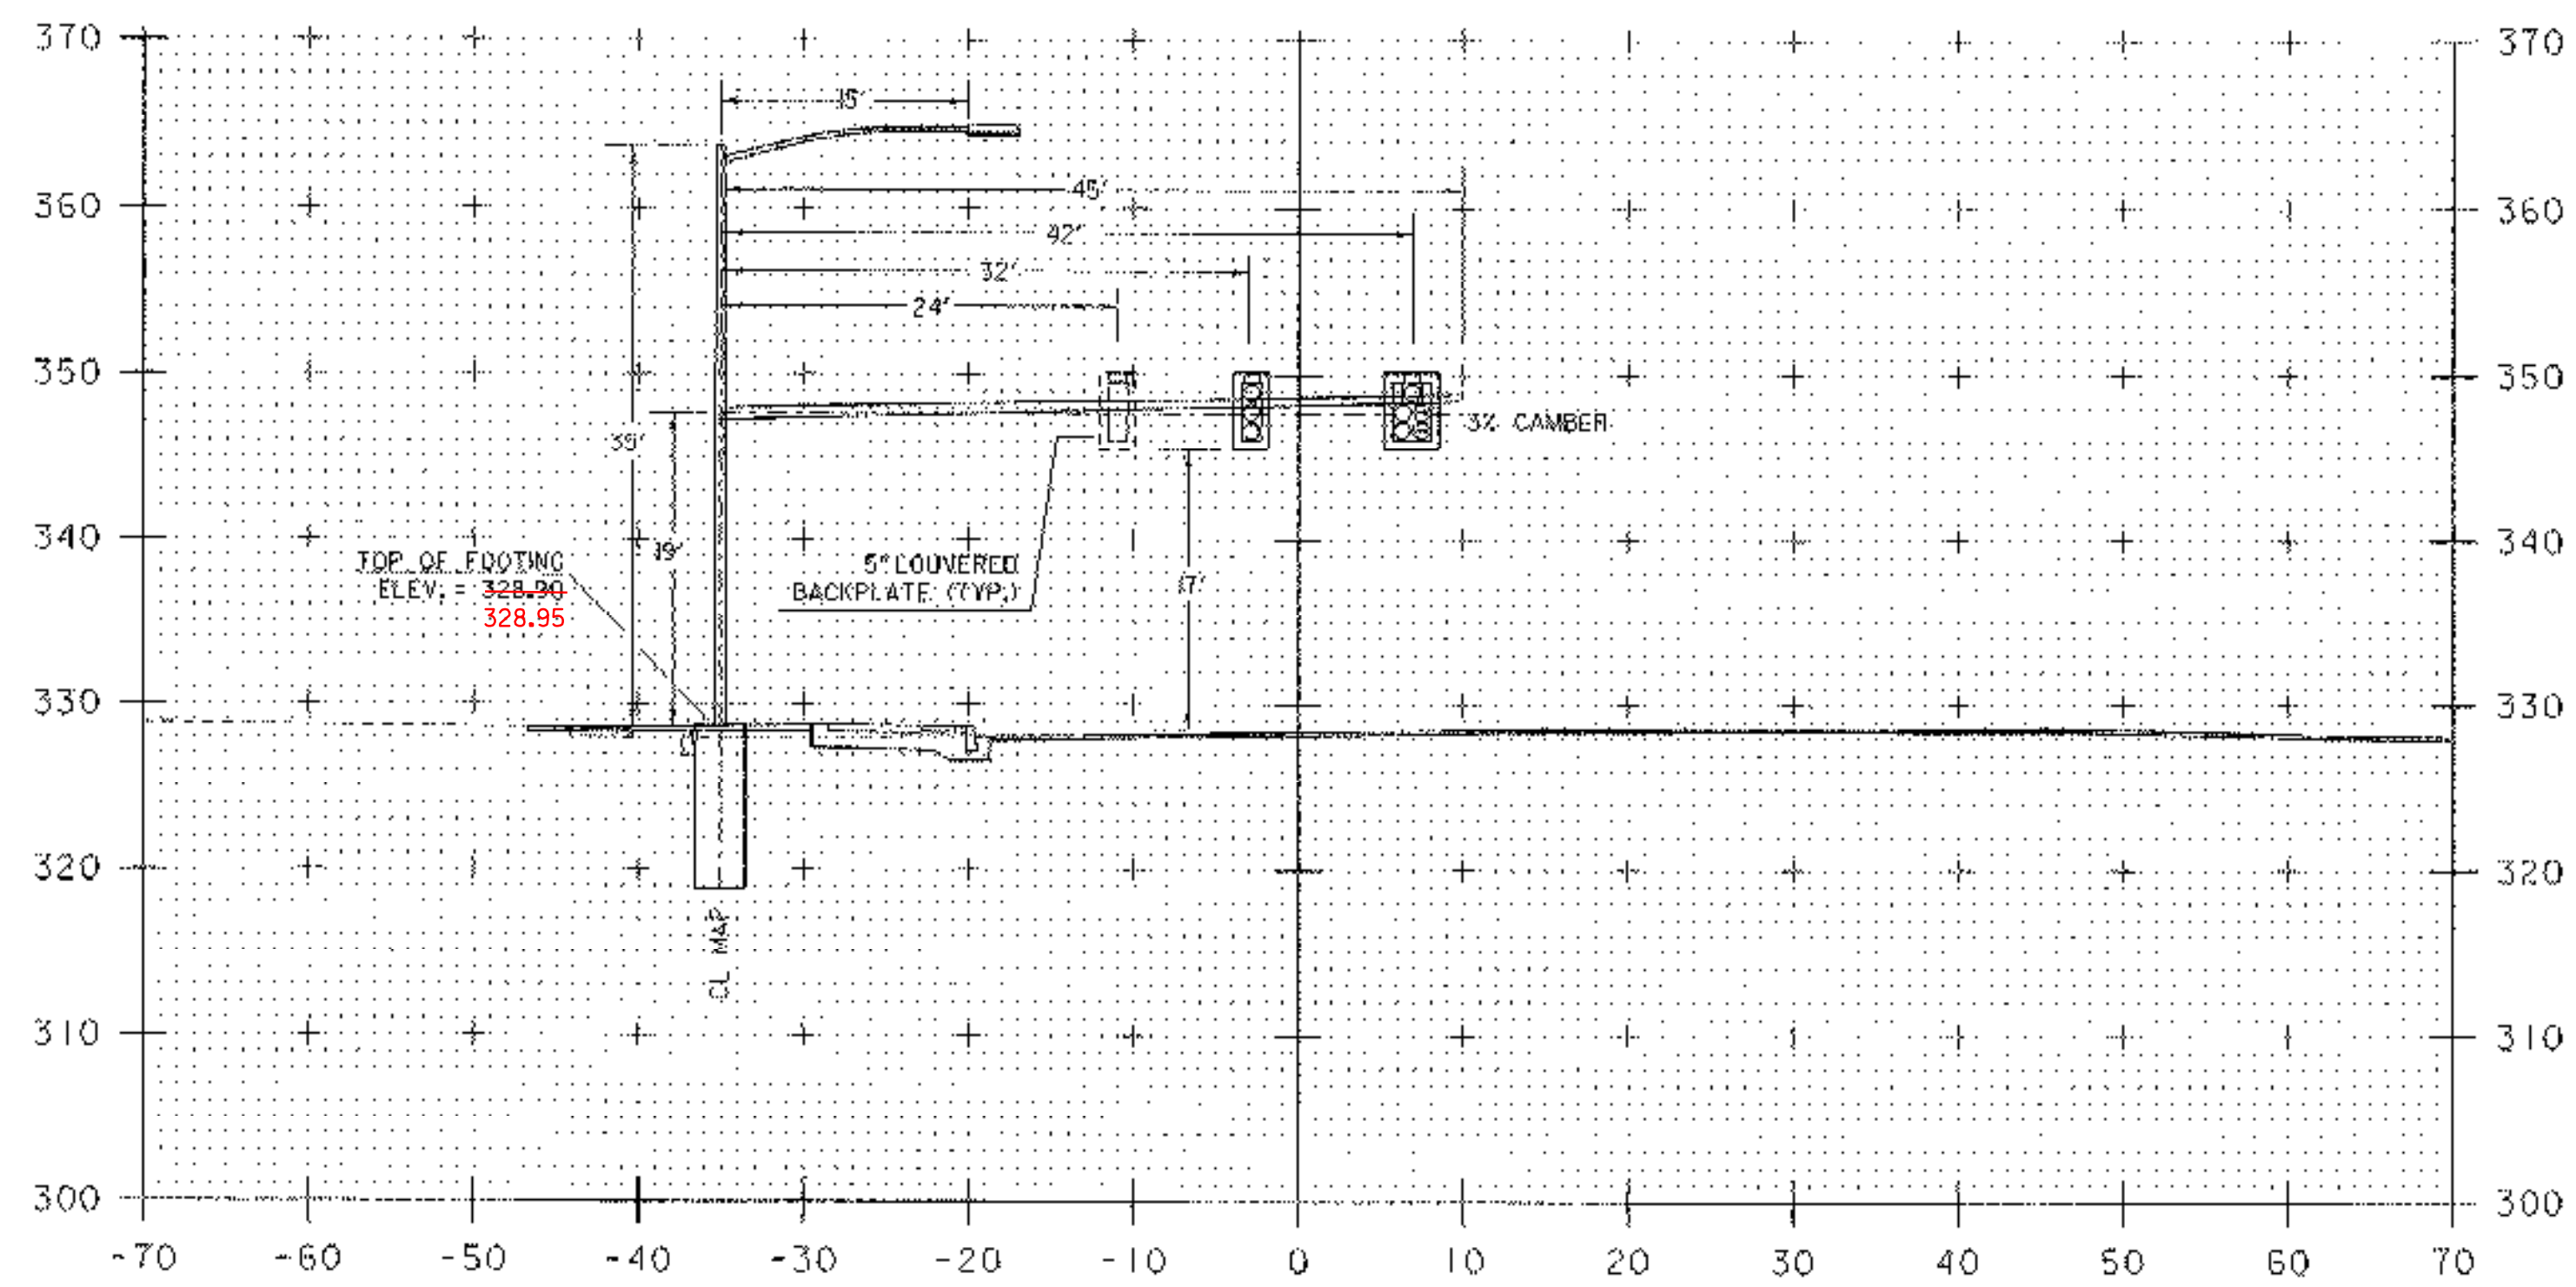

0+22

VT 15  
LOOKING EAST

PROJECT NAME:	ESSEX		
PROJECT NUMBER:	STPG SGNL (17)		
FILE NAME:	96b182/tb182wrk.dgn/tb182ma21	PLOT DATE:	16-NOV-2006
PROJECT LEADER:	B. NYQUIST	DRAWN BY:	B. MCAVOY
DESIGNED BY:	B. MCAVOY	CHECKED BY:	B. NYQUIST
		SHEET	23 OF 29