




280+00

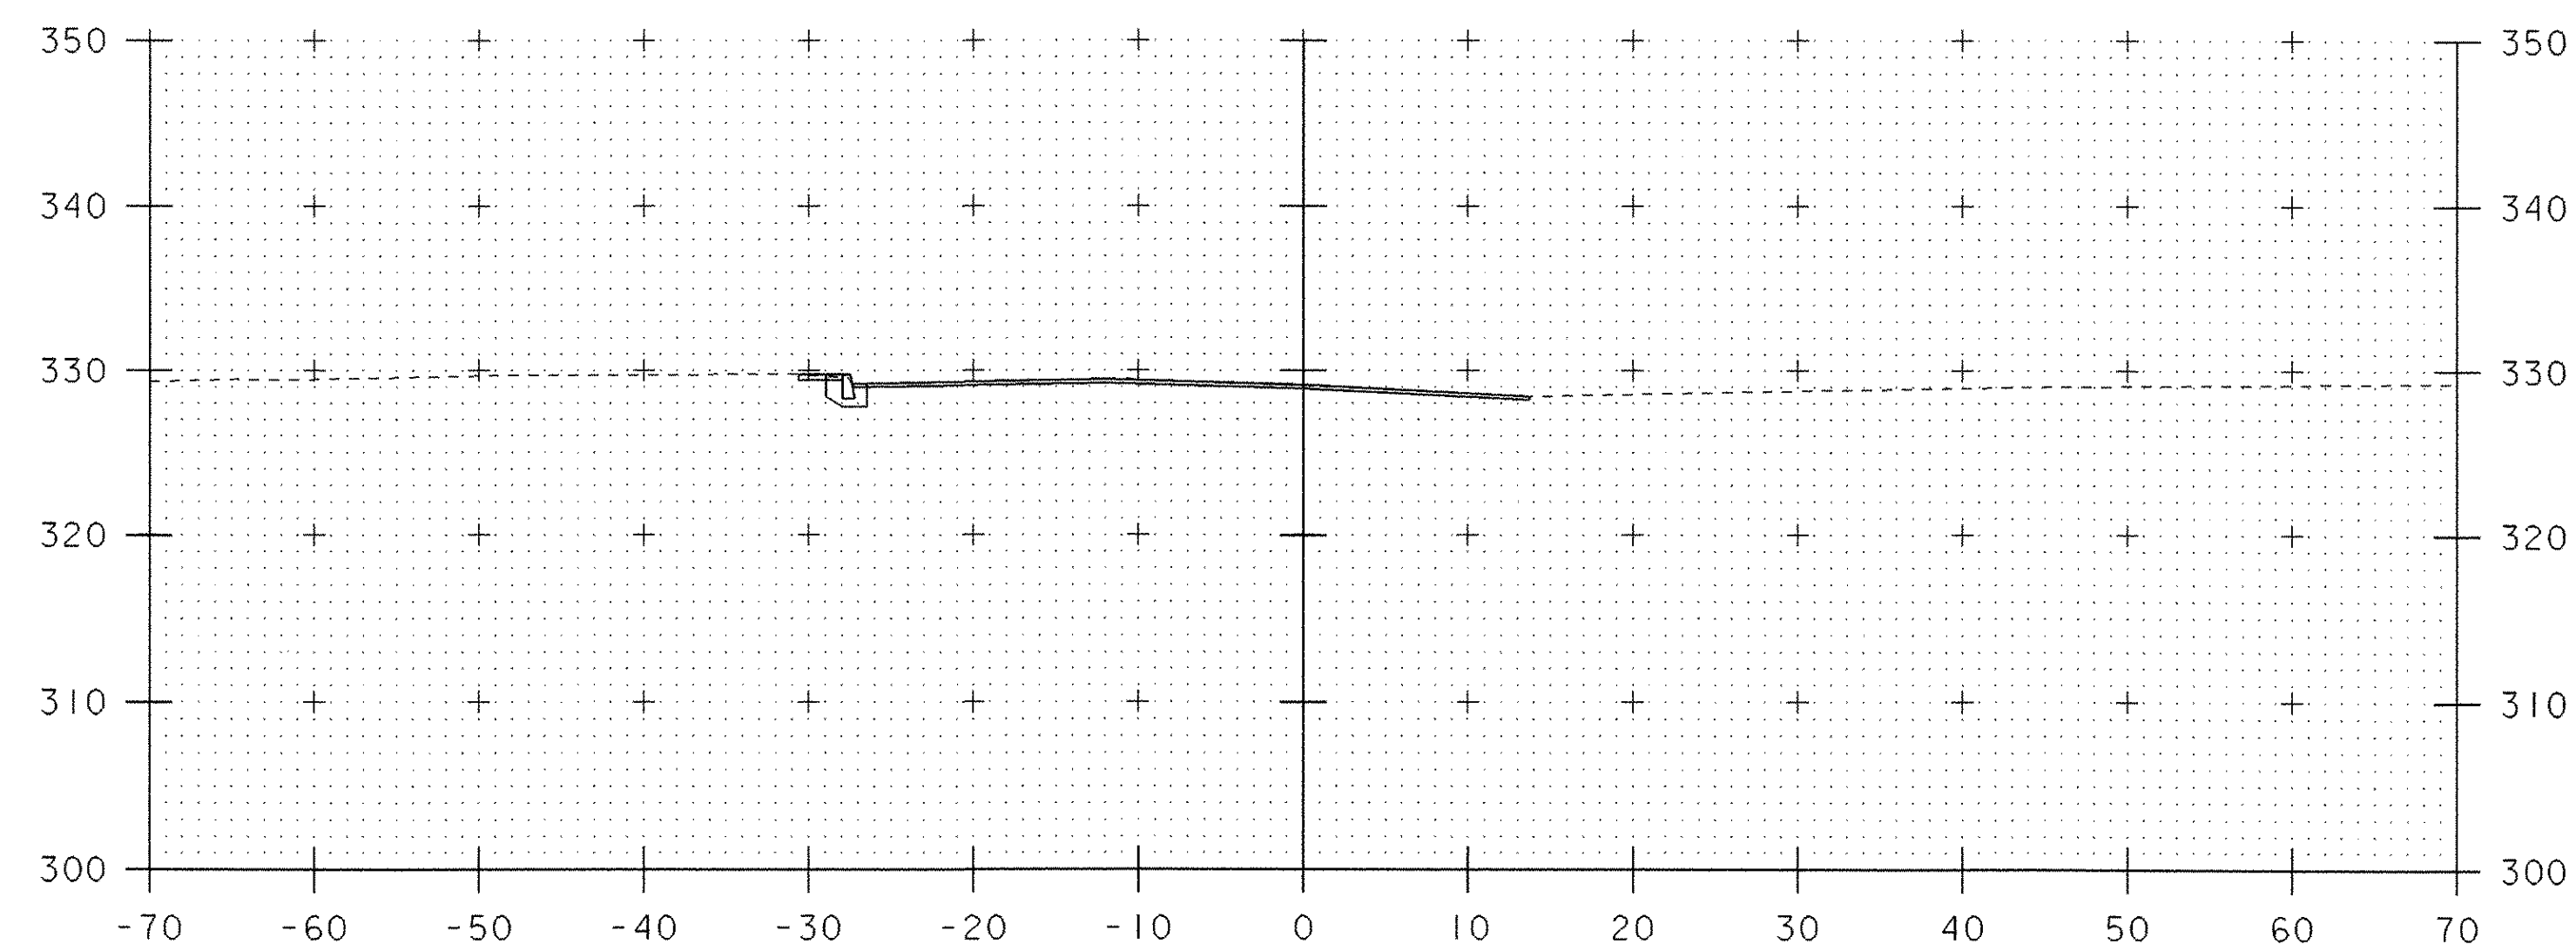


281+00

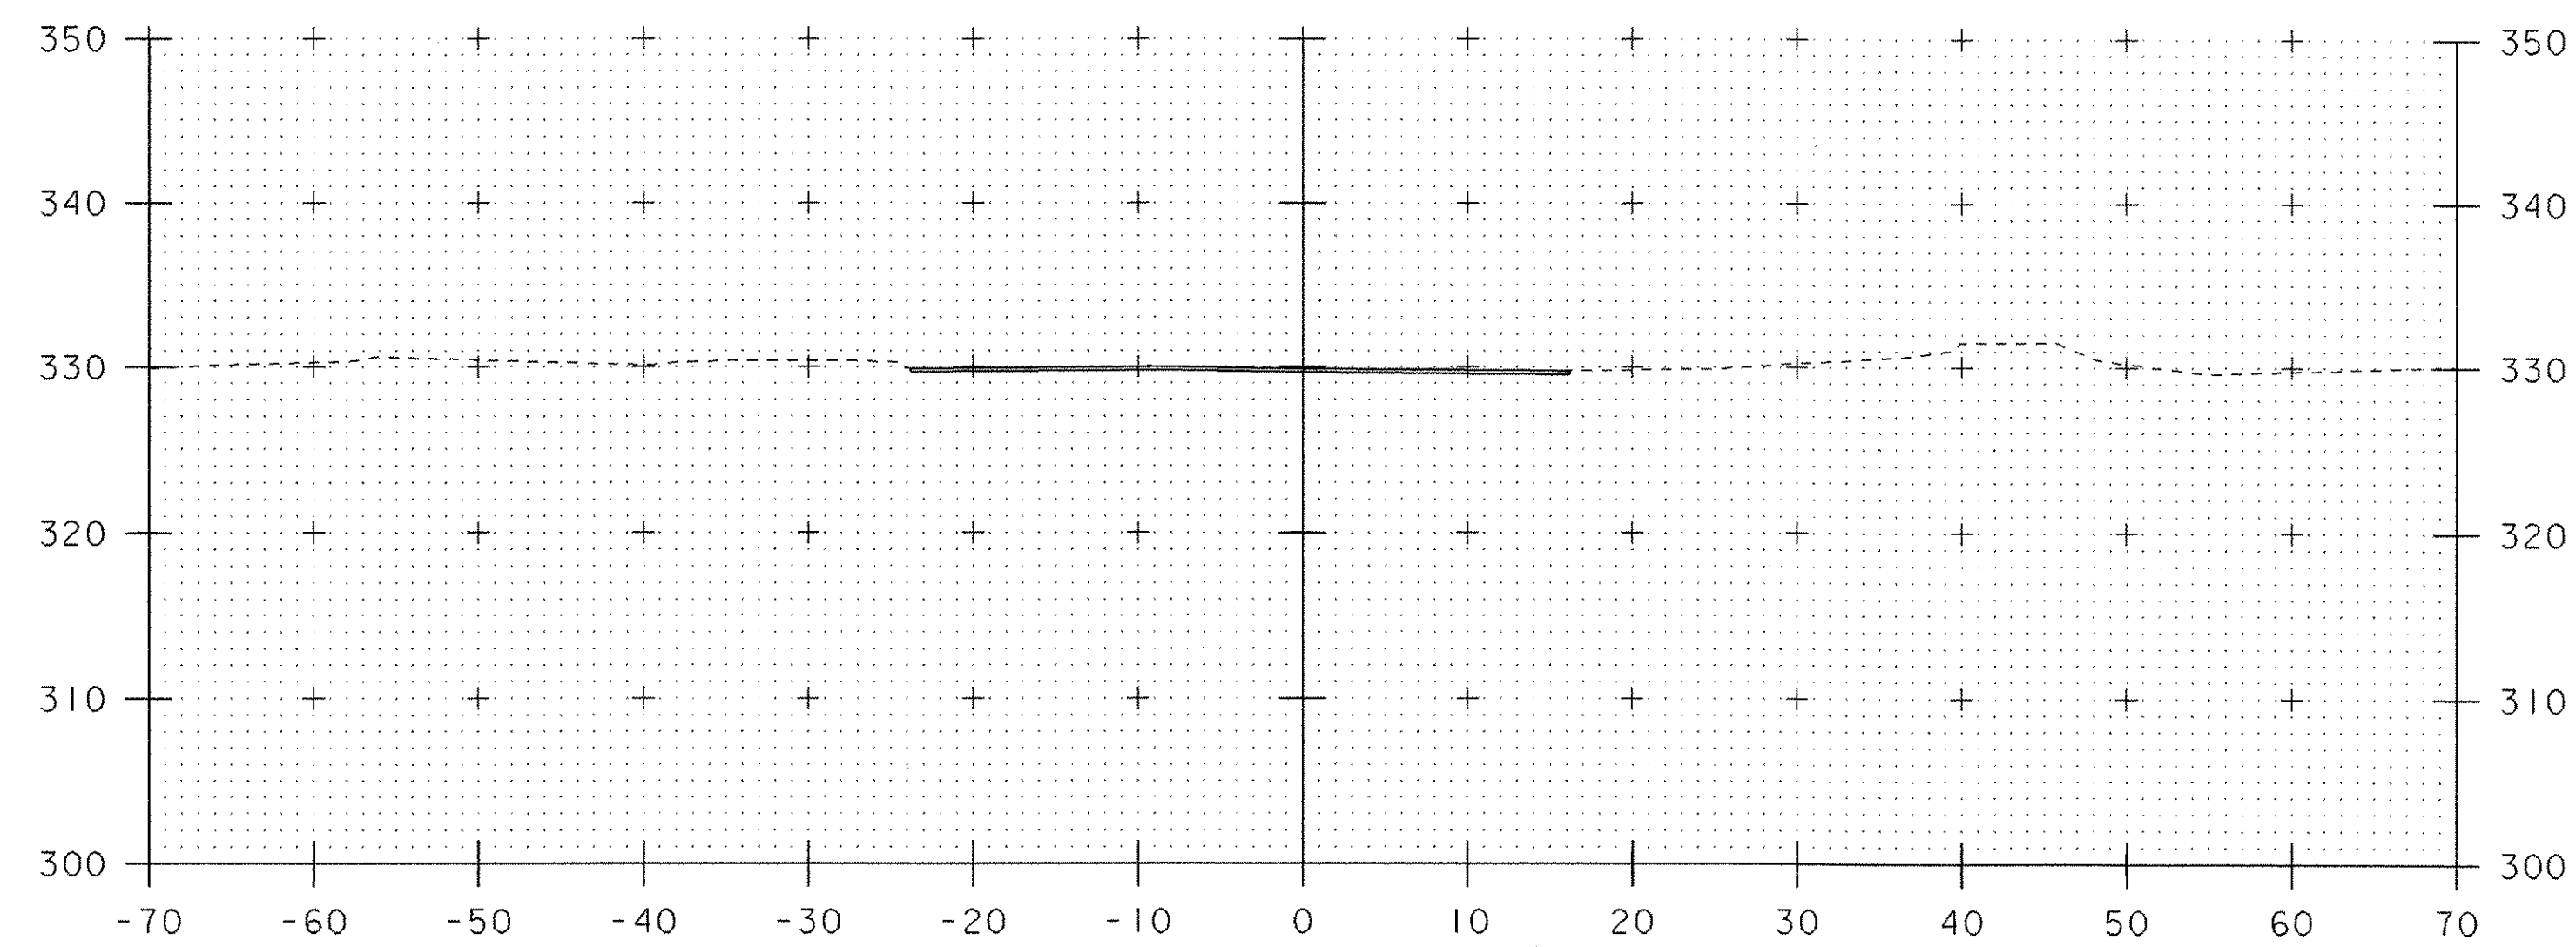

279+50

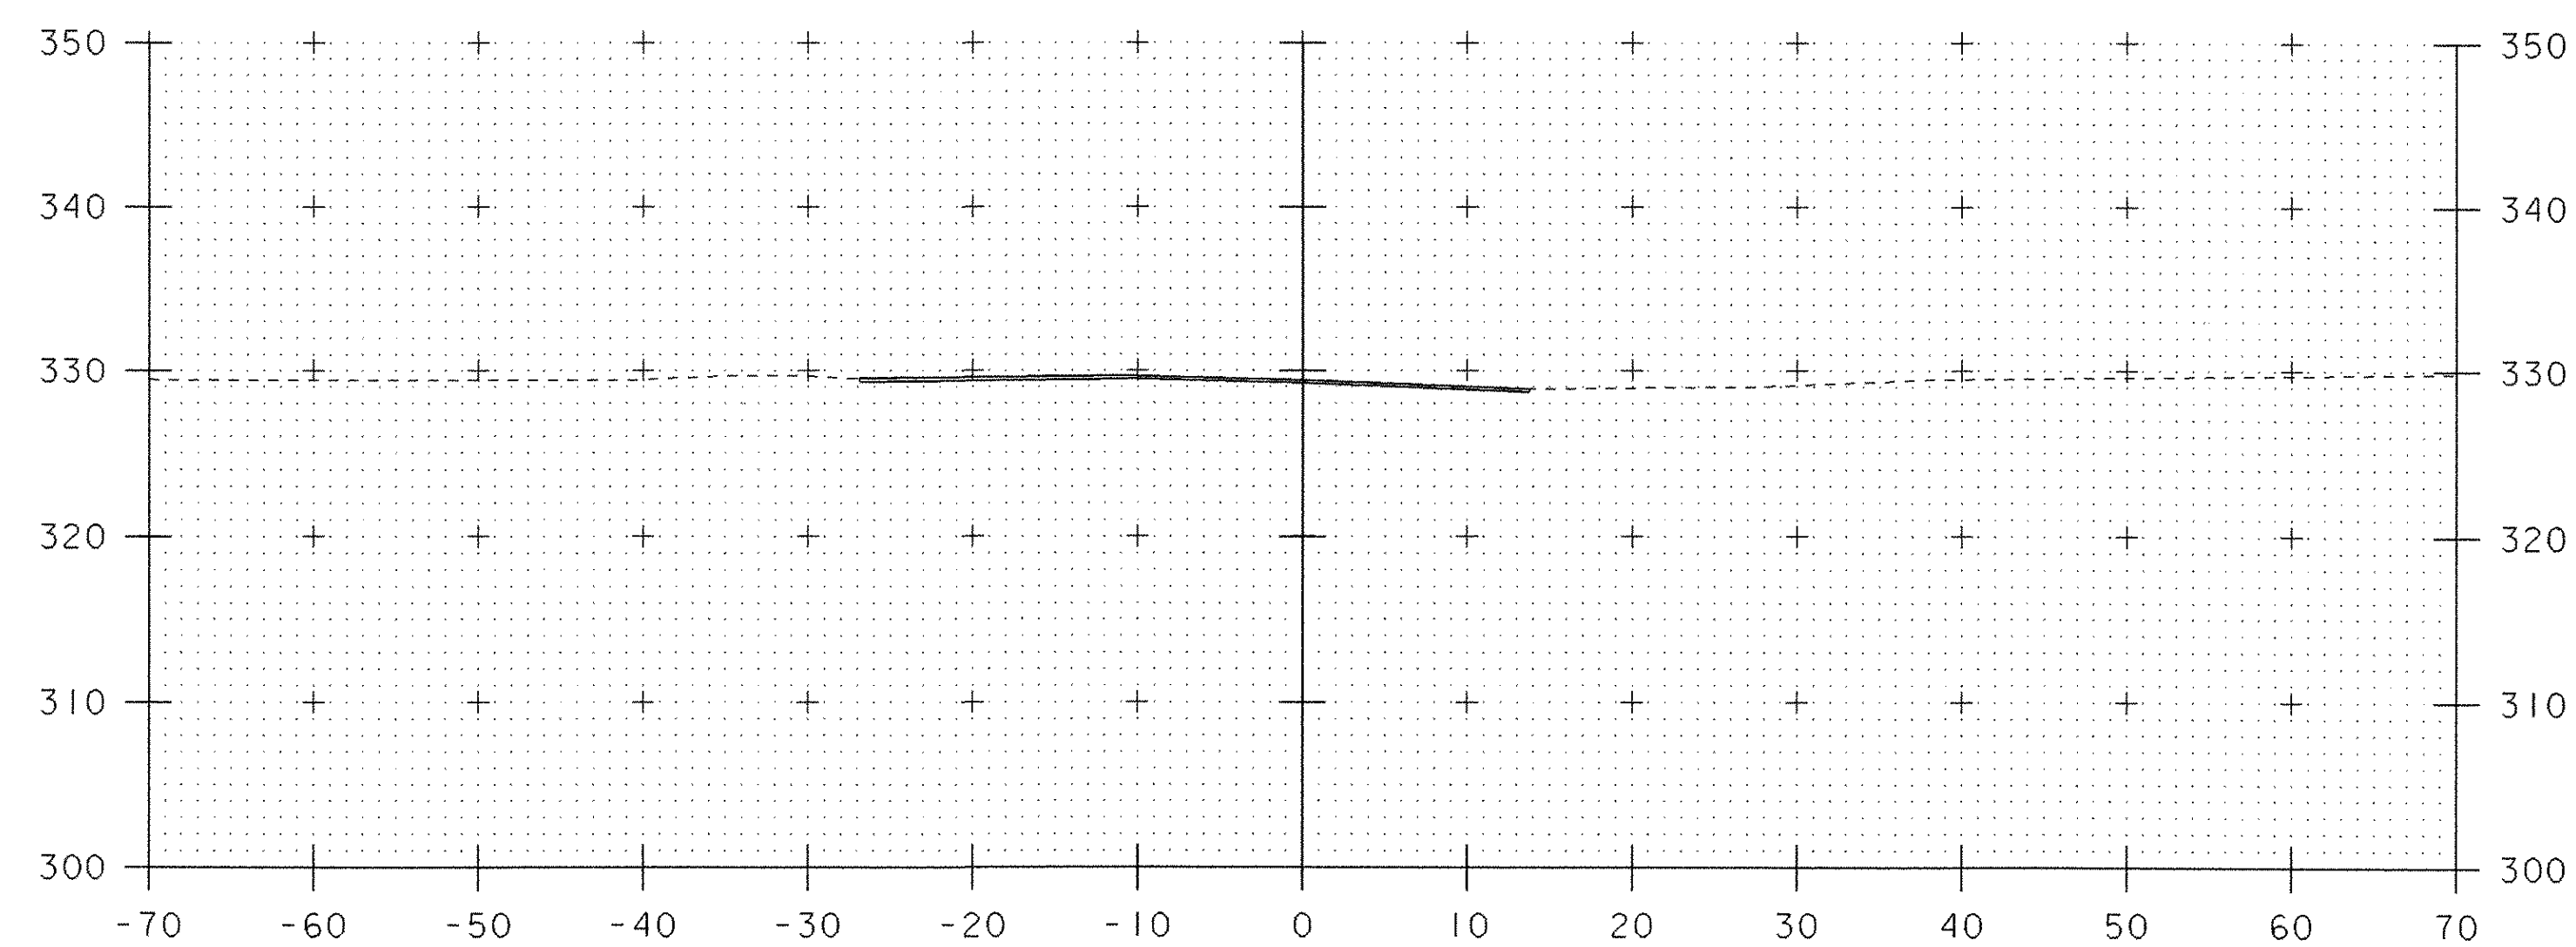

280+50

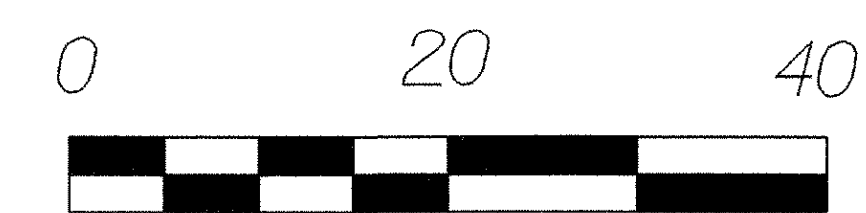

SCALE
IN FEET
HORIZ & VERT

PROJECT NAME:	ESSEX	
PROJECT NUMBER:	STPG_SGNL (17)	
FILE NAME:	96b182/tb182wrk.dgn/tb182xsl.t	PLOT DATE: 16-NOV-2006
PROJECT LEADER:	B. NYQUIST	DRAWN BY: B. MCAVOY
DESIGNED BY:	B. MCAVOY	CHECKED BY: B. NYQUIST
		SHEET 24 OF 29