




281+29

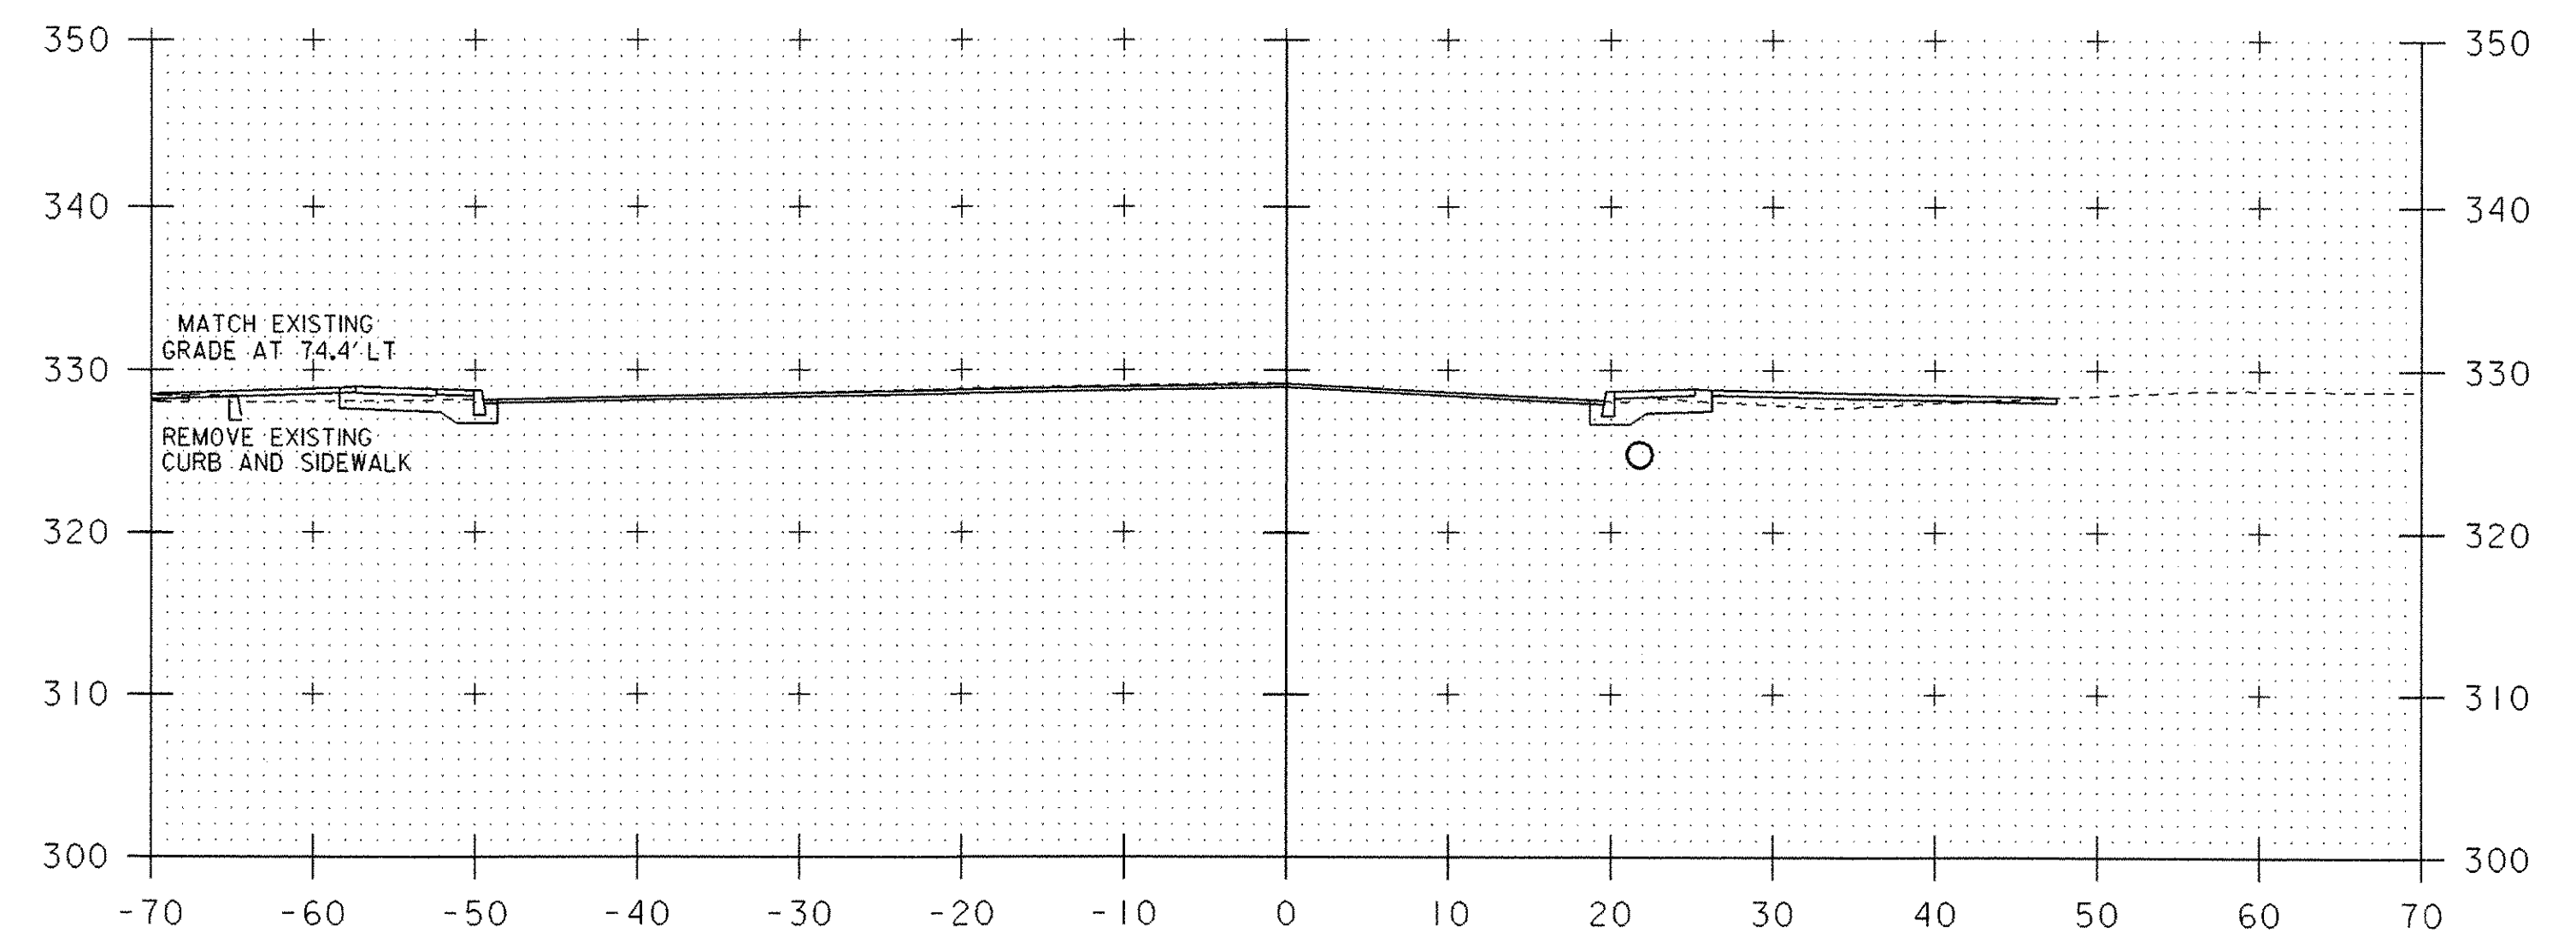


281+89

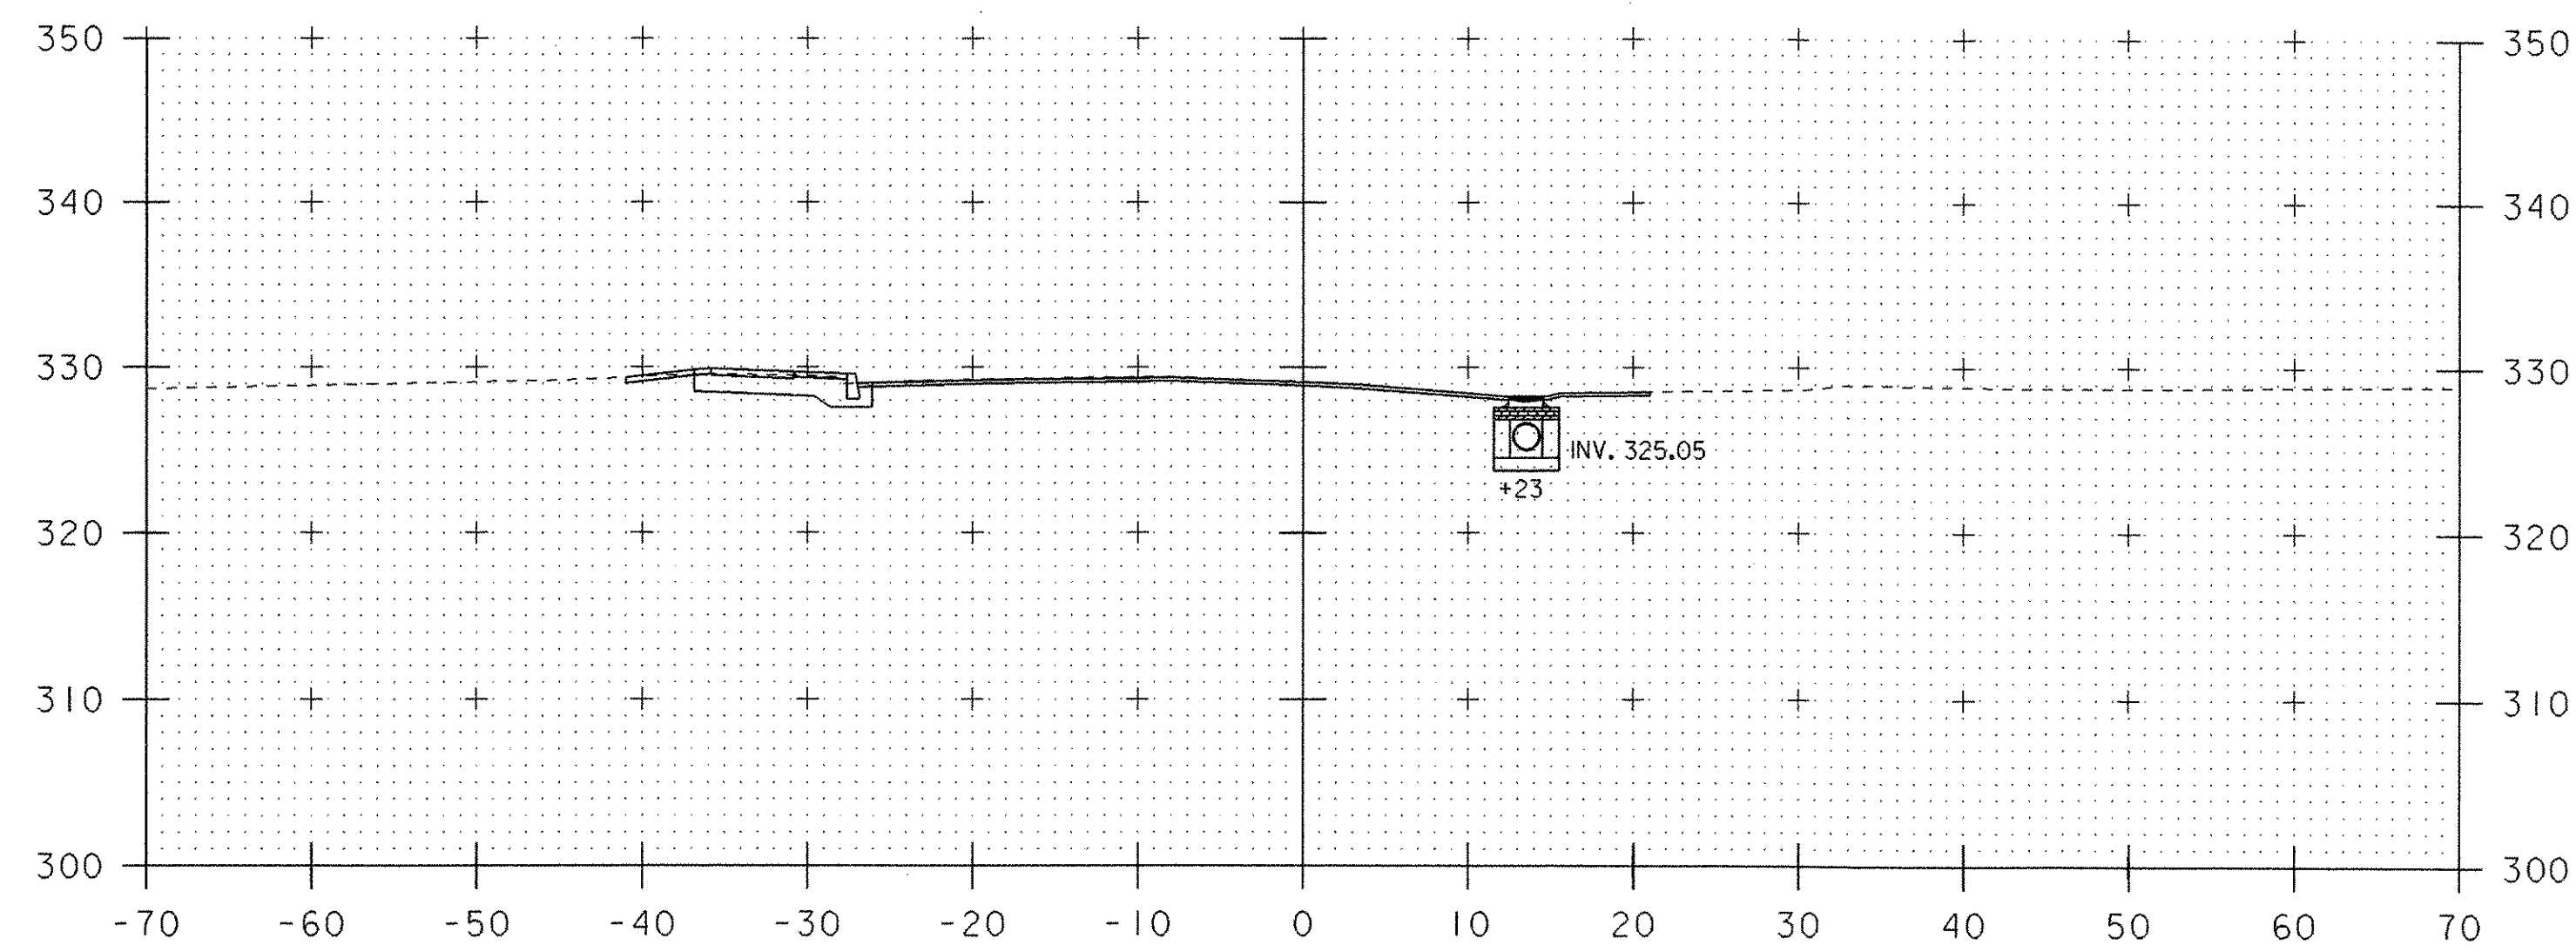

281+23

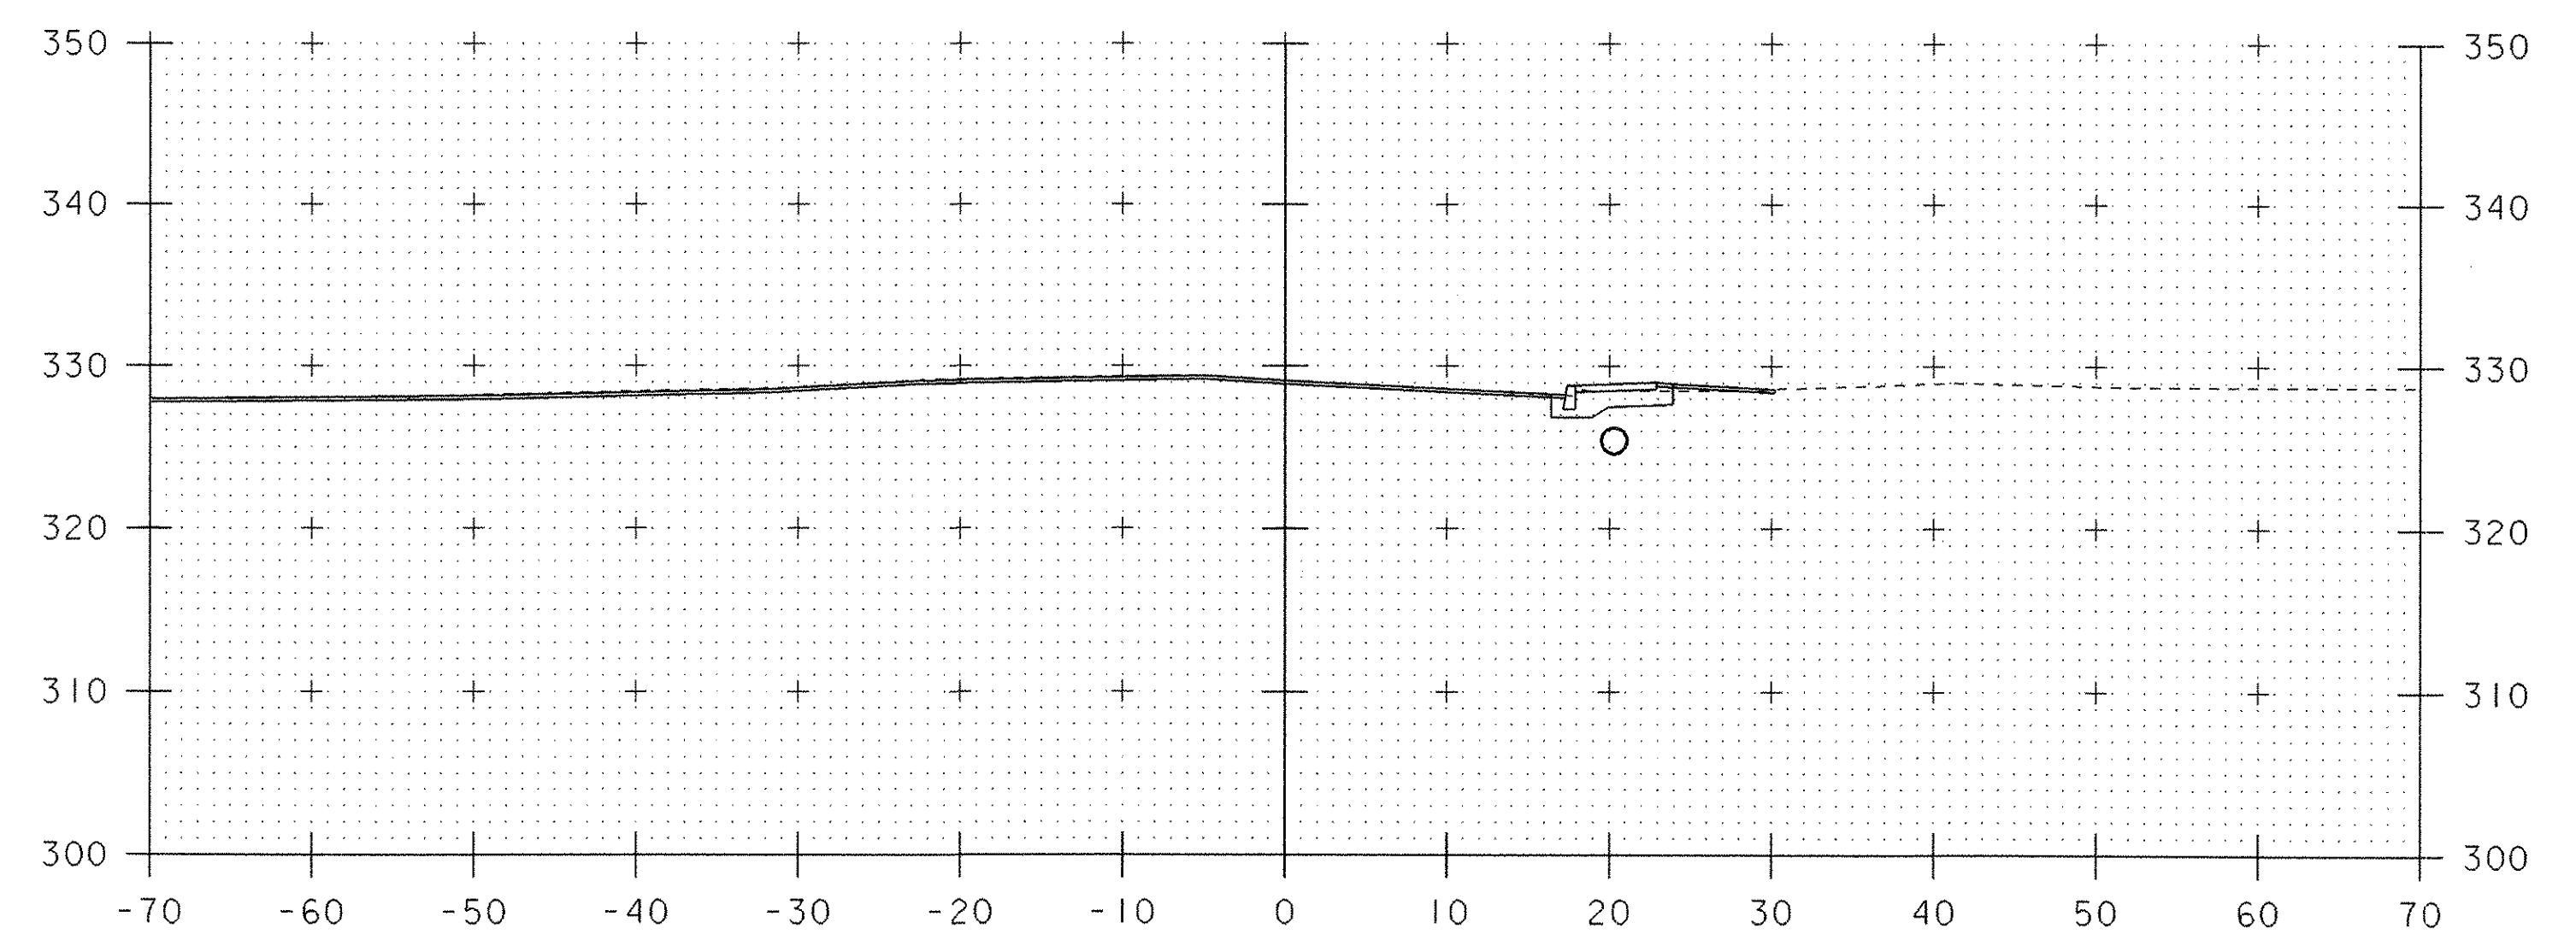

281+50

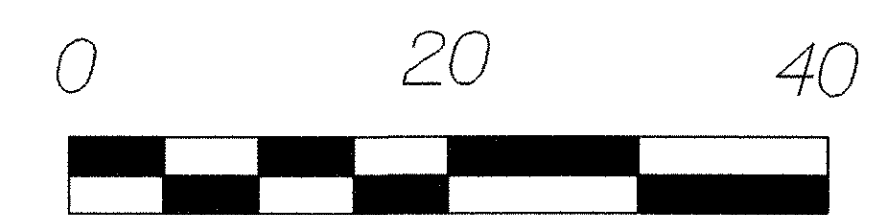

SCALE
IN FEET
HORIZ & VERT

PROJECT NAME:	ESSEX		
PROJECT NUMBER:	STPG_SGNL (17)		
FILE NAME:	96b182/1b182wrk.dgn/1b182xs2.1	PLOT DATE:	16-NOV-2006
PROJECT LEADER:	B. NYQUIST	DRAWN BY:	B. MCAVOY
DESIGNED BY:	B. MCAVOY	CHECKED BY:	B. NYQUIST
		SHEET	25 OF 29