




282+00

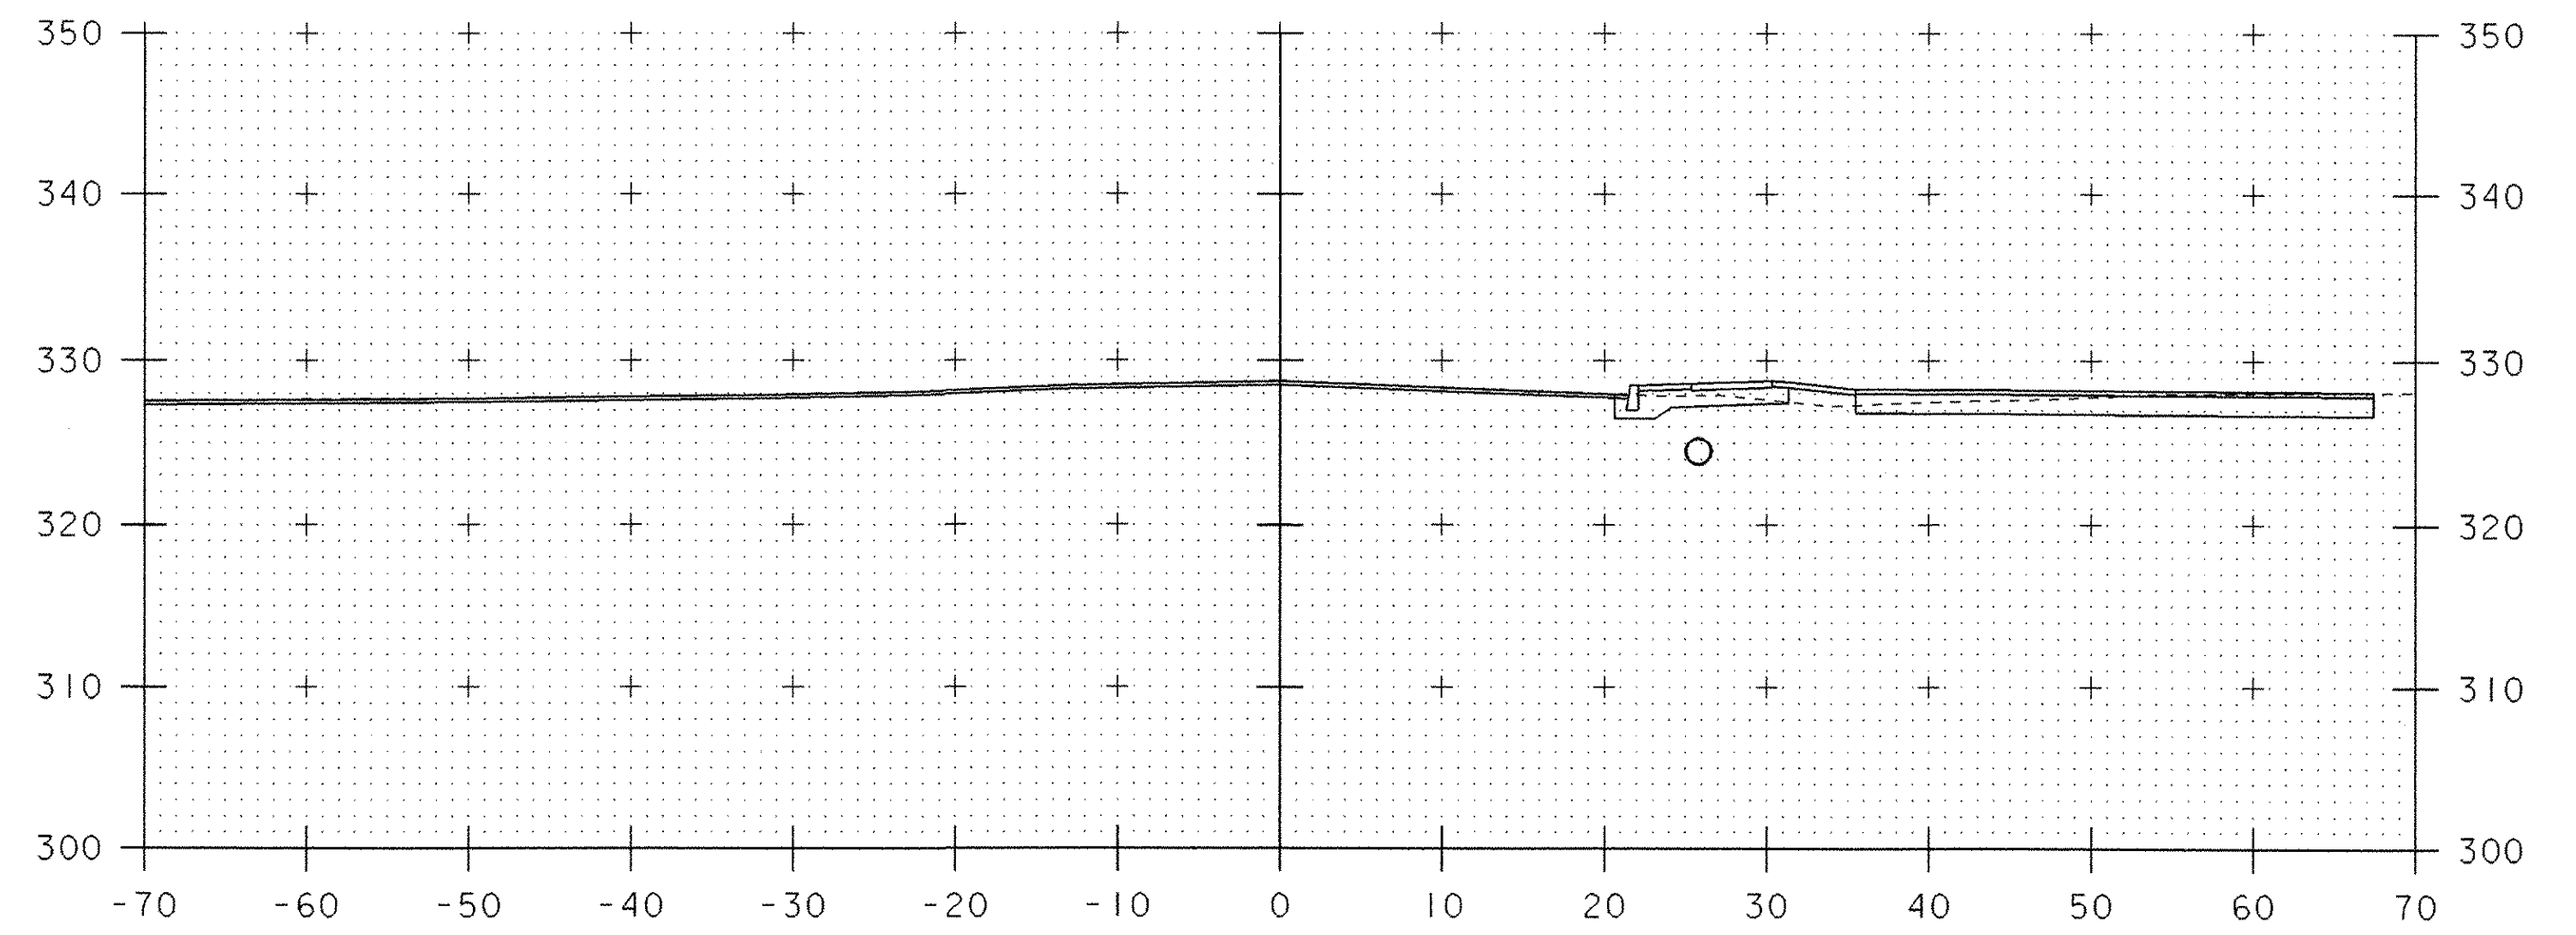

282+25

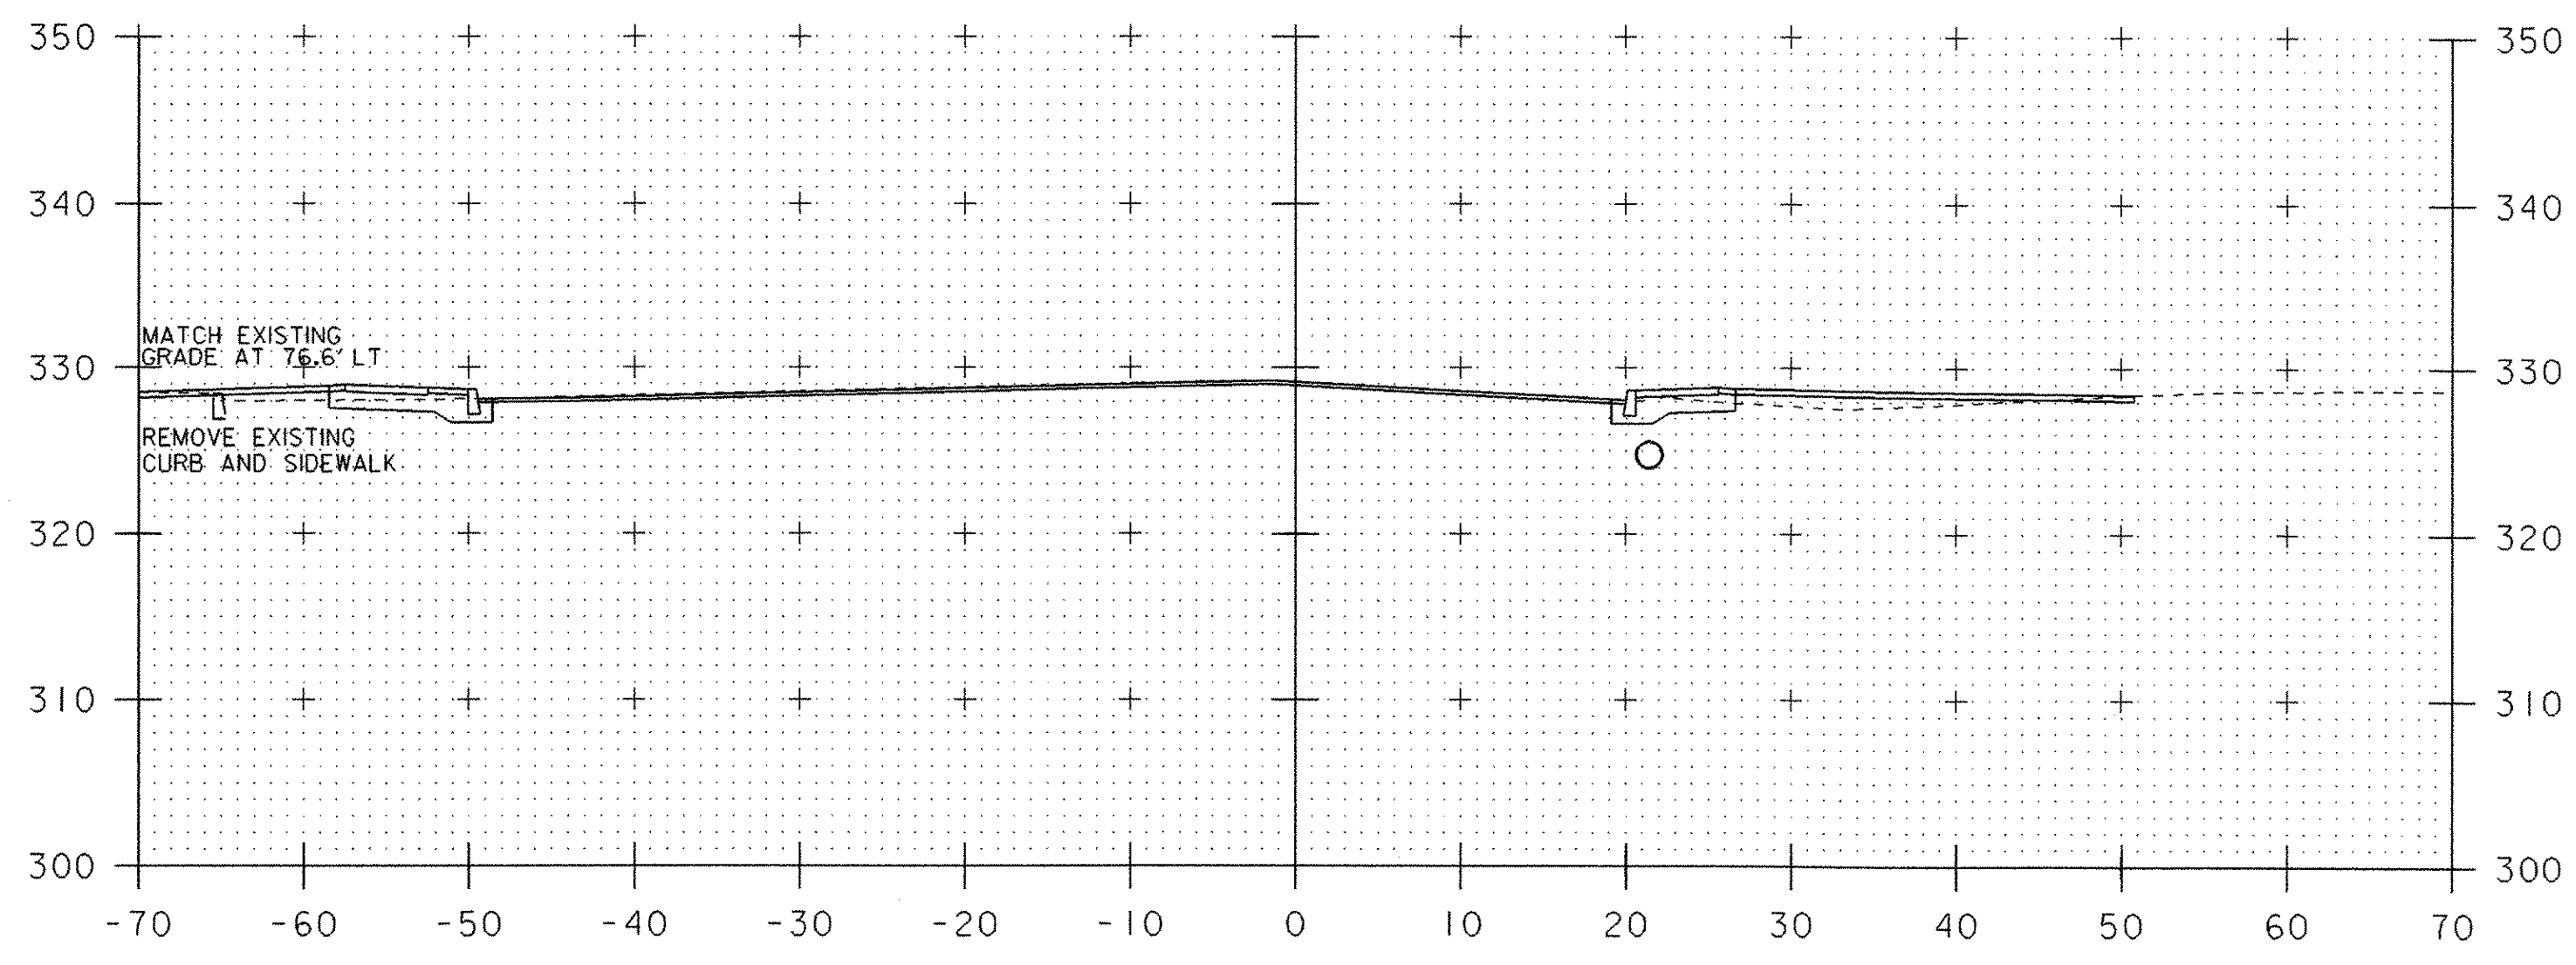

281+93

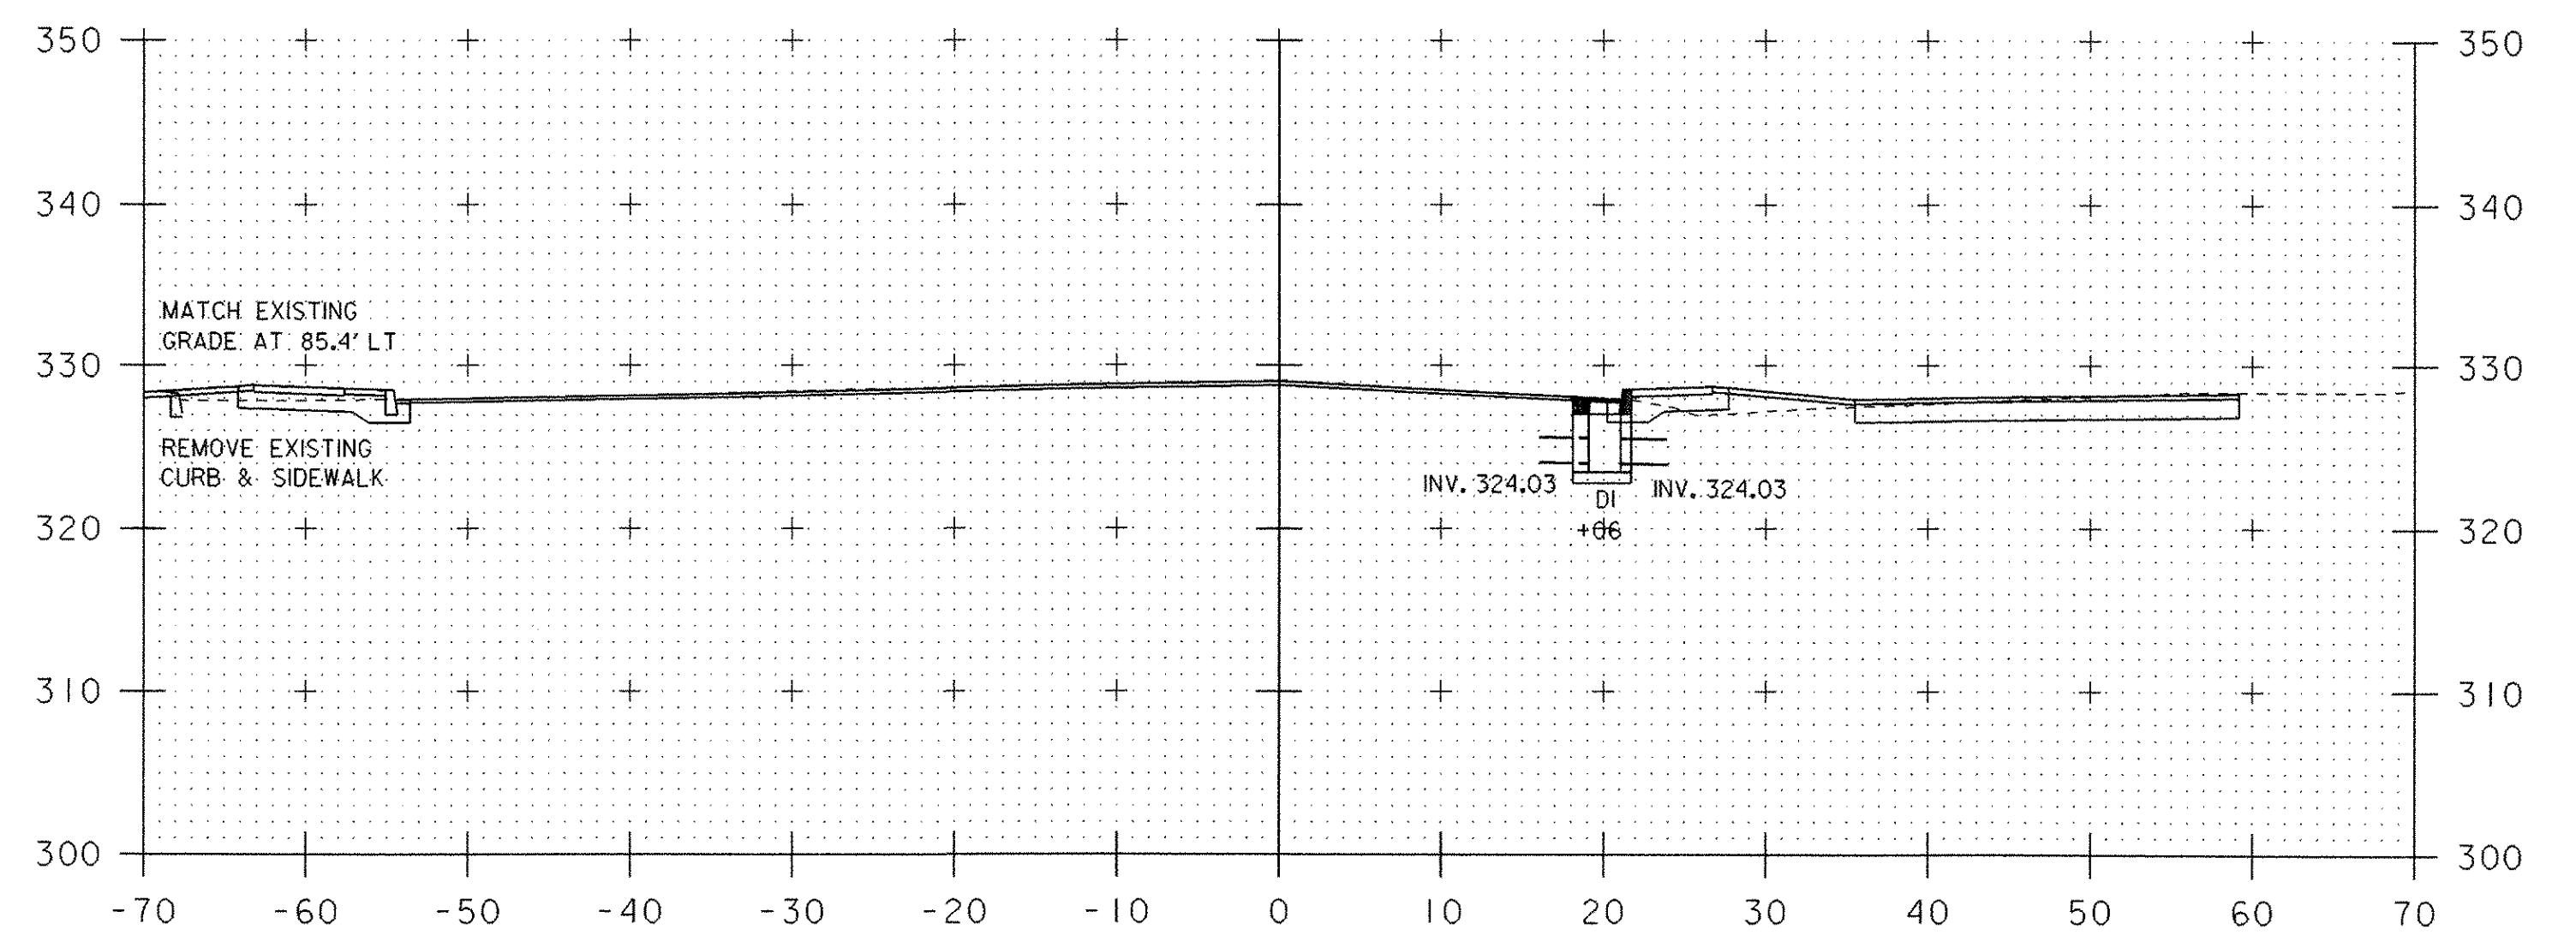

282+06



SCALE  
IN FEET  
HORIZ & VERT

PROJECT NAME:	ESSEX		
PROJECT NUMBER:	STPG SGNL (17)		
FILE NAME:	96bl82/tbl82wrk.dgn/tbl82xs3.1	PLOT DATE:	16-NOV-2006
PROJECT LEADER:	B. NYQUIST	DRAWN BY:	B. MCAVOY
DESIGNED BY:	B. MCAVOY	CHECKED BY:	B. NYQUIST
		SHEET	26 OF 29