




282+80

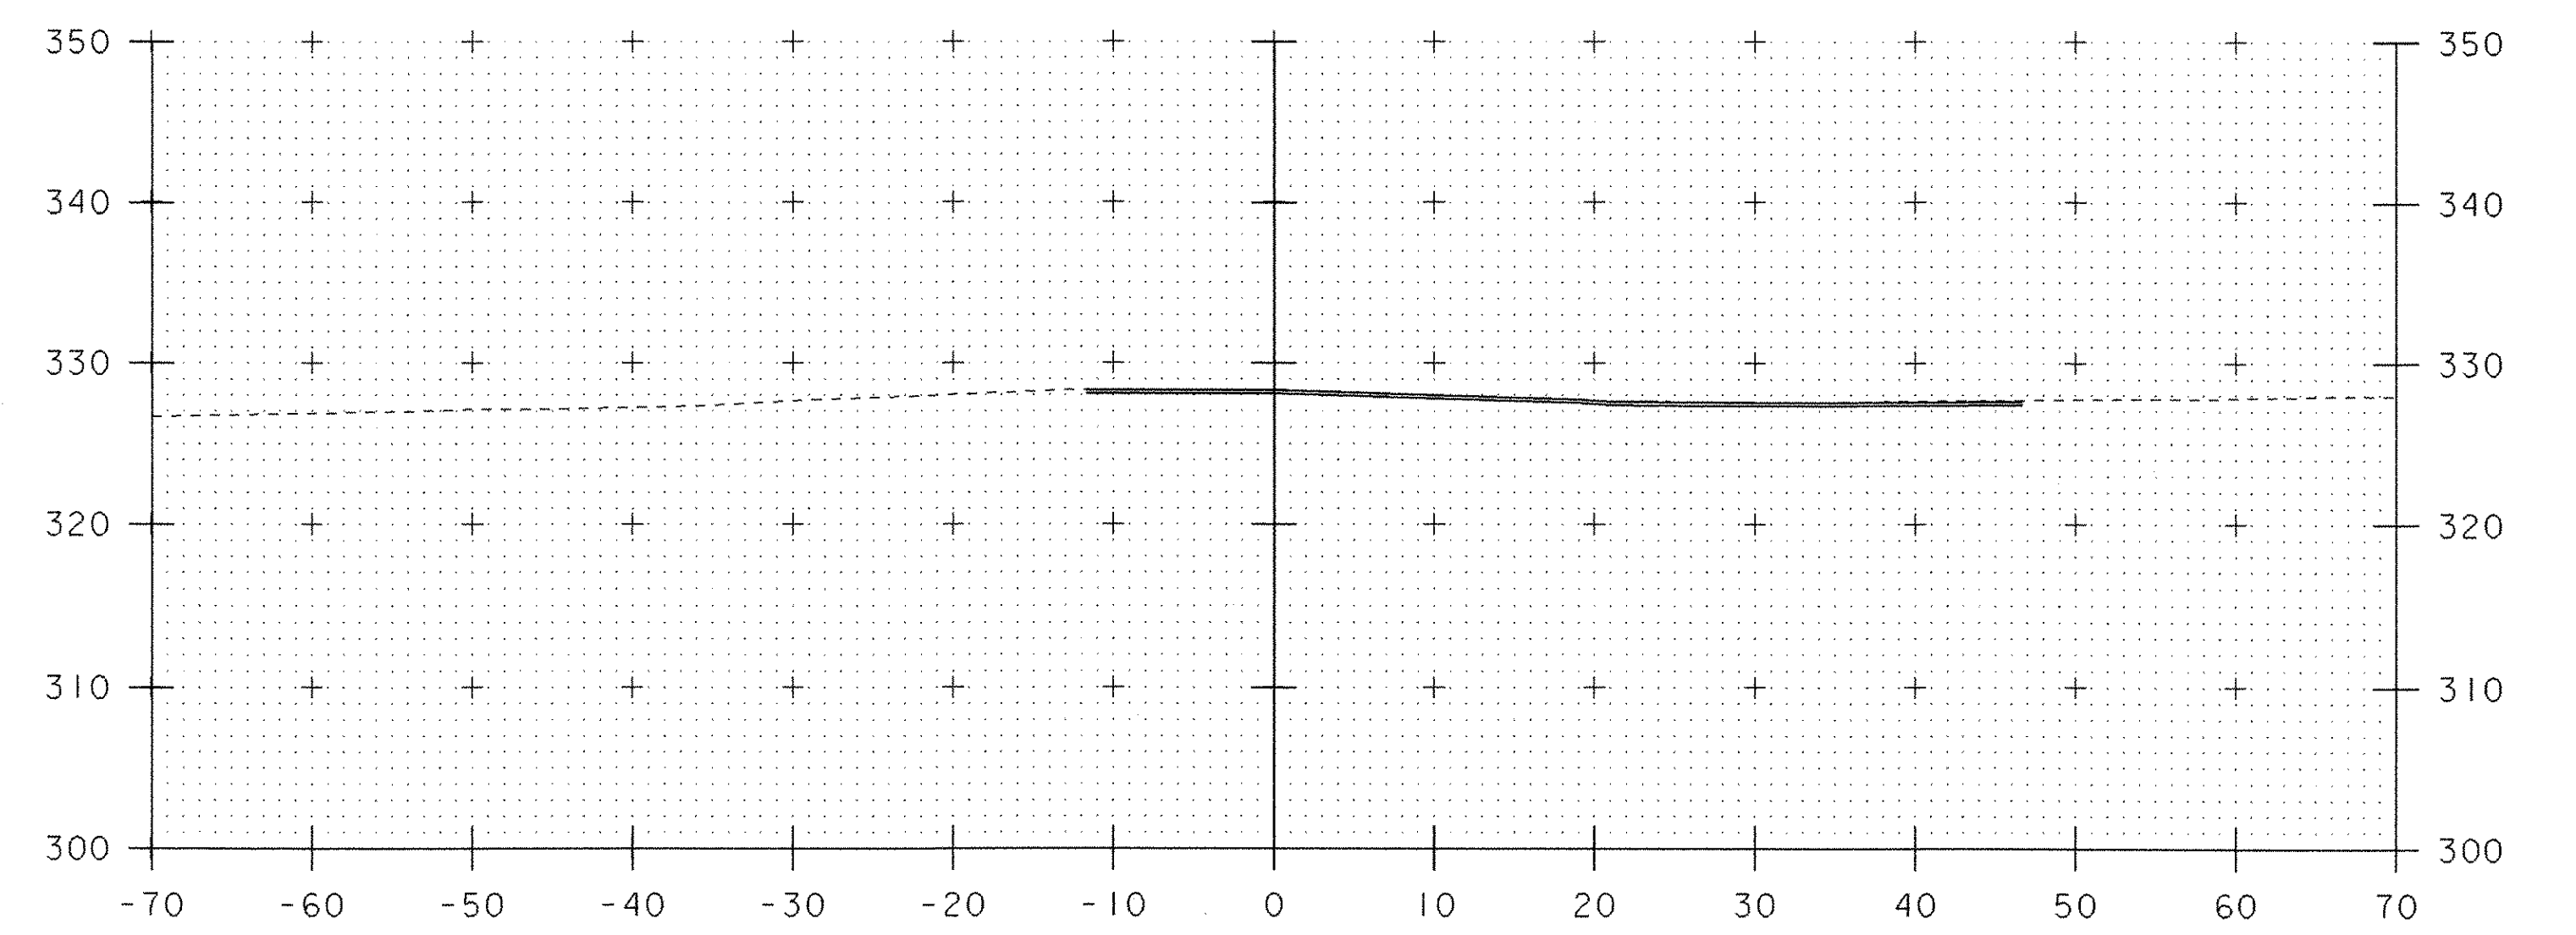

283+10

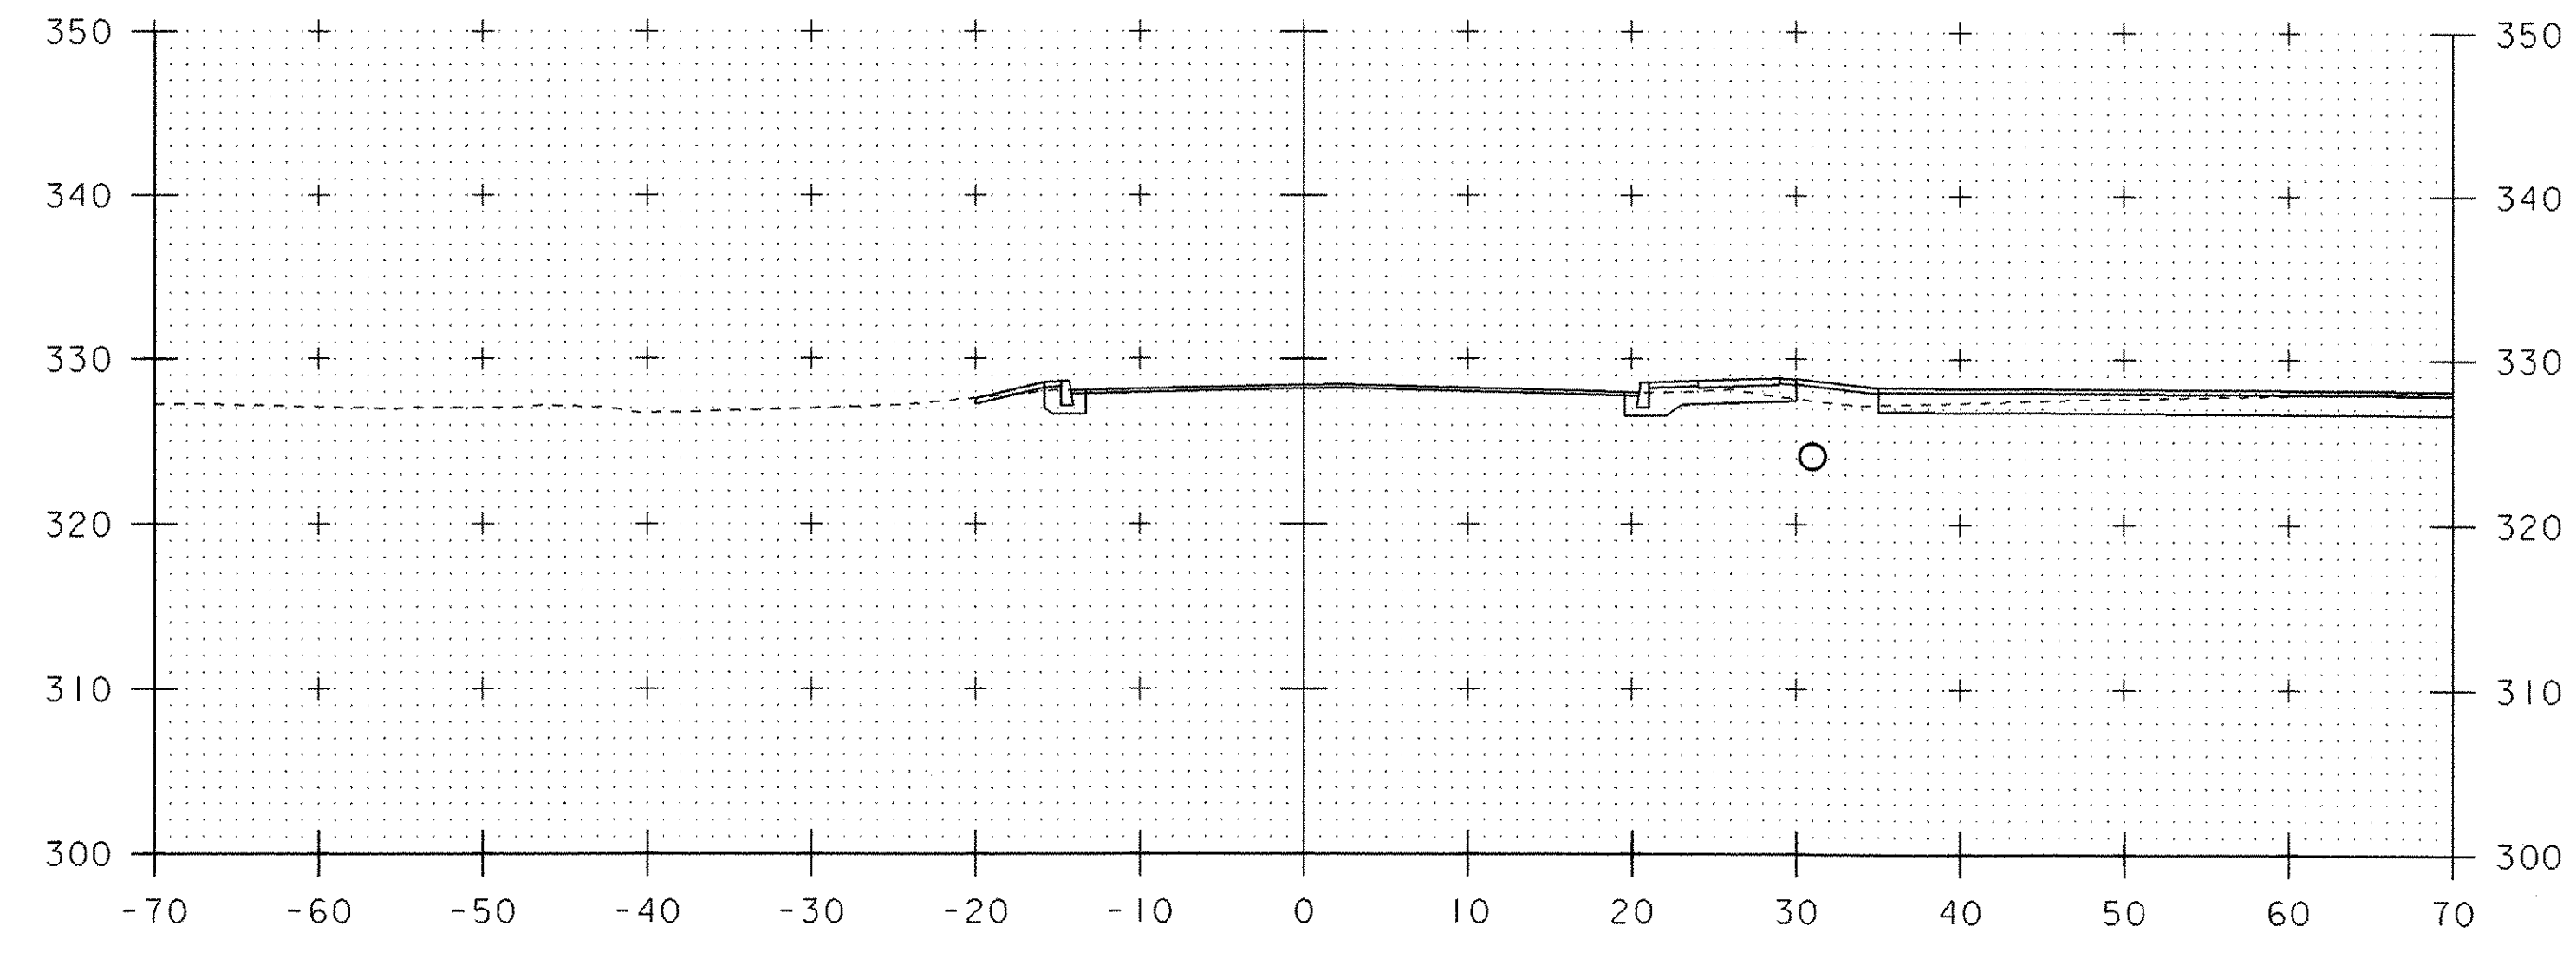

282+50

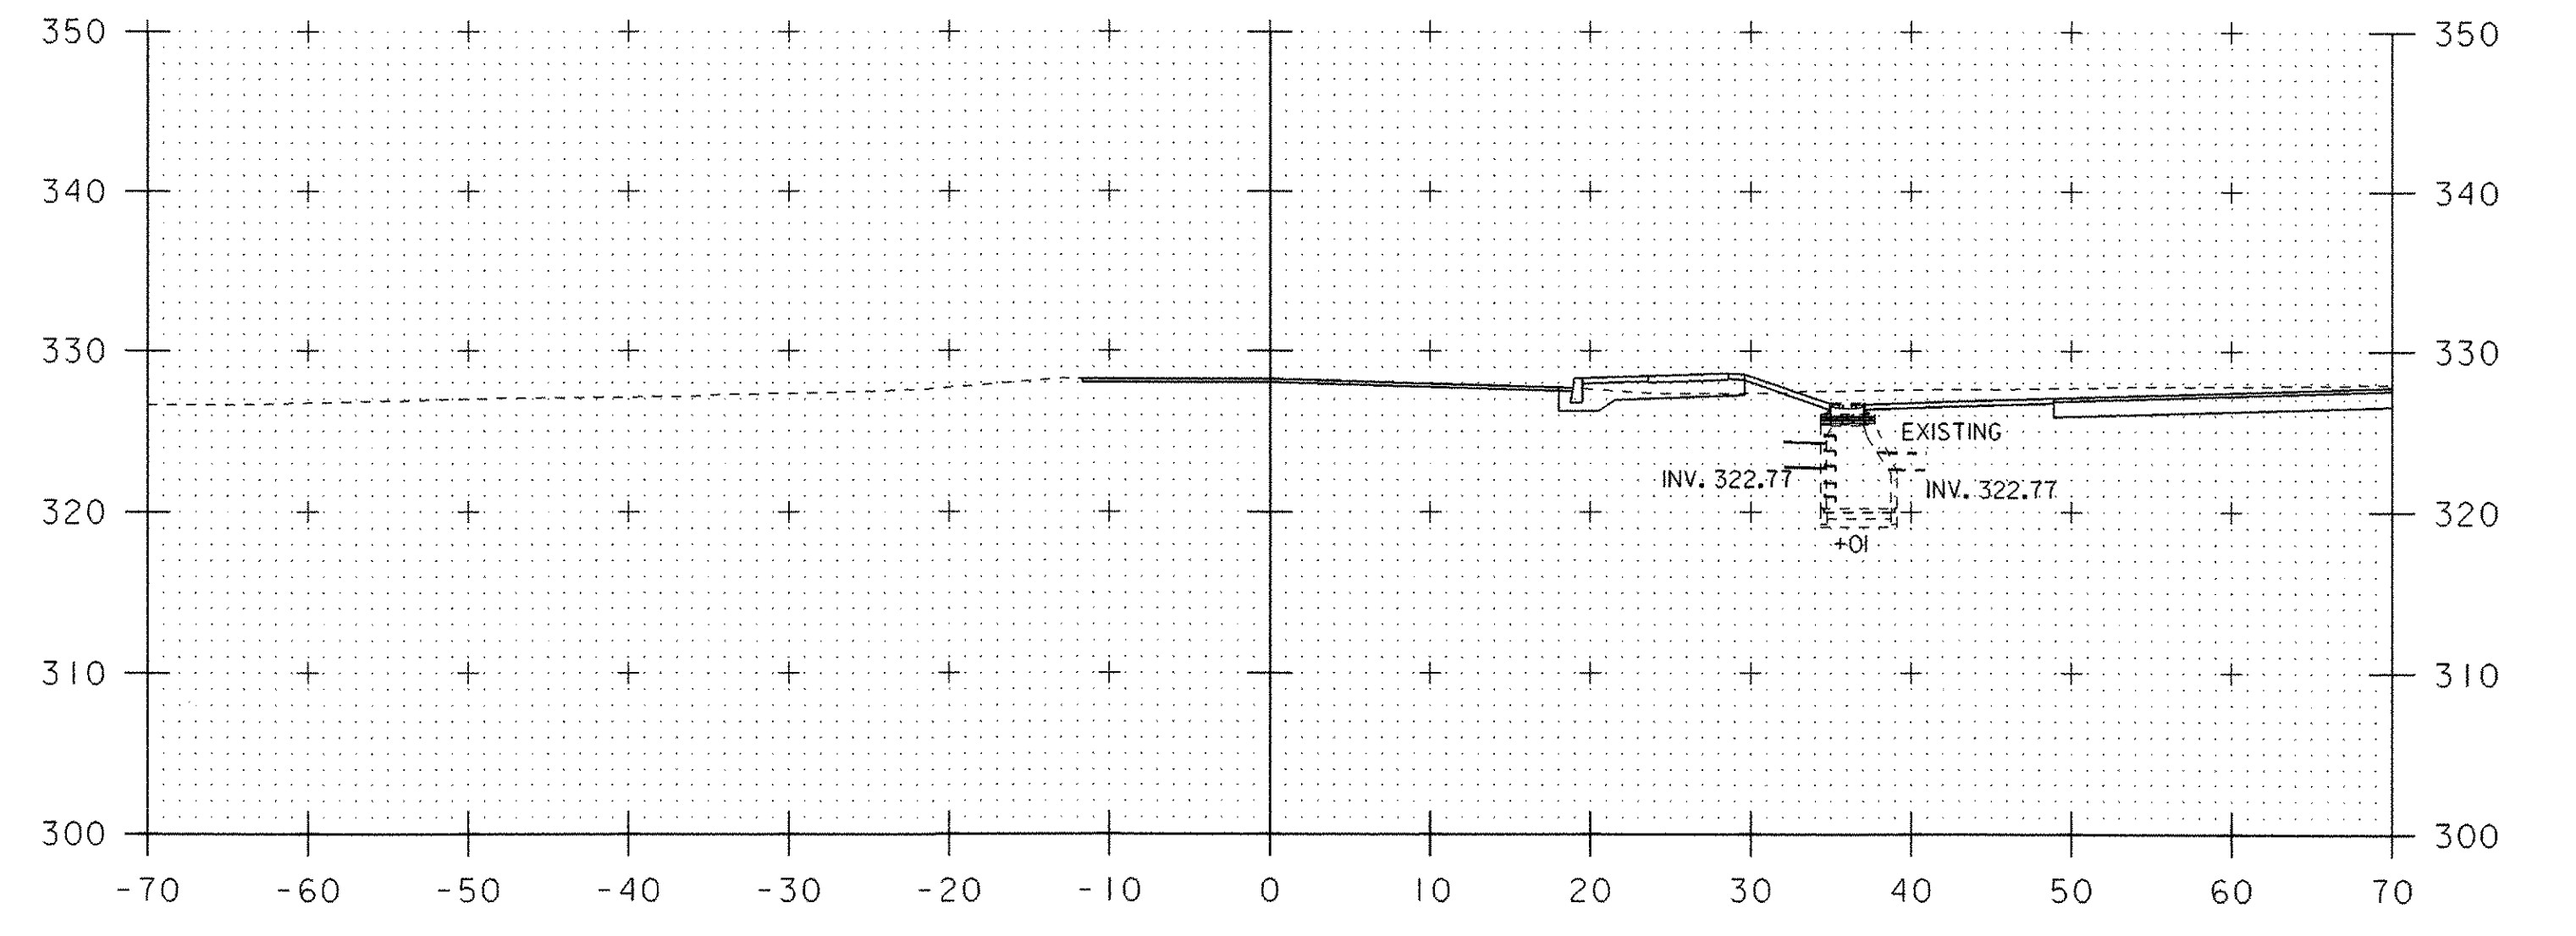

283+00



SCALE
IN FEET
HORIZ & VERT

PROJECT NAME:	ESSEX		
PROJECT NUMBER:	STPG SGNL (17)		
FILE NAME:	96bl82/tbl82wrk.dgn/tbl82xs4.l	PLOT DATE:	16-NOV-2006
PROJECT LEADER:	B. NYQUIST	DRAWN BY:	B. MCAVOY
DESIGNED BY:	B. MCAVOY	CHECKED BY:	B. NYQUIST
		SHEET	27 OF 29