




0+50

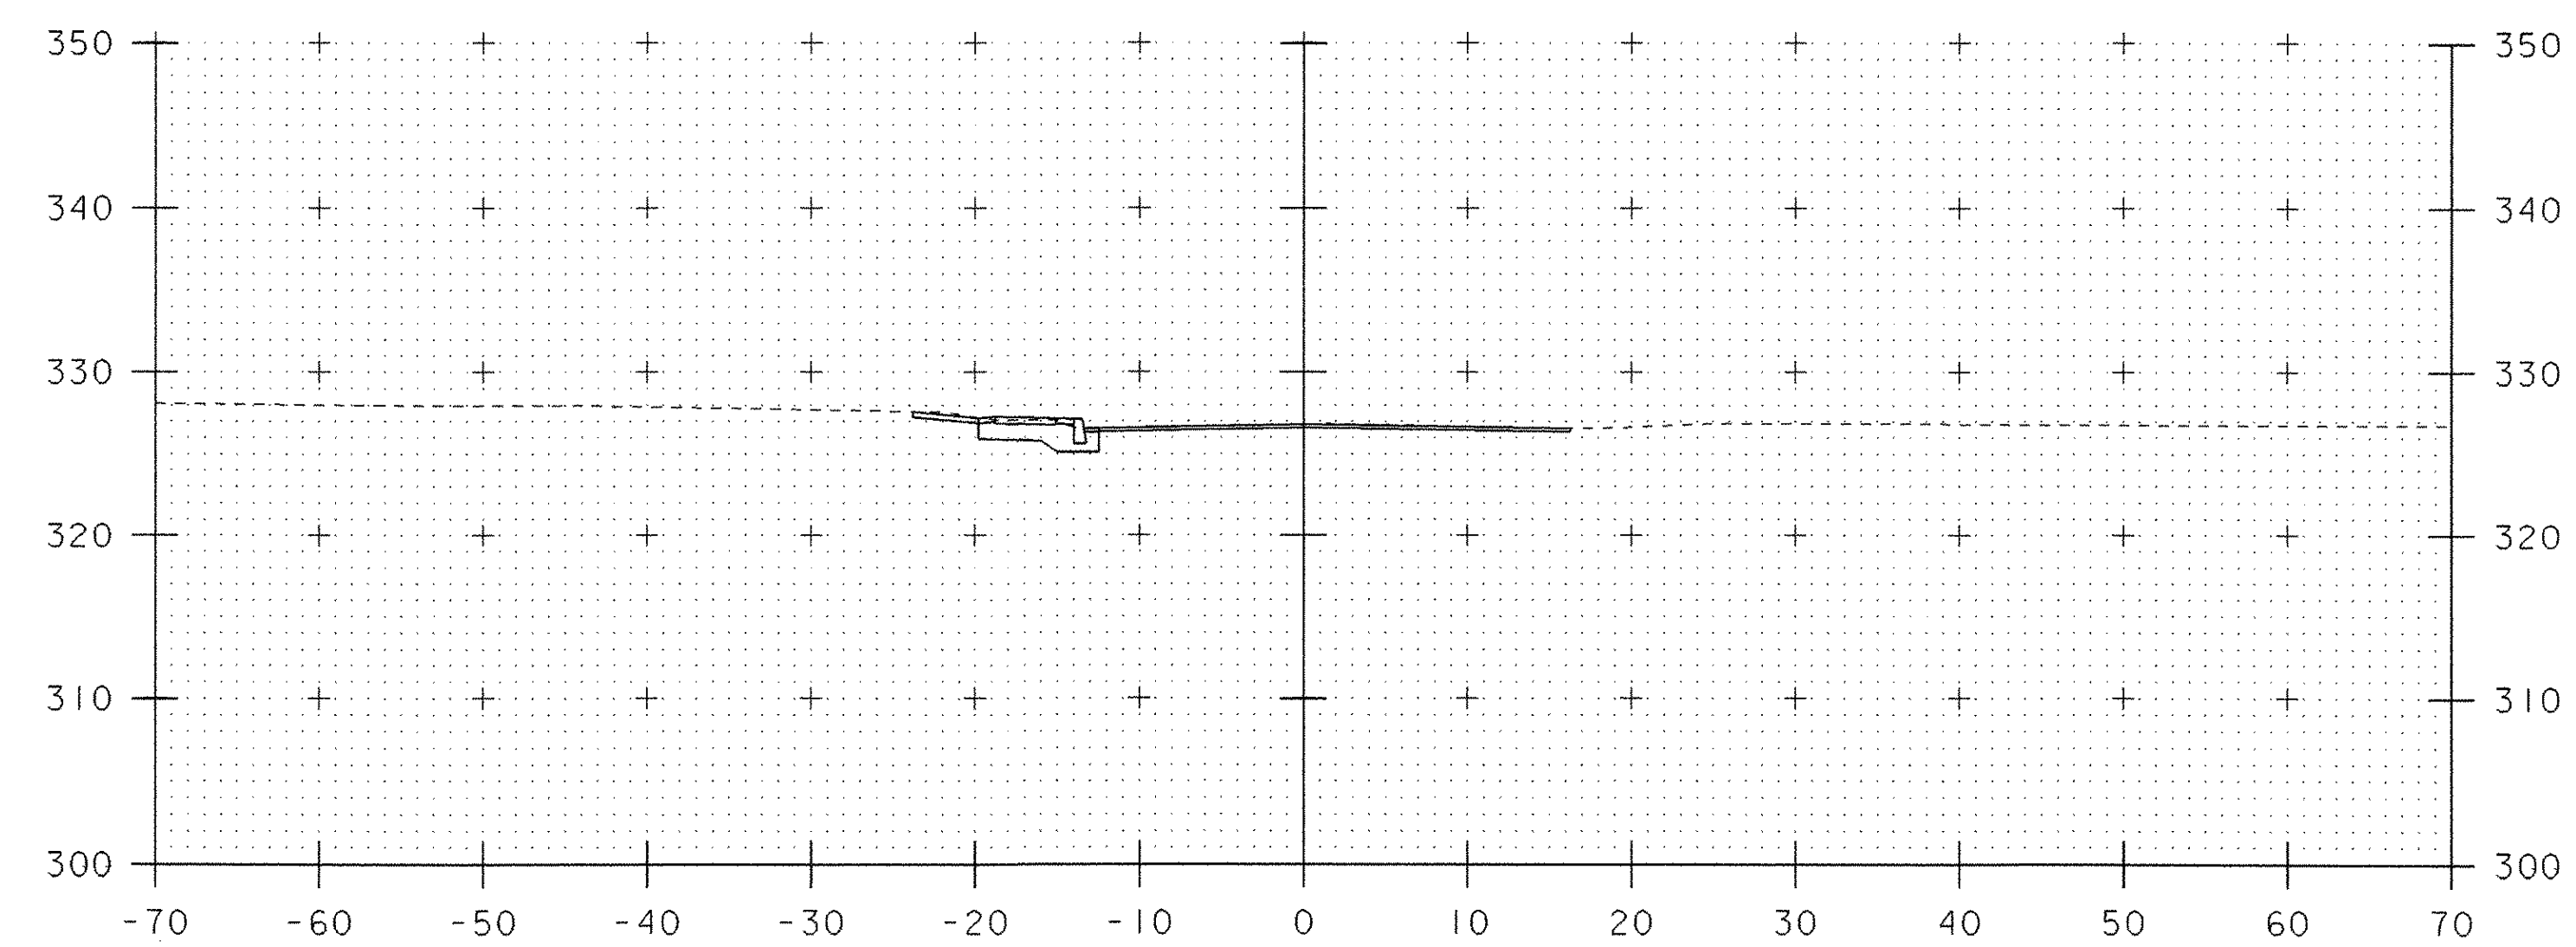

1+50

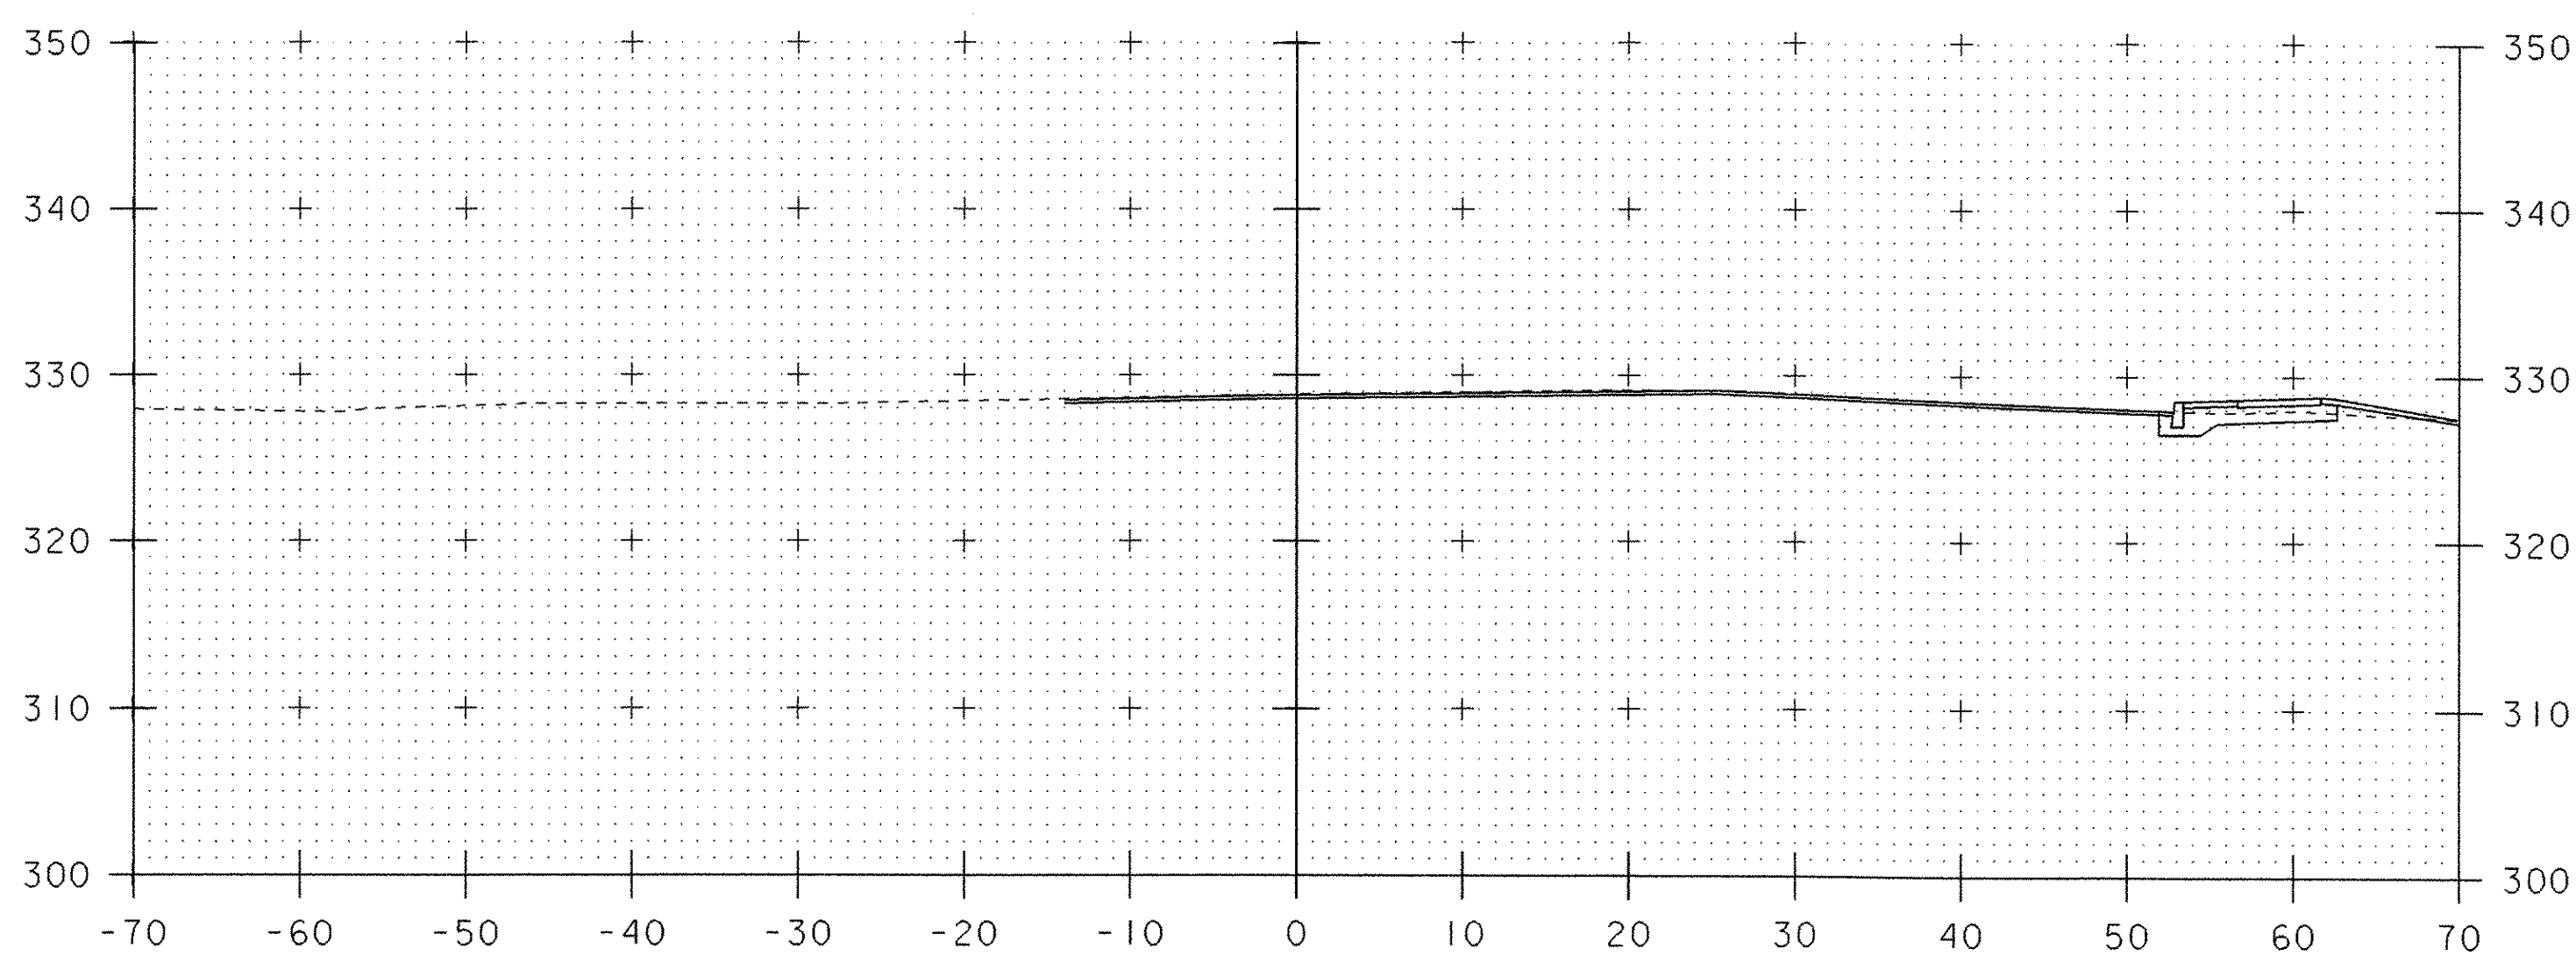

0+00

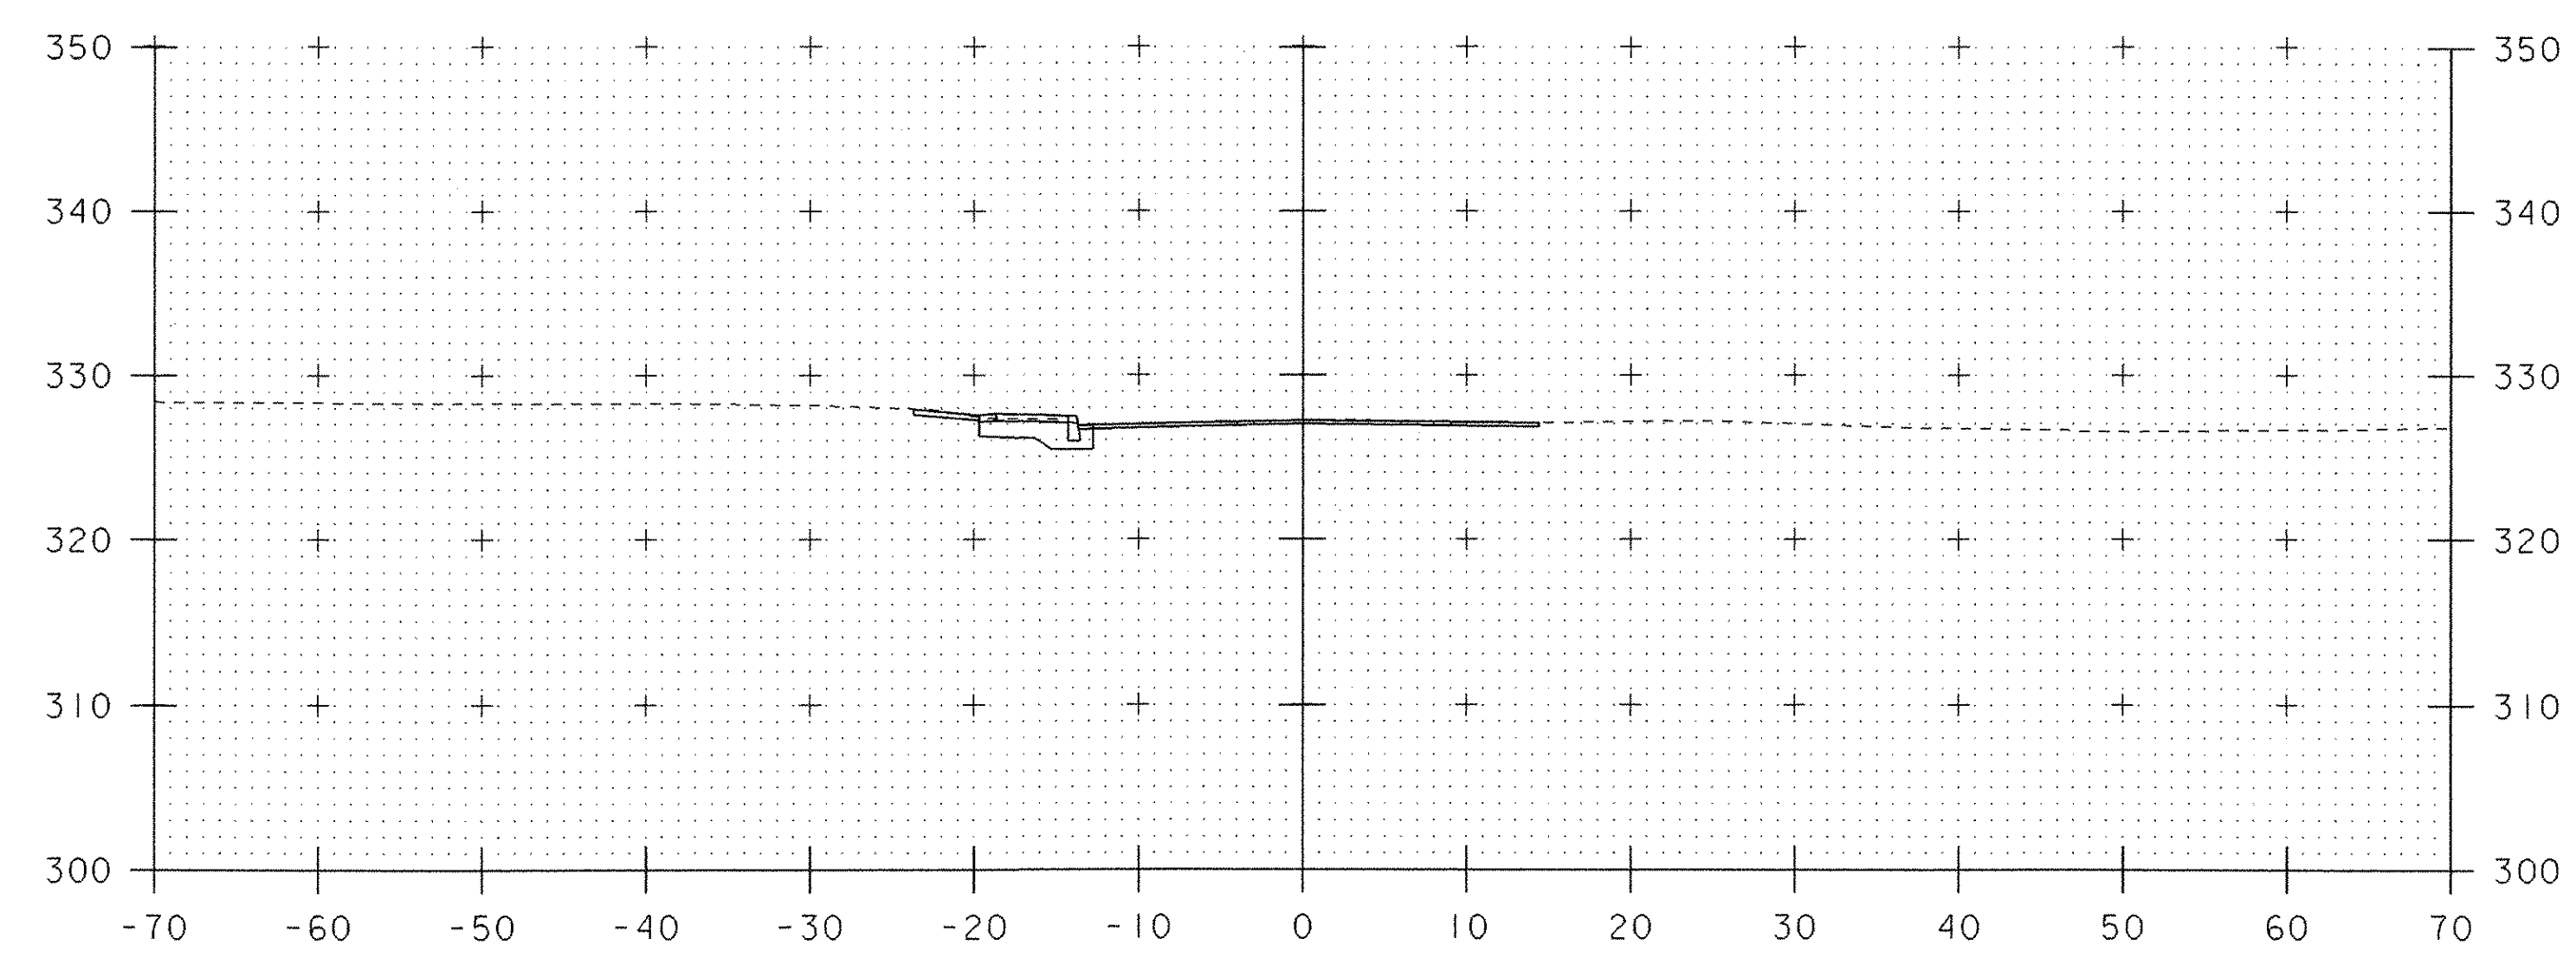

1+00



SCALE  
IN FEET  
HORIZ & VERT

PROJECT NAME:	ESSEX	
PROJECT NUMBER:	SIPG SGNL (17)	
FILE NAME:	96b182/tb182wrk.dgn/tb182xs5.j	PLOT DATE: 16-NOV-2006
PROJECT LEADER:	B. NYQUIST	DRAWN BY: B. MCAVOY
DESIGNED BY:	B. MCAVOY	CHECKED BY: B. NYQUIST
	SHEET	28 OF 29