




11+00

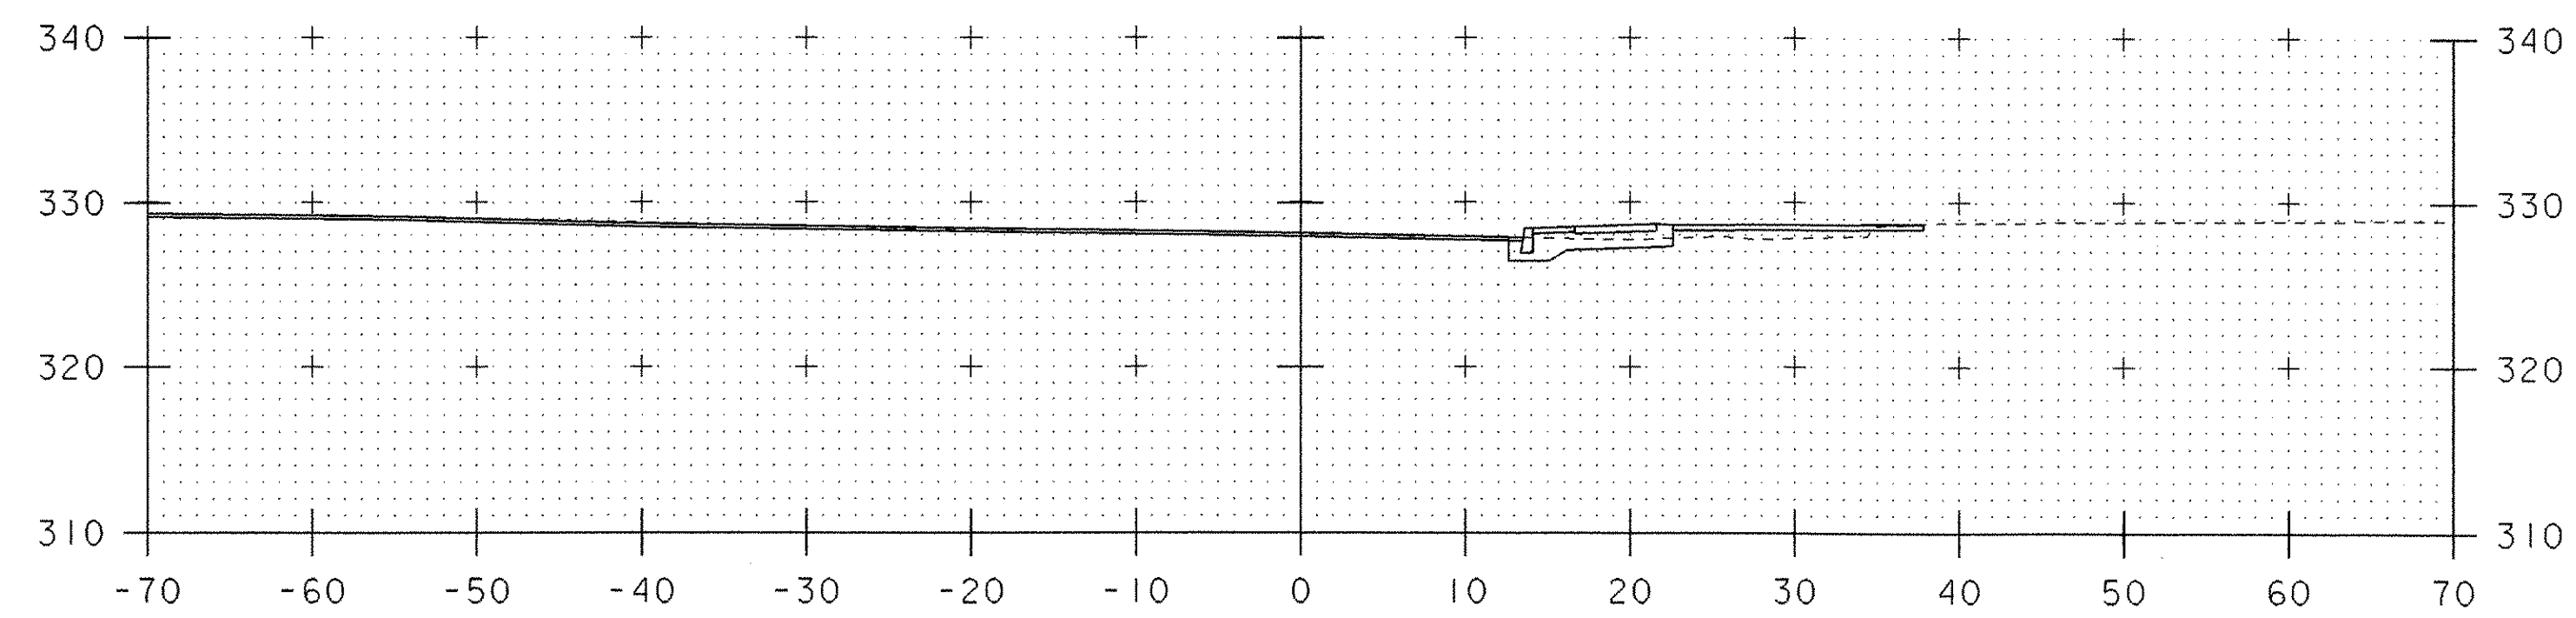


10+50

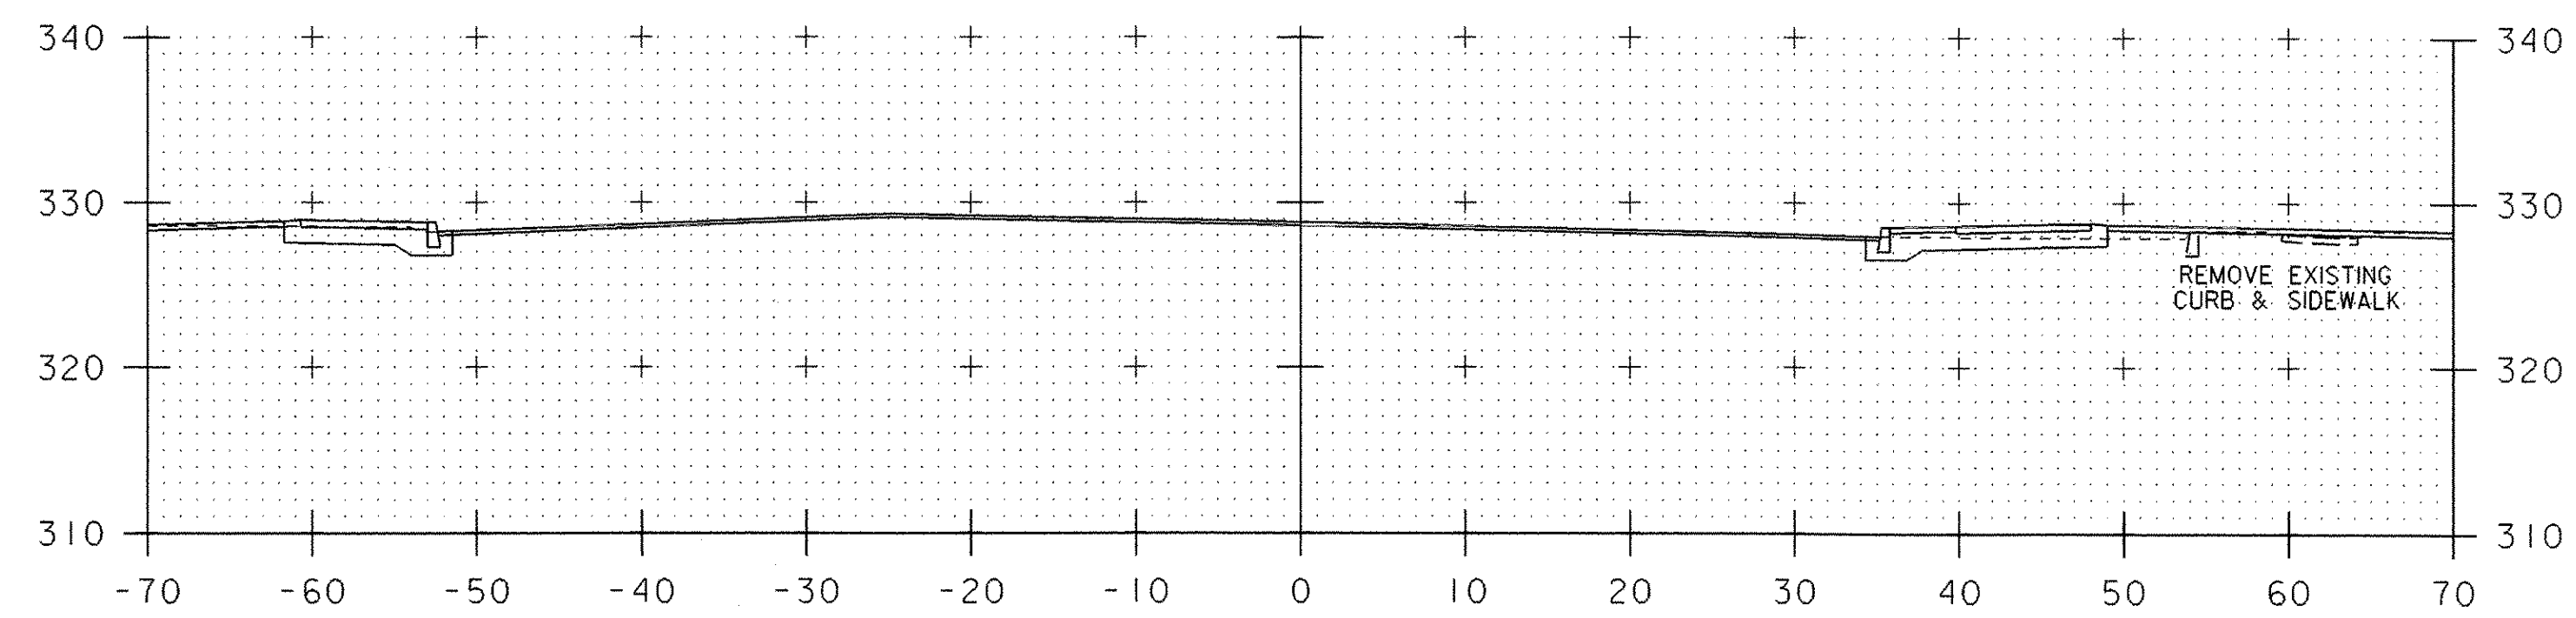

10+00

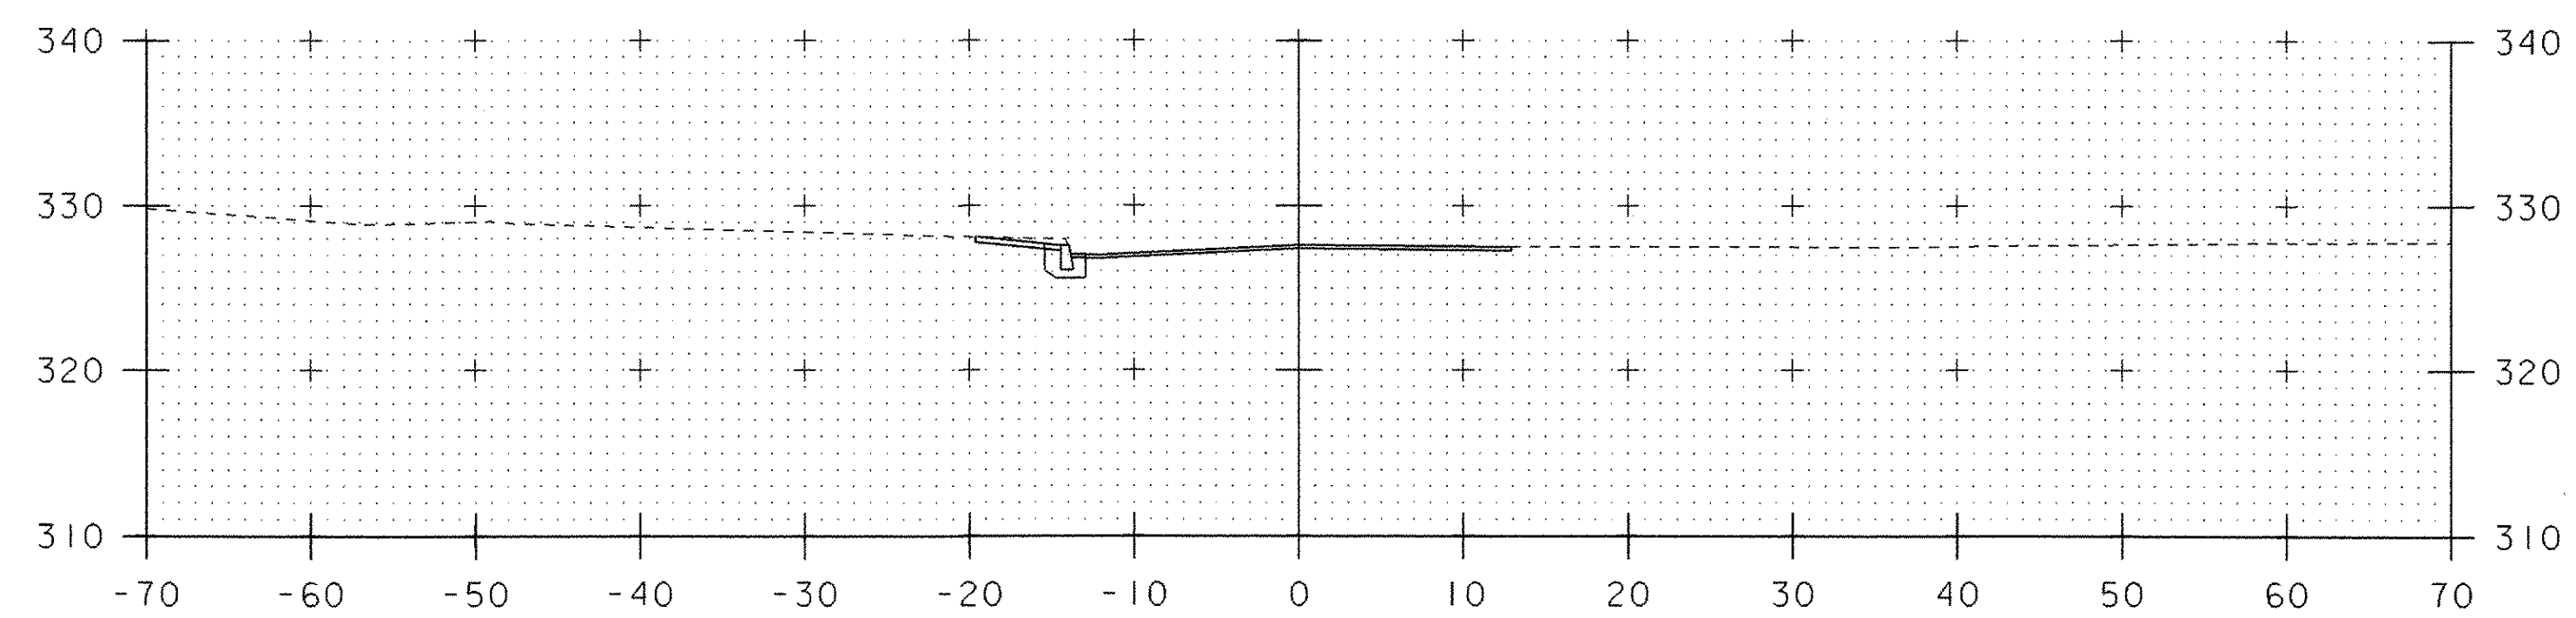

11+50

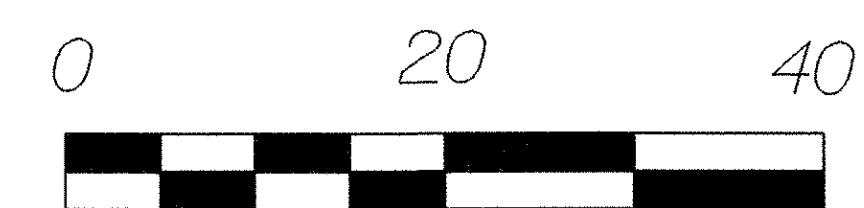

SCALE  
IN FEET  
HORIZ & VERT

PROJECT NAME:	ESSEX		
PROJECT NUMBER:	STPG SGNL (17)		
FILE NAME:	96b182/1b182wrk.dgn/1b182xs6.i	PLOT DATE:	16-NOV-2006
PROJECT LEADER:	B. NYQUIST	DRAWN BY:	B. MCAVOY
DESIGNED BY:	B. MCAVOY	CHECKED BY:	B. NYQUIST
		SHEET	29 OF 29