




TEMPORARY AND DURABLE 100 mm YELLOW LINE
 STA 0+000 TO 1+000 SOLID LT & RT

TEMPORARY AND DURABLE 100 mm WHITE LINE
 STA 0+000 TO 1+000 SOLID LT. & RT.

REMOVING SIGNS
 AS SHOWN - 3

VT ROUTE 100
STA 0+000.00 (MM 0.000)
BEGIN PROJECT STP 9711(1)S

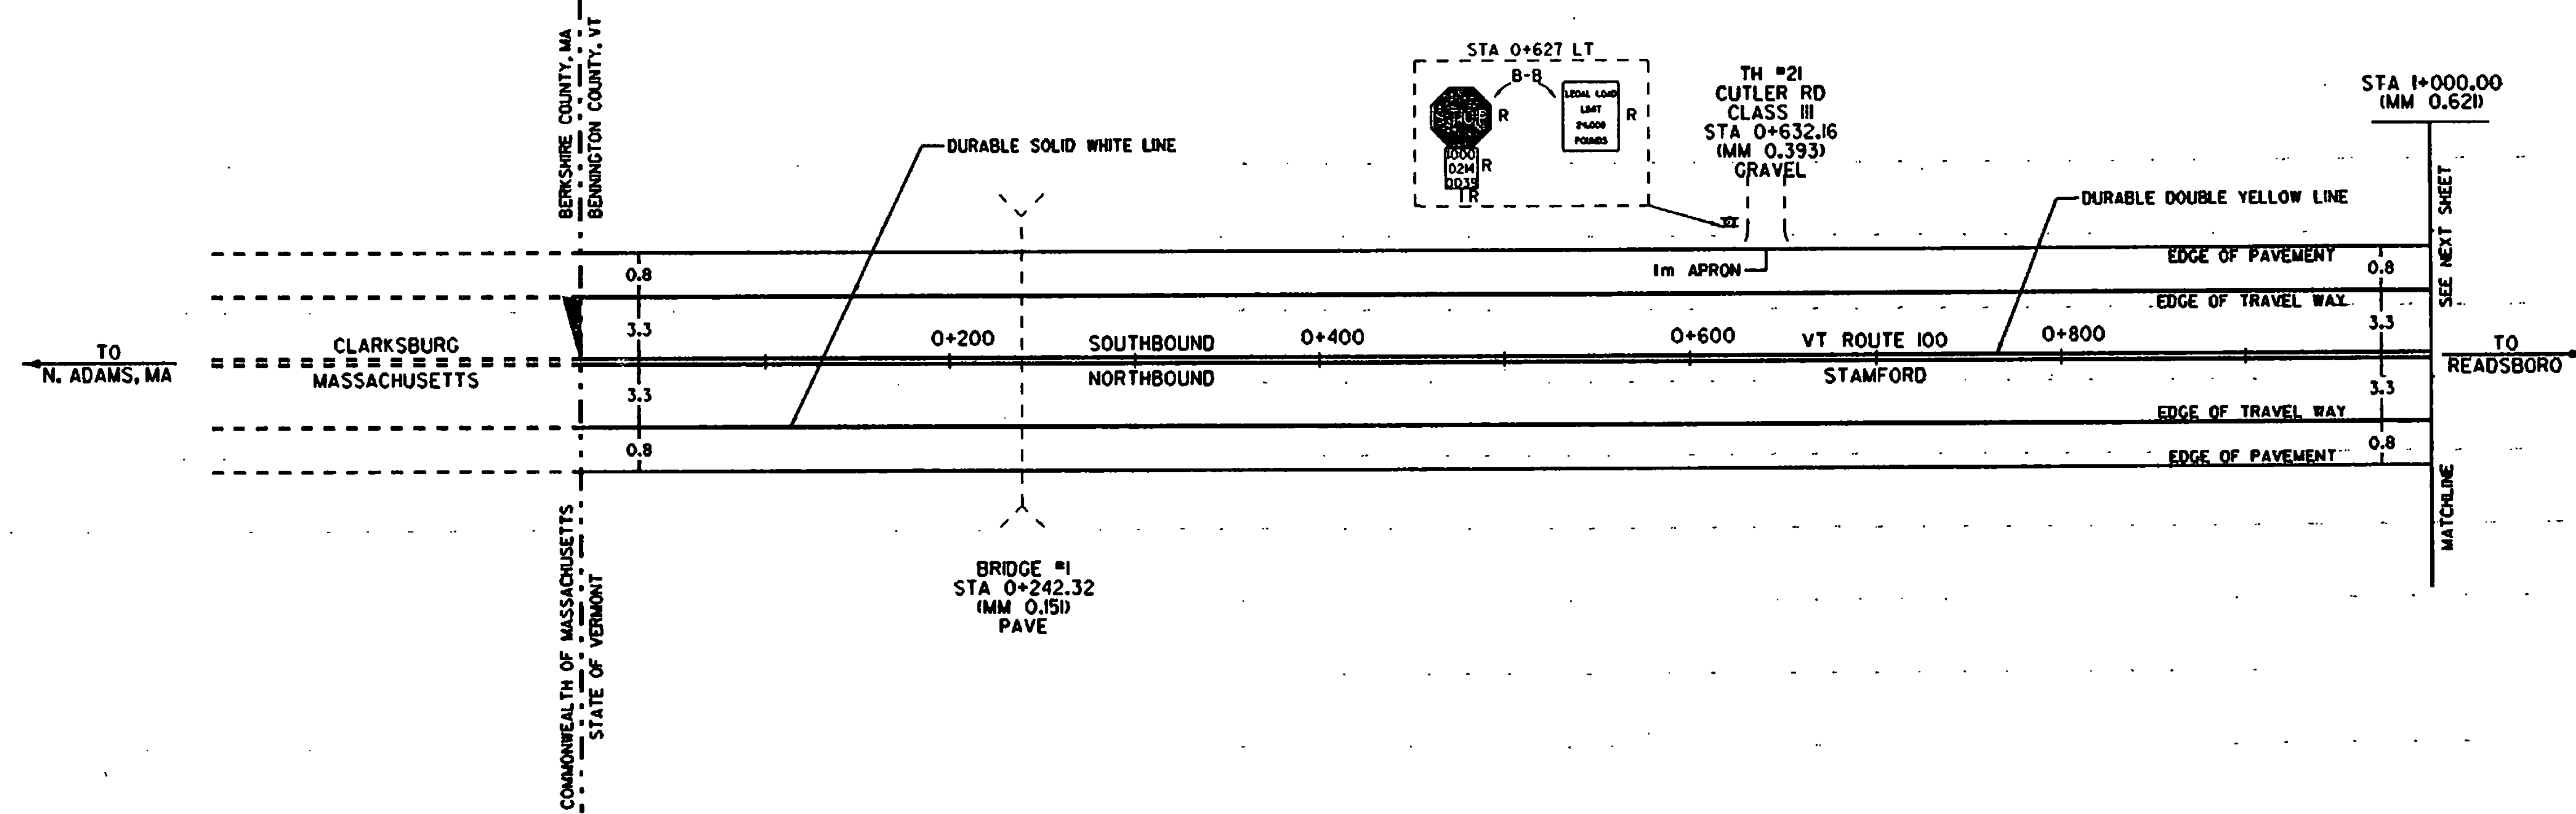

DATUM
 VERTICAL _____
 HORIZONTAL _____

NOT TO SCALE

LEGEND

- R = REMOVE EXISTING
- N = NEW
- RET = RETAIN
- B-B = BACK TO BACK
- R&S = REMOVE & SALVAGE
- S = SALVAGE
- = NEW RAIL
- - - = EXISTING RAIL

**PAVING
 PROJECT
 LAYOUT**

PROJECT:	STAMFORD-READSBORO	PROJECT NO.:	STP 9711(1)S
DESIGN FILE NAME:	Z:\pav\95-020\p-020.dgn	PLOT DATE:	18-MAR-1997
IPARM FILE NAME:	pc-020\011	SURVEY DATE:	2/96
SURVEYED BY:	CLD/lrc	DRAWN BY:	SMC
SQUAD LEADER:	JAW	SHEET:	6 OF 28