


TEMPORARY AND DURABLE 100 mm YELLOW LINE

| | | | | |
|-----------|----|-------|--------|--------------|
| STA 2+200 | TO | 2+269 | DASHED | |
| STA 2+269 | TO | 2+495 | DASHED | LT, SOLID RT |
| STA 2+495 | TO | 2+511 | SOLID | LT & RT |
| STA 2+523 | TO | 2+846 | SOLID | LT & RT |
| STA 2+858 | TO | 2+936 | SOLID | LT & RT |
| STA 2+948 | TO | 3+400 | SOLID | LT & RT |

TEMPORARY AND DURABLE 100 mm WHITE LINE

| | | | | |
|-----------|----|-------|-------|----|
| STA 2+200 | TO | 2+905 | SOLID | RT |
| STA 2+200 | TO | 2+840 | SOLID | LT |
| STA 2+529 | TO | 2+830 | SOLID | RT |
| STA 2+854 | TO | 3+400 | SOLID | RT |
| STA 2+864 | TO | 3+400 | SOLID | LT |

REMOVING SIGNS
AS SHOWN - 9

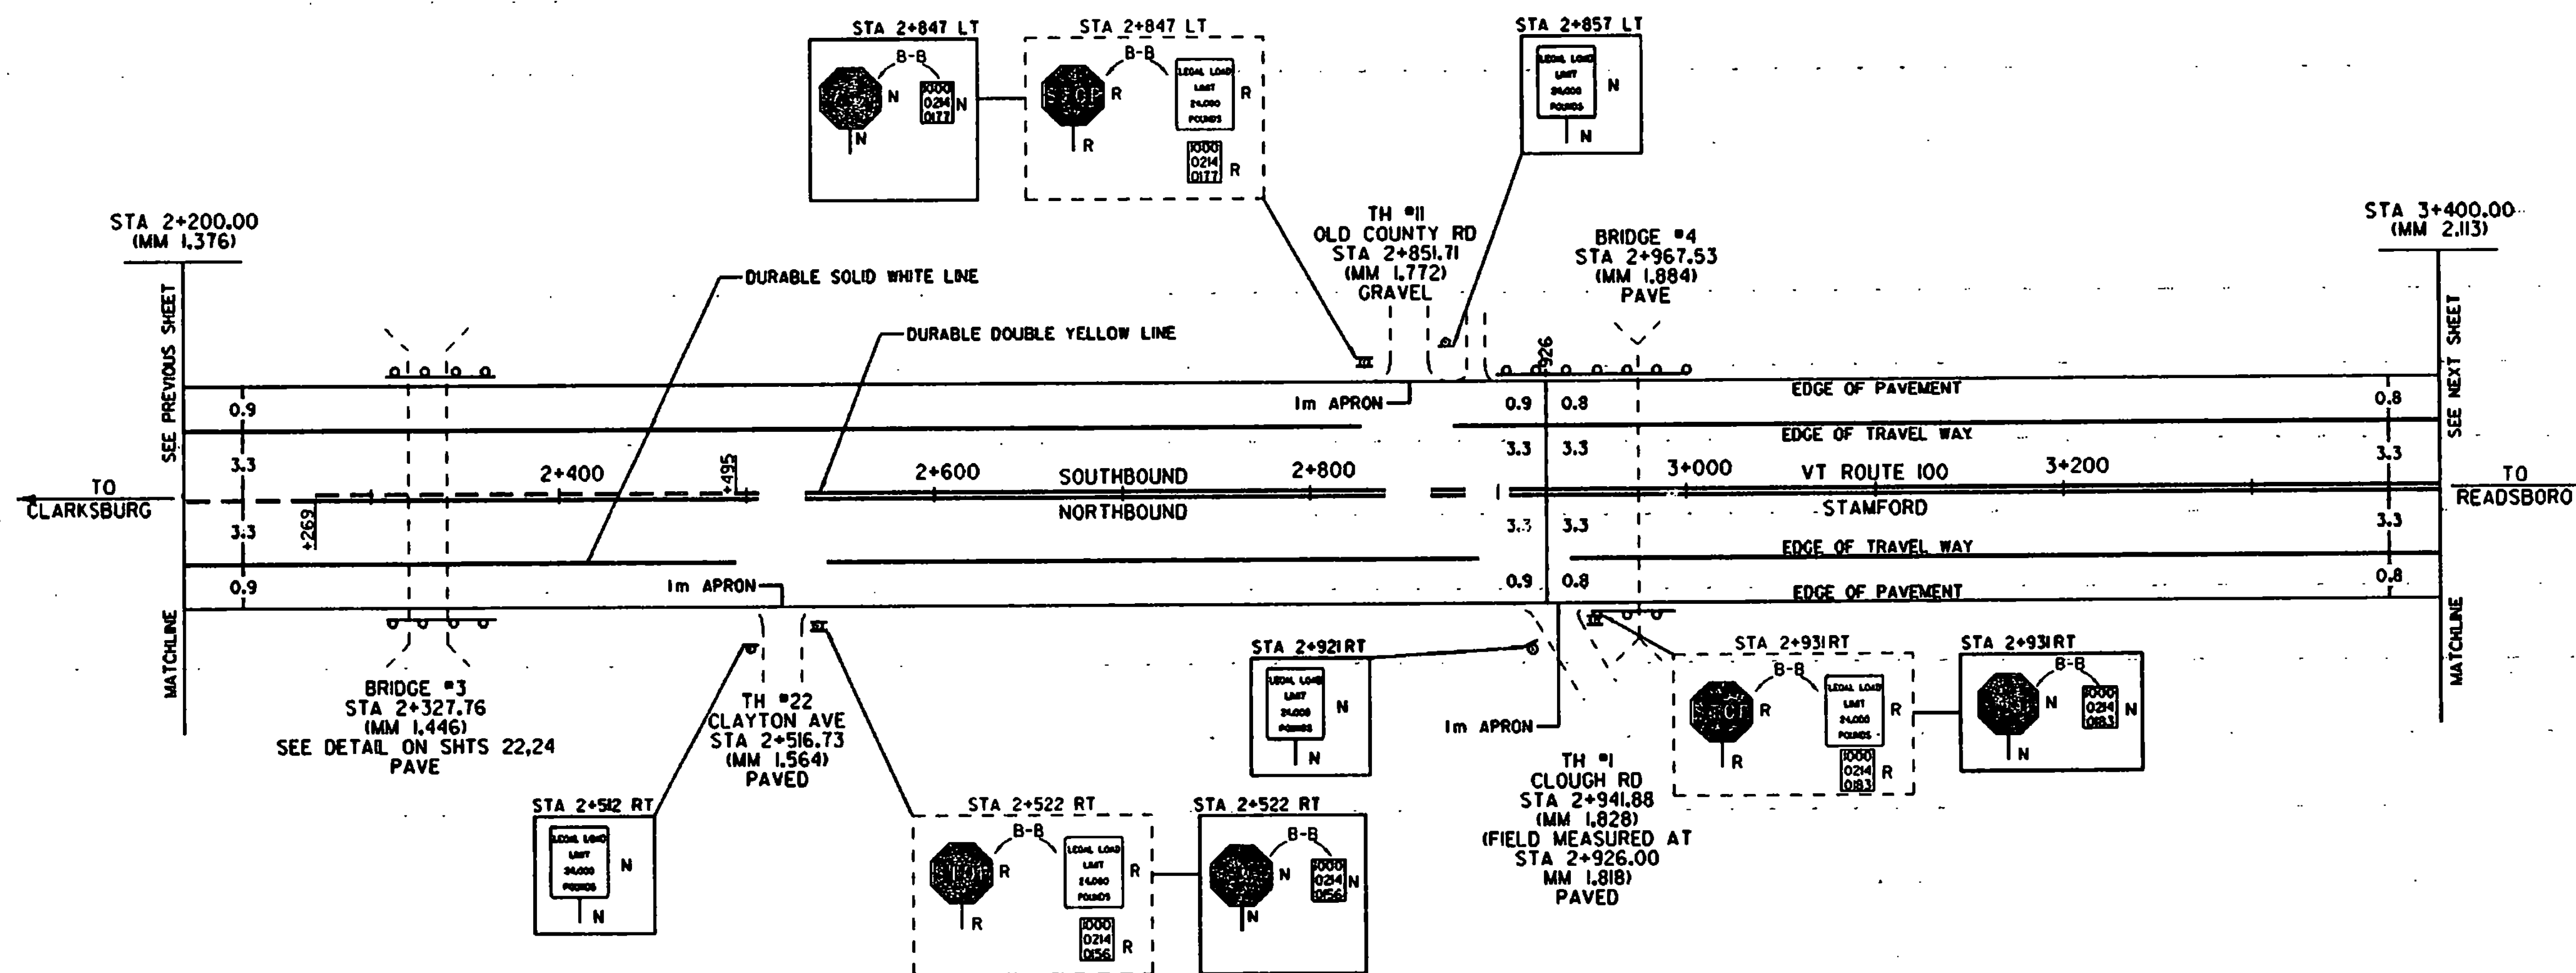

STEEL BEAM GUARDRAIL

| | | | |
|-----------|----|-------|----|
| STA 2+915 | TO | 3+002 | LT |
| STA 2+965 | TO | 2+977 | RT |

REMOVAL & DISP. OF GUARDRAIL

| | | | |
|-----------|----|-------|----|
| STA 2+963 | TO | 2+973 | LT |
| STA 2+965 | TO | 2+975 | RT |

REMOVAL & DISP. OF GUIDE POSTS

| | | | |
|-----------|----|-------|----|
| STA 2+961 | TO | 3+007 | LT |
| STA 2+976 | TO | | RT |

MODIFIED ECCENTRIC LOADER TERMINAL

| | |
|-----------|----|
| STA 2+915 | LT |
| STA 3+002 | LT |
| STA 2+965 | RT |
| STA 2+977 | RT |

LEGEND

- R = REMOVE EXISTING
- N = NEW
- RET = RETAIN
- B-B = BACK TO BACK
- R&S = REMOVE & SALVAGE
- S = SALVAGE
- = NEW RAIL
- ⌊ — ⌋ = EXISTING RAIL

NOT TO SCALE

PAVING PROJECT LAYOUT

| | |
|--|---------------------------|
| PROJECT: STAMFORD-READSBORO | PROJECT NO.: STP 9711111S |
| DESIGN FILE NAME: \pave\36c020\ac020.dgn | PLOT DATE: 24-MAR-1997 |
| PARM FILE NAME: ac020031 | SURVEY DATE: 2/96 |
| SURVEYED BY: G.O. JVC | DRAWN BY: SMC |
| SQUAD LEADER: JAW | SHEET: 8 OF 28 |

DATUM

| | |
|------------|-------|
| VERTICAL | _____ |
| HORIZONTAL | _____ |