

TEMPORARY AND DURABLE 100 mm YELLOW LINE


STA 3+400 TO 3+588	SOLID LT & RT
STA 3+600 TO 3+677	SOLID LT & RT
STA 3+677 TO 3+906	DASHED LT, SOLID RT
STA 3+906 TO 4+170	SOLID LT & RT
STA 4+182 TO 4+353	SOLID LT & RT
STA 4+365 TO 4+370	SOLID LT & RT
STA 4+370 TO 4+499	SOLID LT, DASHED RT
STA 4+499 TO 4+600	DASHED

TEMPORARY AND DURABLE 100 mm WHITE LINE

STA 3+400 TO 4+164	SOLID LT
STA 3+400 TO 3+582	SOLID RT
STA 3+606 TO 4+600	SOLID RT
STA 4+188 TO 4+347	SOLID LT
STA 4+371 TO 4+600	SOLID LT

REMOVING SIGNS
AS SHOWN - 9

ERECTING SALVAGED SIGNS
AS SHOWN - 1

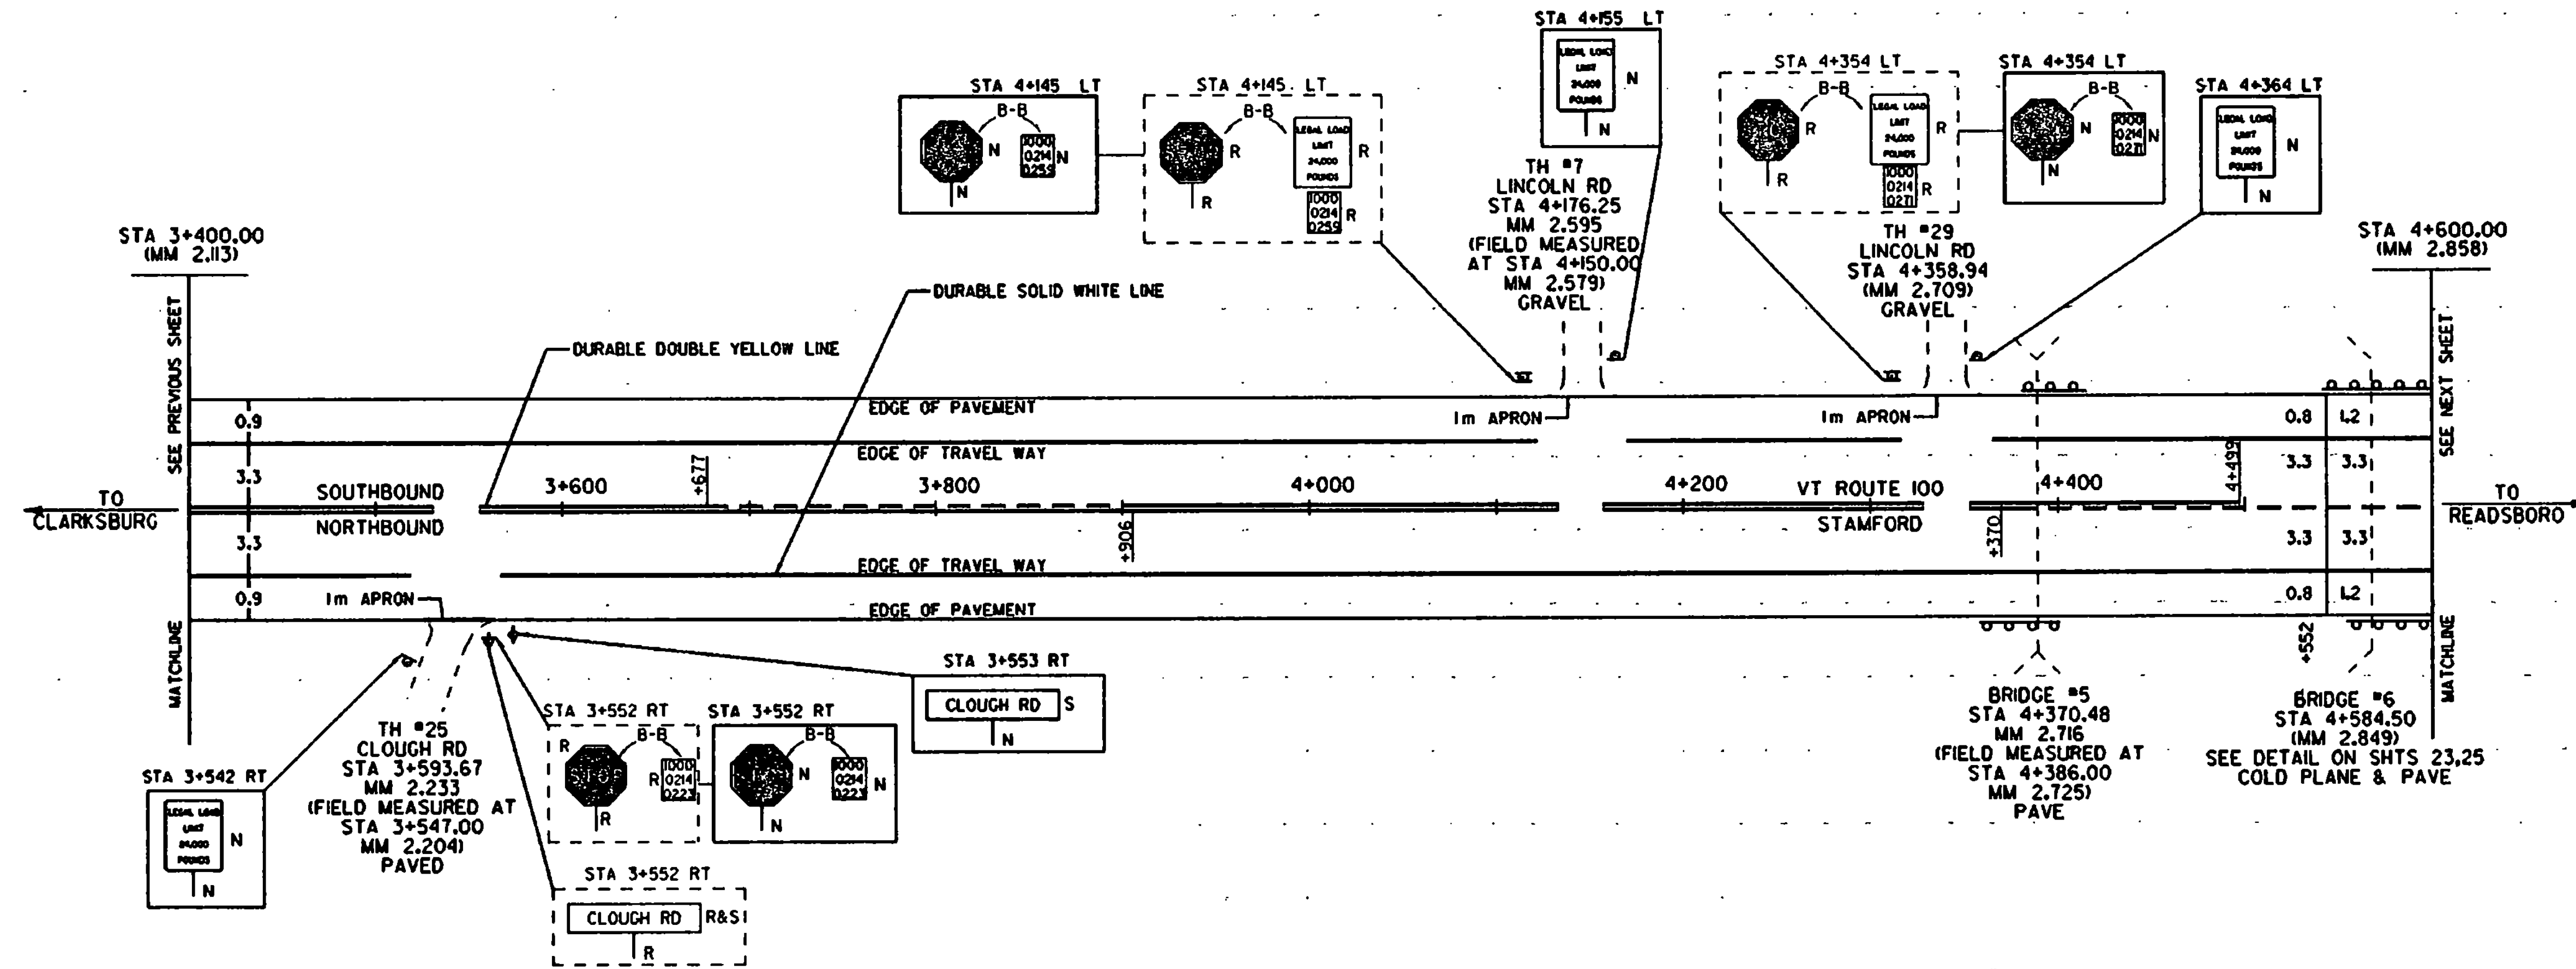

STEEL BEAM GUARDRAIL

STA 4+376 TO 4+395	RT
STA 4+376 TO 4+384	LT

REMOVAL & DISP. OF GUARDRAIL

STA 4+379 TO 4+390	LT
STA 4+377 TO 4+390	RT

REMOVAL & DISP. OF GUIDE POSTS

STA 3+436 TO 3+507	RT
STA 4+344 TO 4+359	RT

MODIFIED ECCENTRIC LOADER TERMINAL

STA 4+376	LT
STA 4+384	LT

ANCHOR FOR STEEL BEAM RAIL

STA 4+376	RT
STA 4+398	RT

LEGEND

- R = REMOVE EXISTING
- N = NEW
- RET = RETAIN
- B-B = BACK TO BACK
- R&S = REMOVE & SALVAGE
- S = SALVAGE
- - - = NEW RAIL
- - - = EXISTING RAIL

NOT TO SCALE

PAVING PROJECT LAYOUT

PROJECT: STAMFORD-READSBORO	PROJECT NO.: STP 9711(1)S
DESIGN FILE NAME: J:\pav/96c020/pc020.dgn	PLOT DATE: 24-MAR-1997
PARM FILE NAME: pc02004.d	SURVEY DATE: 2/96
SURVEYED BY: ELO/ine	DRAWN BY: SMC
SQUAD LEADER: JAW	SHEET: 9 OF 28

DATE:	_____
VERTICAL:	_____
HORIZONTAL:	_____