




TEMPORARY AND DURABLE 100 mm YELLOW LINE
STA 0+200 TO 1+400 SOLID LT & RT

TEMPORARY AND DURABLE 100 mm WHITE LINE
STA 0+200 TO 1+400 SOLID LT & RT

CHANGING ELEV. OF DL CB OR MH
REHABILITATION OF DL CB OR MH CLASS I
REHABILITATION OF DL CB OR MH CLASS II
REHABILITATION OF DL CB OR MH CLASS III
STA 0+853 LT - GRATE TYPE D
STA 0+866 LT - GRATE TYPE D
STA 1+034 LT - GRATE TYPE D

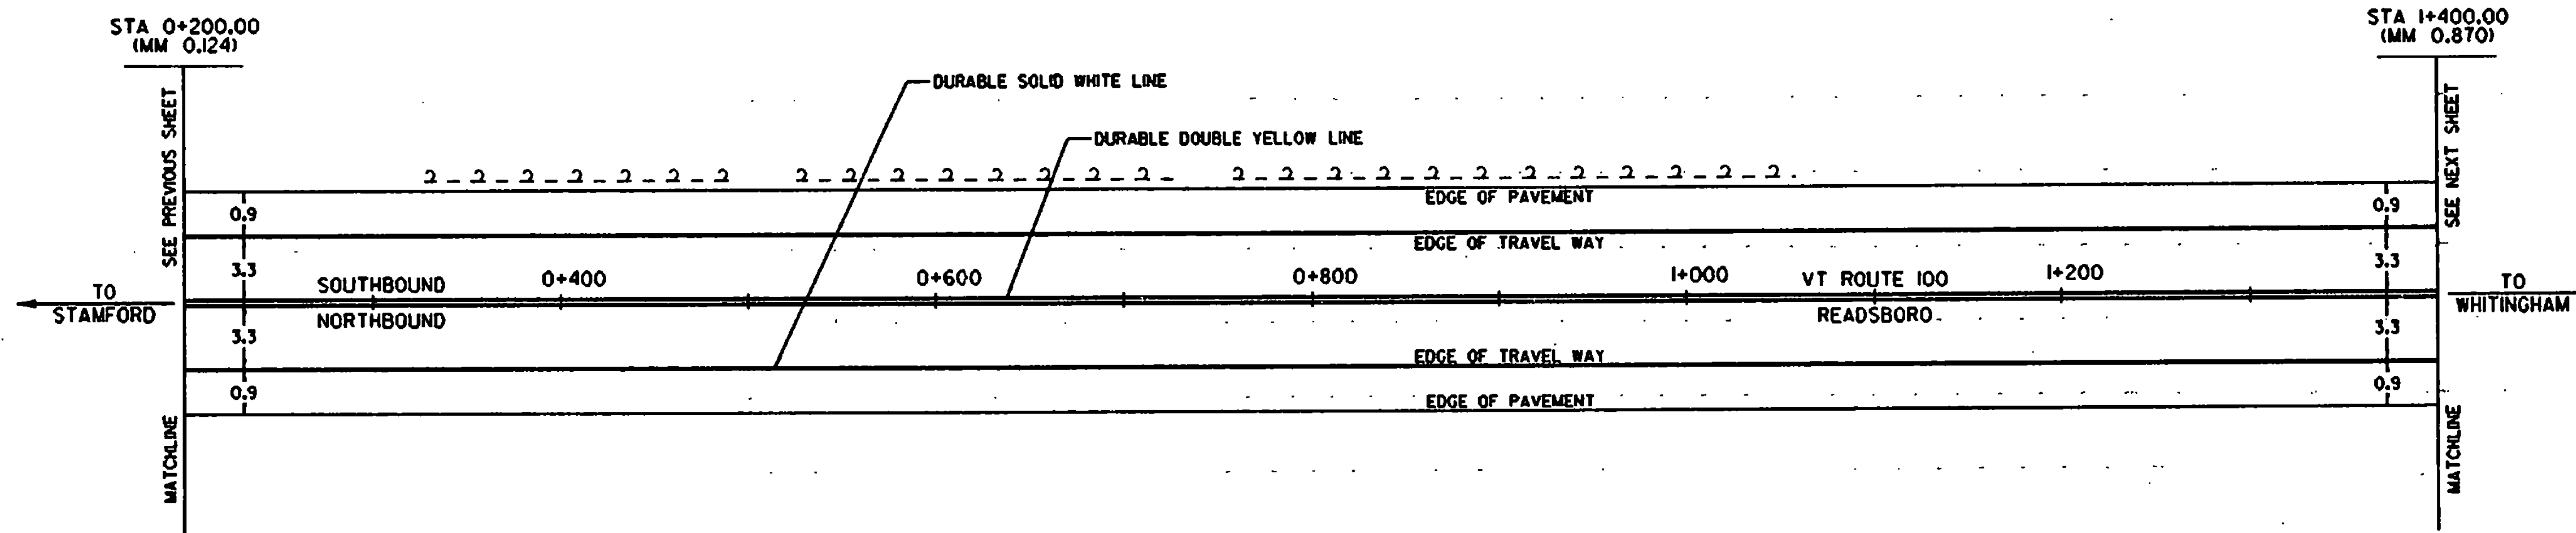

DATUM
 VERTICAL _____
 HORIZONTAL _____

NOT TO SCALE

LEGEND

- R = REMOVE EXISTING
- N = NEW
- RET = RETAIN
- B-B = BACK TO BACK
- R&S = REMOVE & SALVAGE
- S = SALVAGE
- = NEW RAIL
- - - = EXISTING RAIL

**PAVING
PROJECT
LAYOUT**

PROJECT:	STAMFORD-READSBORO	PROJECT NO.:	STP 9711(1)S
DESIGN FILE NAME:	../dave/96c020/nc020.dgn	PLOT DATE:	24-MAR-1997
PARM FILE NAME:	nc02003.l	SURVEY DATE:	2/96
SURVEYED BY:	CLQ, Inc.	DRAWN BY:	SAC
SQUAD LEADER:	JAN	SHEET:	14 OF 28

: Sheet Number: