

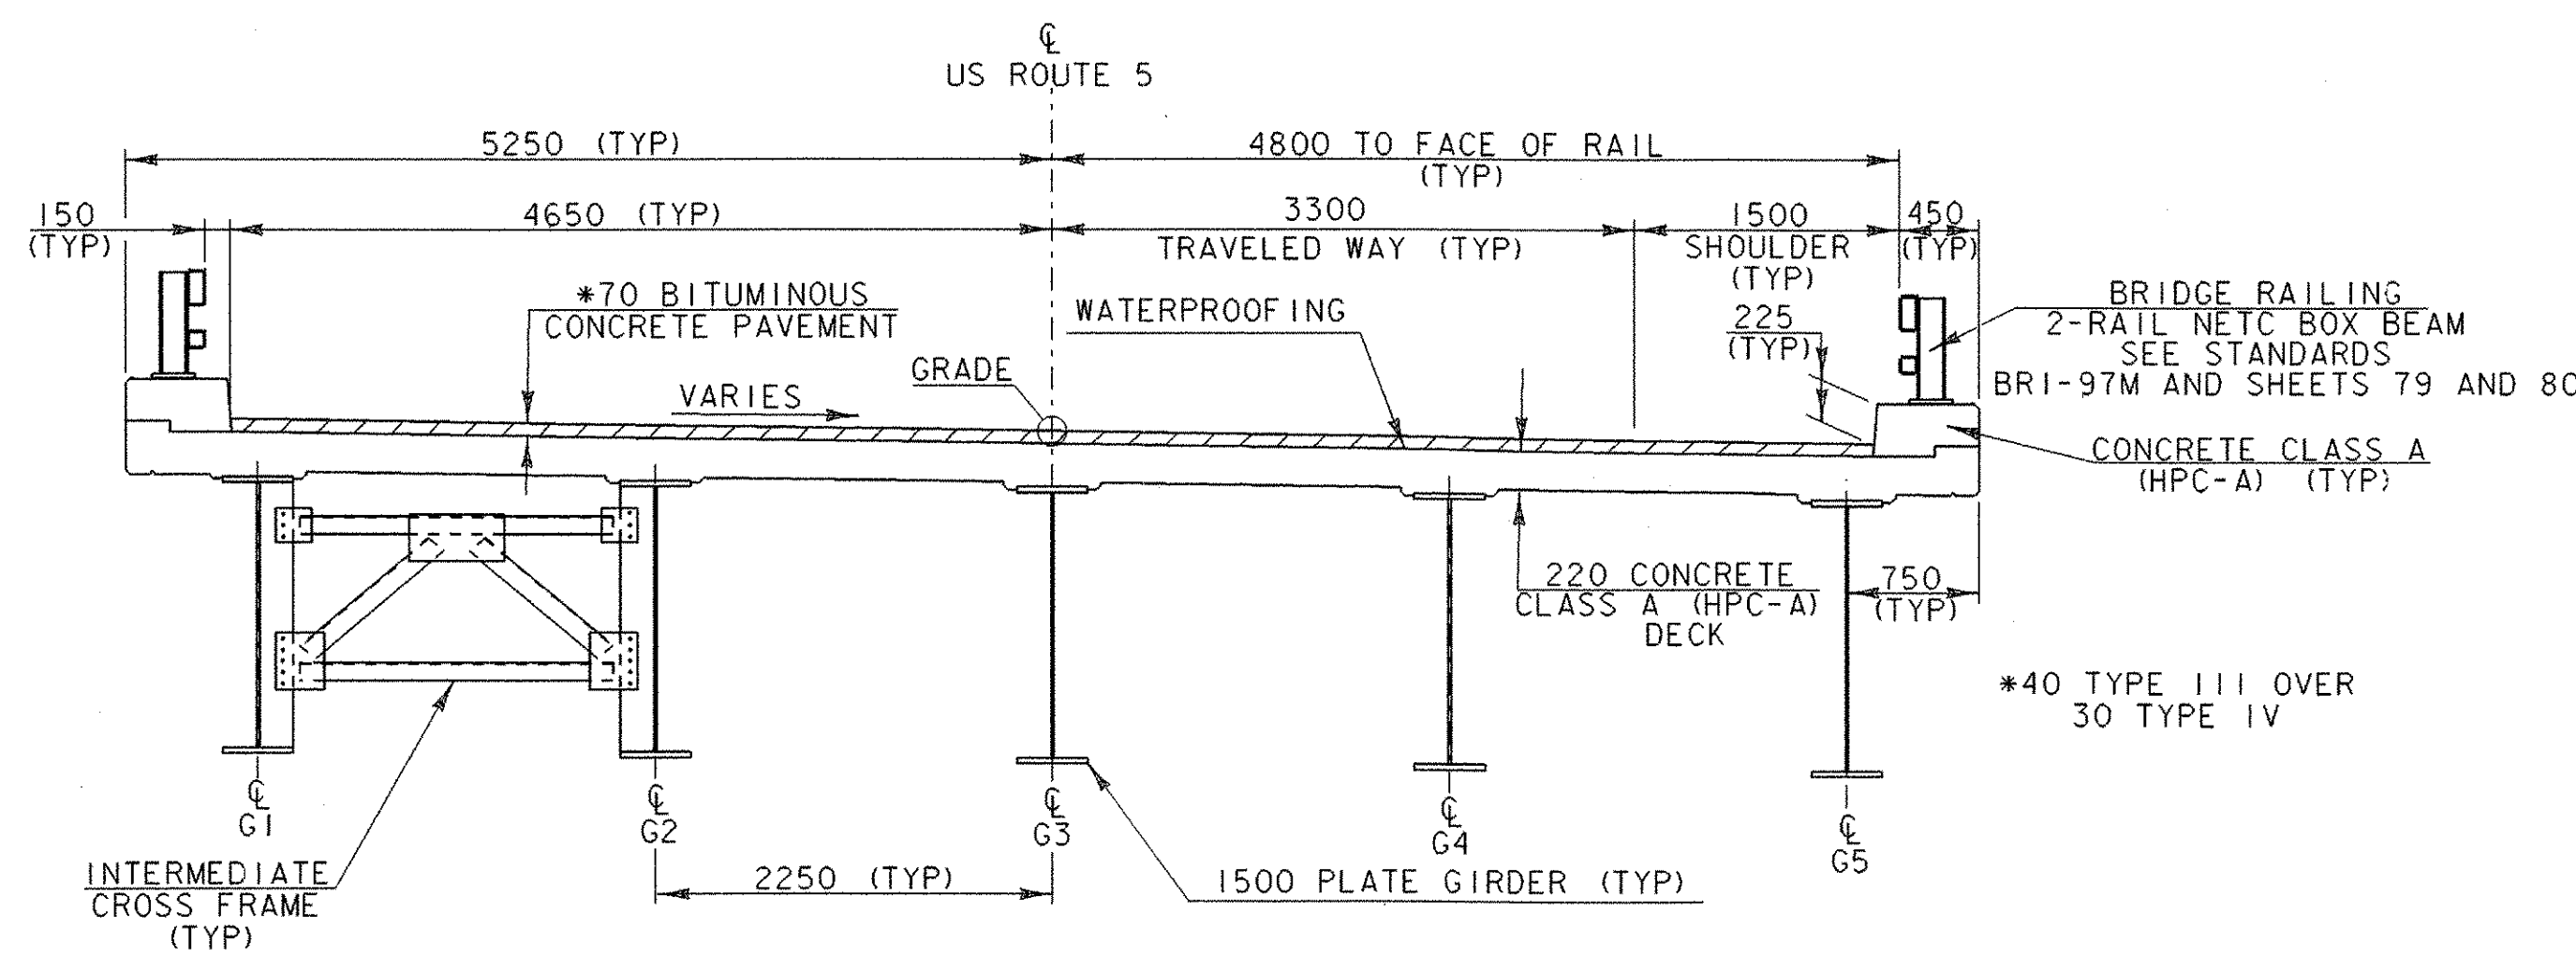
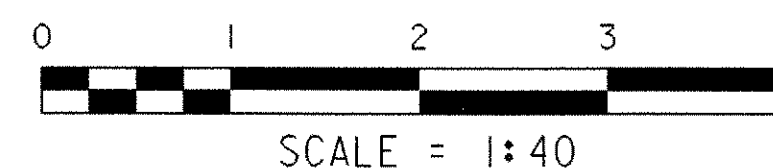



US 5 TYPICAL ROADWAY SECTION

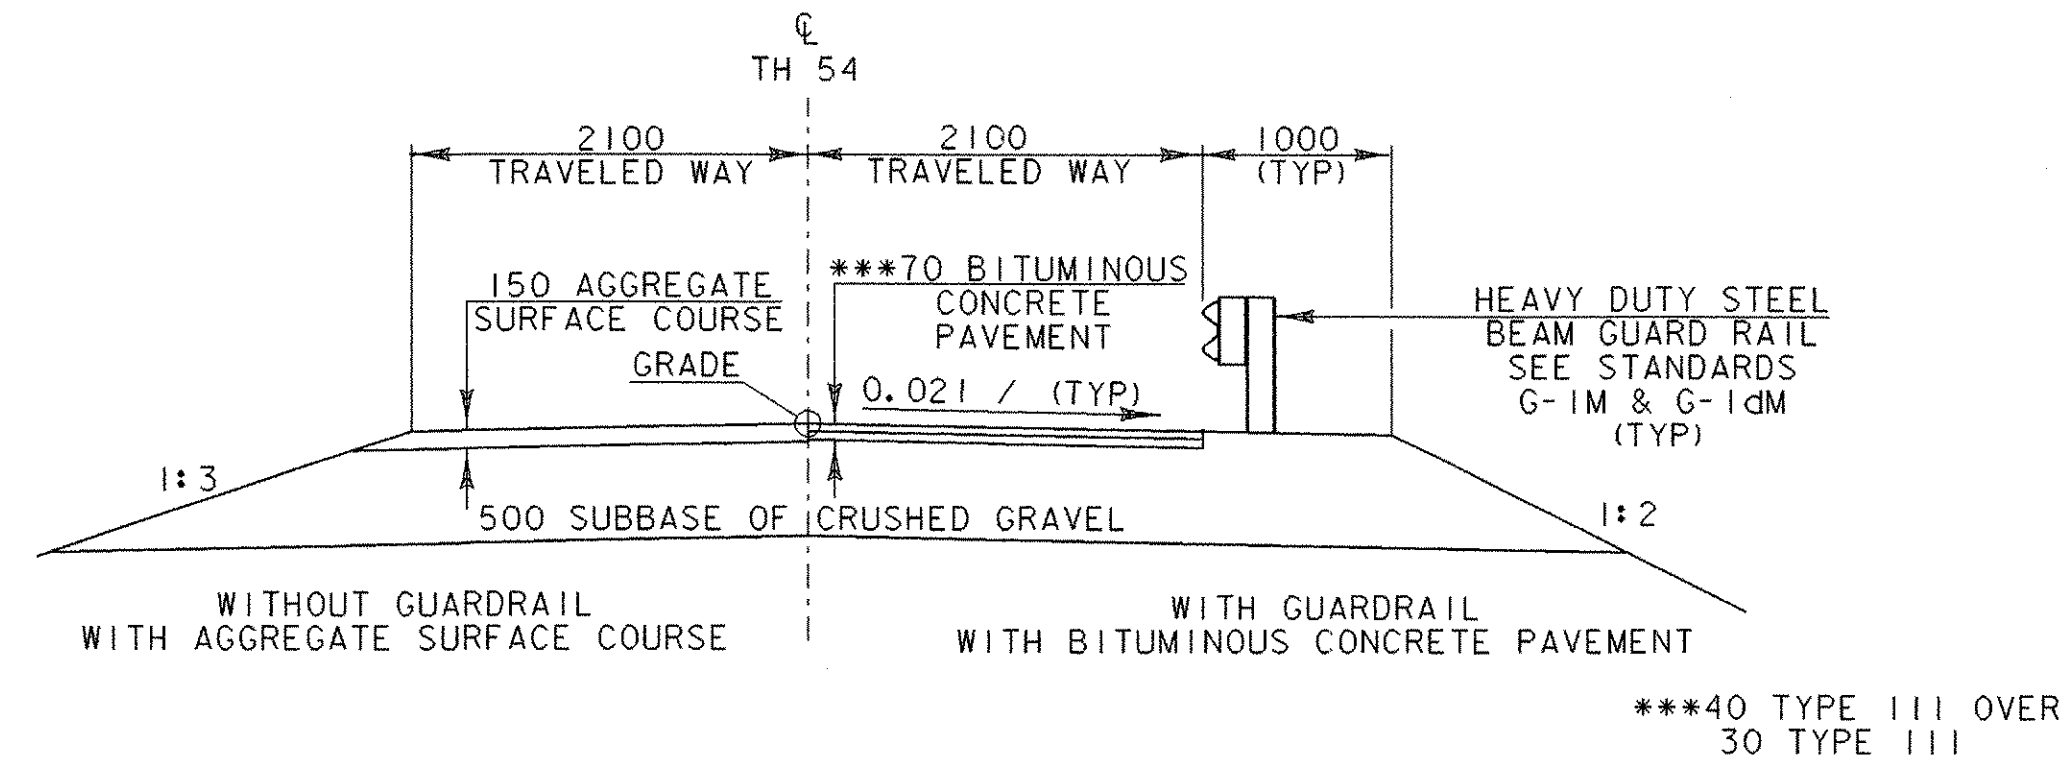

TYPICAL BRIDGE SECTION

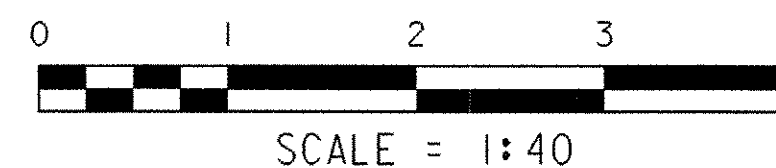

TH 54 TYPICAL ROADWAY SECTION

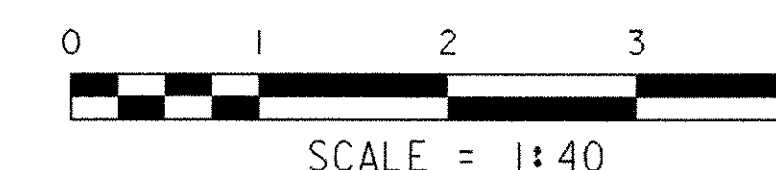

MATERIAL ITEM	TOLERANCE
PAVEMENT	±5 mm TOTAL THICKNESS
AGGREGATE SURFACE COURSE	± 10 mm
BASE COURSE	± 10 mm
SUBBASE	± 30 mm
SAND BORROW	± 30 mm
GRANULAR BORROW	± 30 mm

STATE OF VERMONT AGENCY OF TRANSPORTATION	
Town Of BARTON	Bridge No. 161
Highway No. US ROUTE 5	Log Sta.
US ROUTE 5 OVER NORTHERN VERMONT RAILROAD	
TYPICAL SECTIONS	
Designed By W.B. SYMONDS	Drawn By P.G. JARVIS
Checked By W.B. SYMONDS	Date 12/98
Bridge Design Supervisor C.P. WILLIAMS Date 12/98	
PROJECT BARTON	PROJECT NO. STP 0113 (58) S
I.G.C. Info. 96c116/structures/sc116typ.dgn sc116typ.i	
Bridge Sheet No.	Sheet 3 of 120