


MATCH LINE STA 1+565

APPROXIMATE AERIAL RELOCATION
ROUTE BY BARTON VILLAGE, INC. AND
NEW ENGLAND TELEPHONE & TELEGRAPH CO.

BENCHMARK #4
DISK IN LEDGE
P54 1978 (NGS)
ELEV = 316.524

0050
1002
0420 RET

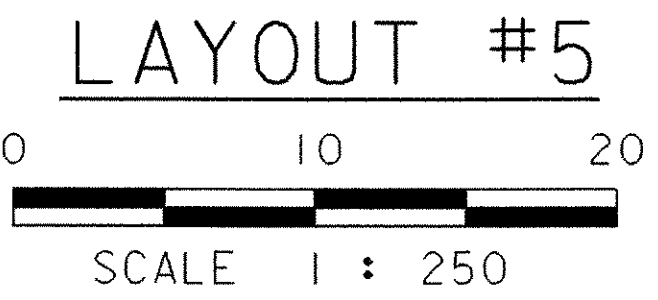

LEGEND
ALL SIGNS AND POSTS WILL BE
NEW UNLESS OTHERWISE NOTED:

- R - REMOVE
- R&S - REMOVE & SALVAGE
- S - SALVAGE
- RET - RETAIN

SEE SHEET 46
FOR DRAINAGE DETAILS

SEE SHEET 48 FOR
SIGN SUMMARY

DATUM

VERTICAL	NAVD 88
HORIZONTAL	NAD 83 (93)

PROJECT:	BARTON	PROJECT NO. :	STP 0113 (58) S
DESIGN FILE NAME:	96c116/structures/sc116bdr.dgn	PLOT DATE:	03-JAN-2002
IPARM FILE NAME:	sc1161a5.i	SURVEY DATE:	8/96,5/99
SURVEYED BY:	R. BULLOCK, R. GILMAN	DRAWN BY:	P.C. JARVIS
SQUAD LEADER:	C.P. WILLIAMS	LAYOUT #5	SHEET: 13 OF 120