


PROFILE AND BANKING DIAGRAM US ROUTE 5

NOTE: EXISTING CENTERLINE ELEVATIONS ARE SHOWN TO THE HUNDREDTH.
PROPOSED CENTERLINE ELEVATIONS ARE SHOWN TO THE THOUSANDTH.

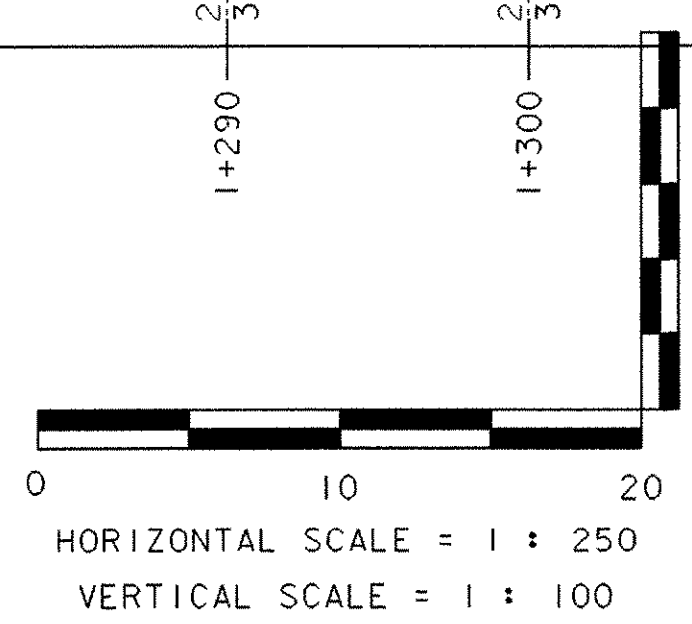

DATUM	
VERTICAL	NAVD 88
HORIZONTAL	NAD 83 (93)

PROJECT:	BARTON	PROJECT NO. :	STP 0113 (58) S
DESIGN FILE NAME:	96c116/structures/sc116bdr.dgn	PLOT DATE:	03-JAN-2002
IPARM FILE NAME:	sc116pr2.i	SURVEY DATE:	8/96,5/99
SURVEYED BY:	R. BULLOCK, R. GILMAN	DRAWN BY:	P.G. JARVIS
SQUAD LEADER:	C.P. WILLIAMS	SHEET:	15 OF 120
PROFILE #2	US ROUTE 5		