


NOTE: EXISTING CENTERLINE ELEVATIONS ARE SHOWN TO THE HUNDREDTH.
 PROPOSED CENTERLINE ELEVATIONS ARE SHOWN TO THE THOUSANDTH.

PROFILE AND BANKING DIAGRAM US ROUTE 5

DATUM
 VERTICAL NAVD 88
 HORIZONTAL NAD 83 (93)

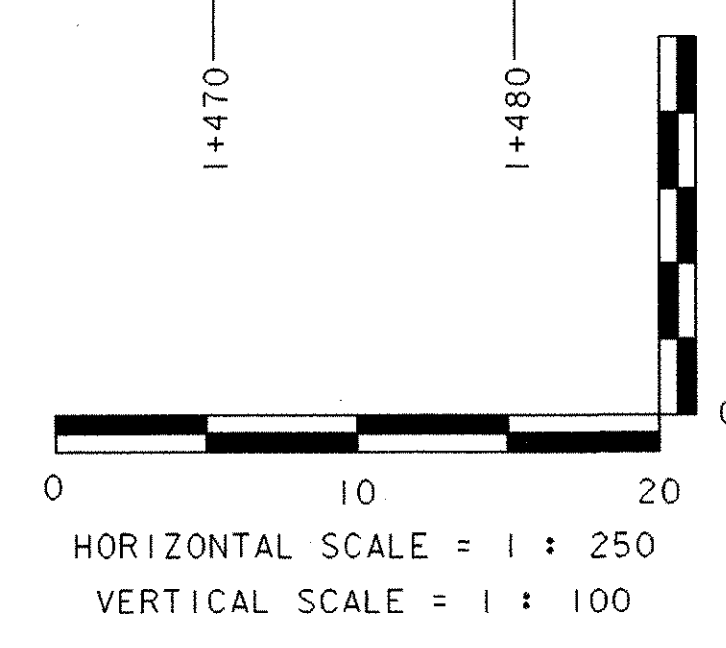

| | |
|--|---|
| PROJECT: BARTON | PROJECT NO. : STP 0113 (58) S |
| DESIGN FILE NAME: 96c116/structures/sc116bdr.dgn | PLOT DATE: 03-JAN-2002 |
| IPARM FILE NAME: sc116pr3.i | SURVEY DATE: 8/96,5/99 |
| SURVEYED BY: R. BULLOCK, R. GILMAN | DRAWN BY: P.G. JARVIS |
| SQUAD LEADER: C.P. WILLIAMS | SHEET: 16 OF 120 |
| PROFILE #3 US ROUTE 5 | |