


### TH 54 PROFILE

NOTE: EXISTING CENTERLINE ELEVATIONS ARE SHOWN TO THE HUNDREDS  
 PROPOSED CENTERLINE ELEVATIONS ARE SHOWN TO THE THOUSANDTH

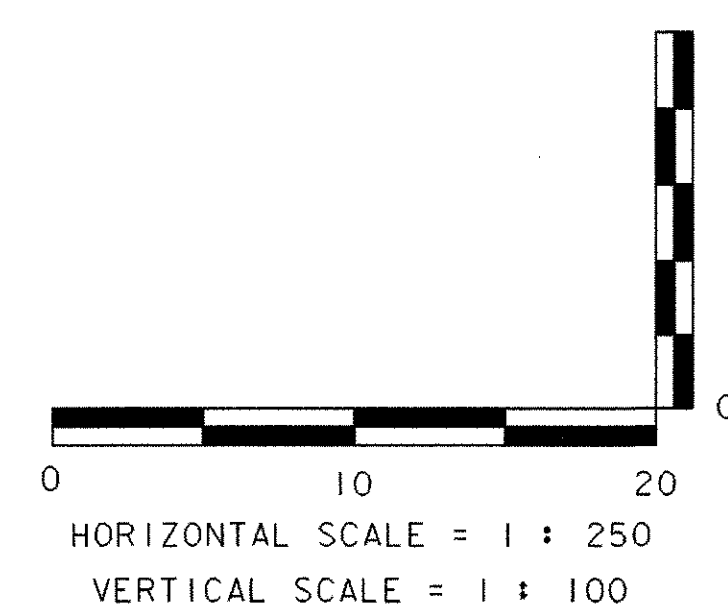

DATUM	
VERTICAL	NAVD 88
HORIZONTAL	NAD 83 (93)

PROJECT:	BARTON	PROJECT NO.:	STP 0113(58)S
DESIGN FILE NAME:	96cll6/structures/sc1l6+54.dgn	PLOT DATE:	03-JAN-2002
IPARM FILE NAME:	sc1l6p54.i	SURVEY DATE:	08/96,05/99
SURVEYED BY:	R. BULLOCK, R. GILMAN	DRAWN BY:	M. CERUTTI
SQUAD LEADER:	C.P. WILLIAMS	SHEET:	18 OF 120
TH 54 PROFILE			