

REMOVAL OF EXISTING PAVEMENT MARKINGS
STA. 1+185 RT - STA. 1+235 RT


TEMPORARY 100mm WHITE LINE
STA. 1+130 RT - STA. 1+235 RT (2)

TEMPORARY SHEET PILING
STA. 1+130 RT - STA. 1+235 RT

TEMPORARY TRAFFIC BARRIER
STA. 1+130 RT - STA. 1+235 RT

APPROXIMATE AERIAL RELOCATION
ROUTE BY BARTON VILLAGE, INC. AND
NEW ENGLAND TELEPHONE & TELEGRAPH CO.

**PHASE 2
DETOUR LAYOUT #2**

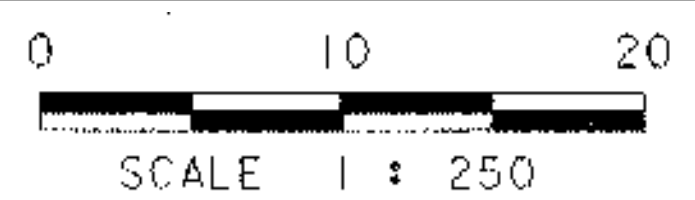

LEGEND	
	- SIGN POSTS
	- TYPE III BARRICADES (MOD.)
	- TEMP. TRAFFIC BARRIER
	- LUMINAIRE
	- STRAIN POLE
	- SIGNAL HEAD
	- ENERGY ABSORTION ATTENUATOR
	- TEMPORARY SHEET PILING
	- REFLECTORIZED BARREL
	- PAVEMENT MARKING REMOVAL

**ARCHIVED
ON CADD**

DATUM	
VERTICAL	NAVD 88
HORIZONTAL	NAD 83 (93)

PROJECT:	BARTON	PROJECT NO. :	STP 0113 (58) S
DESIGN FILE NAME:	96cl16/structures/sc116bdr.dgn	PLOT DATE:	03-JAN-2002
IPARM FILE NAME:	sc116det2.i	SURVEY DATE:	8/96,5/99
SURVEYED BY:	R. BULLOCK, R. GILMAN	DRAWN BY:	D.G. BASSETT
SQUAD LEADER:	C.P. WILLIAMS	SHEET:	22 OF 120
DETOUR LAYOUT #2 (PHASE2)			