


APPROXIMATE AERIAL RELOCATION
ROUTE BY BARTON VILLAGE, INC. AND
NEW ENGLAND TELEPHONE & TELEGRAPH CO.

TEMPORARY 100mm YELLOW LINE
STA. 1+565 @ - STA. 1+1+580 @ (DOUBLE)

- LEGEND
- SIGN POSTS
 - TYPE III BARRICADES (MOD.)
 - TEMP. TRAFFIC BARRIER
 - LUMINARE
 - STRAIN POLE
 - SIGNAL HEAD
 - ENERGY ABSORPTION ATTENUATOR
 - TEMPORARY SHEET PILING
 - REFLECTORIZED BARREL
 - PAVEMENT MARKING REMOVAL

PHASE 2
DETOUR LAYOUT #5

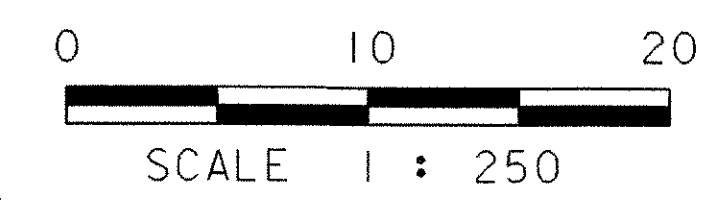

DATUM	
VERTICAL	NAVD 88
HORIZONTAL	NAD 83 (93)

PROJECT:	BARTON	PROJECT NO. :	STP 0113 (58) S
DESIGN FILE NAME:	96c116/structures/sc116bdr.dgn	PLOT DATE:	03-JAN-2002
IPARM FILE NAME:	sc116det5.i	SURVEY DATE:	8/96,5/99
SURVEYED BY:	R. BULLOCK, R. GILMAN	DRAWN BY:	D.G. BASSETT
SQUAD LEADER:	C.P. WILLIAMS		
DETOUR LAYOUT #5 (PHASE 2)		SHEET:	25 OF 120