


APPROXIMATE AERIAL RELOCATION
ROUTE BY BARTON VILLAGE, INC. AND
NEW ENGLAND TELEPHONE & TELEGRAPH CO.

LEGEND	
	HAY BALES
	SILT FENCE

EROSION CONTROL LAYOUT #5

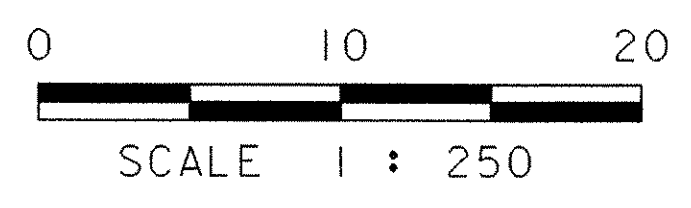

DATUM	
VERTICAL	NAVD 88
HORIZONTAL	NAD 83 (93)

PROJECT:	BARTON	PROJECT NO. :	STP 0113 (58) S
DESIGN FILE NAME:	96c116/structures/sc116bdr.dgn	PLOT DATE:	03-JAN-2002
IPARM FILE NAME:	sc116ec5.i	SURVEY DATE:	8/96,5/99
SURVEYED BY:	R. BULLOCK, R. GILMAN	DRAWN BY:	P.G. JARVIS
SQUAD LEADER:	C.P. WILLIAMS	EROSION CONTROL LAYOUT #5	SHEET: 42 OF 120