


# Profile Pipe @ STA 1+063.000

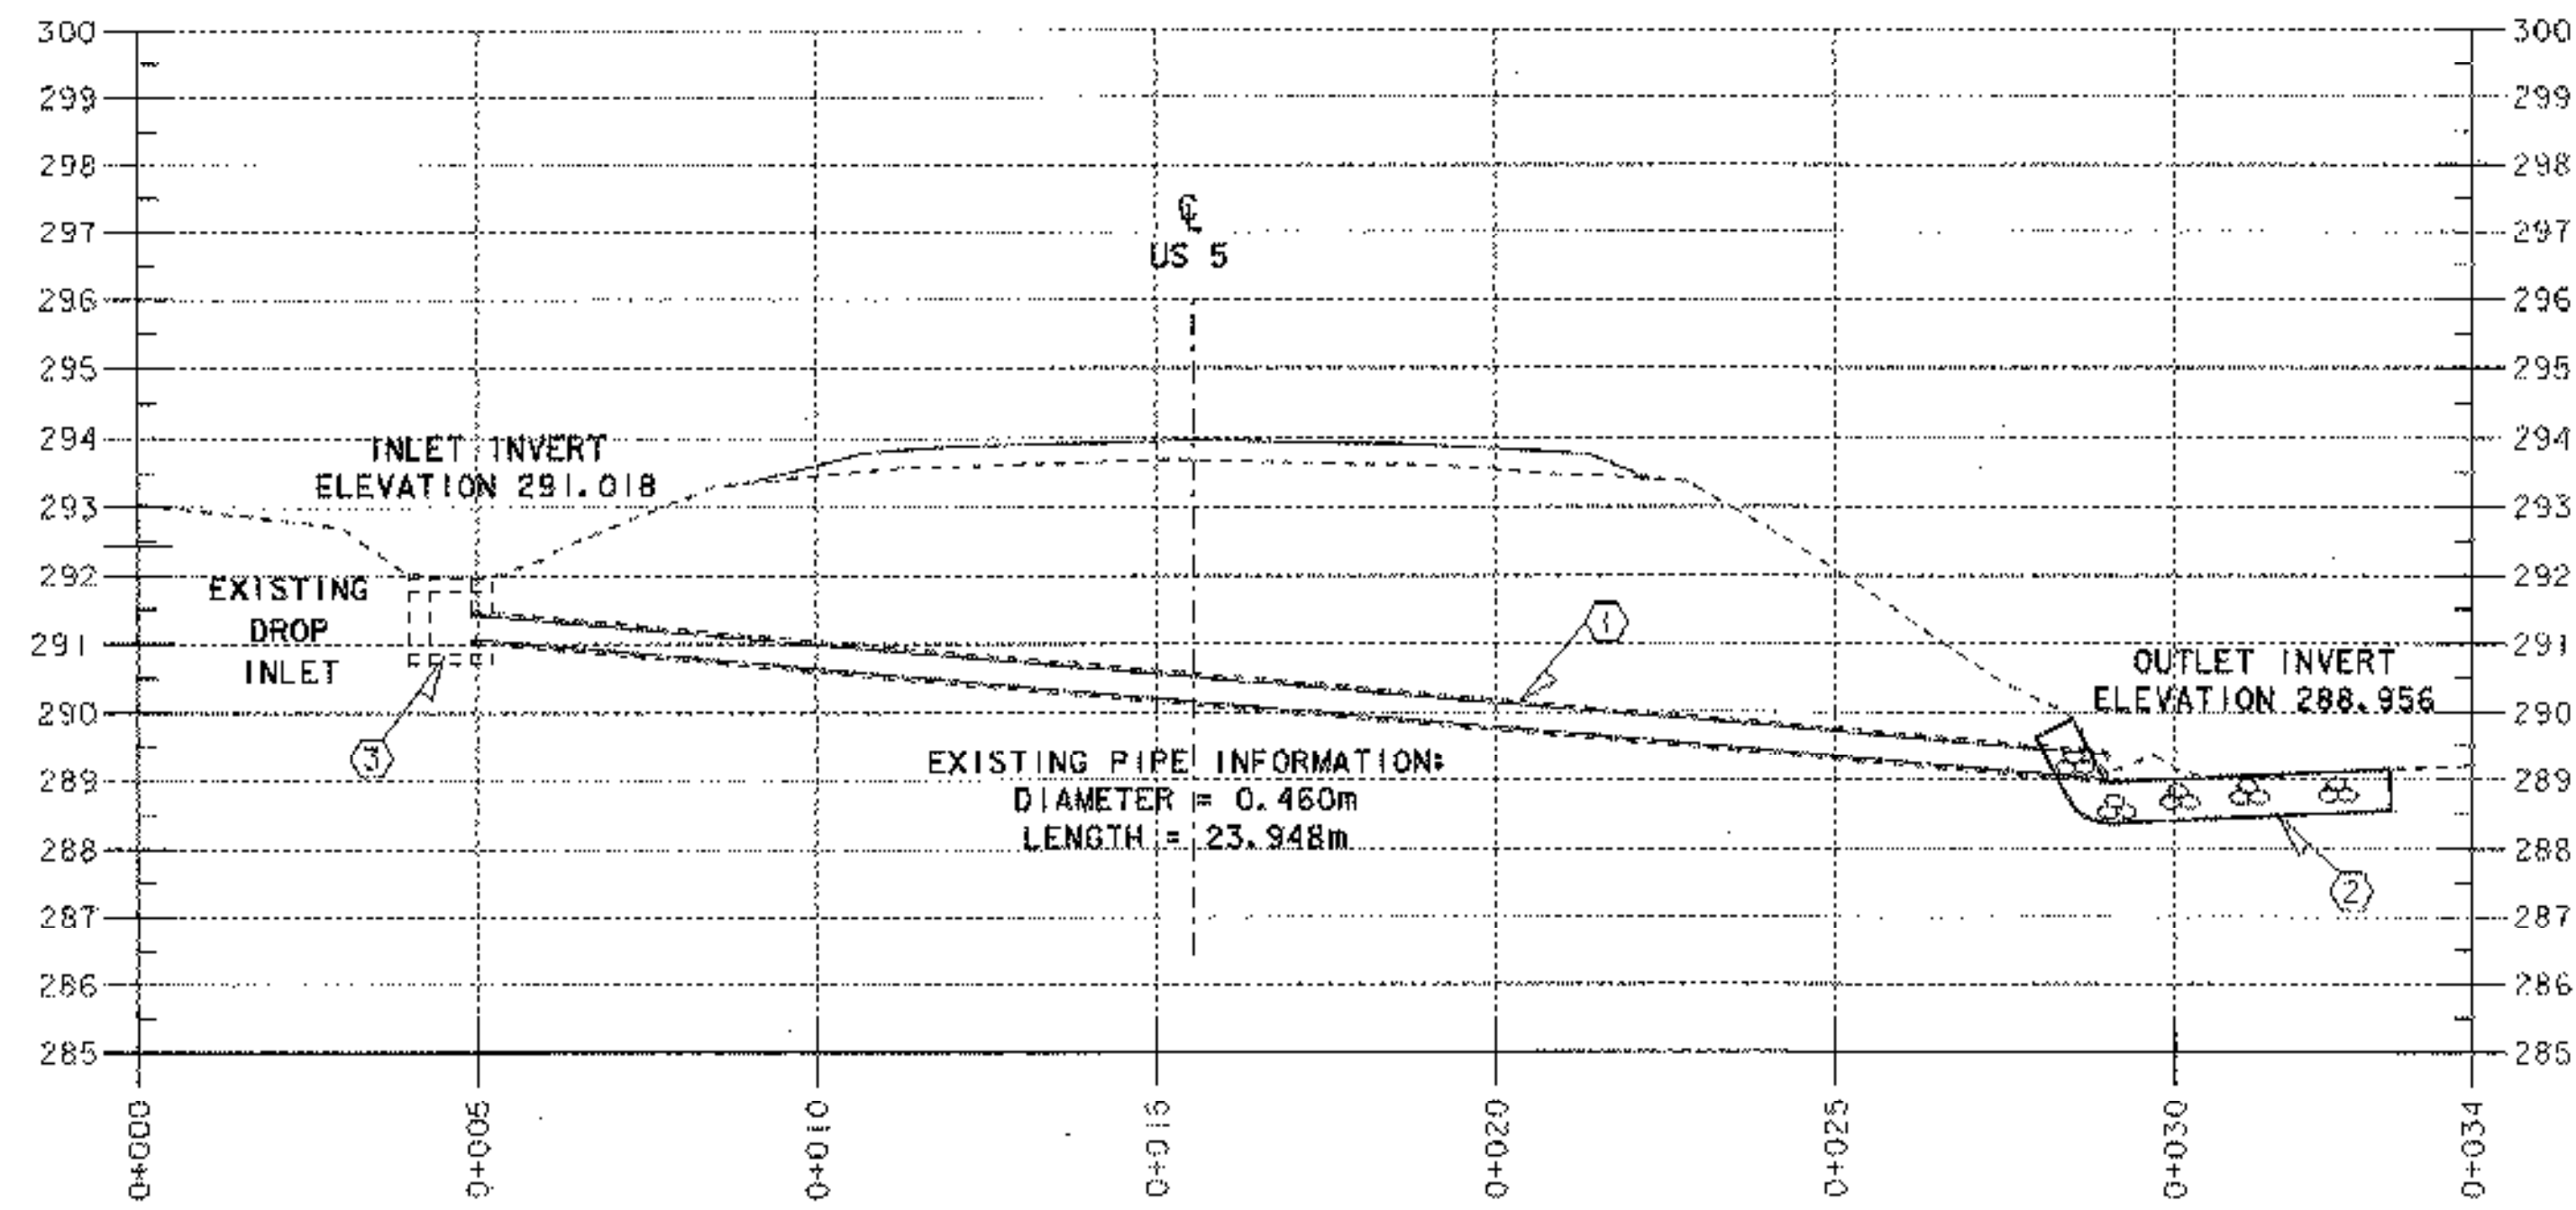


#2  
204.20  
 $4.0 \times 1.5 \times 0.6 = 3.6m^3$   
KRM 6-12-03

613.11  
 $4.0 \times 1.5 \times 0.6 = 3.6m^3$

649.31  
 $6.0 \times 2.0 = 12.0m^3$


# Profile Pipe @ STA 1+177.800 LT

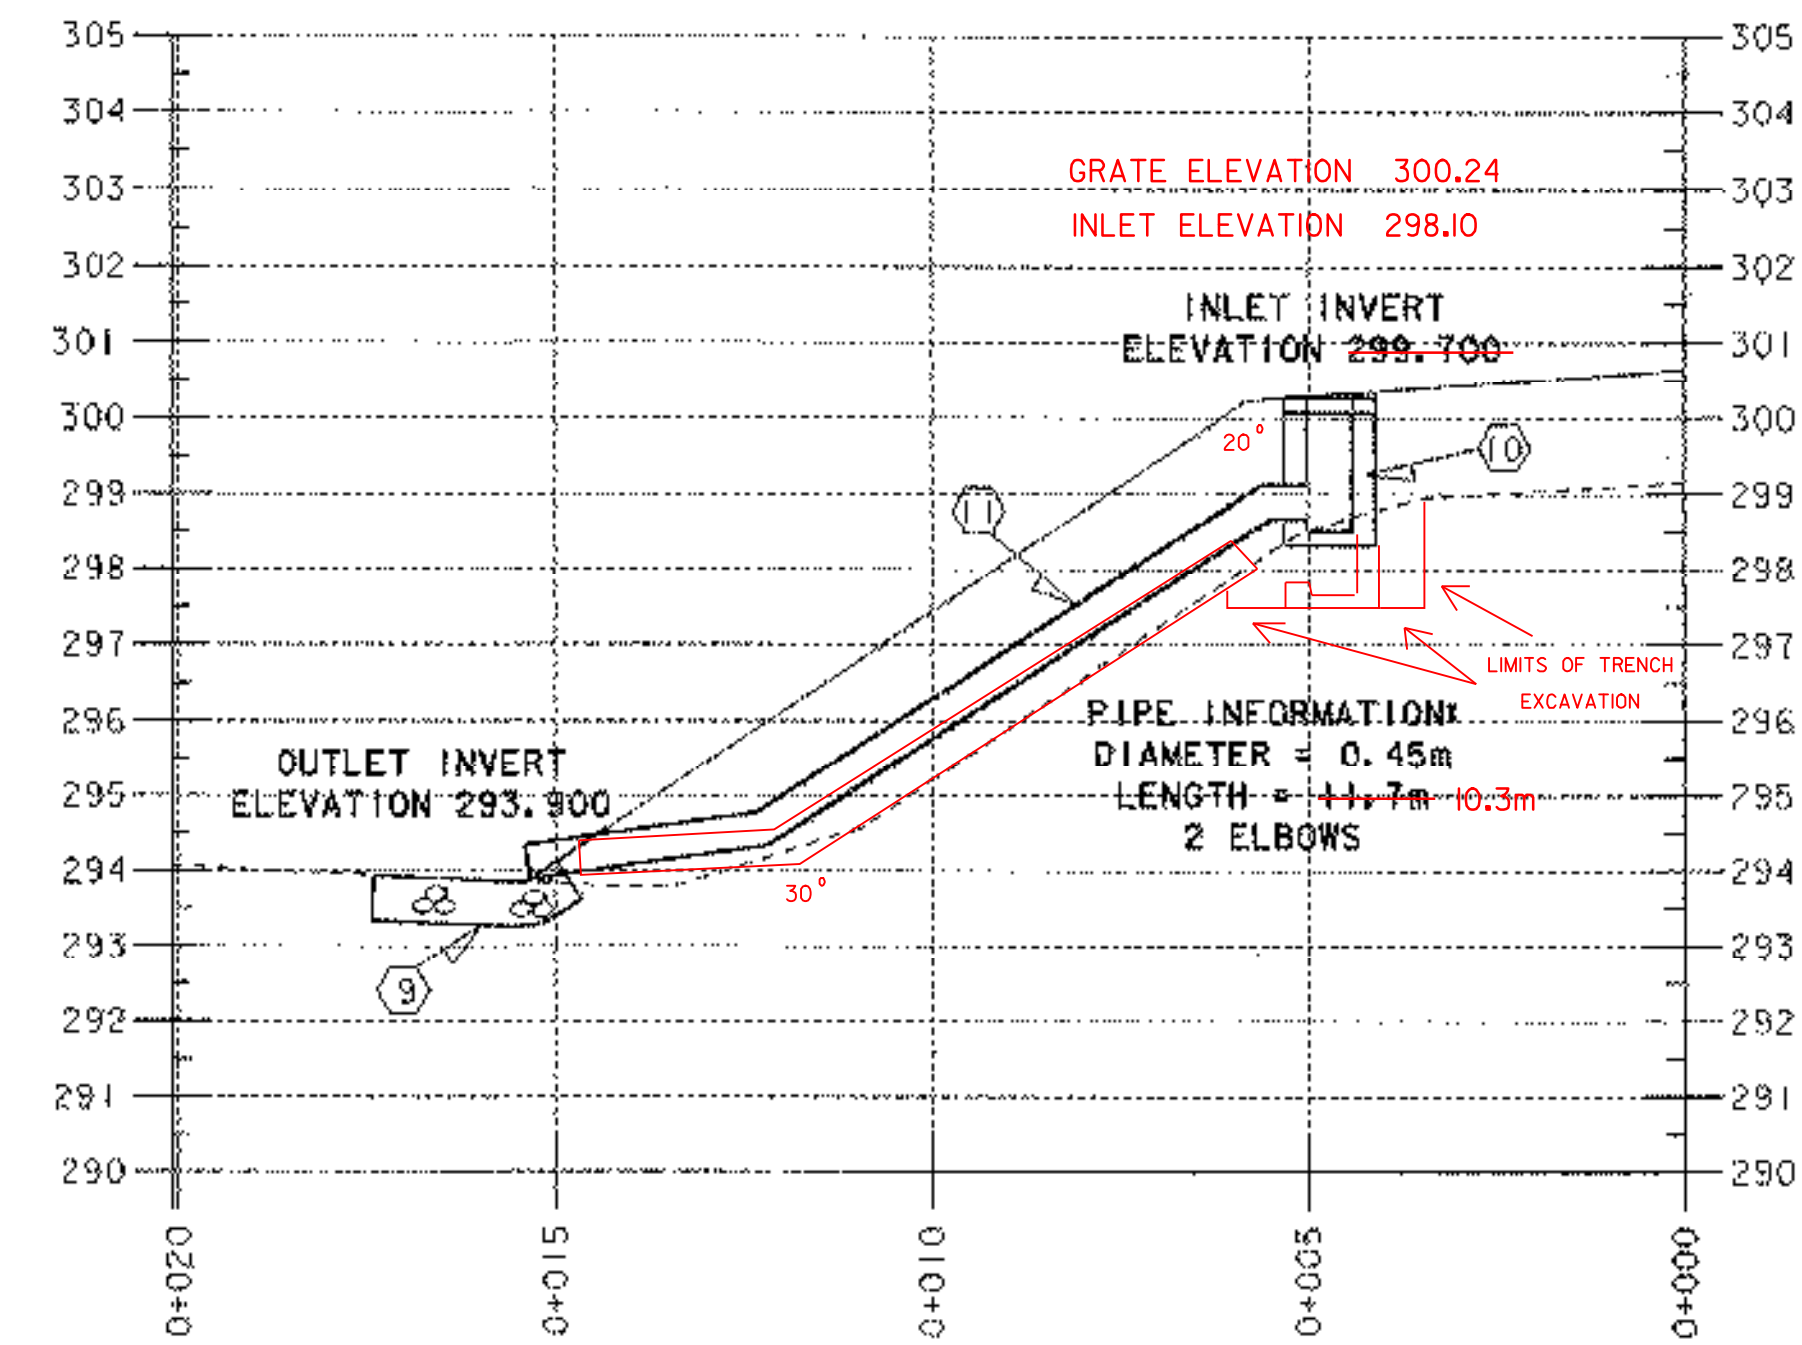

204.20  
TRENCH EXCAVATION  
1.6 1.6  
3.2 1.7m<sup>2</sup>  
1.8 1.8  
3.6  
1.7m<sup>2</sup> x 2.2m = 3.7m<sup>3</sup> KRM 8-7-03

**ARCHIVED  
ON CADD**

# Profile Pipe @ STA 1+120.000 LT

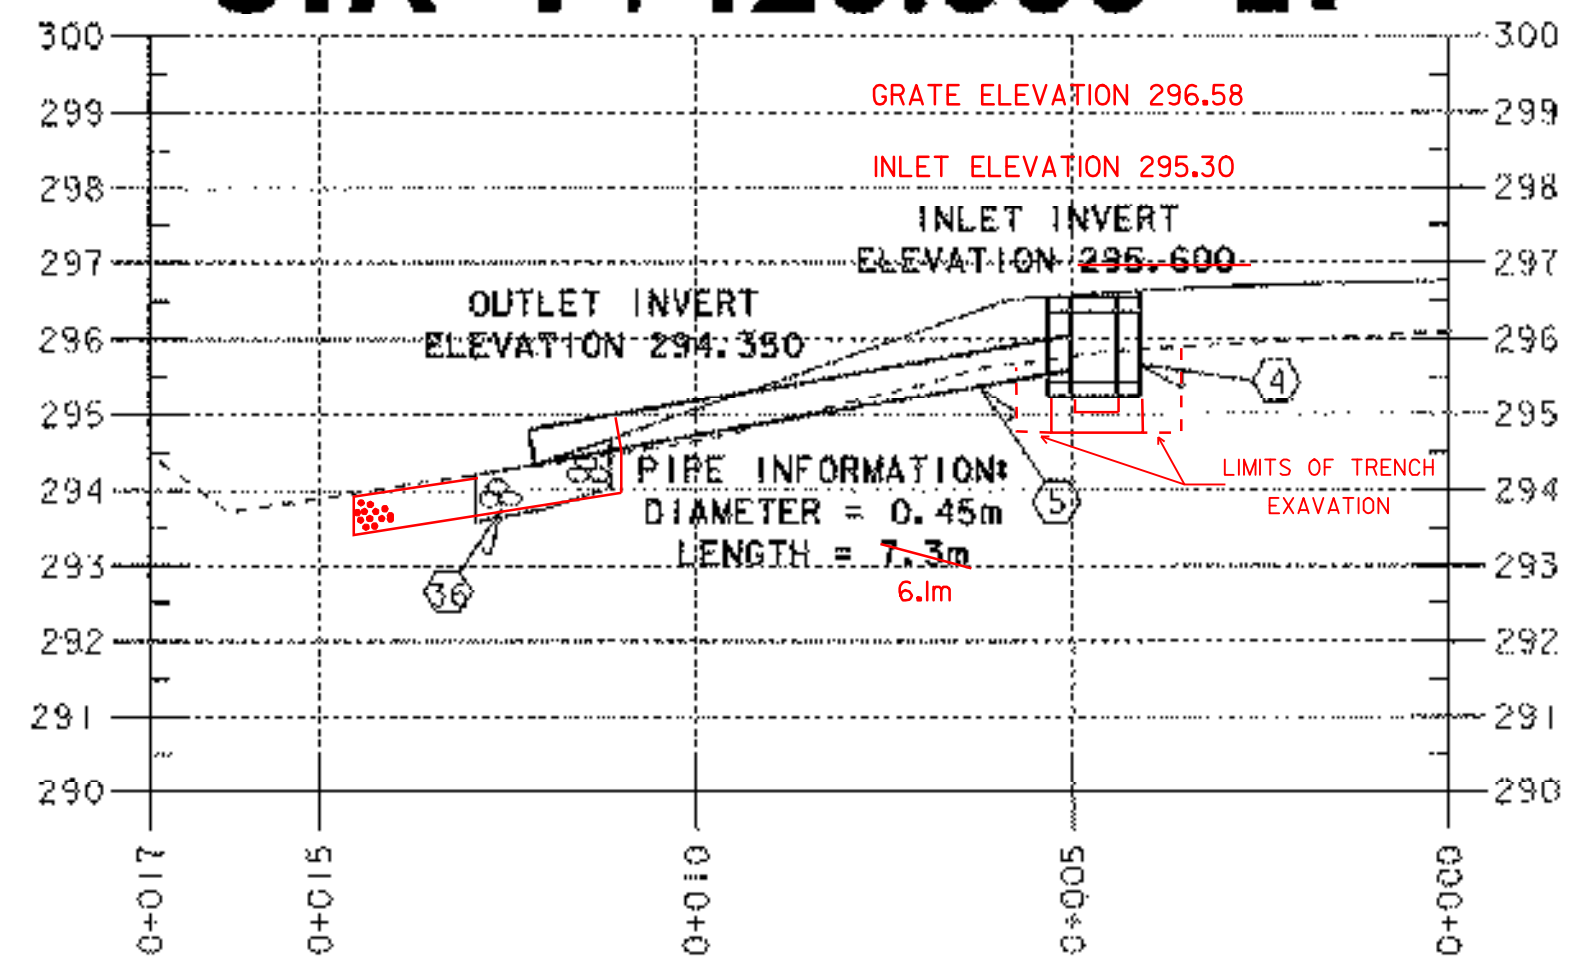

- STONE TYPE II OUTLET PAD (36)  
FIELD MEASURED KRM 8-19-03 SEE IDR 8-15-03

204.20 TRENCH EXCAVATION  
D.I. (4)  
2.0  
2.0  
4.0  
2.0  
2.0  
2.0  
2.0  
4.0

613.11  $3.5m \times 3.0m \times 0.6m = 6.30m^3$   
2  $(2.0m \times 1.3m \times 0.6m) = 3.12m^3$  KRM 8-26-03  
9.42m<sup>3</sup>


649.31  $5.5m \times 3.0m = 16.5m^2$

2.0m<sup>2</sup> x 2.2m = 4.4m<sup>3</sup> KRM 8-26-03

1.25m<sup>2</sup> x 1.45m = 1.6m<sup>3</sup> KRM 8-26-03


- PIPE (6)  
1.1  
1.15  
2.3  
1.1  
1.1  
2.2

# Profile Pipe @ STA 1+142.000

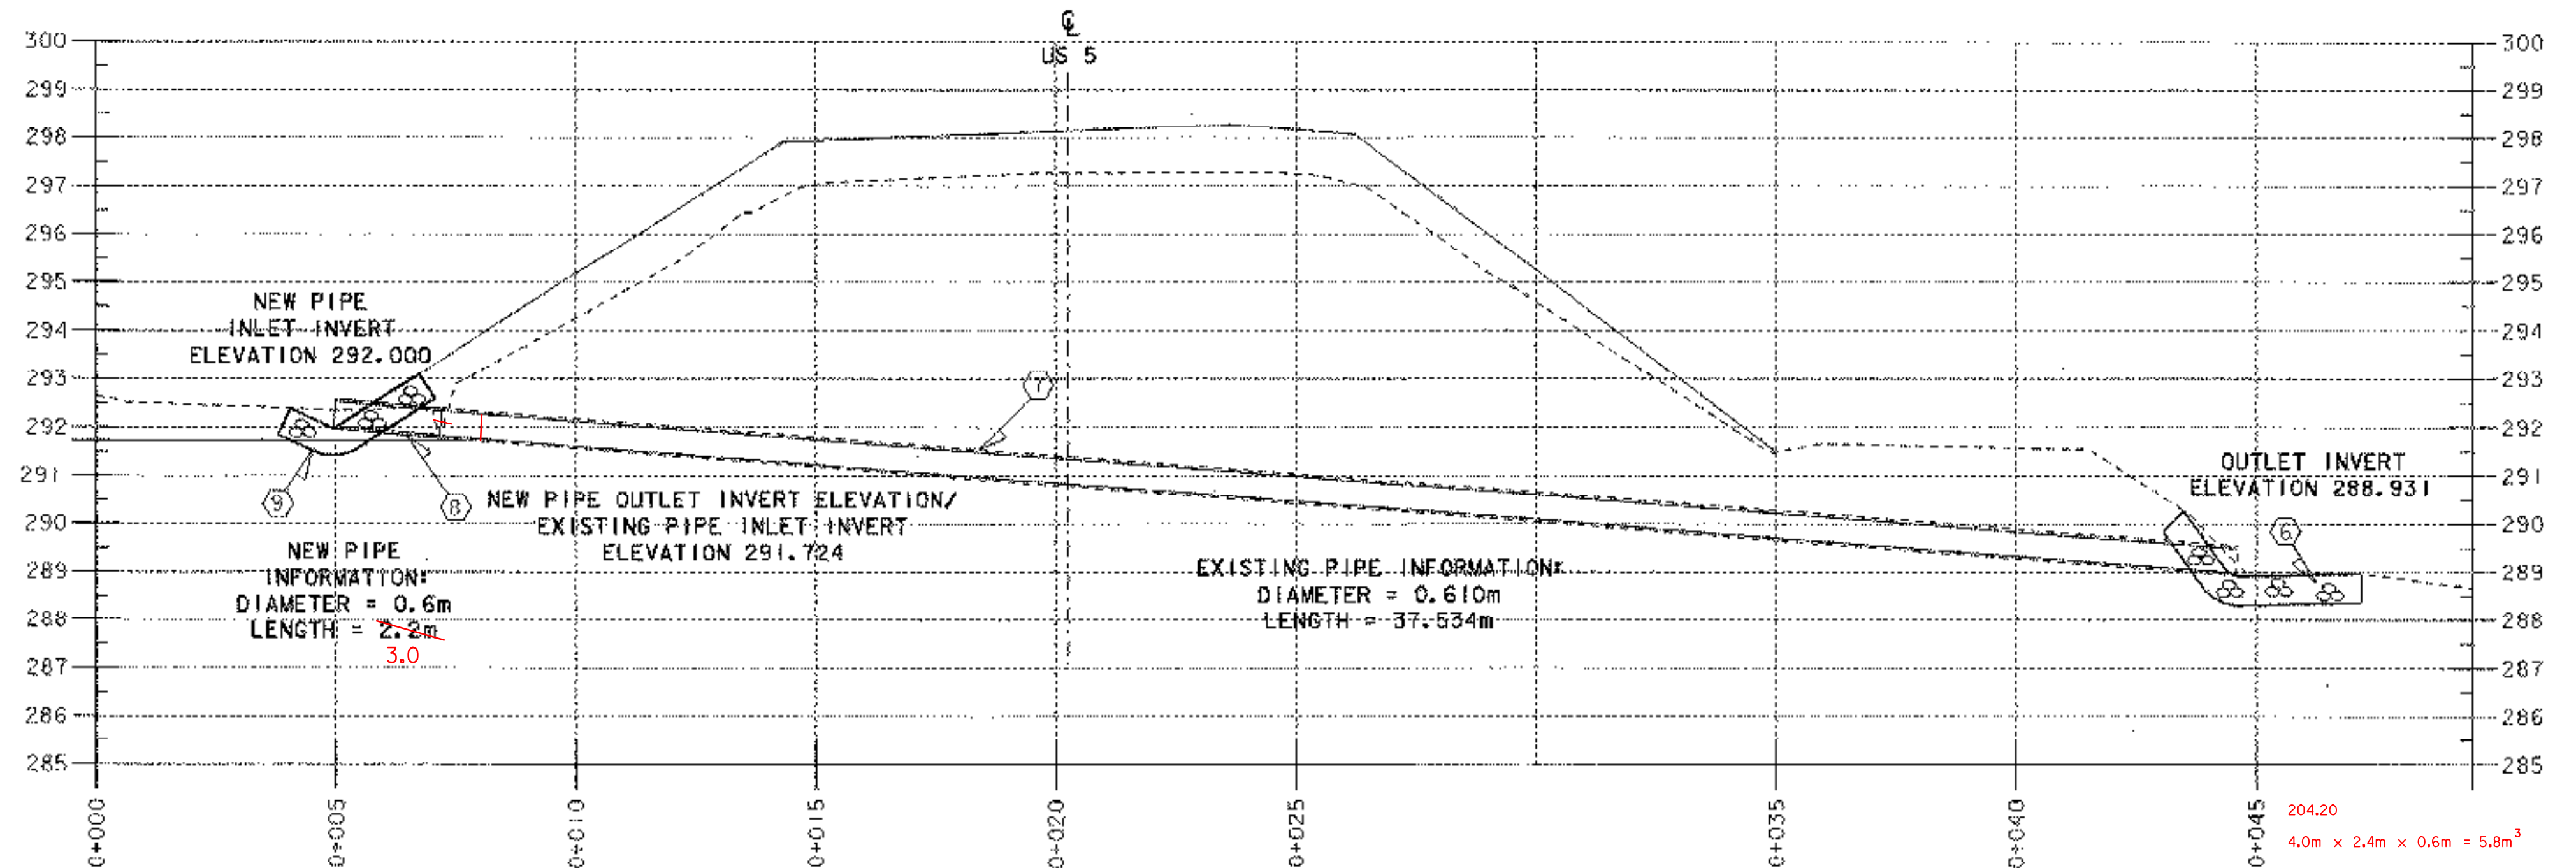

ADDITIONAL DRAINAGE NOTE:

(B) THE EXTENSION TO THE EXISTING PIPE (Y) SHALL BE INSTALLED PRIOR TO THE INSTALLATION OF THE PVC FOLD AND FORM LINER. THE FOLD AND FORM LINER SHALL EXTEND WITHOUT INTERRUPTION THROUGH BOTH EXISTING AND EXTENSION PIPE.

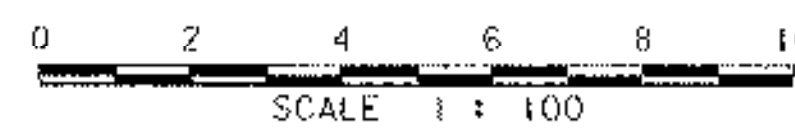

PROJECT:	BARTON	PROJECT NO. :	STP 0113 (58) S
DESIGN FILE NAME:	96c116/structures/sc116drain.dgn	PLOT DATE:	03-JAN-2002
IPARM FILE NAME:	sc116dpl.i	DRAWN BY:	R. S. YOUNG
PROJECT LEADER:	C. P. WILLIAMS		
DRAINAGE PROFILE		SHEET:	43 OF 120