

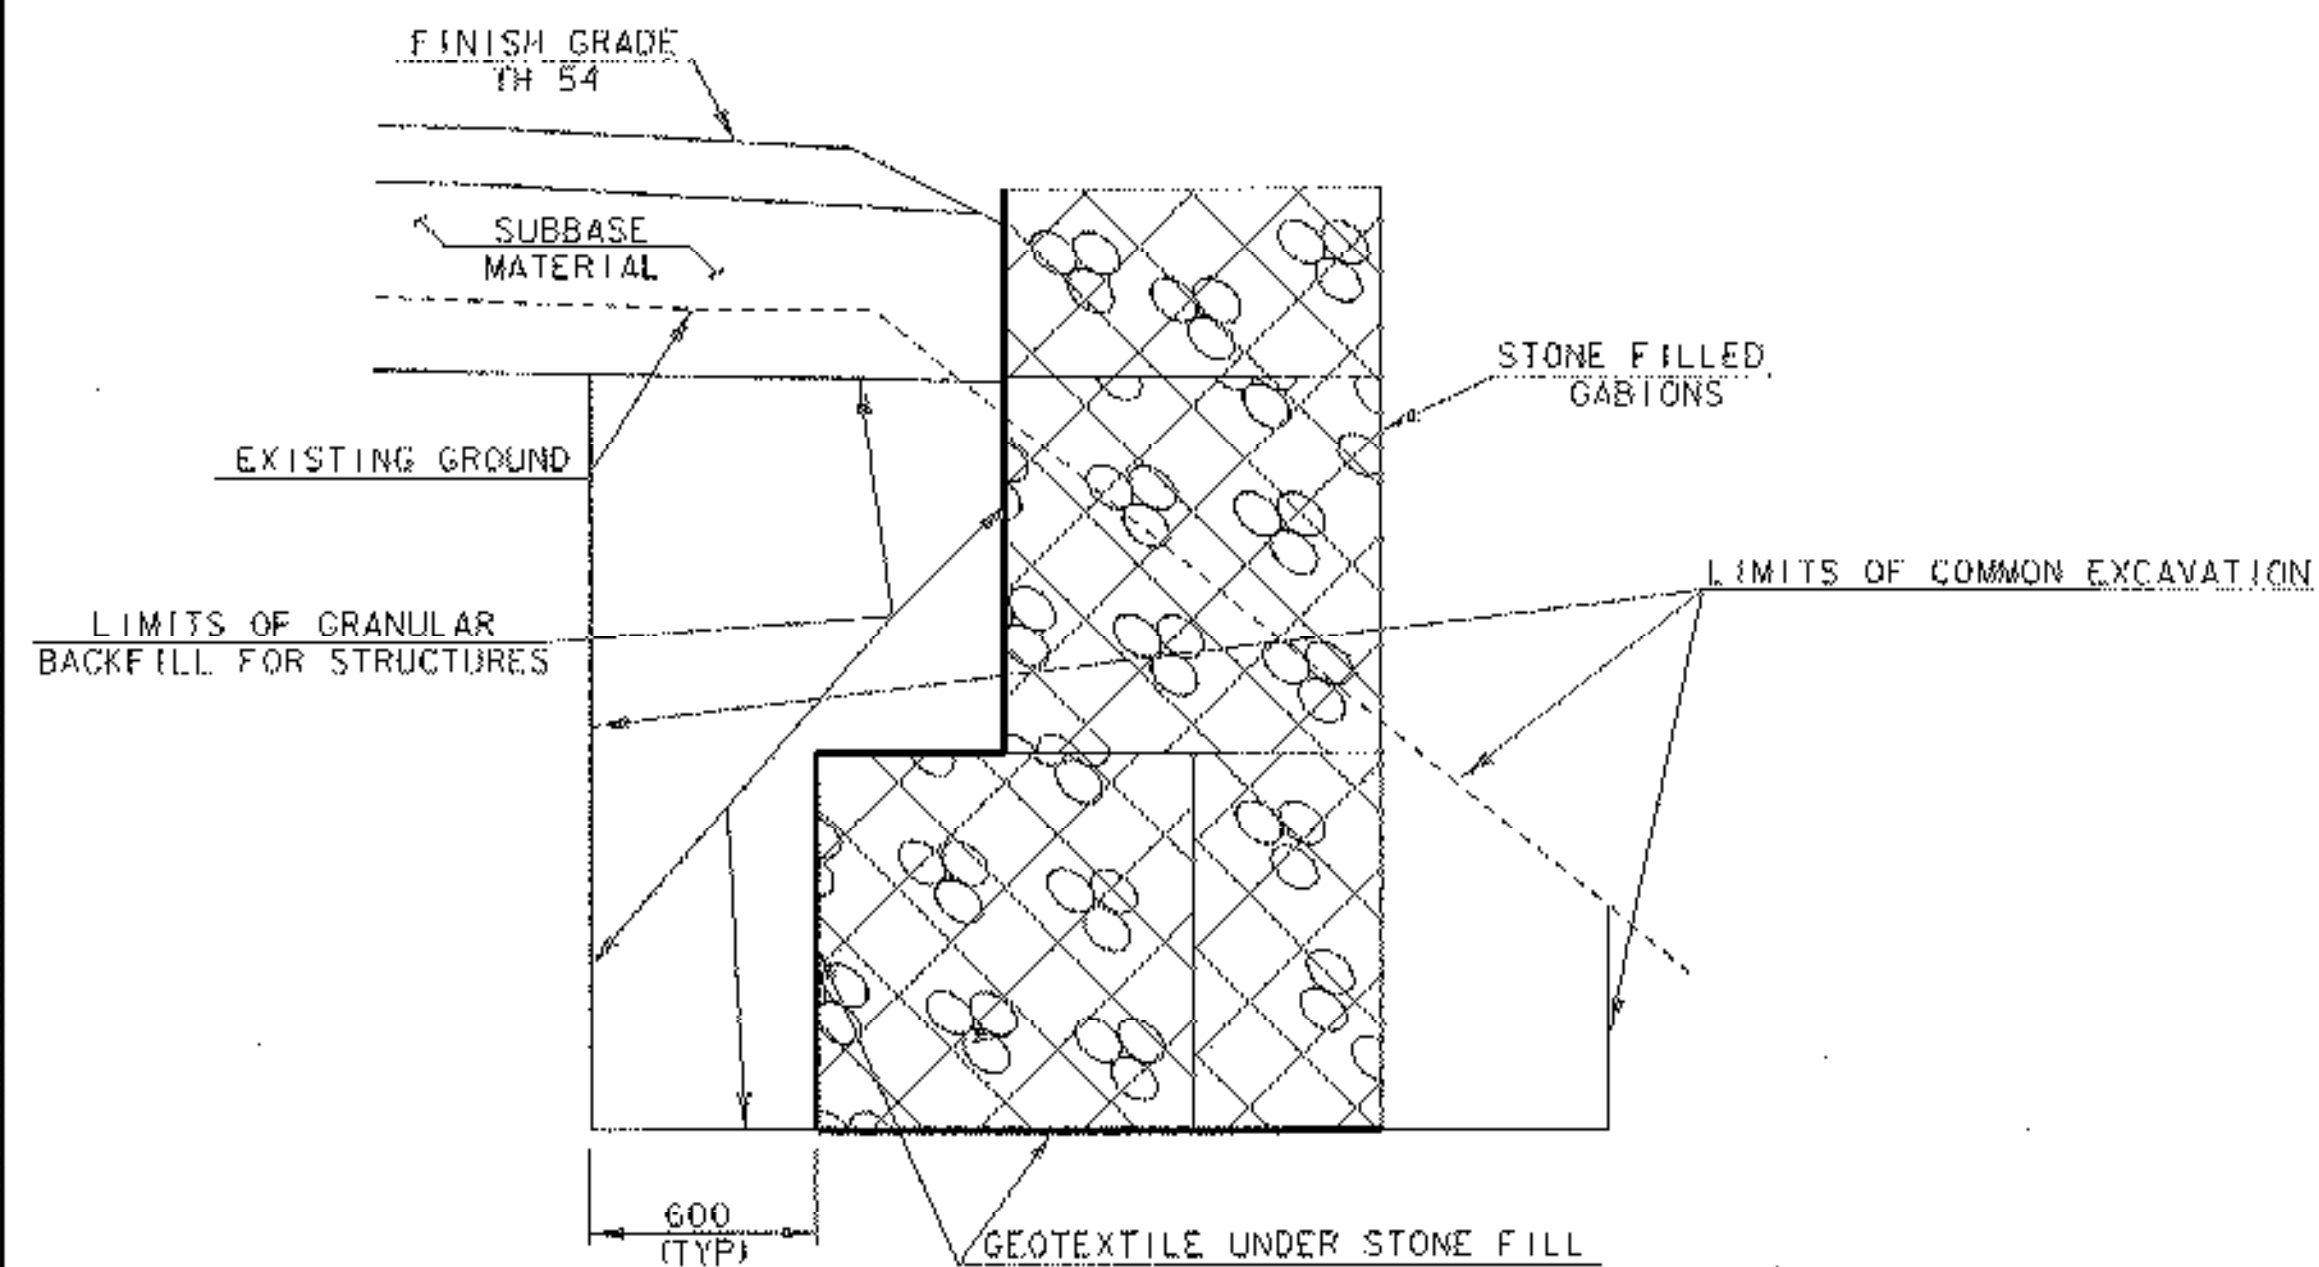
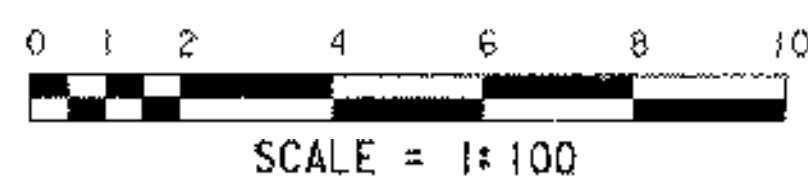




ELEVATION VIEW OF GABION WALL ALONG \mathcal{C} OF T.H. 54

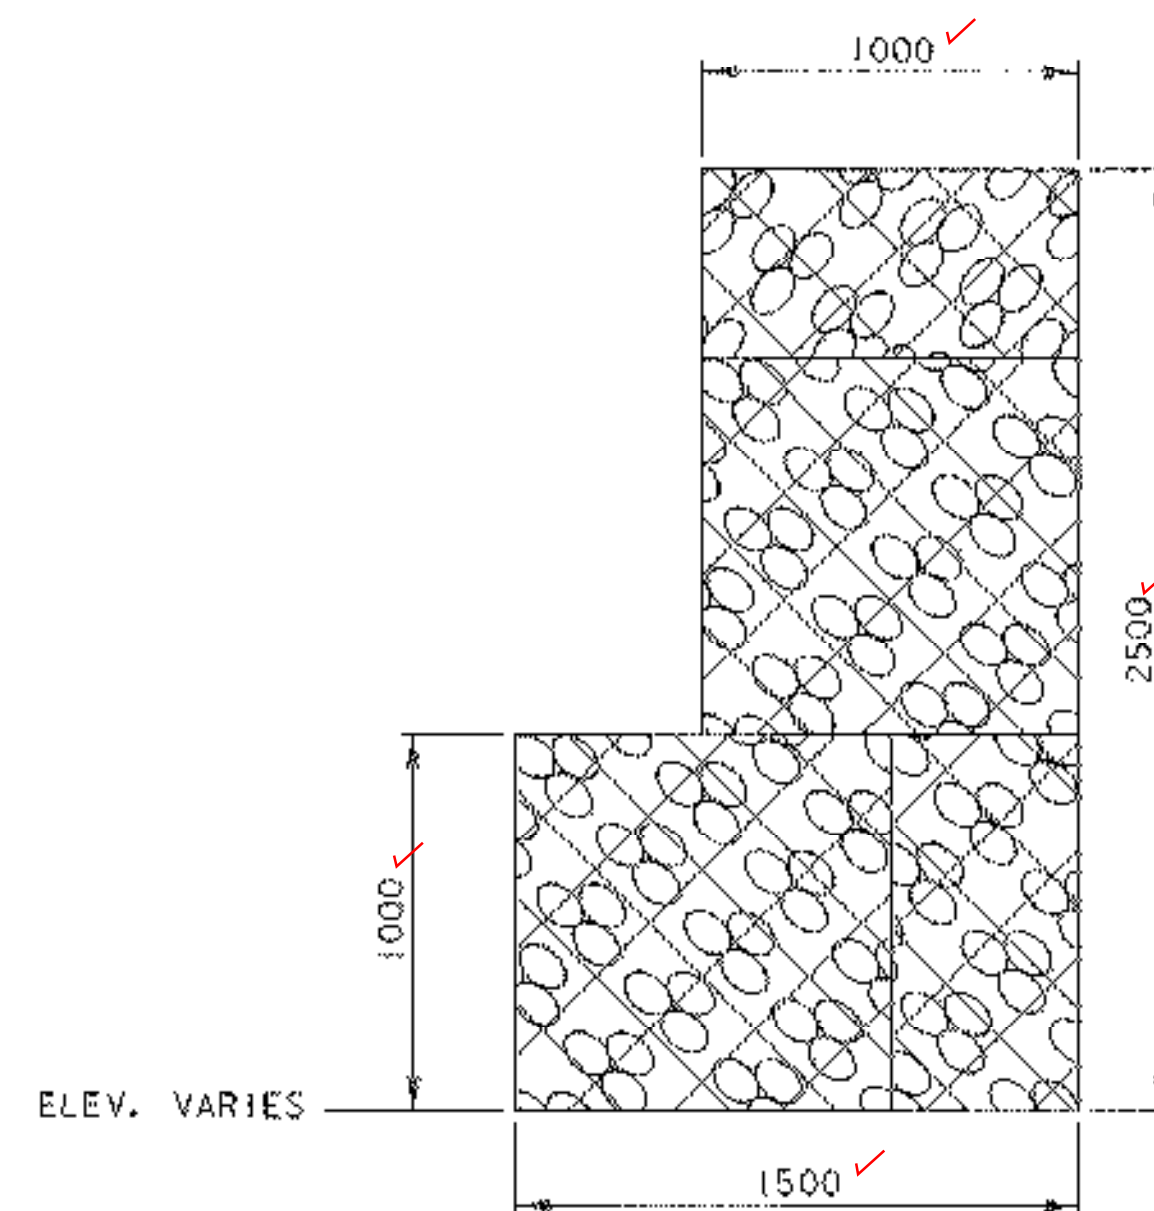


TYPICAL SECTION

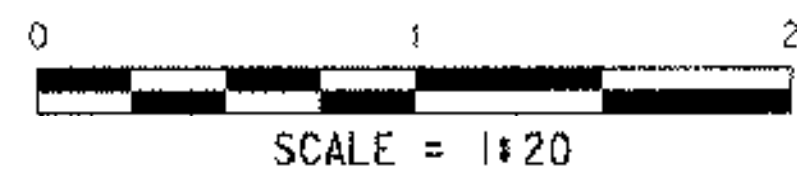

SECTION B-B

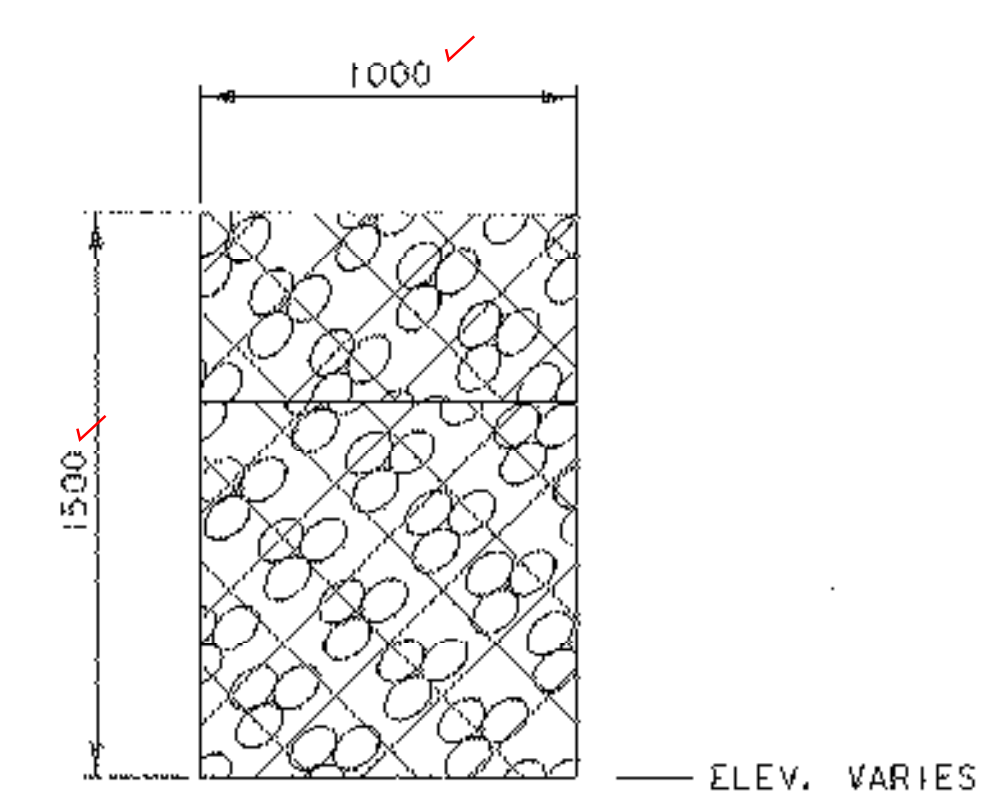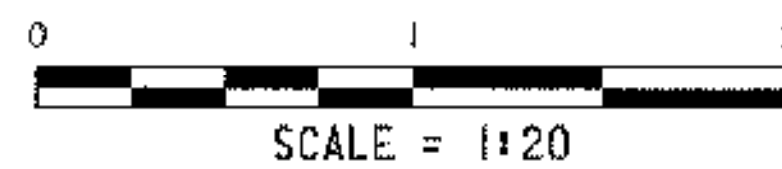

SECTION A-A

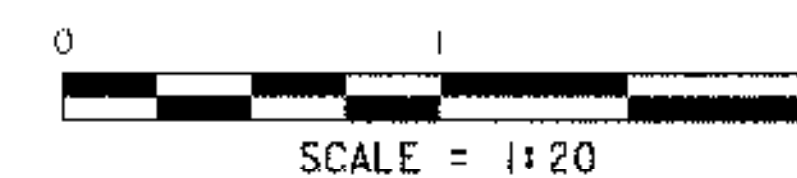

NOTE: THE FRONT FACE OF THE GABION RETAINING WALL SHALL BE BATTERED BACK AT A RATE OF 0.027 mm/mm.

**ARCHIVED
ON CADD**

| | |
|---|---|
| PROJECT: BARTON | PROJECT NO. # STP 0113 (58) S |
| DESIGN FILE NAME: 96c116/structures/sc116gabion.dgn | PLOT DATE: 03-JAN-2002 |
| IPARM FILE NAME: sc116gabion.i | DRAWN BY: R.S. YOUNG |
| DESIGNED BY: R.S. YOUNG | CHECKED BY: W.B. SYMONDS |
| SQUAD LEADER: C.P. WILLIAMS | SHEET: 47 OF 120 |
| GABION WALL DETAILS | |