


**EXPANSION JOINT @ ABUTMENT #2**

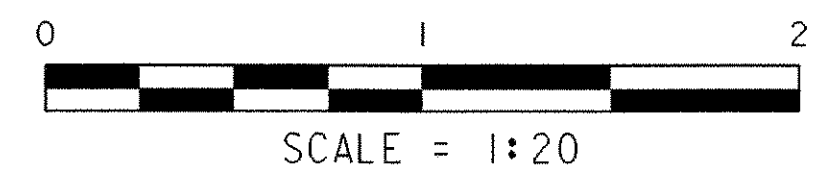

PROJECT NAME:	BARTON
PROJECT NUMBER:	STP 0113 (58)S
FILE NAME: 96c116/STRUCTURES/sc116joint.dgn	PLOT DATE: 03-JAN-2002
IPARM NAME: 96c116/STRUCTURES/sc116expj11.i	DRAWN BY: T.G. ANDERSON
PROJECT LEADER: C.P. WILLIAMS	CHECKED BY: W.B. SYMONDS
DESIGNED BY: W.B. SYMONDS	SHEET 58 OF 120
EXPANSION JOINT PLAN	