


NOTE:
1. SEE SHEET 58 FOR LOCATION OF SECTIONS FOR DETAILS ON THIS SHEET.

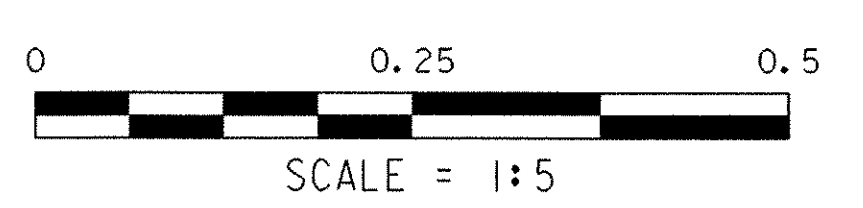

PROJECT NAME:	BARTON
PROJECT NUMBER:	STP 0113 (58) S
FILE NAME:	96c116/STRUCTURES/sc116joint.dgn
IPARM NAME:	96c116/STRUCTURES/sc116expj12.1
PROJECT LEADER:	C.P. WILLIAMS
DESIGNED BY:	W.B. SYMONDS
PLLOT DATE:	03-JAN-2002
DRAWN BY:	T.G. ANDERSON
CHECKED BY:	W.B. SYMONDS
SHEET	59 OF 120