


**RAILING BASE SLAB
TYPICAL SECTION**

SCALE 1 : 10


NOTE:

NF = NEAR FACE
 FF = FAR FACE
 EF = EACH FACE
 ▲ = CUT TO FIT IN FIELD
 75 CLR. UNLESS OTHERWISE SPECIFIED ON THE PLANS.
 ALL LAPS SHALL BE 660 UNLESS NOTED OTHERWISE
 ALL REINFORCING STEEL SHALL BE EPOXY COATED.

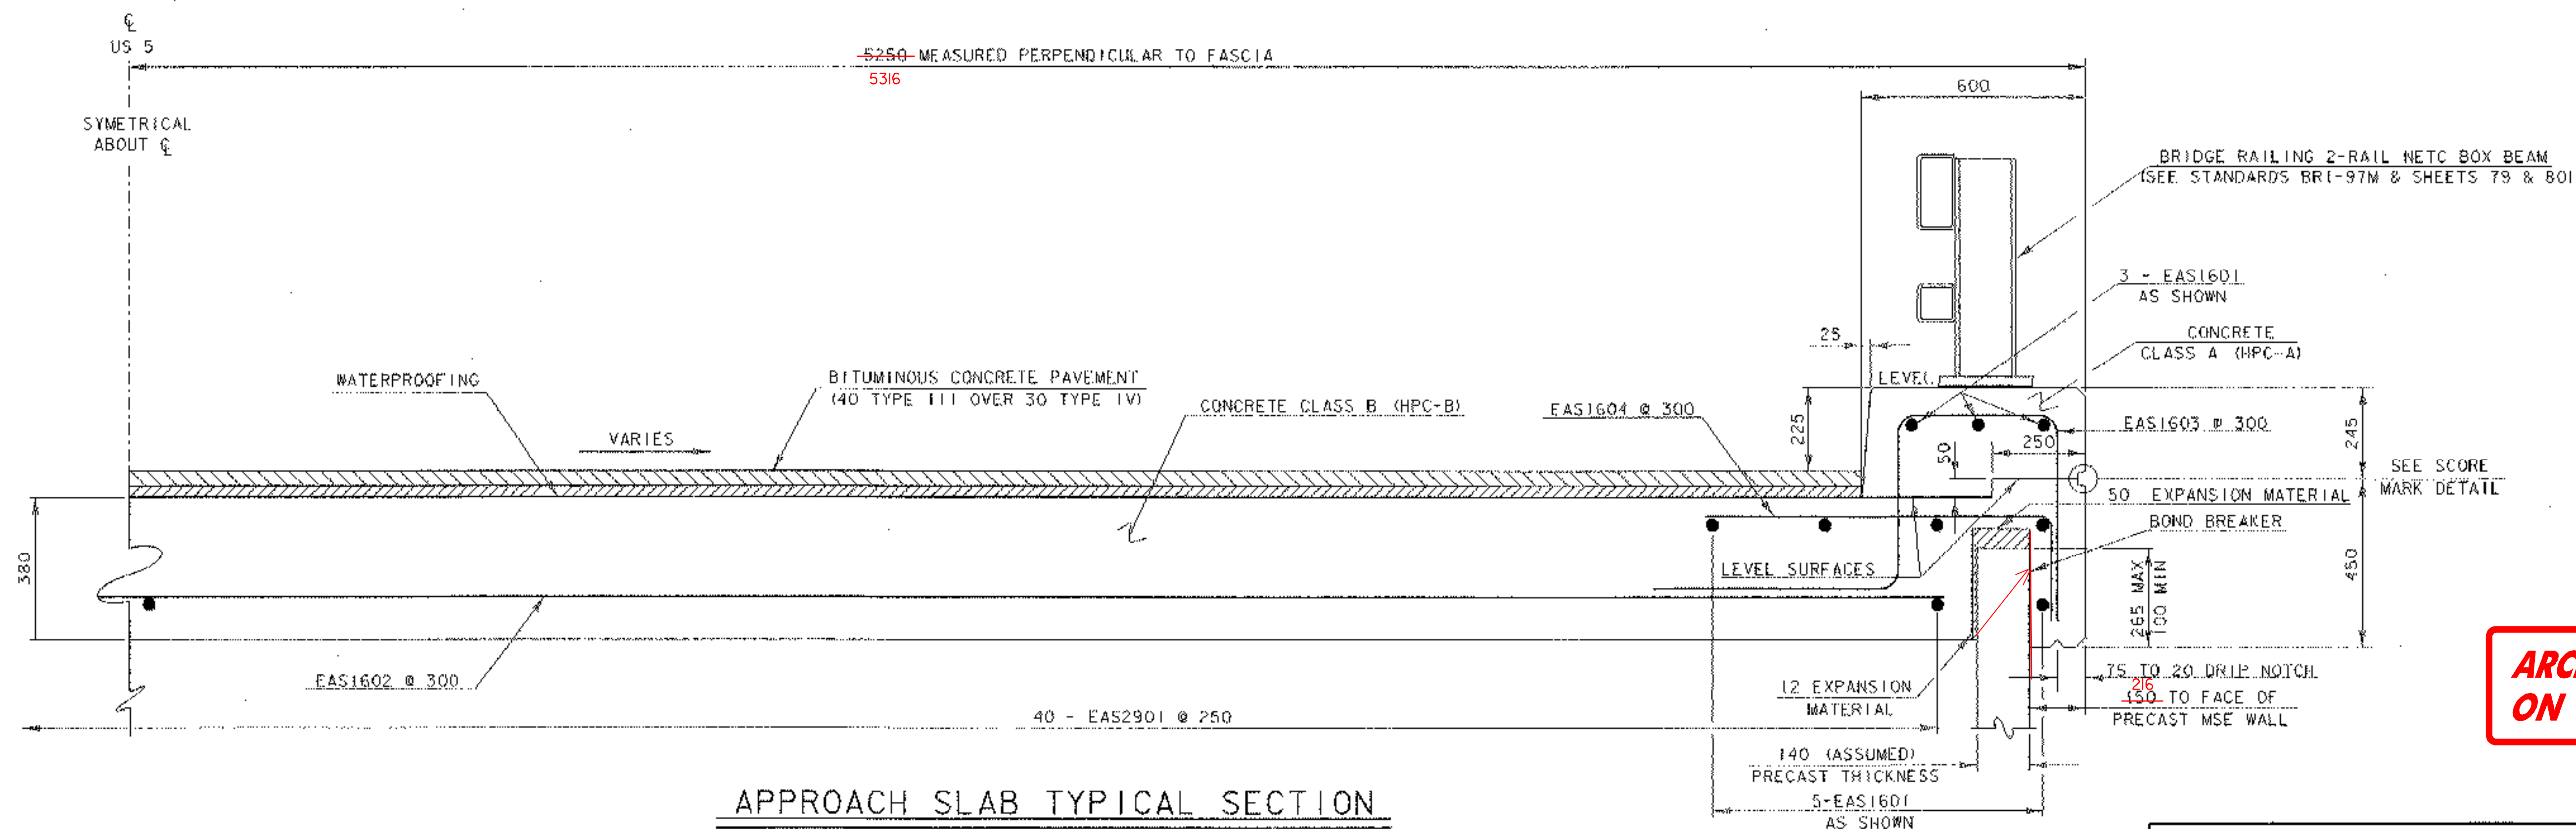

**APPROACH SLAB TYPICAL SECTION
(SEE SECTION C-C SHEET 62 OF 120)**

SCALE 1 : 10

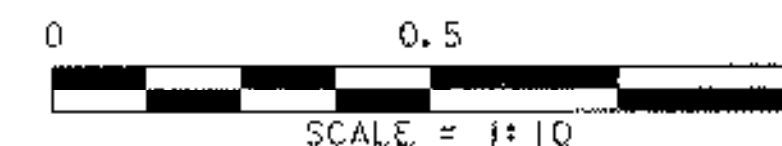

**ARCHIVED
ON CADD**

PROJECT NAME:	BARTON	PLOT DATE:	03-JAN-2002
PROJECT NUMBER:	STP 0113 (58) S	DRAWN BY:	D. G. BASSETT
FILE NAME:	96c116/structures/ect116sup.dgn	CHECKED BY:	W. B. SYMONDS
IPARM NAME:	96c116/structures/ect116sec.1	DESIGNED BY:	W. B. SYMONDS
PROJECT LEADER:	C. P. WILLIAMS	SHEET	61 OF 120
BASE/APPROACH SLAB TYPICAL SECTIONS			