



SEE MSE WALL SHOP DRAWINGS

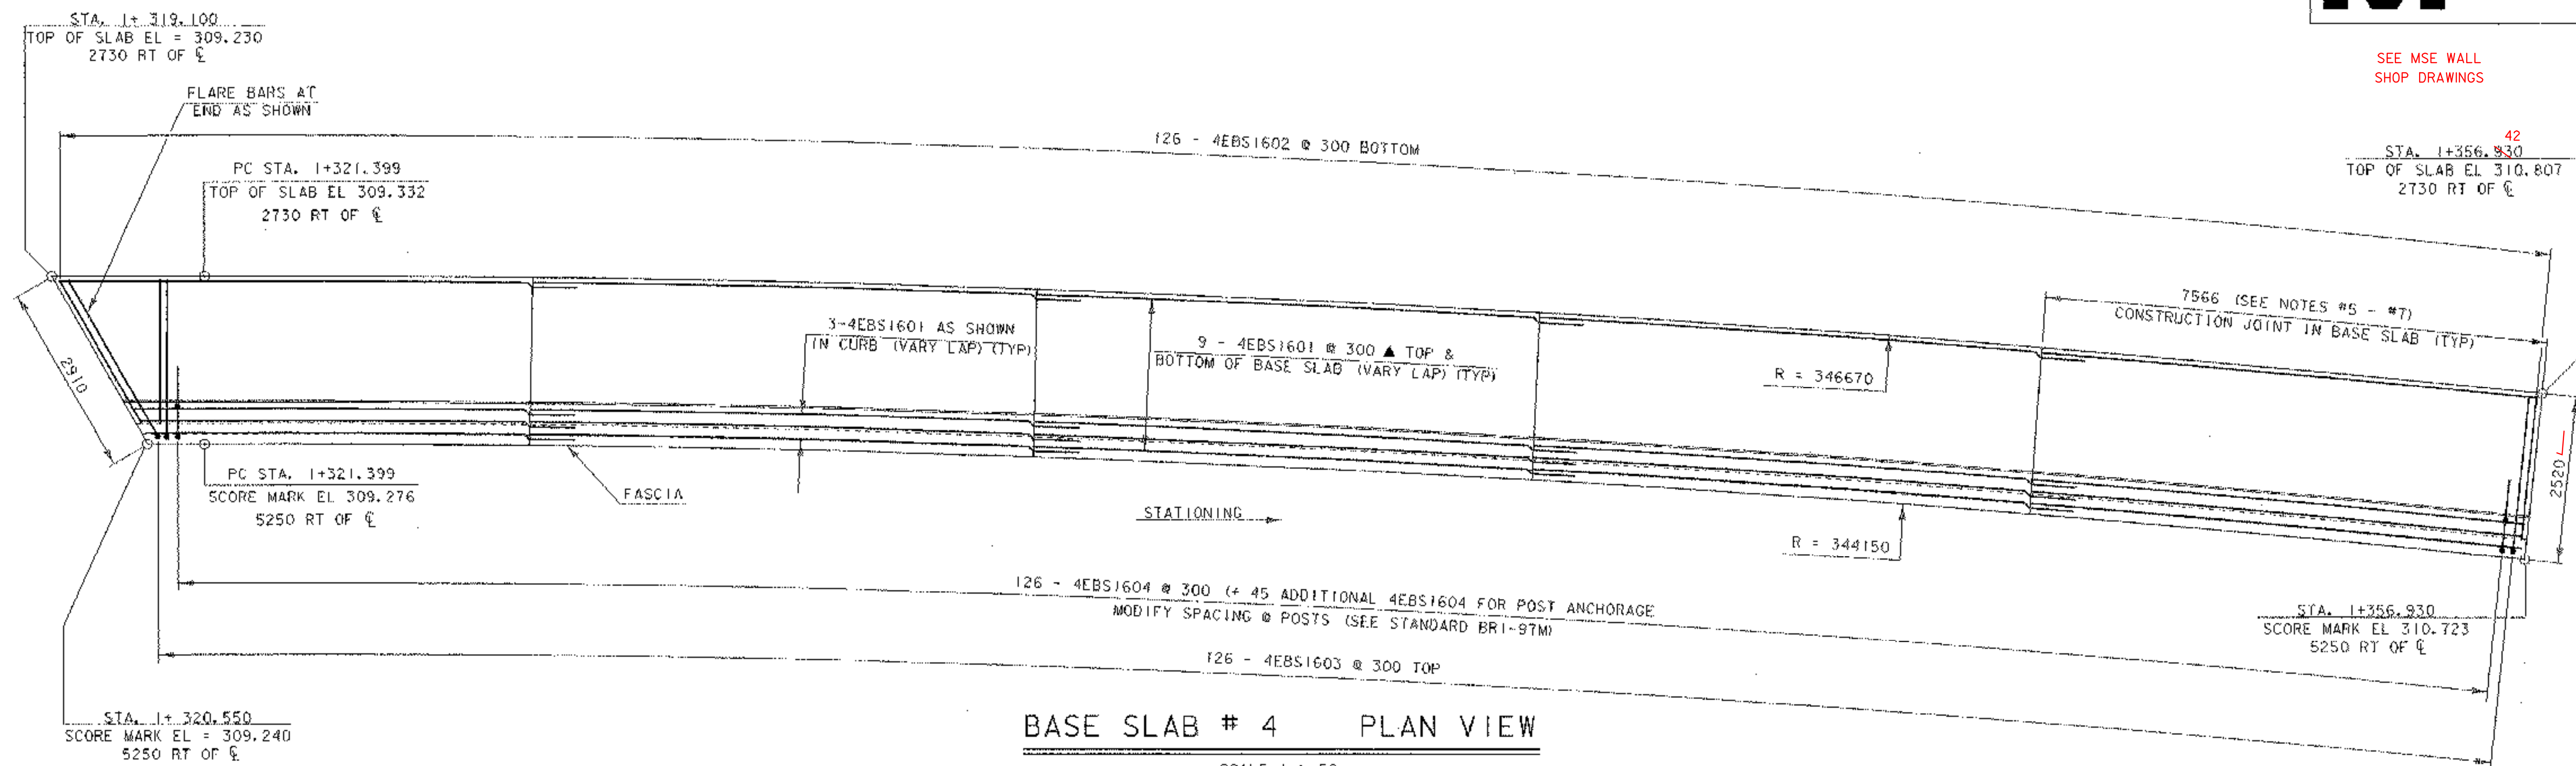


BASE SLAB # 4 PLAN VIEW

SCALE 1 : 50

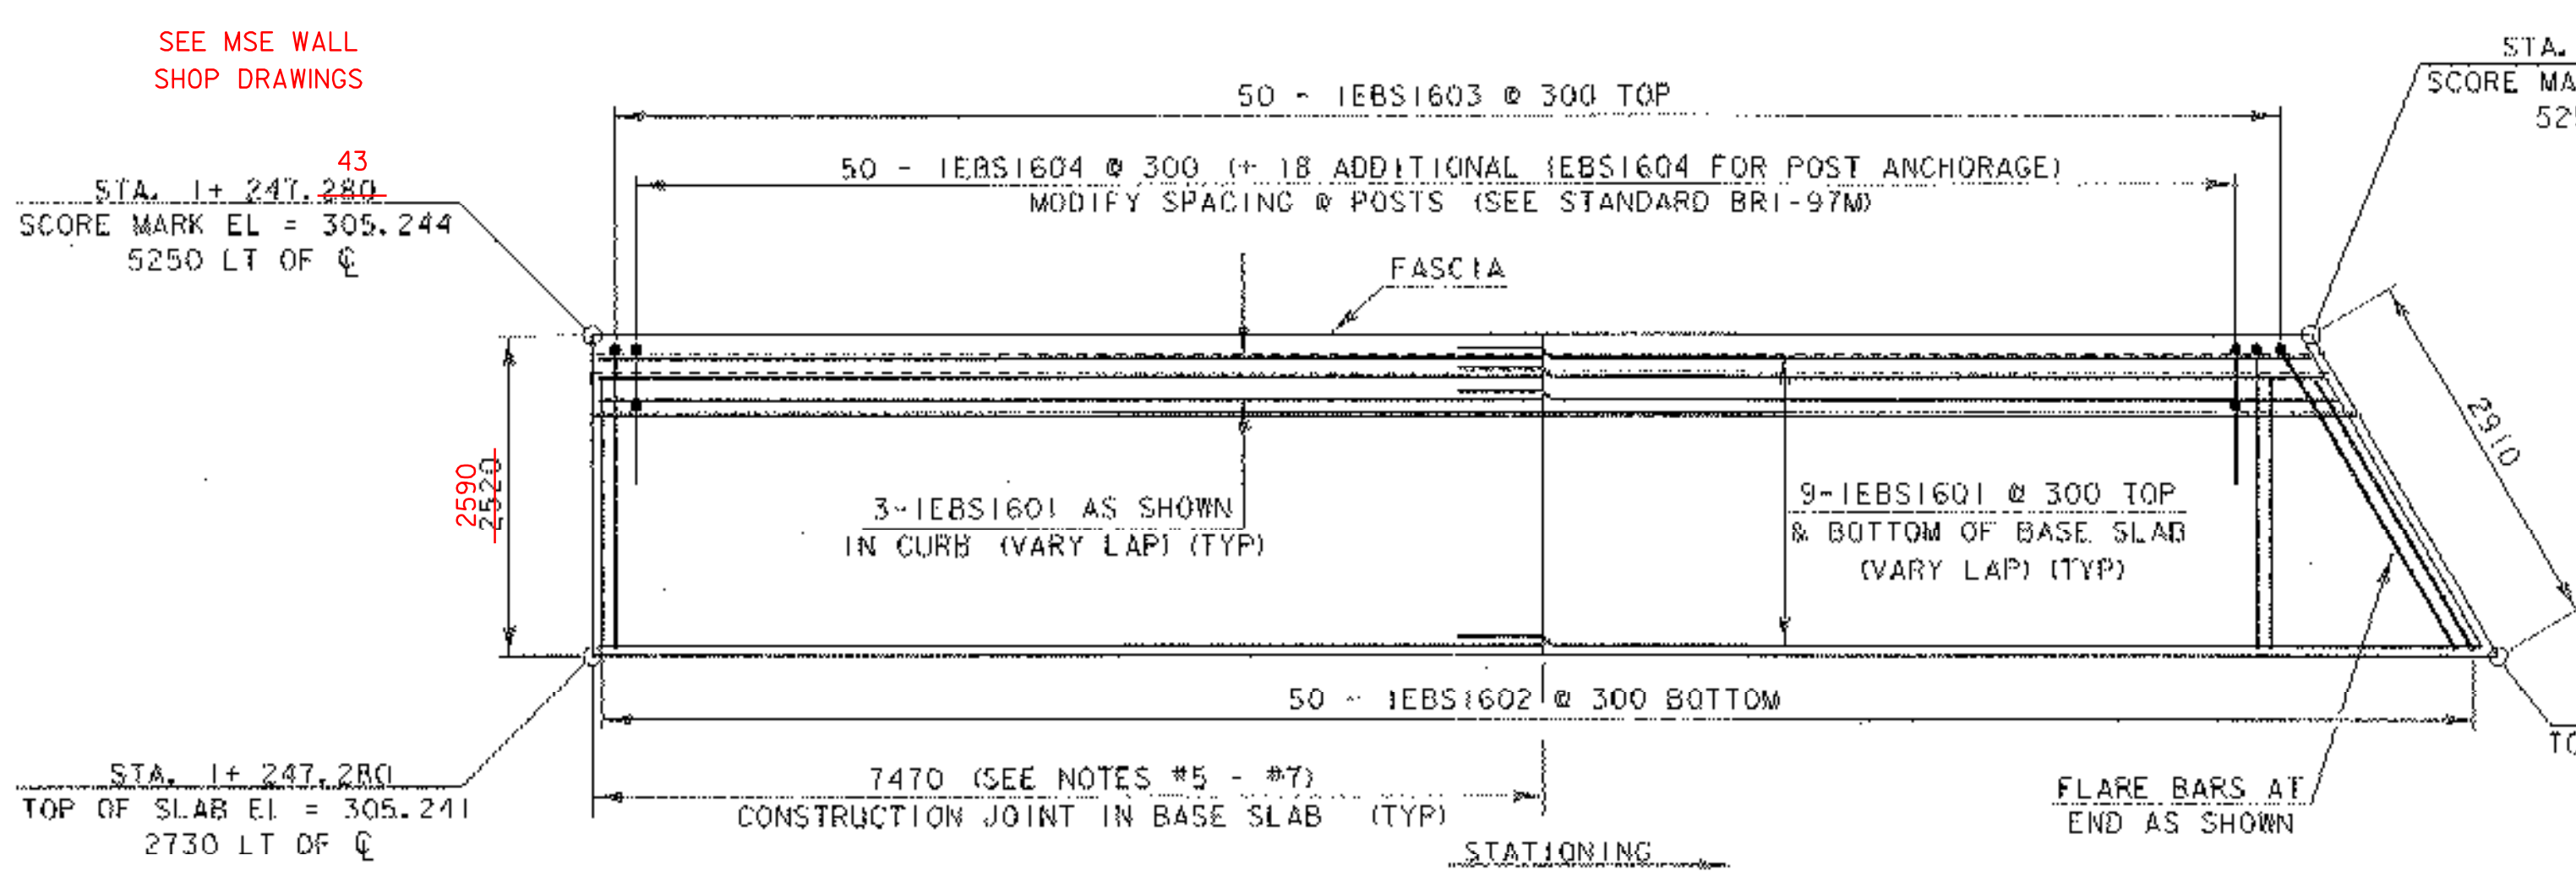

BASE SLAB # 1 PLAN VIEW

SCALE 1 : 50

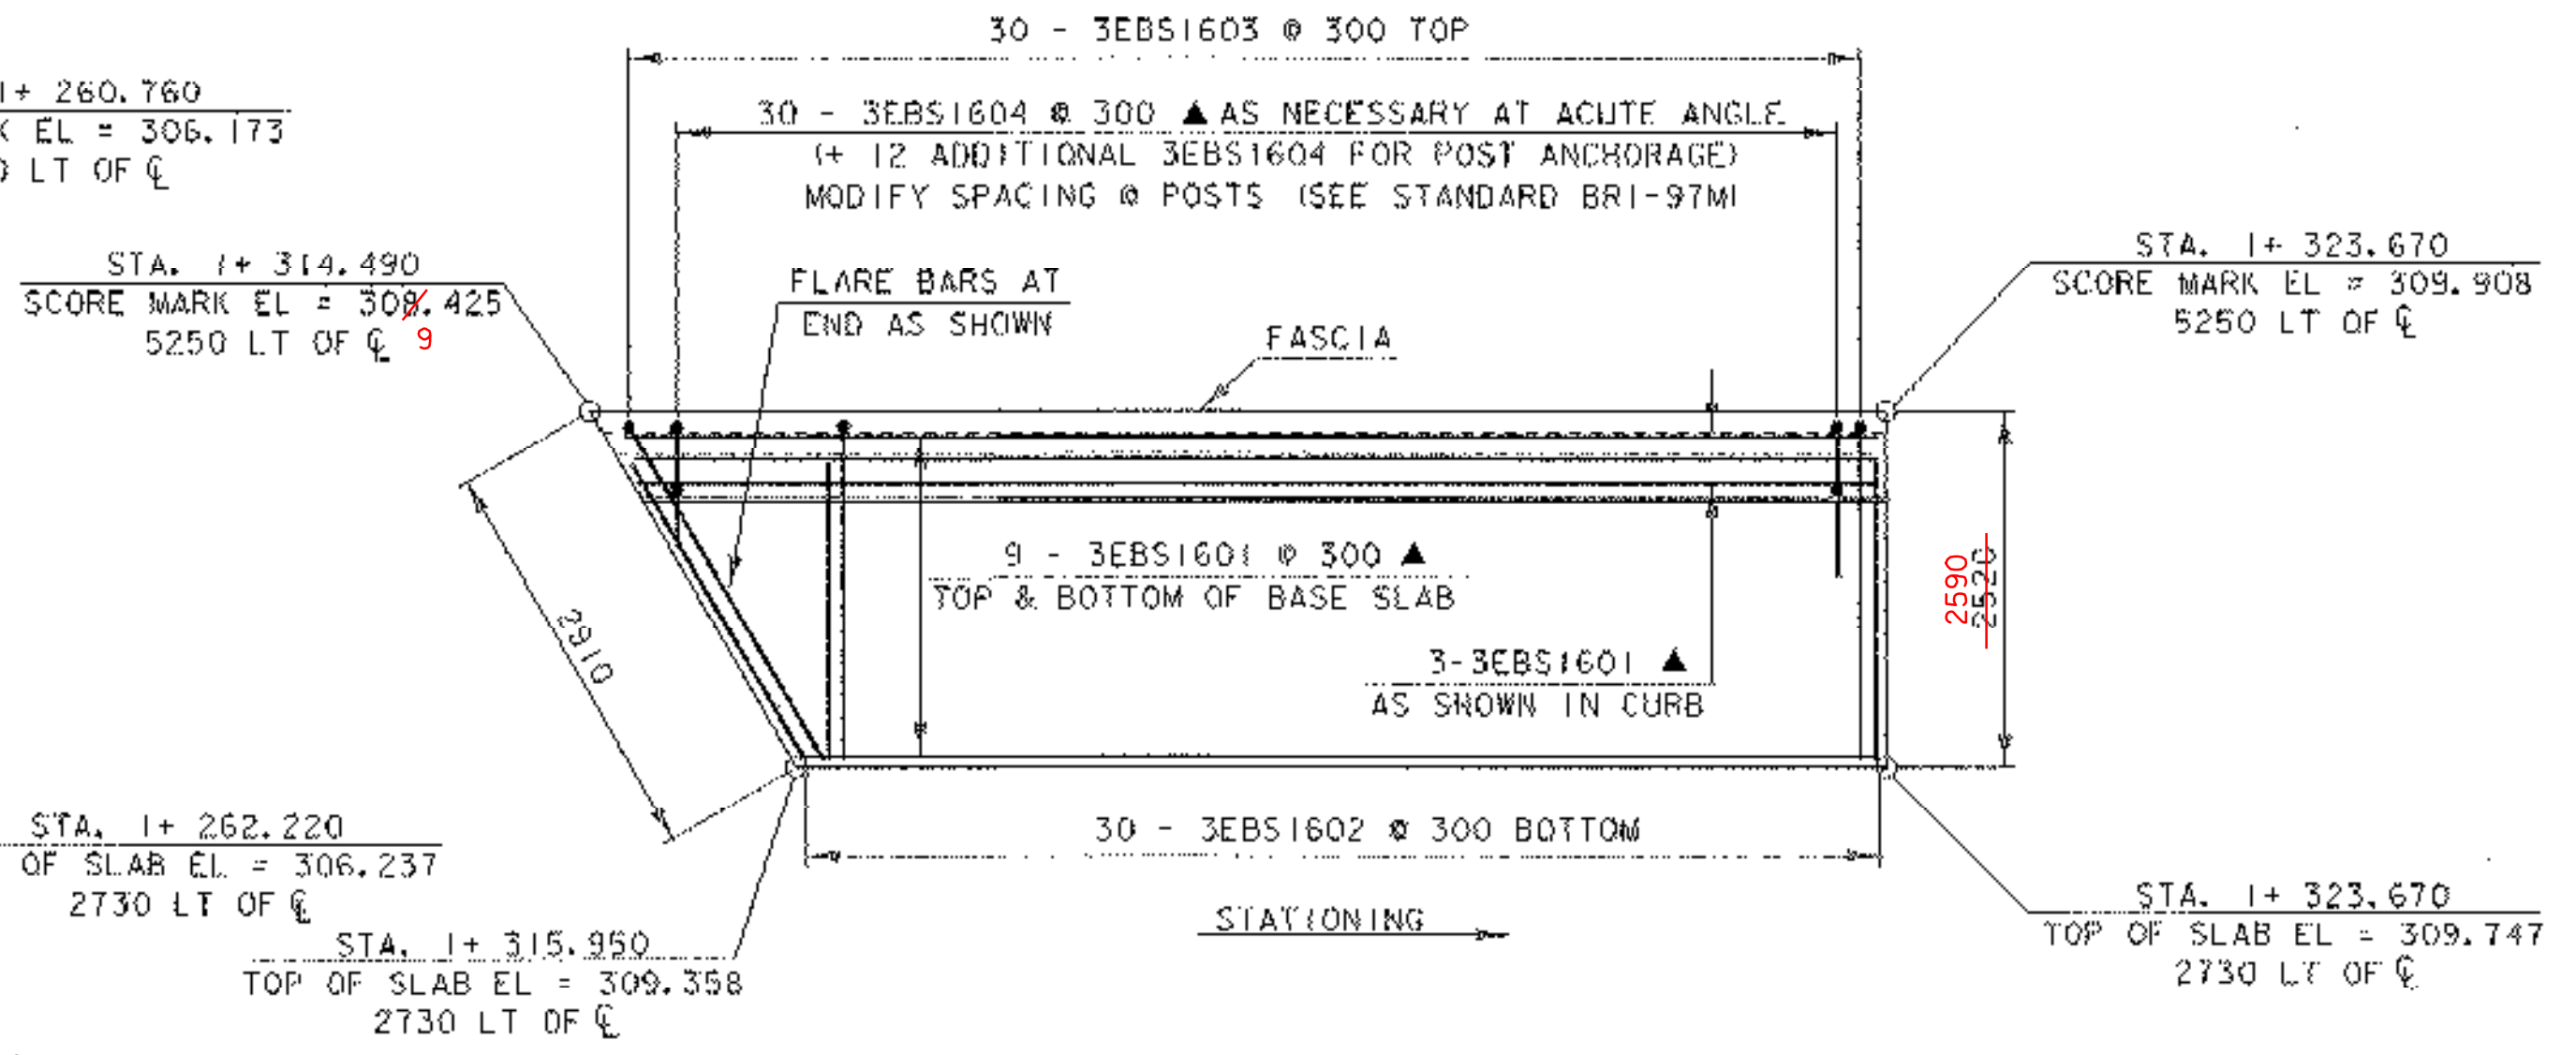


BASE SLAB # 3 PLAN VIEW

SCALE 1 : 50

NOTES:

- 1. NF = NEAR FACE EF = EACH FACE
FF = FAR FACE ▲ = CUT TO FIT IN FIELD
- 2. ALL REINFORCING STEEL SHALL BE EPOXY COATED.
- 3. 75 CLR. UNLESS OTHERWISE SPECIFIED ON THE PLANS.
- 4. ALL LAPS SHALL BE 660 UNLESS NOTED OTHERWISE.
- 5. A CURB CONSTRUCTION JOINT SHALL BE LOCATED OVER ALL BASE SLAB CONSTRUCTION JOINTS.
- 6. MAXIMUM DISTANCE BETWEEN CONSTRUCTION JOINTS IN CURBS SHALL BE 3000.
- 7. MAXIMUM DISTANCE BETWEEN CONSTRUCTION JOINTS BASE SLAB SHALL BE 9000.
- 8. SEE SHEETS 69 AND 70 FOR MORE BASE SLAB DIMENSIONS.
- 9. BASE SLAB #2 IS NOT REQUIRED FOR THIS PROJECT.
- 10. CURVED FASCIAS WILL BE FORMED TO RADIUS SHOWN, FORMING ON CHORDS WILL NOT BE ALLOWED.

ARCHIVED
ON CADD

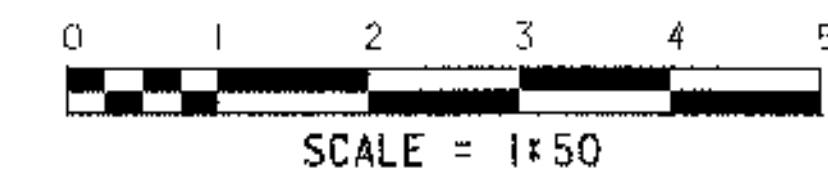

PROJECT NAME:	BARTON
PROJECT NUMBER:	STP 0113 (58) S
FILE NAME:	06c116/Structures/ec116sup.dgn
IPARM NAME:	06c116/Structures/ec116st1.dwg
PROJECT LEADER:	C. P. WILLIAMS
DESIGNED BY:	W. B. SYMONDS
PLOT DATE:	03-JAN-2002
DRAWN BY:	T. G. ANDERSON
CHECKED BY:	W. B. SYMONDS
SHEET	63 OF 120