



NOTE: WP = MSE WALL WORKING POINT ALONG FRONT FACE OF WALL.  
 ABUTMENT WORKING POINTS ARE NOT SHOWN ON THIS SHEET.

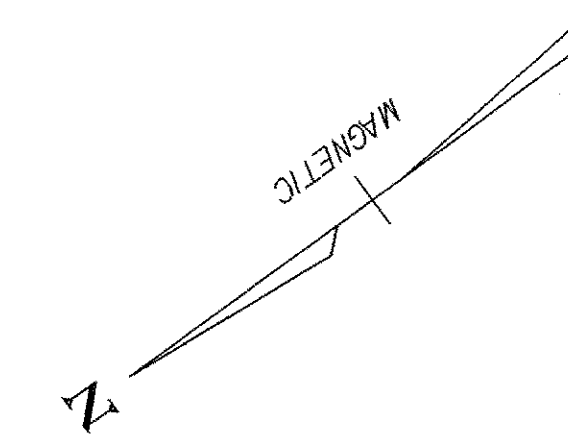

PLAN OF MECHANICALLY STABILIZED  
 EARTH WALL @ ABUTMENT NO. 1



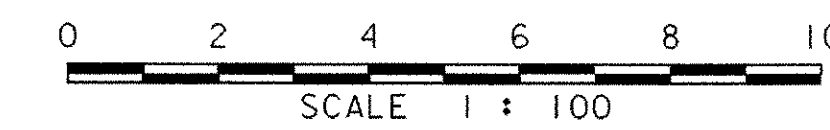


NOTES

THE ELEVATIONS SHOWN ARE TO THE TOP OF THE LEVELING PAD AND THE BOTTOM OF THE MSE WALL. THE LEVELING PAD SHALL BE INSTALLED LEVEL.

MSE WALL PANELS ARE SHOWN NOMINALLY SIZED AT 1500 X 1500.

SLIP JOINTS ARE NOT SHOWN ON THE ELEVATION, BUT ARE REQUIRED AT ALL WALL INTERSECTIONS THAT FORM ANGLES. ADDITIONAL SLIP JOINTS SHALL BE PLACED AS REQUIRED BY THE MSE WALL SUPPLIER.

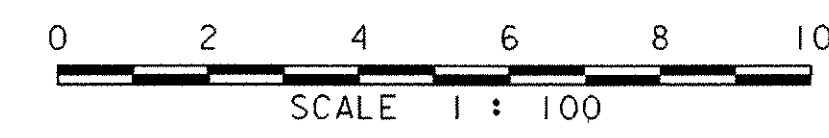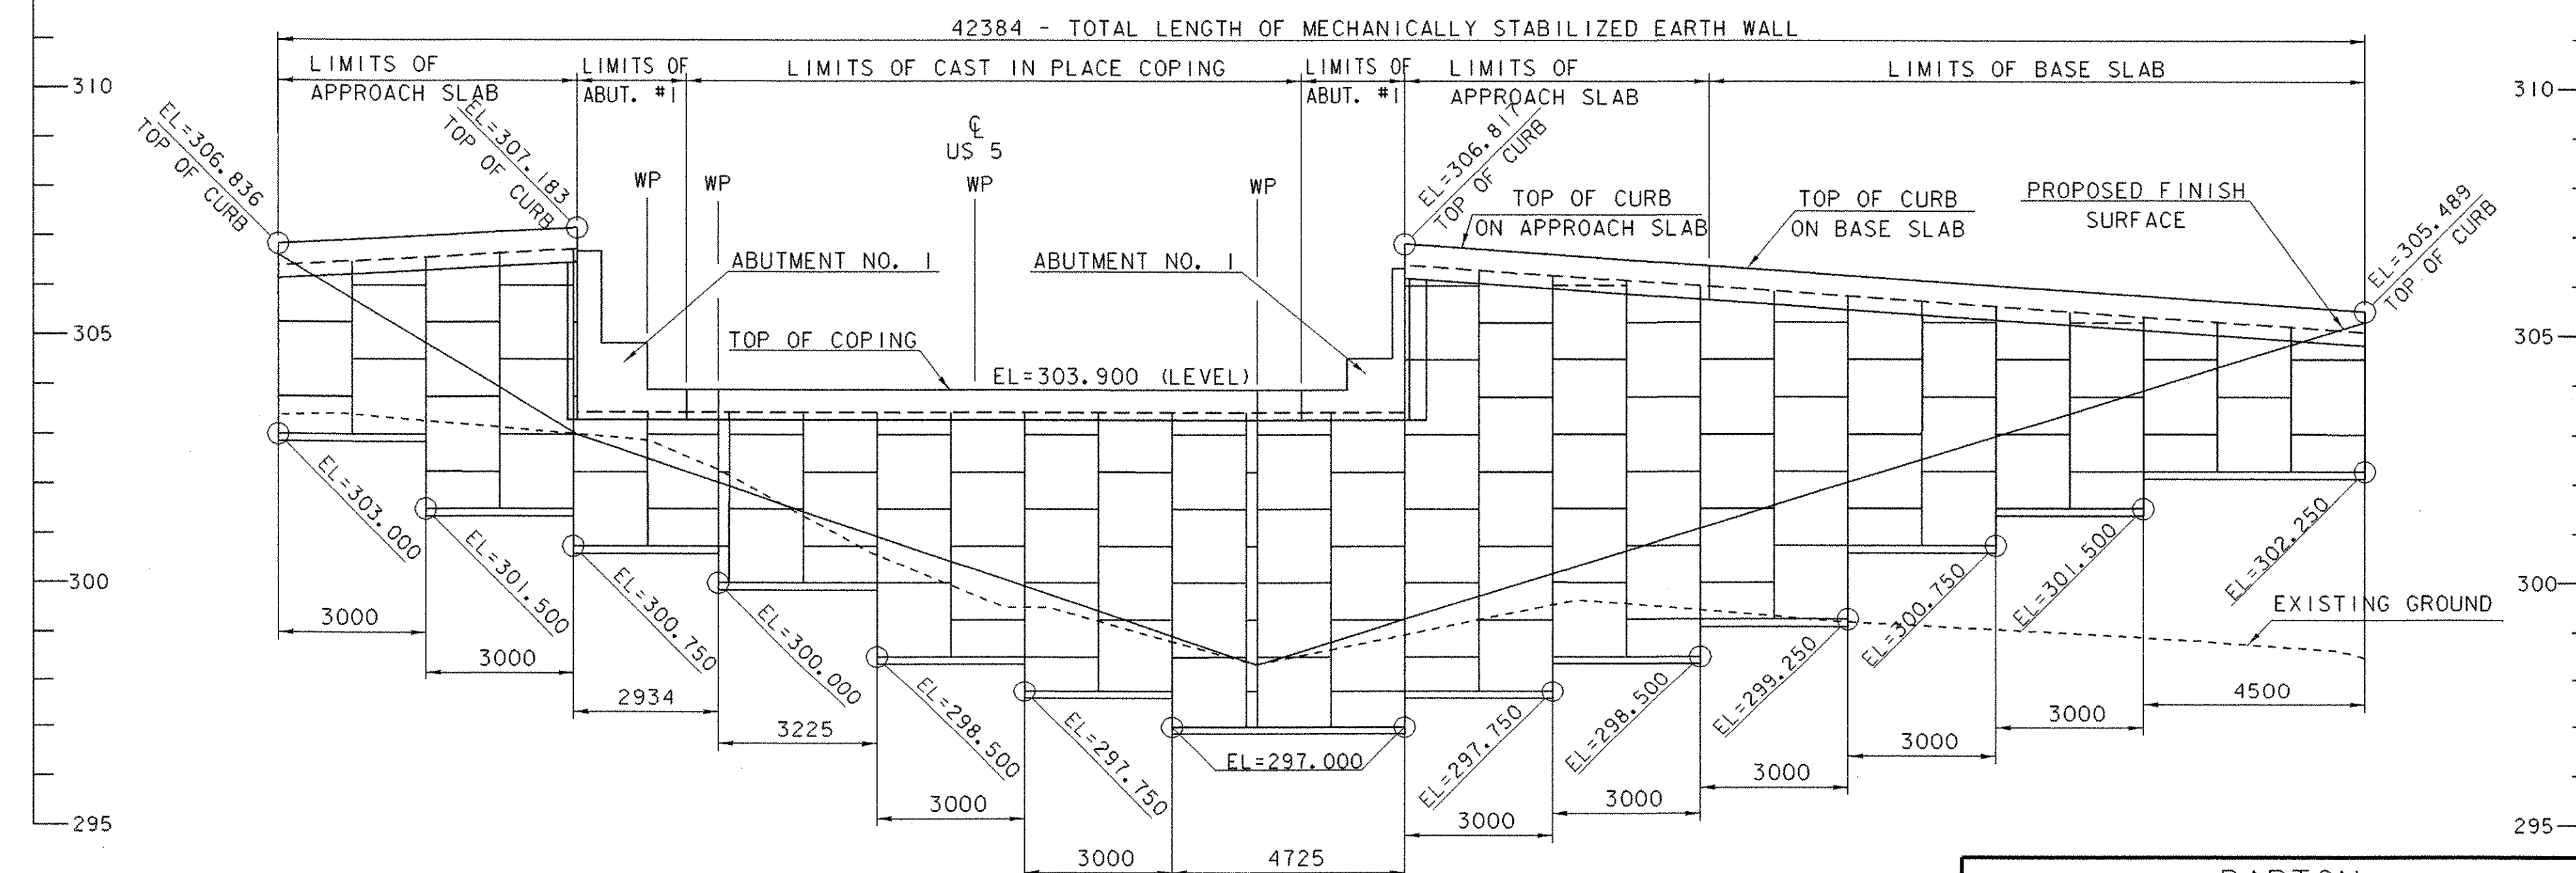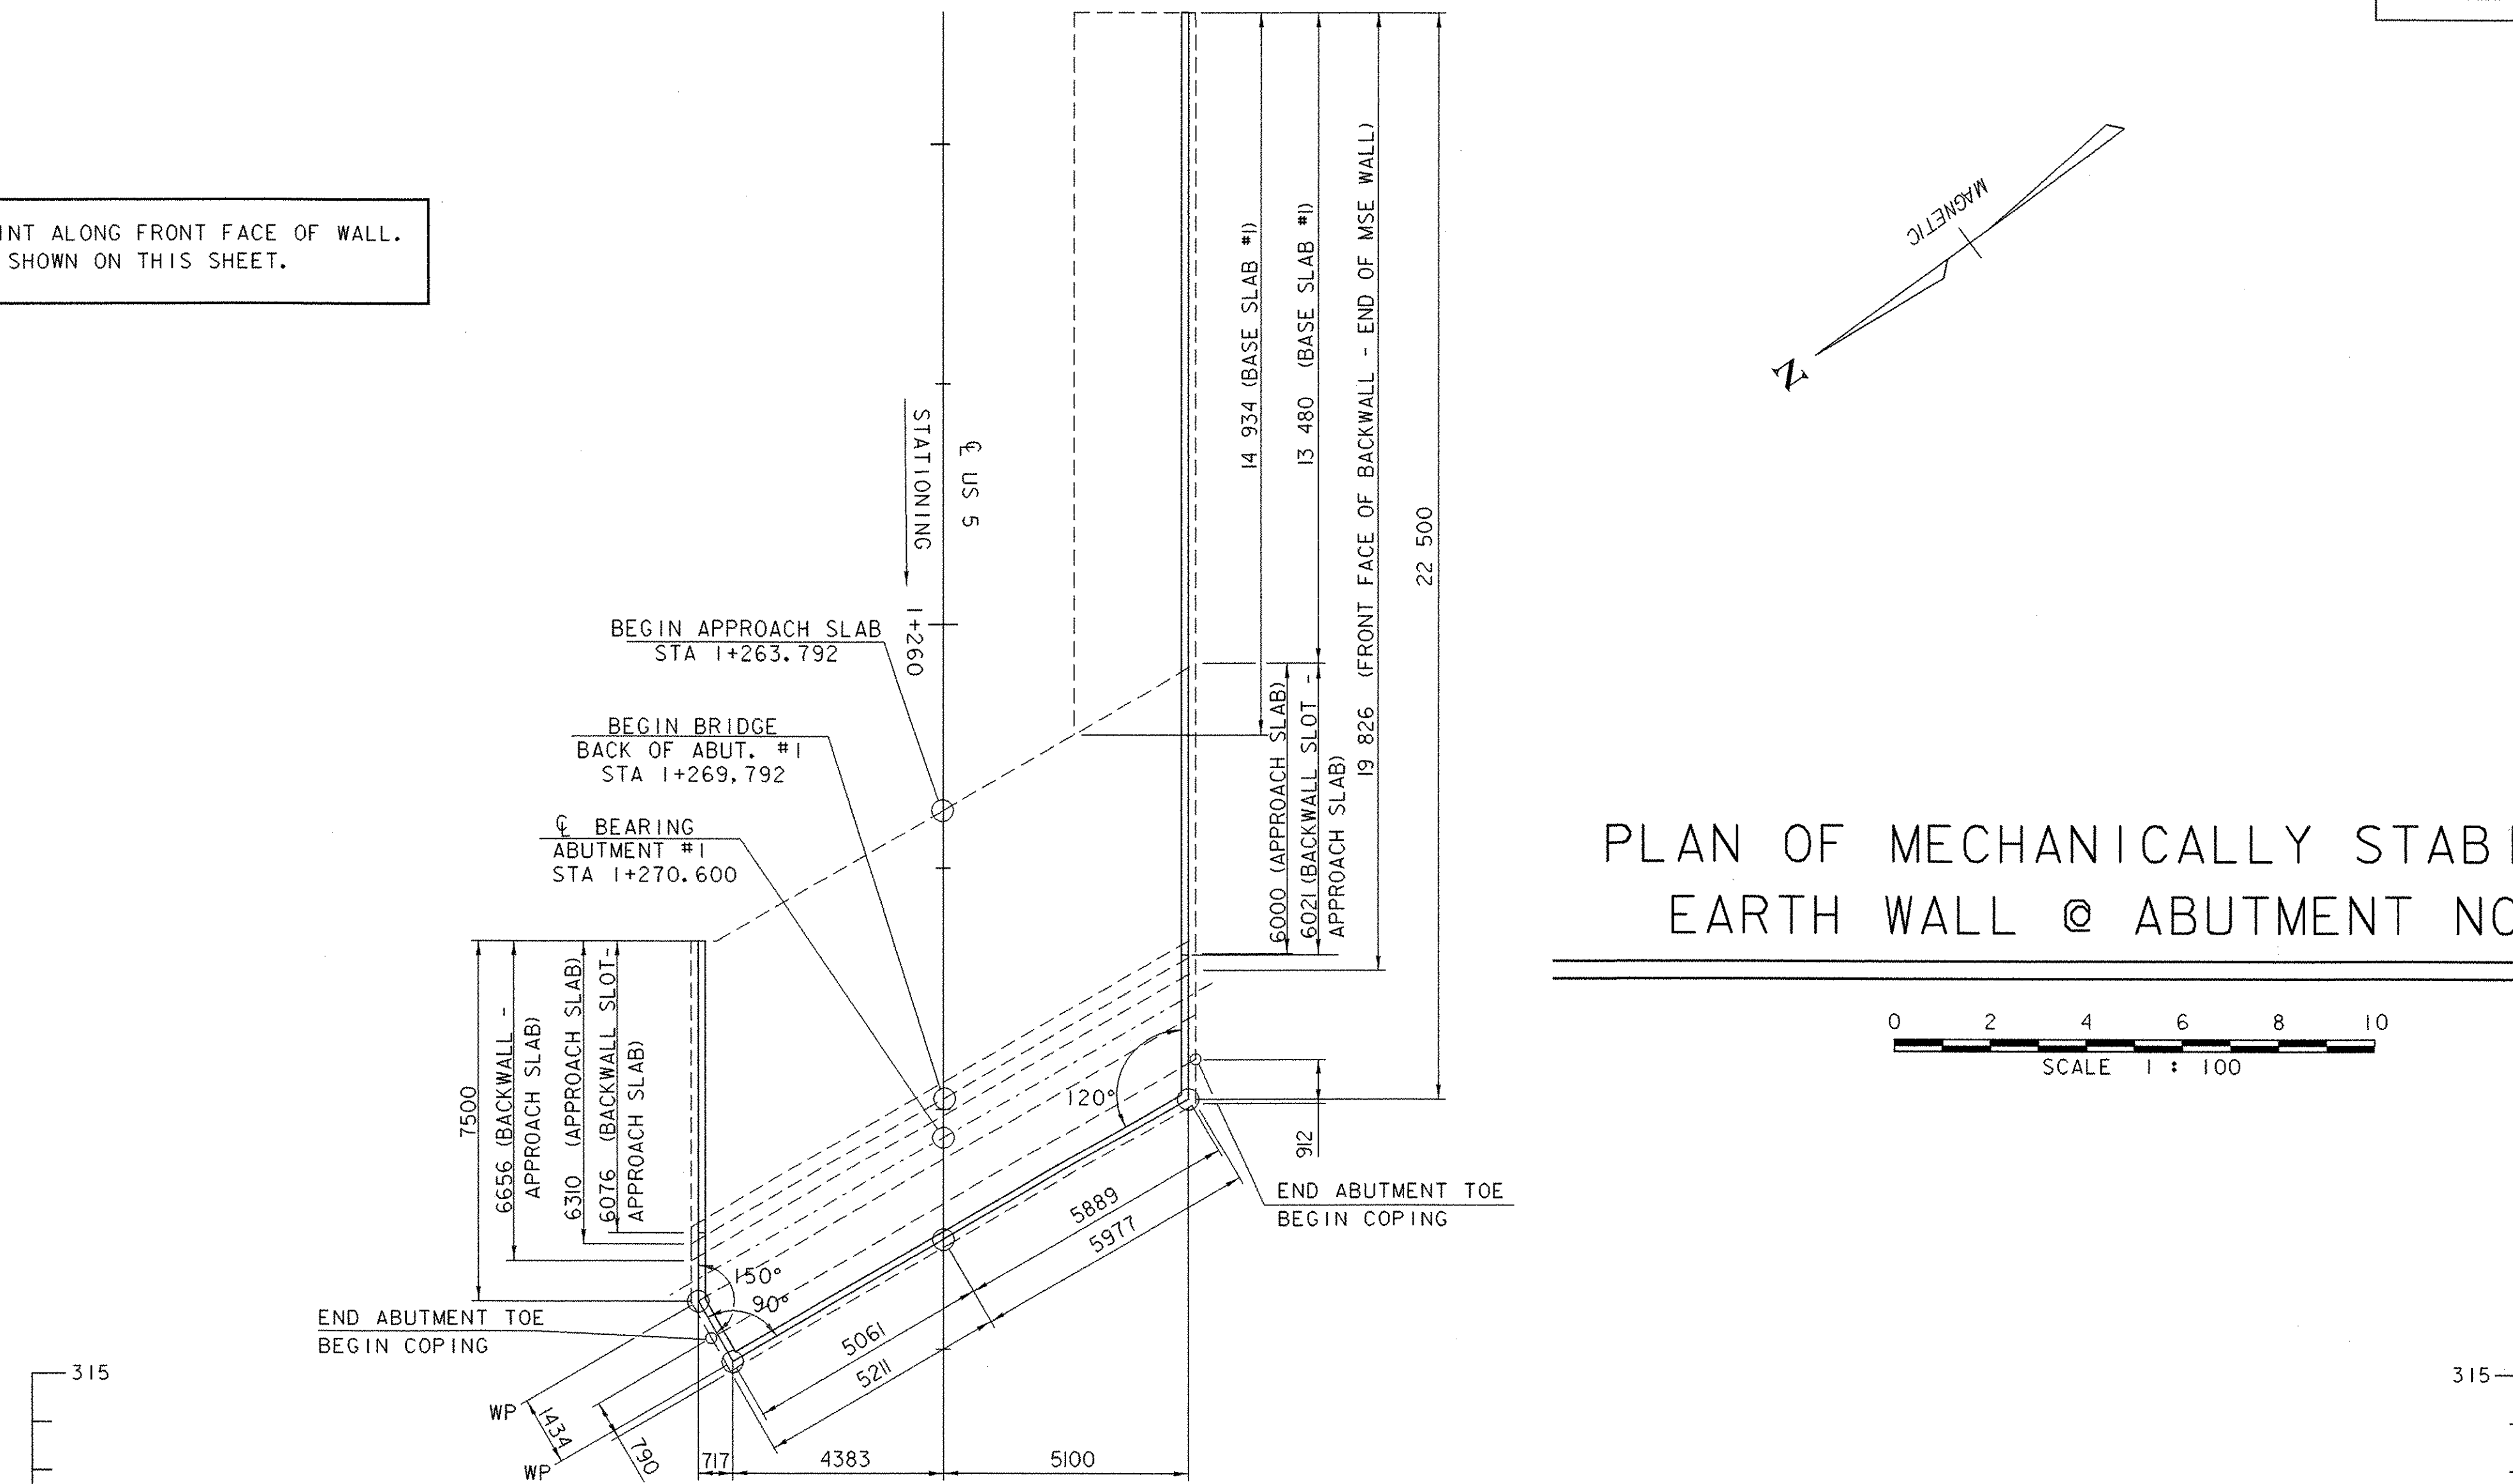

ELEVATION ALONG FACE OF MECHANICALLY  
 STABILIZED EARTH WALL @ ABUTMENT NO. 1

PROJECT NAME:	BARTON
PROJECT NUMBER:	STP 0113 (58) S
FILE NAME:	96cl16/structures/sc16mse1.dgn
PROJECT LEADER:	C. P. WILLIAMS
DESIGNED BY:	W. B. SYMONDS
ABUTMENT #1 MSE WALL PLAN & ELEVATION	
PLOT DATE:	03-JAN-2002
DRAWN BY:	W. B. SYMONDS
CHECKED BY:	R. S. YOUNG
SHEET	69 OF 120