

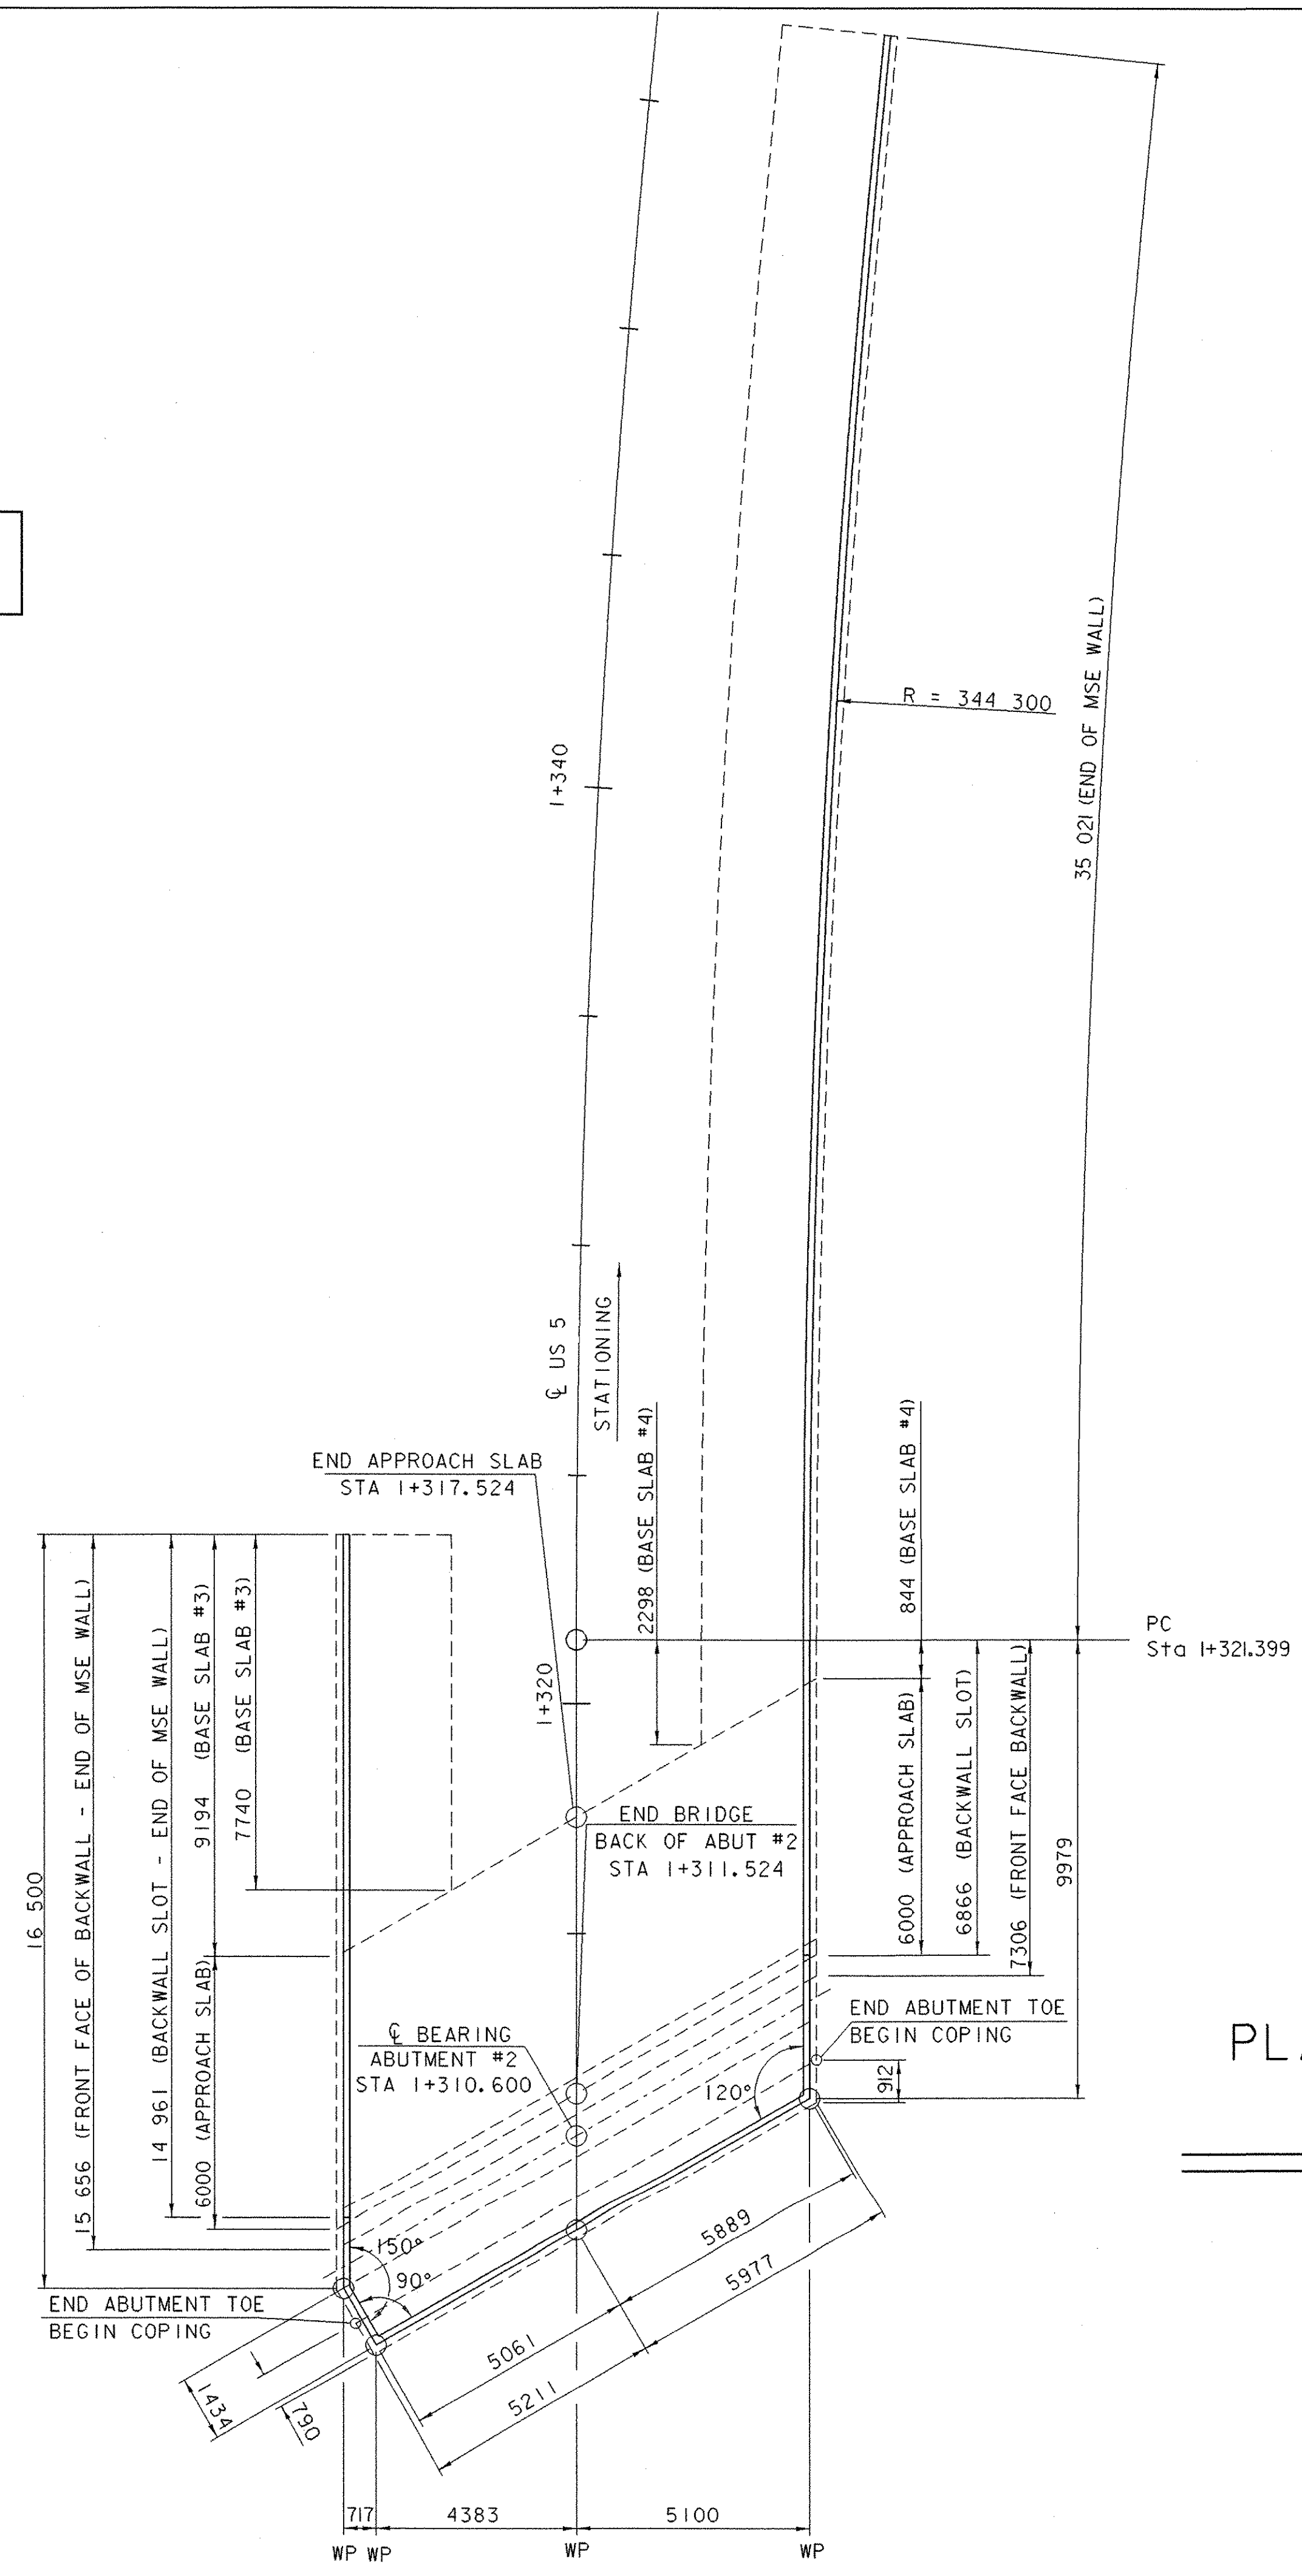


NOTE: WP = MSE WALL WORKING POINT ALONG FRONT FACE OF WALL.
 ABUTMENT WORKING POINTS ARE NOT SHOWN ON THIS SHEET.

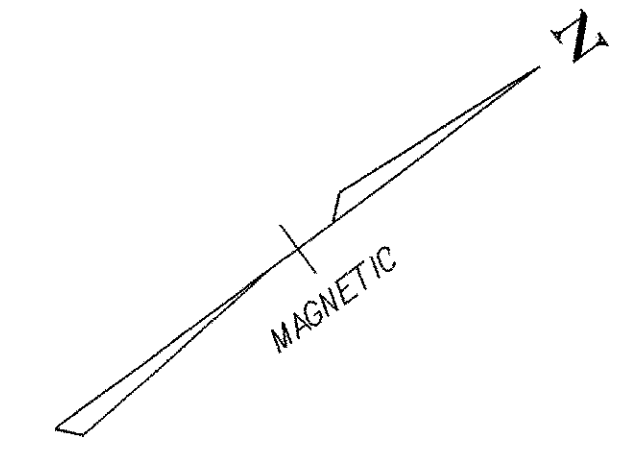

PLAN OF MECHANICALLY STABILIZED
 EARTH WALL @ ABUTMENT NO. 2

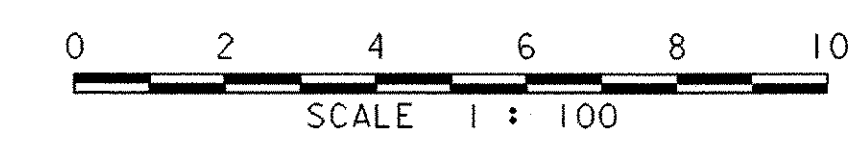

PROJECT NAME: BARTON	PLOT DATE: 03-JAN-2002
PROJECT NUMBER: STP 0113 (58)S	DRAWN BY:
FILE NAME: 96c116/structures/sc116mse	CHECKED BY:
PROJECT LEADER: C.P. WILLIAMS	SHEET 70 OF 120
DESIGNED BY: W.B. SYMONDS	
ABUTMENT #2 MSE WALL PLAN	